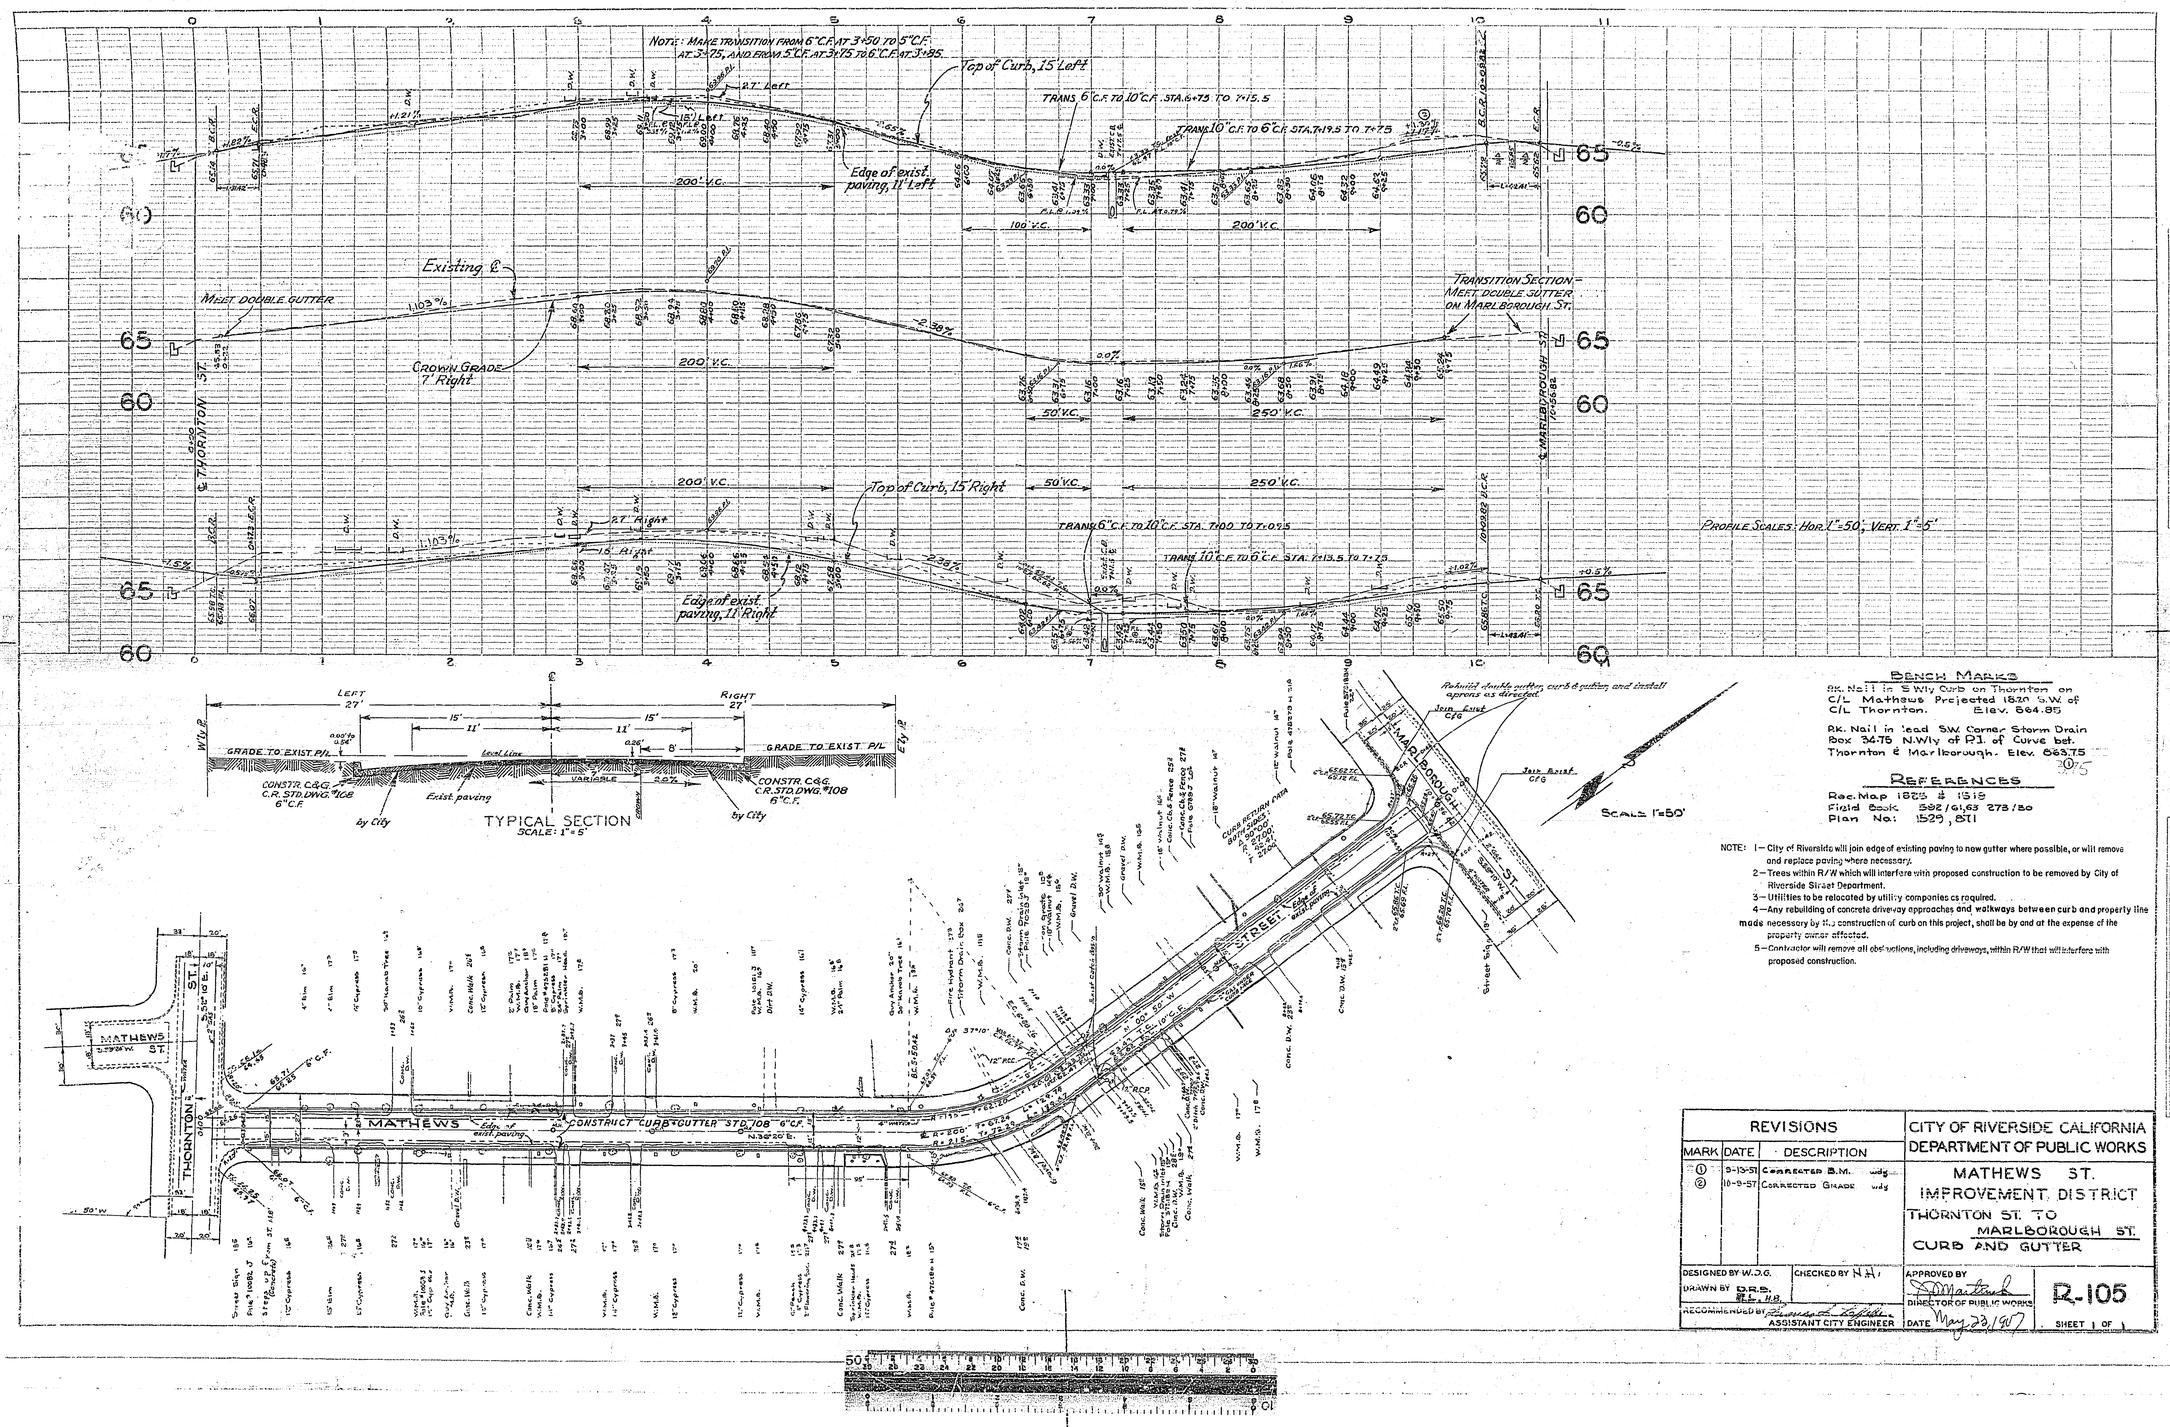

BENCH MARKS

Rk. Nail in S Wly Curb on Thornton on C/L Mathews Projected 1820 S.W. of C/L Thornton. Elev. 864.85

Rk. Nail in lead S.W. Corner Storm Drain Box 34.75 N.Wly of P.I. of Curve bet. Thornton & Marlborough. Elev. 863.75

REFERENCES

Rec. Map 1825 & 1518
Field Book 592/61,63 273/30
Plan No: 1529, 871

NOTE:
1 — City of Riverside will join edge of existing paving to new gutter where possible, or will remove and replace paving where necessary.
2 — Trees within R/W which will interfere with proposed construction to be removed by City of Riverside Street Department.
3 — Utilities to be relocated by utility companies as required.
4 — Any rebuilding of concrete driveway approaches and walkways between curb and property line made necessary by the construction of curb on this project, shall be by and at the expense of the property owner affected.
5 — Contractor will remove all obstructions, including driveways, within R/W that will interfere with proposed construction.

REVISIONS		
MARK	DATE	DESCRIPTION
①	9-13-57	CORRECTED B.M. wdg
②	10-9-57	CORRECTED GRADE wdg

CITY OF RIVERSIDE CALIFORNIA
DEPARTMENT OF PUBLIC WORKS

MATHEWS ST.
IMPROVEMENT DISTRICT
THORNTON ST. TO MARLBOROUGH ST.
CURB AND GUTTER

DESIGNED BY W.D.G. | CHECKED BY N.H.
DRAWN BY D.R.S. R.L. H.B.
RECOMMENDED BY [signature] ASSISTANT CITY ENGINEER
APPROVED BY [signature] DIRECTOR OF PUBLIC WORKS
DATE May 23, 1957

R-105
SHEET 1 OF 1

PROFILE
NOTE BOOK
PLOTTED
DRAWN
CHECKED
STRUCTURE NOTES
NO.
DATE

PLAN
NOTE BOOK
SURVEYED
PLOTTED
ALIGNMENT CHECKED
RT. OF WAY CHECKED
NO.
DATE