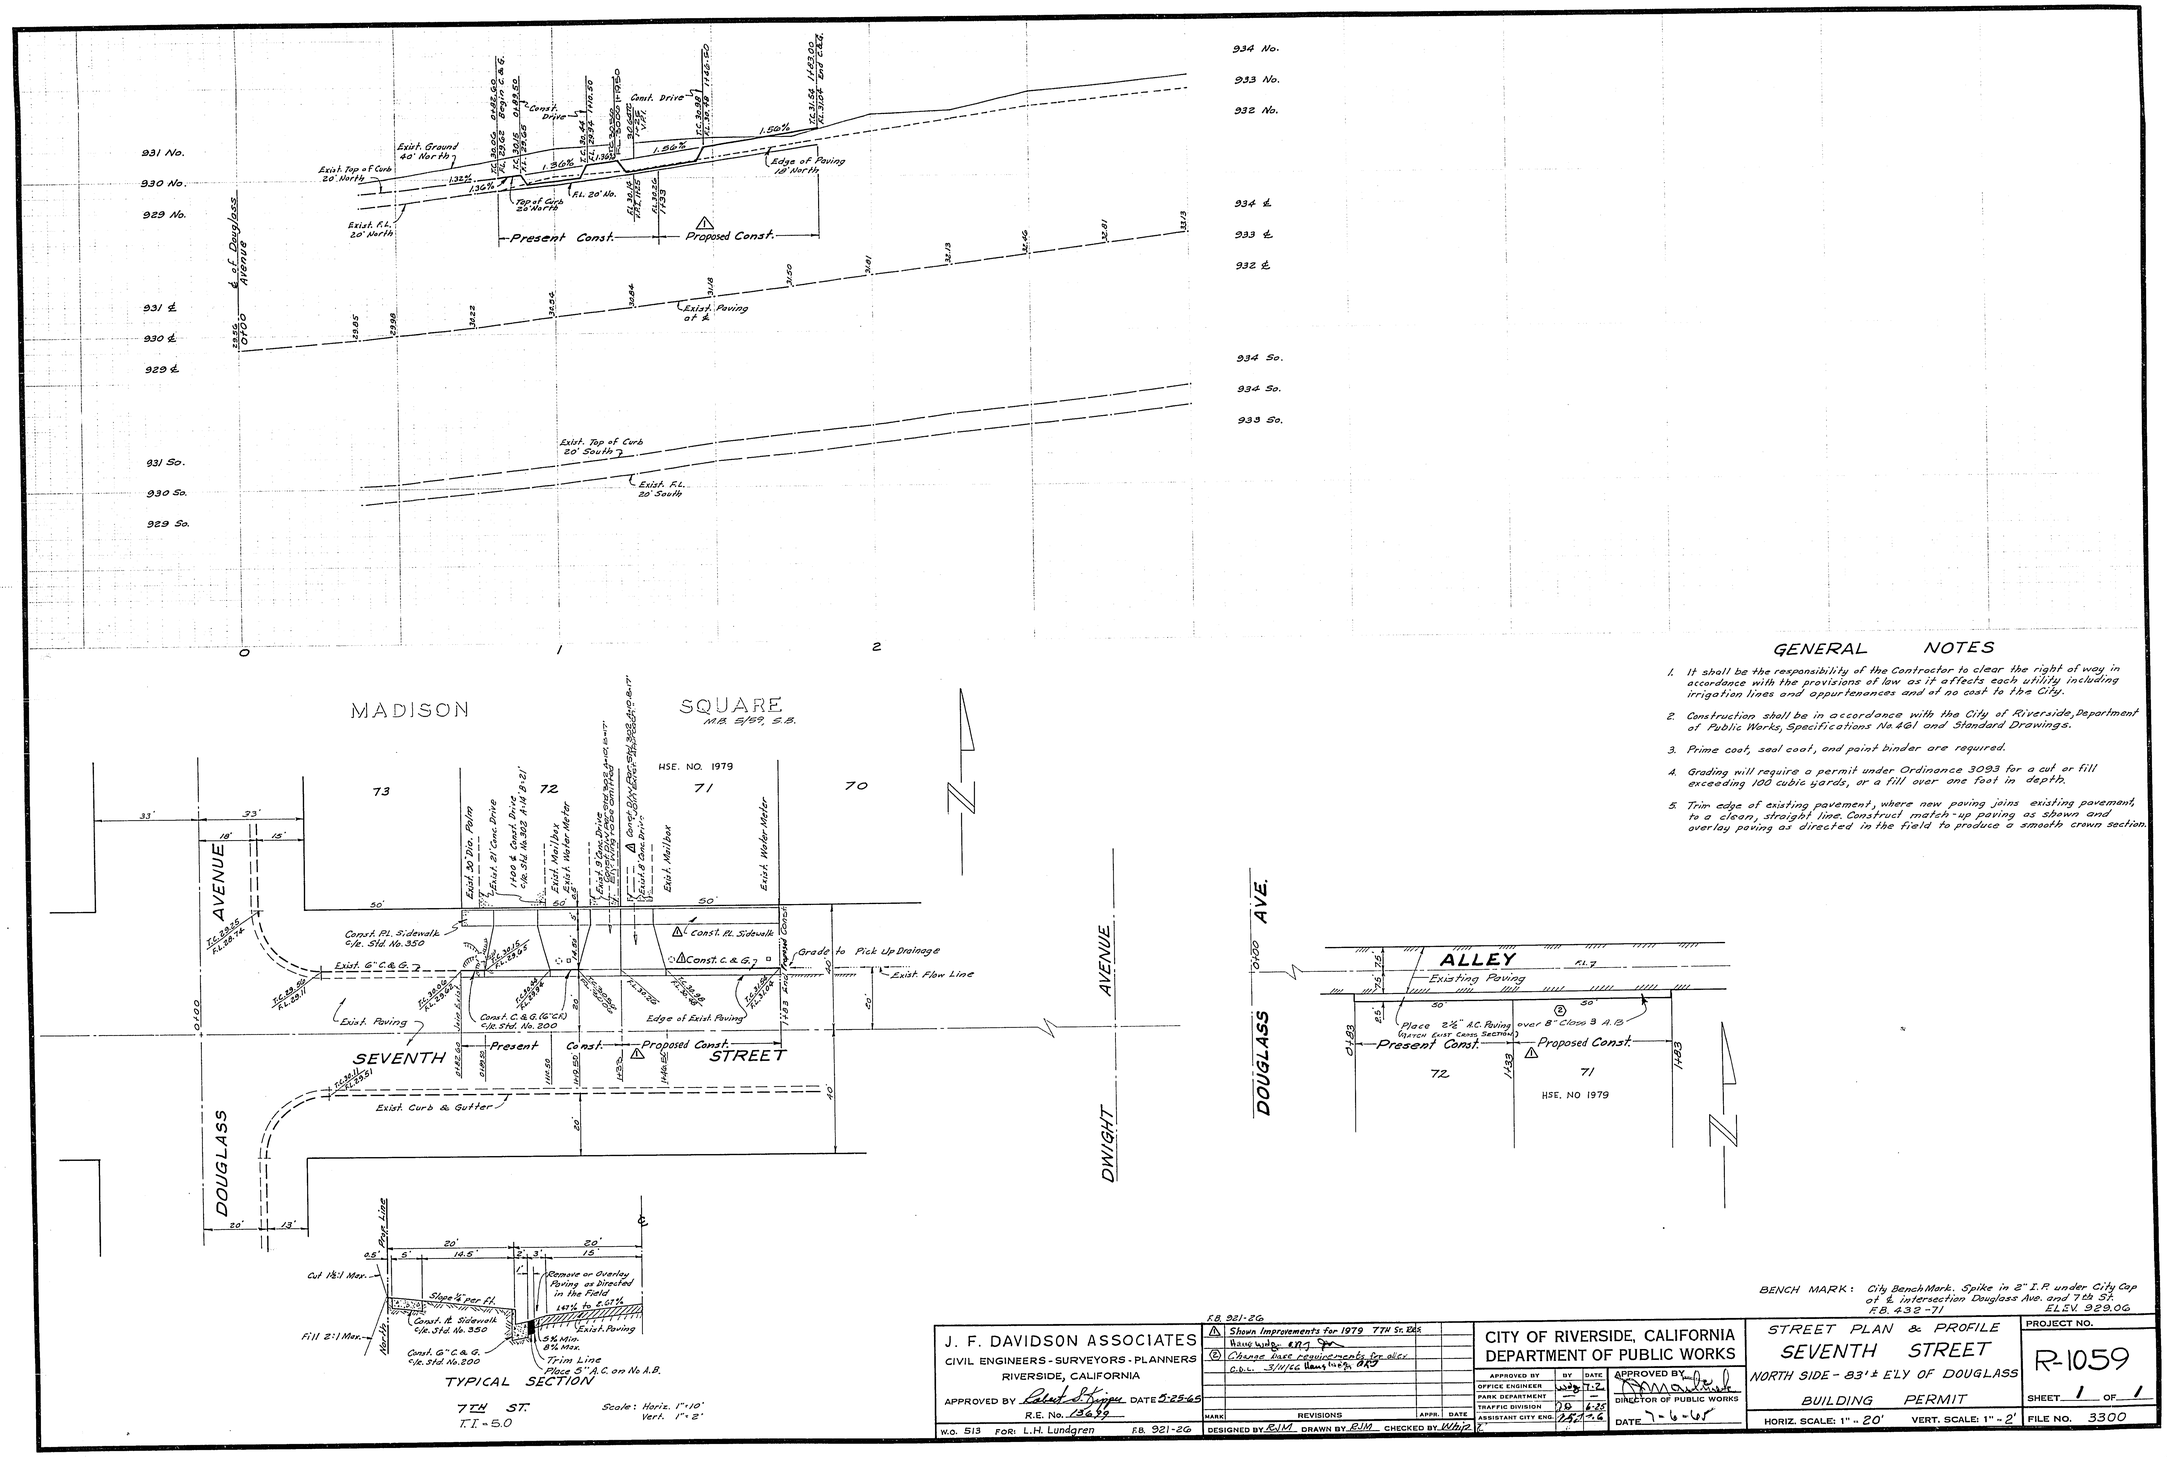

GENERAL NOTES

1. It shall be the responsibility of the Contractor to clear the right of way in accordance with the provisions of law as it affects each utility including irrigation lines and appurtenances and at no cost to the City.
2. Construction shall be in accordance with the City of Riverside, Department of Public Works, Specifications No. 461 and Standard Drawings.
3. Prime coat, seal coat, and paint binder are required.
4. Grading will require a permit under Ordinance 3093 for a cut or fill exceeding 100 cubic yards, or a fill over one foot in depth.
5. Trim edge of existing pavement, where new paving joins existing pavement, to a clean, straight line. Construct match-up paving as shown and overlay paving as directed in the field to produce a smooth crown section.

BENCH MARK: City Bench Mark. Spike in 2" I.P. under City Cap at ℄ intersection Douglass Ave. and 7th St.
F.B. 432-71 ELEV. 929.06

J. F. DAVIDSON ASSOCIATES
CIVIL ENGINEERS - SURVEYORS - PLANNERS
RIVERSIDE, CALIFORNIA
APPROVED BY Robert S. Kipper DATE 5-25-65
R.E. No. 13699
W.O. 513 FOR: L.H. Lundgren F.B. 921-26

F.B. 921-26

MARK	REVISIONS	APPR.	DATE
1	Shown Improvements for 1979 7TH St. RES. Hans Wedge ENG Jan		
2	Change base requirements for alley C.B.L. 3/11/66 Hans Wedge ENG		

DESIGNED BY RJM DRAWN BY RJM CHECKED BY Whip

CITY OF RIVERSIDE, CALIFORNIA
DEPARTMENT OF PUBLIC WORKS

APPROVED BY	BY	DATE
OFFICE ENGINEER	Wdg	7-2
PARK DEPARTMENT	—	—
TRAFFIC DIVISION	JD	6-25
ASSISTANT CITY ENG.	JRJ	7-6

APPROVED BY [signature]
DIRECTOR OF PUBLIC WORKS
DATE 7-6-65

STREET PLAN & PROFILE
SEVENTH STREET
NORTH SIDE - 83'± E'LY OF DOUGLASS
BUILDING PERMIT
HORIZ. SCALE: 1" = 20' VERT. SCALE: 1" = 2'

PROJECT NO. R-1059
SHEET 1 OF 1
FILE NO. 3300