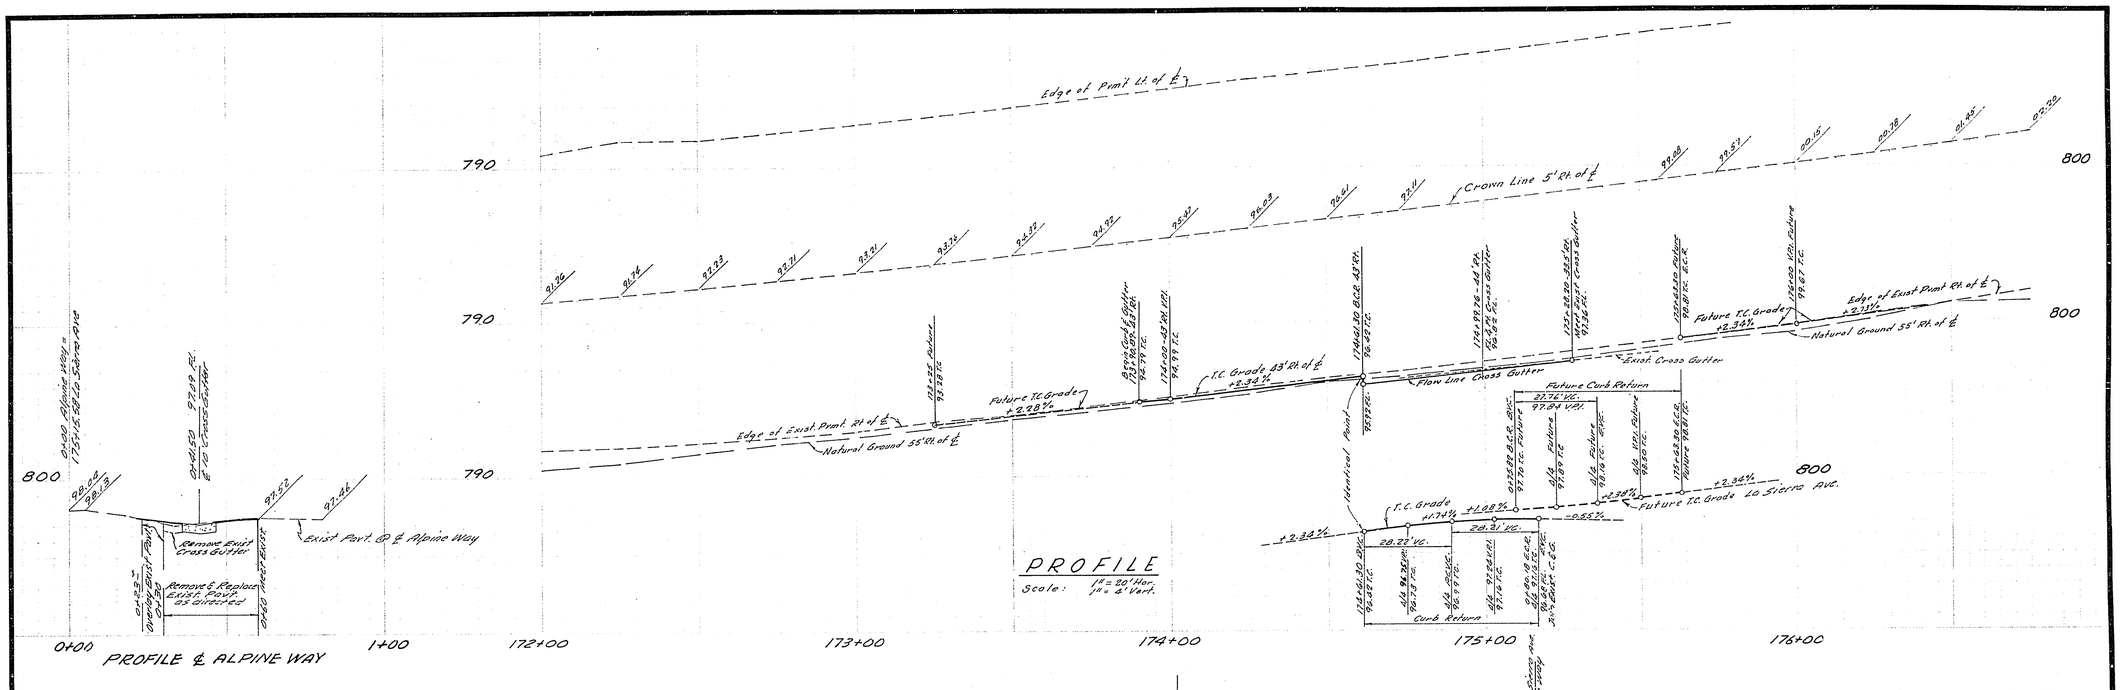

GENERAL NOTES

1. It shall be the responsibility of the contractor to clear the right of way in accordance with the provisions of law as it affects each utility including irrigation lines and appurtenances and at no cost to Park City.
2. Construction shall be in accordance with the City of Riverside Department of Public Works, Specifications No. 681 and Standard Drawings.
3. Prime coat, seal coat and paint binder are required.
4. Grading will require a permit under Ordinance 3093 for a cut or fill exceeding 100 cubic yards, or a fill over one foot in depth.
5. Trim edge of existing pavement, where new paving joins existing pavement, to a clean straight line. Construct patch-up paving as shown and overlay as directed in the field to produce a smooth crown section.
6. The developer shall arrange for test of the soil at the subgrade level by a soils engineer. Depth and type of cover shall be determined by the soils engineer and submitted to the City of Riverside for approval.
7. The finished subgrade shall have a compaction of not less than 90% for a depth of 0.5 feet as determined by test method No. California 216 F. immediately prior to placement of the cover.
8. The amount of asphalt overlay on existing pavement has been estimated by the Engineer to be approximately 6 tons.
9. For relocation of any City domestic or irrigation water facility, or Electric Power utility facility to be done by City forces, contact Lin Eastman, Water Commercial Engineer at 787-7241, Schedule about 2 weeks to process a work order, before relocation work begins.
10. The Contractor shall call South West Gas Company (689-4222) at least 24 hours prior to Excavating in Street.

MARK	REVISIONS	APPR.	DATE
1	Added underground utilities		11-2-68
2	Extend cover at P.C.		11-26-68
3	Add irrigation line to plan		8/10/67

DESIGNED BY BC DRAWN BY BC CHECKED BY

CRAWLEY & HAWKINS
SURVEYORS AND ENGINEERS
Riverside, California
Approved George O. Crawley R.E. No. 9455
Field Bk. 9211, 7046, 3418
Date 7-28-68

CITY OF RIVERSIDE, CALIFORNIA
DEPARTMENT OF PUBLIC WORKS

APPROVED BY	BY	DATE
OFFICE ENGINEER		
PARK DEPARTMENT		7-18
TRAFFIC DIVISION		10-1-68
ASSISTANT CITY ENG.		10-21-68

APPROVED BY
DIRECTOR OF PUBLIC WORKS
DATE 10-22-68

STREET PLAN & PROFILE
RIS 900
LA SIERRA AVENUE
EAST SIDE, FROM ALPINE WAY SLY 125'

HORIZ. SCALE: 1" = 20' VERT. SCALE: 1" = 4'

PROJECT NO. R-1079
SHEET 1 OF 1
FILE NO.