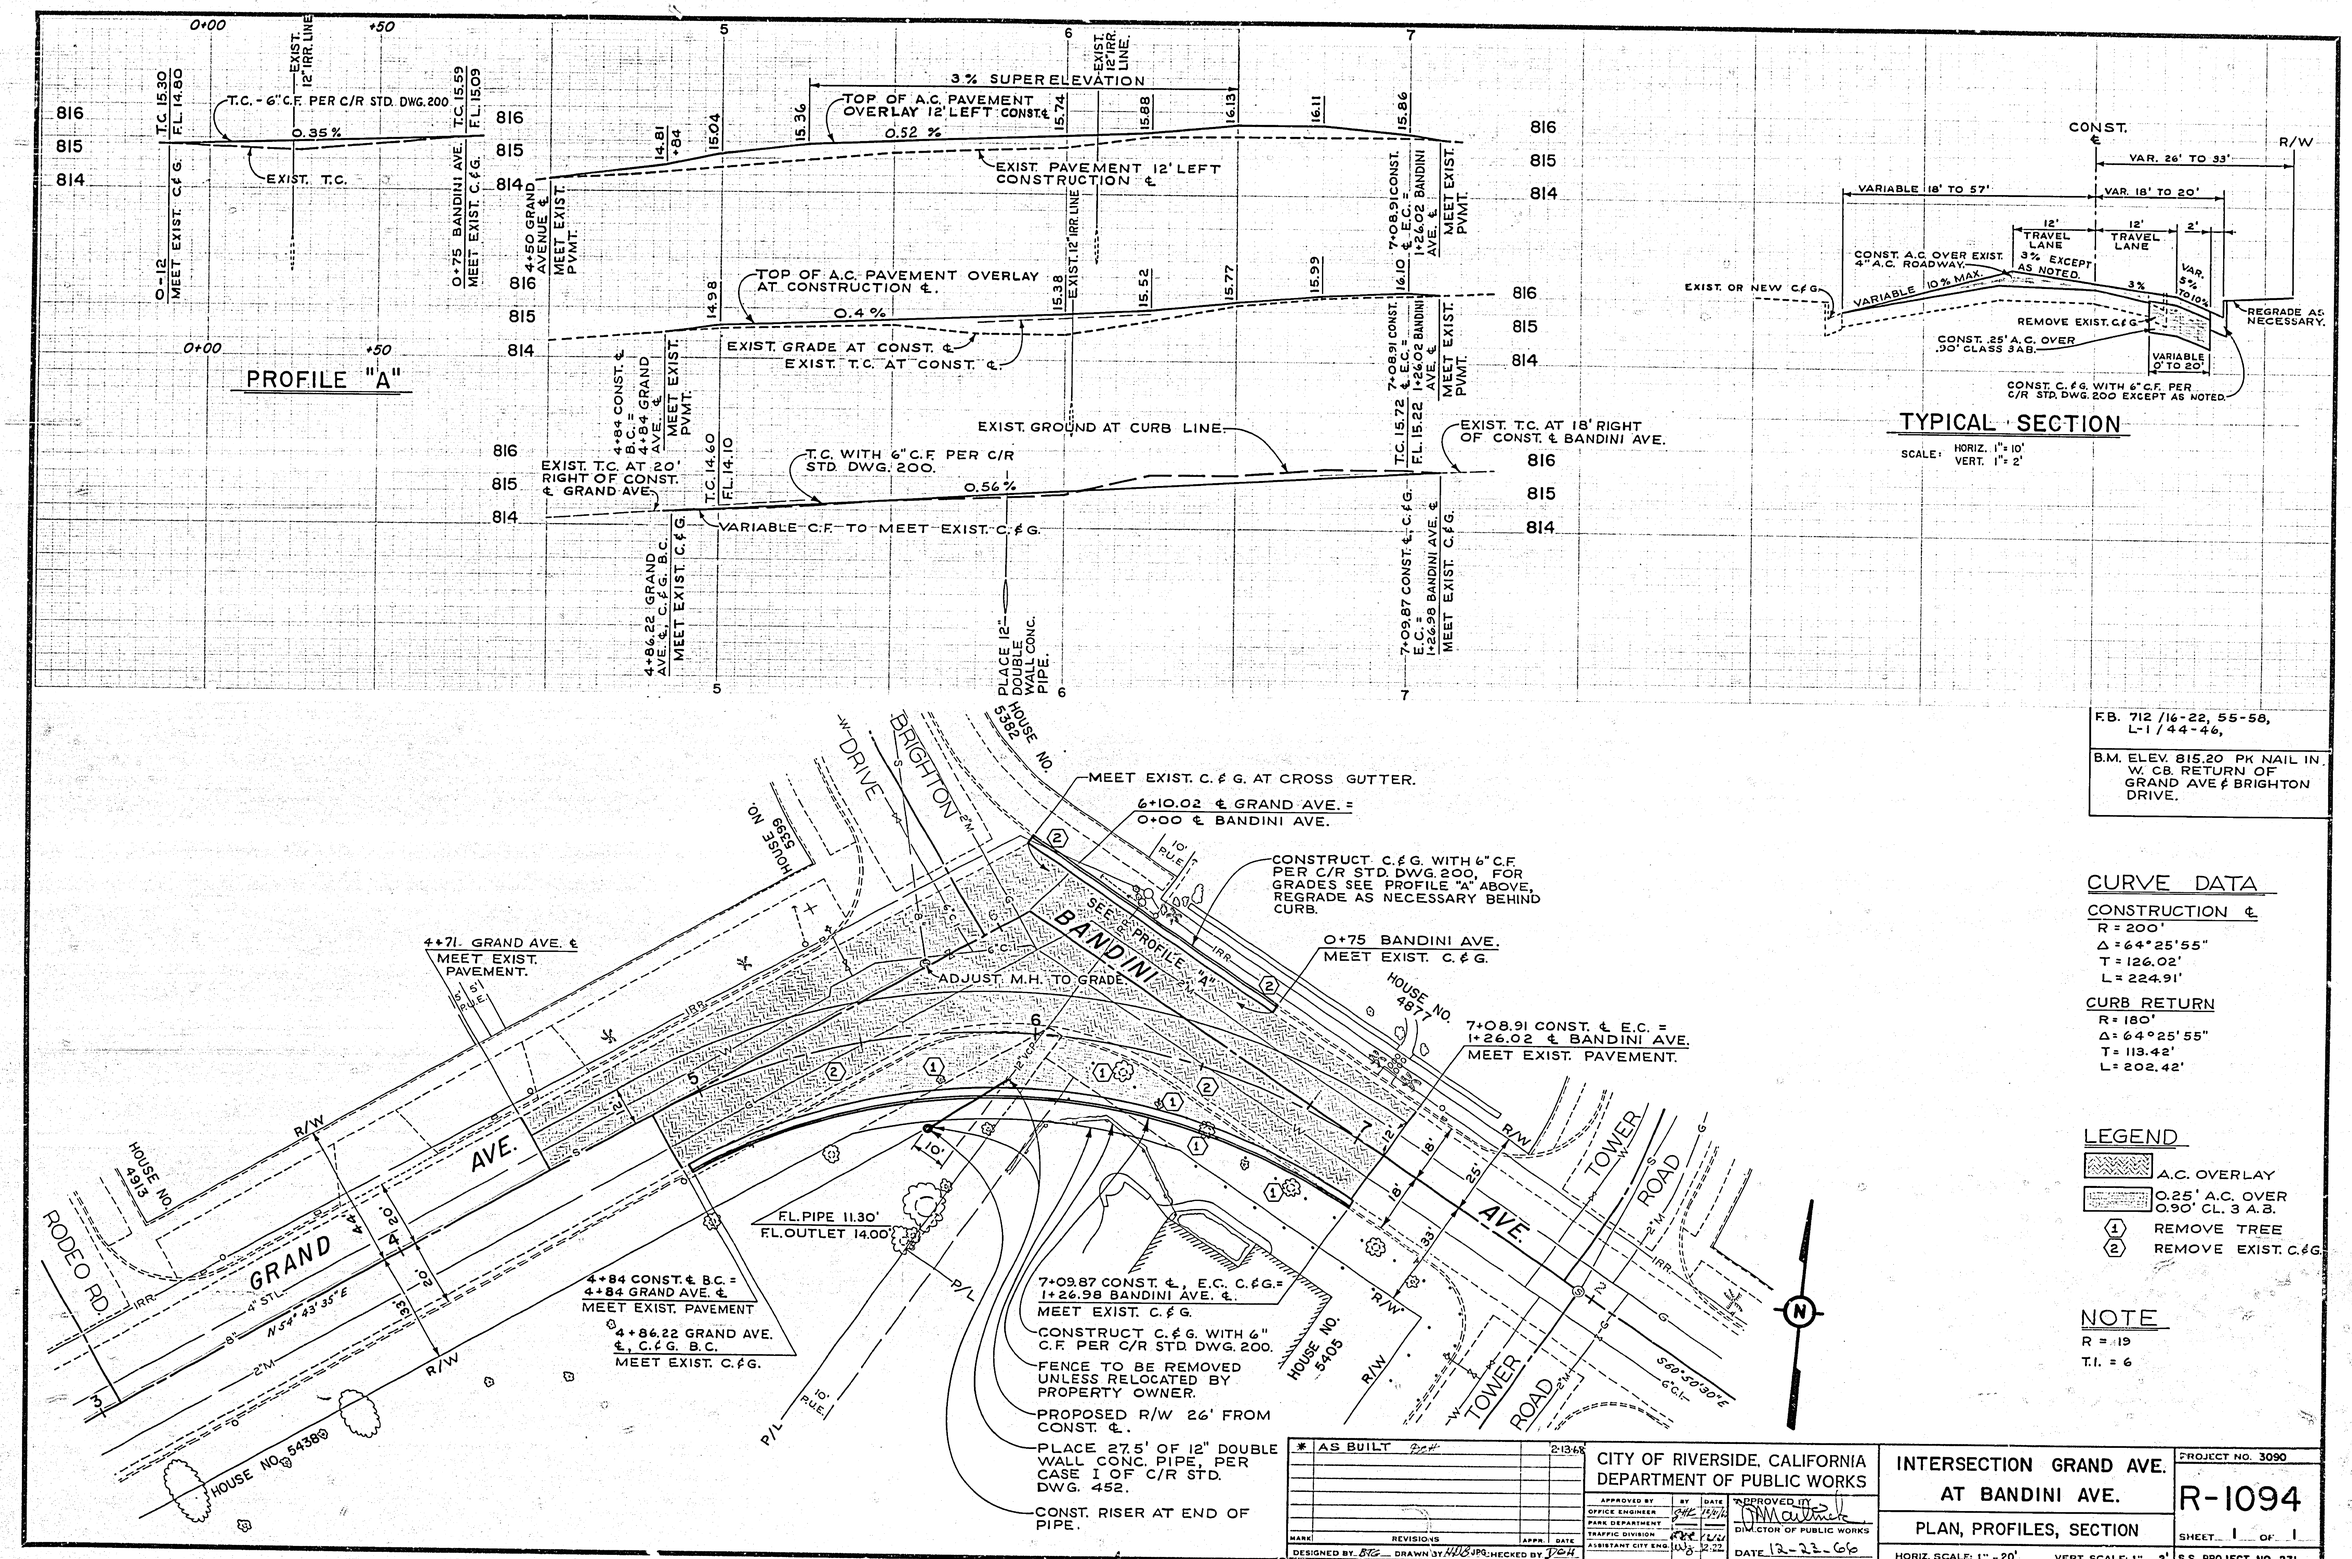

F.B. 712 /16-22, 55-58, L-1 / 44-46,

B.M. ELEV. 815.20 PK NAIL IN W. CB. RETURN OF GRAND AVE & BRIGHTON DRIVE.

CURVE DATA

CONSTRUCTION ℄
R = 200'
Δ = 64°25'55"
T = 126.02'
L = 224.91'

CURB RETURN
R = 180'
Δ = 64°25'55"
T = 113.42'
L = 202.42'

LEGEND

A.C. OVERLAY
0.25' A.C. OVER 0.90' CL. 3 A.B.
(1) REMOVE TREE
(2) REMOVE EXIST. C.&G.

NOTE

R = 19
T.I. = 6

MARK	REVISIONS	APPR.	DATE
*	AS BUILT		2-13-68

DESIGNED BY BTG DRAWN BY HLB JPG CHECKED BY JGH

CITY OF RIVERSIDE, CALIFORNIA
DEPARTMENT OF PUBLIC WORKS

APPROVED BY	BY	DATE
OFFICE ENGINEER		
PARK DEPARTMENT		
TRAFFIC DIVISION		
ASSISTANT CITY ENG.		

APPROVED IN DIRECTOR OF PUBLIC WORKS
DATE 12-22-66

INTERSECTION GRAND AVE. AT BANDINI AVE.

PLAN, PROFILES, SECTION

HORIZ. SCALE: 1" = 20' VERT. SCALE: 1" = 2'

PROJECT NO. 3090

R-1094

SHEET 1 OF 1

S.S. PROJECT NO. 271