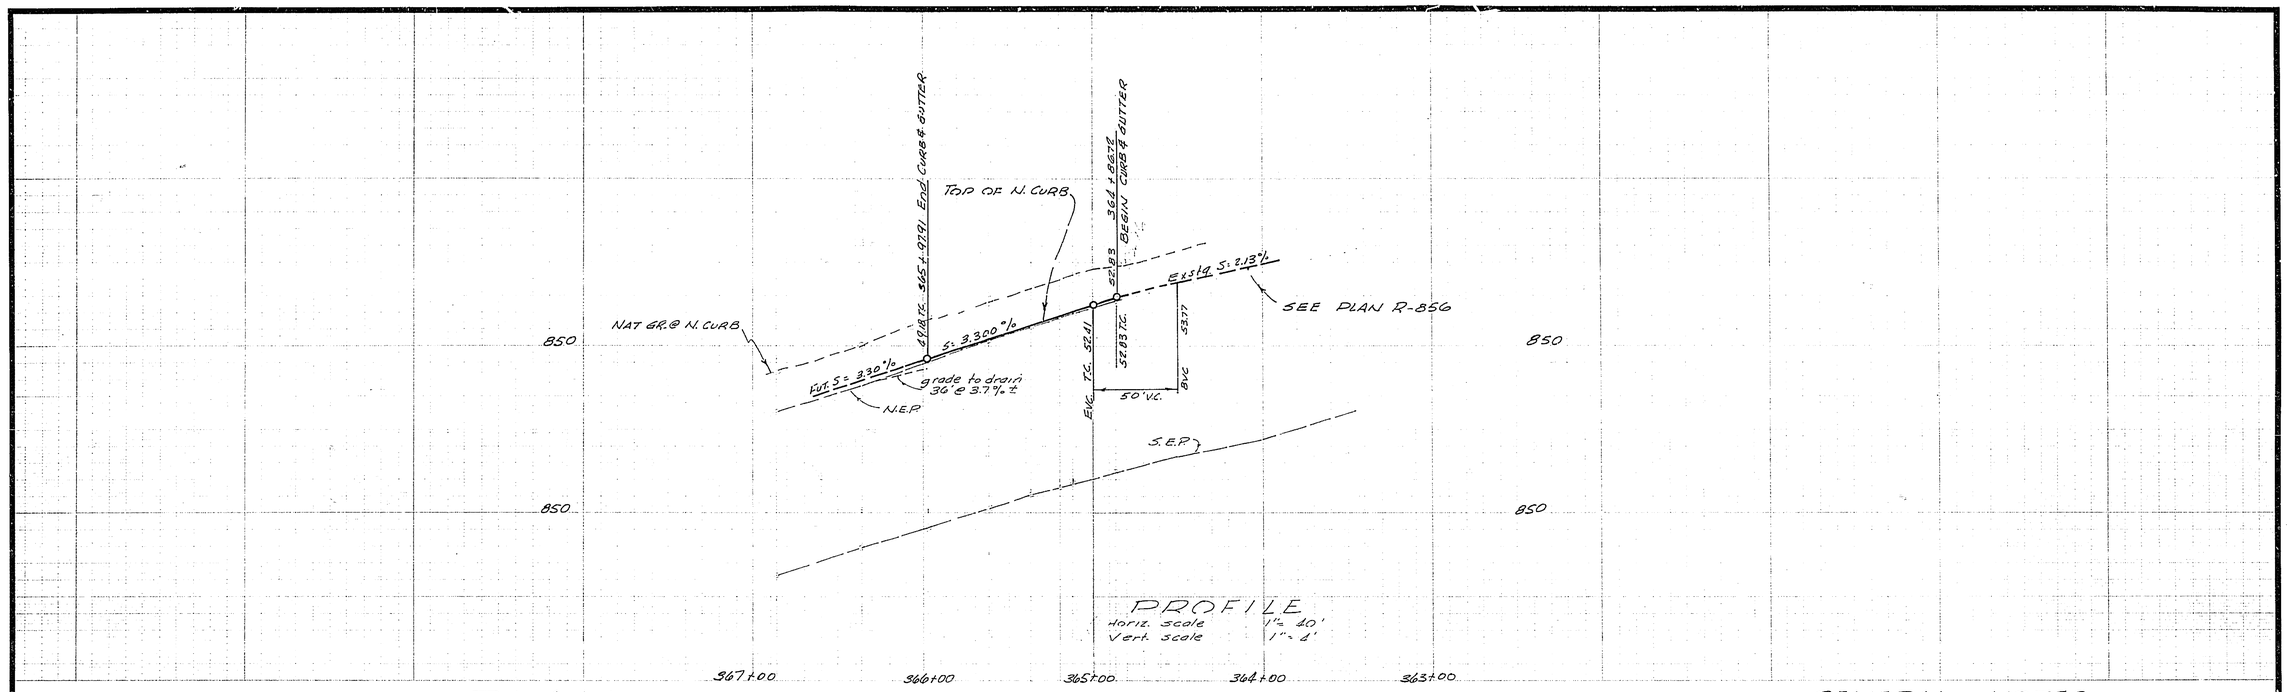

PROFILE
Horiz. scale 1" = 40'
Vert. scale 1" = 4'

PLAN
SCALE 1" = 40'

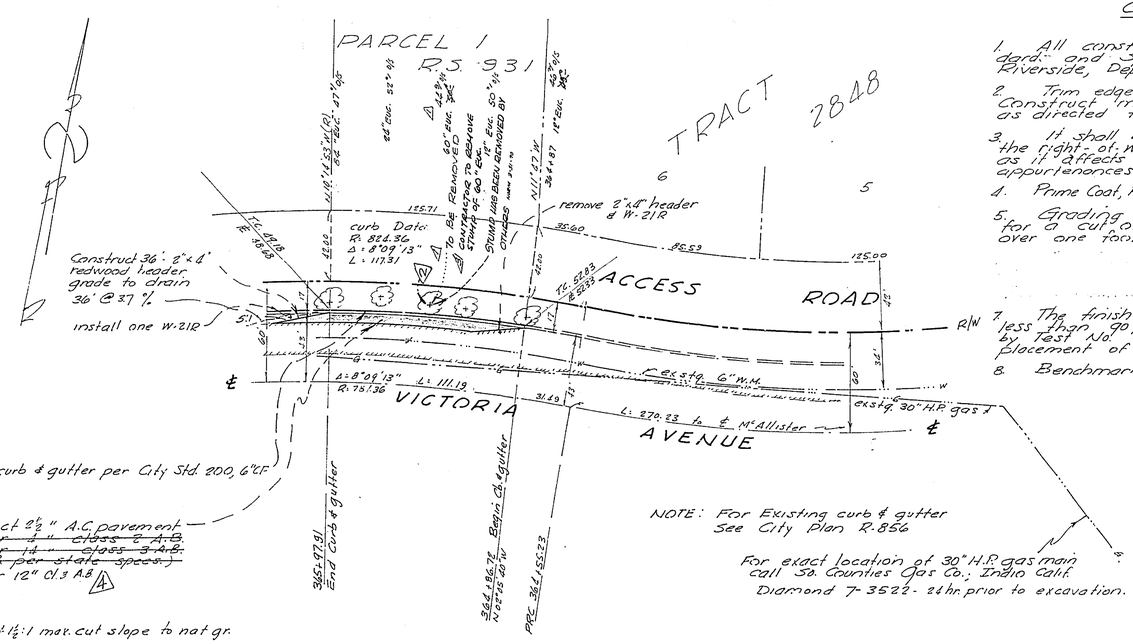

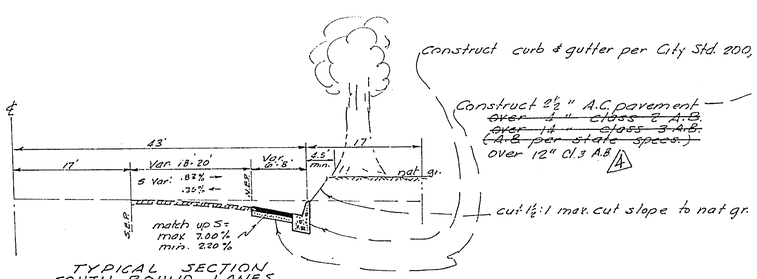

TYPICAL SECTION
SOUTH BOUND LANES
VICTORIA AVE
no scale
T1 = 7.0

GENERAL NOTES

1. All construction shall be in accordance with Standard and Specifications No. 461 of the City of Riverside, Department of Public Works.
2. Trim edge of pavement to clean straight line. Construct match up paving and overlay existing paving as directed to produce smooth crown section.
3. It shall be the responsibility of the Contractor to clear the right-of-way in accordance with the provisions of law as it affects each utility, including irrigation lines and appurtenances and at no cost to the City.
4. Prime Coat, Paint Binder and Seal Coat are required.
5. Grading will require a permit under Ordinance 3093 for a cut or fill exceeding 100 cubic yards or a fill over one foot in depth.
7. The finish subgrade shall have a compaction of not less than 90% for a depth of 0.5 feet as determined by Test No. "California 216 F" immediately prior to placement of cover.
8. Benchmark ~ chiseled X on F.H. flange; S.W. corner of McAllister @ Victoria Avenue El. 861.28

MARK	REVISIONS	APPR.	DATE
4	connect 0/1 to 60" E.V.C.; Note to be removed		
3	60" E.V.C. removed by City Forces 11/5/70		
2	Add Note "Contractor to remove stump of 60" E.V.C." per City Forces		
1	change base requirement to 12" Cl. 3 AB per Public Works Dept. Request		

DESIGNED BY ____ DRAWN BY ____ CHECKED BY ____

CITY OF RIVERSIDE, CALIFORNIA
DEPARTMENT OF PUBLIC WORKS

APPROVED BY	BY	DATE
OFFICE ENGINEER		12-7
PARK DEPARTMENT		12-2
TRAFFIC DIVISION		11-30
ASSISTANT CITY ENG.		12-7

APPROVED BY
DIRECTOR OF PUBLIC WORKS
DATE 12-7-65

S.R. 53 ; R = 12

PLAN AND PROFILE
N'WLY CURB - VICTORIA AVE
270' Westerly of McAllister Street

Approved: Robert L. Taylor RCE 10470 9/23/65

R.S. 931

PROJECT NO. R-1100

SHEET 1 OF 1

HORIZ. SCALE: 1" = 40 VERT. SCALE: 1" = 4

FILE NO.