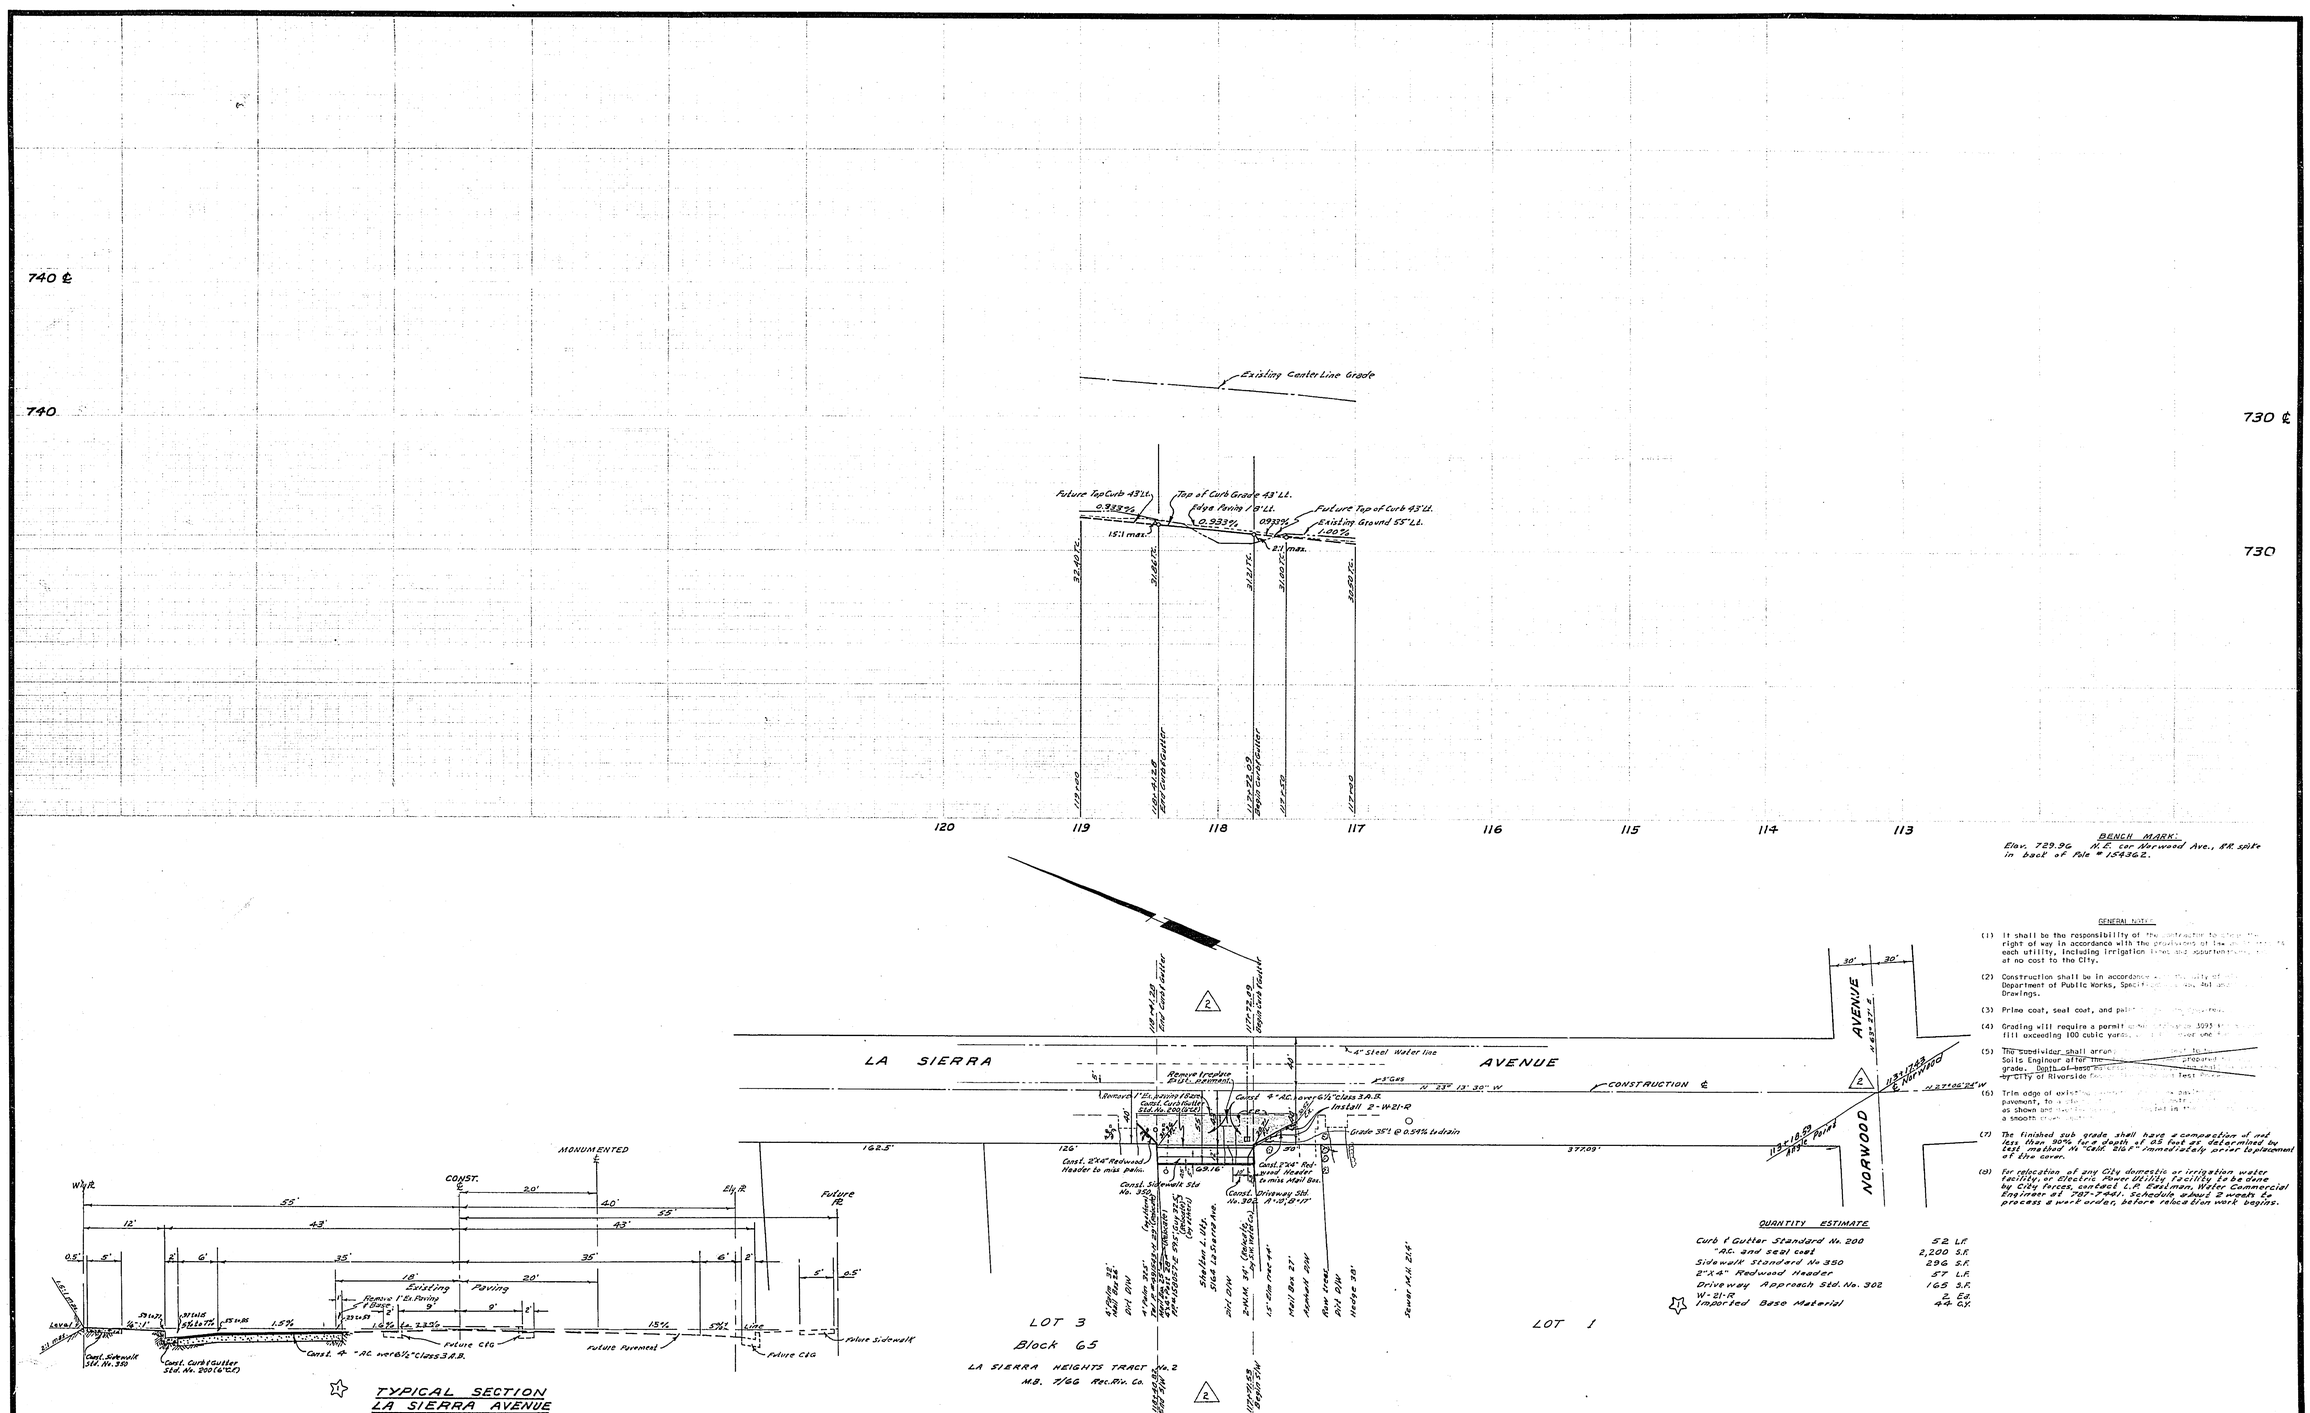

TYPICAL SECTION
LA SIERRA AVENUE
NO SCALE
T.1.7

BENCH MARK:
Elev. 729.96 N.E. cor Norwood Ave., B.R. spike in back of Pole # 154362.

GENERAL NOTES

(1) It shall be the responsibility of the contractor to [illegible] right of way in accordance with the provisions of law [illegible] each utility, including irrigation [illegible] at no cost to the City.

(2) Construction shall be in accordance [illegible] Department of Public Works, Spec[illegible] Drawings.

(3) Prime coat, seal coat, and pa[illegible]

(4) Grading will require a permit [illegible] fill exceeding 100 cubic yards, [illegible]

(5) The subdivider shall arran[illegible] Soils Engineer after the [illegible] grade. Depth of base [illegible] by City of Riverside [illegible] Test [illegible]

(6) Trim edge of exist[illegible] pavement, to [illegible] as shown and [illegible] a smooth [illegible]

(7) The finished sub grade shall have a compaction of not less than 90% for a depth of 85 feet as determined by test method No "Calif. 216 F" immediately prior to placement of the cover.

(8) For relocation of any City domestic or irrigation water facility, or Electric Power Utility facility to be done by City forces, contact L.P. Eastman, Water Commercial Engineer at 787-7441. Schedule about 2 weeks to process a work order, before relocation work begins.

QUANTITY ESTIMATE

Curb & Gutter Standard No. 200	52 L.F.
"A.C. and seal coat	2,200 S.F.
Sidewalk Standard No 350	296 S.F.
2"X4" Redwood Header	57 L.F.
Driveway Approach Std. No. 302	165 S.F.
W-21-R	2 Ea.
Imported Base Material	44 C.Y.

ALBERT A. WEBB ASSOCIATES
CIVIL ENGINEERS
RIVERSIDE, CALIFORNIA
APPROVED BY Ernest H. Webb DATE 10/18/65
R.E. No. 9876
W.O. 65-332 FOR: Shelton Utz F.B. 556

MARK	REVISIONS	APPR.	DATE
2	Revised Sta. & Added Begin & End Sta.	EHW	5-19-66
1	Added Base requirements	EHW	2-23-66

DESIGNED BY Gow DRAWN BY Gow CHECKED BY

CITY OF RIVERSIDE, CALIFORNIA
DEPARTMENT OF PUBLIC WORKS

APPROVED BY	BY	DATE
OFFICE ENGINEER	Wdg	1-19
PARK DEPARTMENT	—	—
TRAFFIC DIVISION	GO	1-11
ASSISTANT CITY ENG.	[illegible]	1-19
	Hans	1-11

APPROVED BY [signature]
DIRECTOR OF PUBLIC WORKS
DATE 1-19-66

STREET PLAN & PROFILE
LA SIERRA AVENUE
Between Norwood Ave. & Gramercy Pl.
West side 428'± North of Norwood Ave.
Shelton L. Utz
5164 La Sierra Avenue
HORIZ. SCALE: 1" = 50' VERT. SCALE: 1" = 5'

PROJECT NO. R-1110
SHEET 1 OF 1
FILE NO. 65-332-A