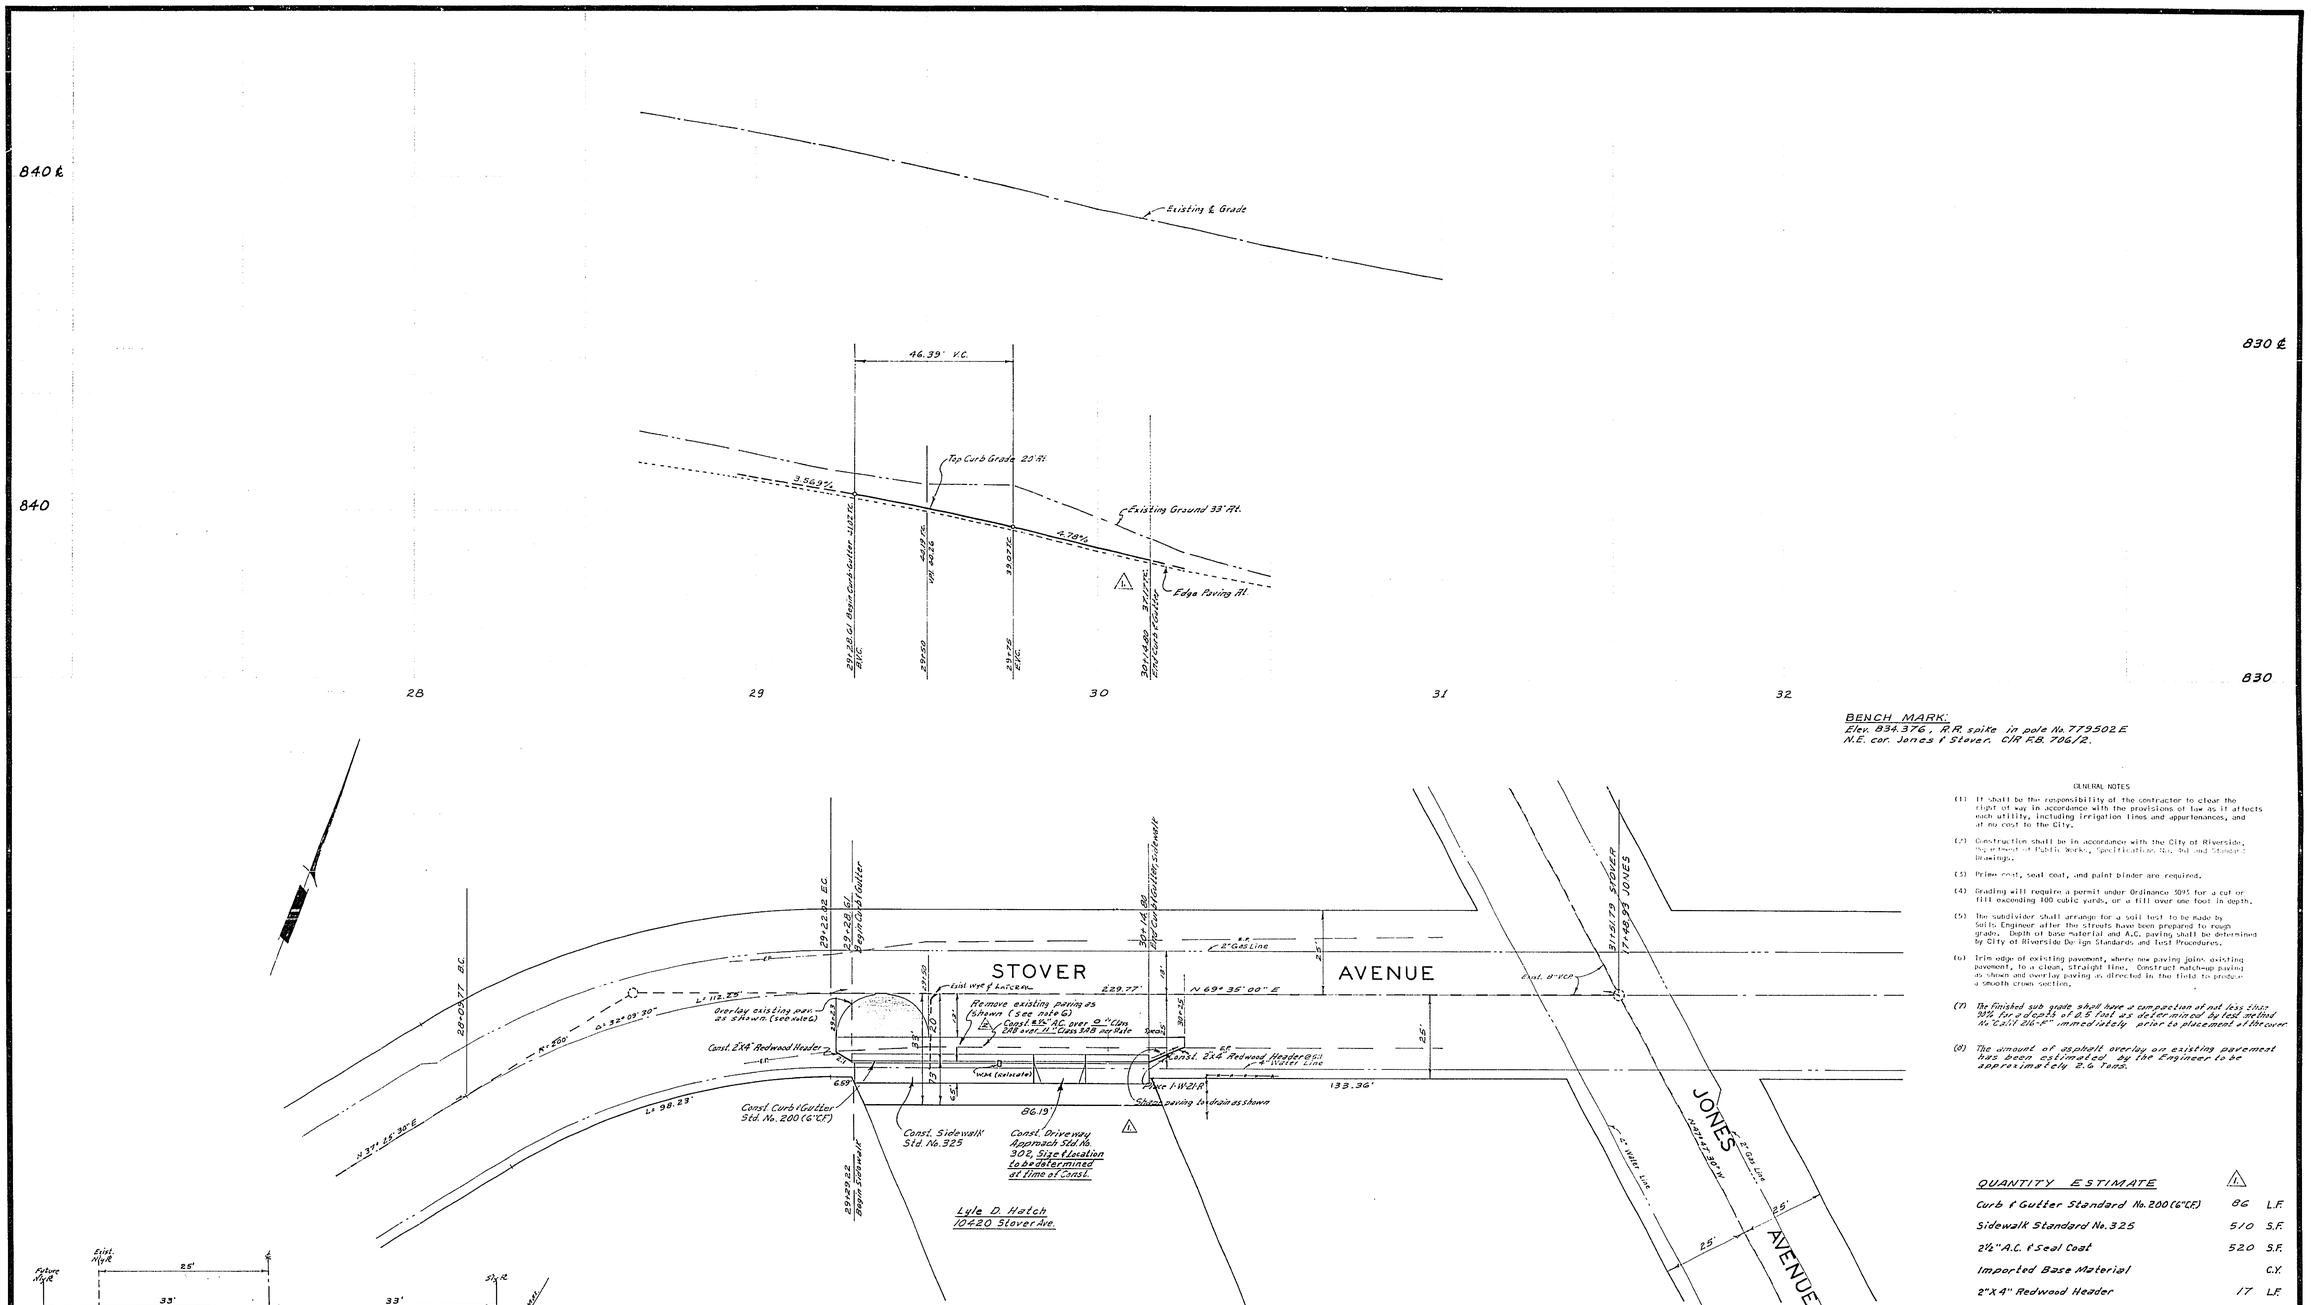

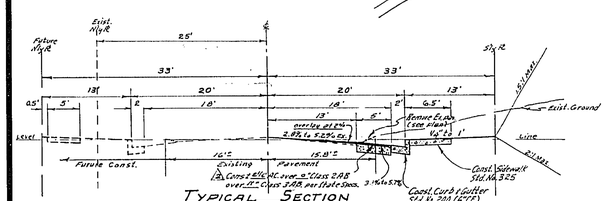

TYPICAL SECTION
STOVER AVENUE

NO SCALE
T.I. 6.0

BENCH MARK:
Elev. 834.376, R.R. spike in pole No. 779502 E
N.E. cor. Jones & Stover. C/R F.B. 706/2.

GENERAL NOTES

(1) It shall be the responsibility of the contractor to clear the right of way in accordance with the provisions of law as it affects each utility, including irrigation lines and appurtenances, and at no cost to the City.

(2) Construction shall be in accordance with the City of Riverside, Department of Public Works, Specifications No. 361 and Standard Drawings.

(3) Prime coat, seal coat, and paint binder are required.

(4) Grading will require a permit under Ordinance 5095 for a cut or fill exceeding 100 cubic yards, or a fill over one foot in depth.

(5) The subdivider shall arrange for a soil test to be made by Soils Engineer after the streets have been prepared to rough grade. Depth of base material and A.C. paving shall be determined by City of Riverside Design Standards and Test Procedures.

(6) Trim edge of existing pavement, where new paving joins existing pavement, to a clean, straight line. Construct match-up paving as shown and overlay paving as directed in the field to produce a smooth crown section.

(7) The finished sub grade shall have a compaction of not less than 90% for a depth of 0.5 foot as determined by test method No. C.A.L.T. 216-F" immediately prior to placement of the cover.

(8) The amount of asphalt overlay on existing pavement has been estimated by the Engineer to be approximately 2.6 Tons.

QUANTITY ESTIMATE	△1	
Curb & Gutter Standard No. 200 (6" C.F.)	86	L.F.
Sidewalk Standard No. 325	510	S.F.
2½" A.C. & Seal Coat	520	S.F.
Imported Base Material		C.Y.
2"X4" Redwood Header	17	L.F.
W-21-R	1	Ea.
Driveway Approach Standard No. 302	1	Ea.

SR # 692 R-18

ALBERT A. WEBB ASSOCIATES
CIVIL ENGINEERS
RIVERSIDE, CALIFORNIA
APPROVED BY [signature] DATE 4/20/66
R.E. No. 9876
W.O. 66-91 FOR: Lyle D. Hatch F.B. 556

MARK	REVISIONS	APPR.	DATE
2	ADDED STRUCTURAL SECTION	WDG	9-26-67
1	REVISED END CIG. STD., To correct Frontage	WDG	7-13-67

DESIGNED BY BJL DRAWN BY BEL CHECKED BY AL

CITY OF RIVERSIDE, CALIFORNIA
DEPARTMENT OF PUBLIC WORKS

APPROVED BY	BY	DATE
OFFICE ENGINEER	BER	6-17
PARK DEPARTMENT	—	—
TRAFFIC DIVISION	JED	6-16-66
ASSISTANT CITY ENG.	WDG	6-23
	Hans	6-16

APPROVED BY [signature]
DIRECTOR OF PUBLIC WORKS
DATE 6-24-66

STREET PLAN & PROFILE
STOVER AVENUE
The South Side, Between Jones Avenue and Chadbourne Avenue, 150' Westerly of Jones Avenue.
Lyle D. Hatch, 10420 Stover Avenue
HORIZ. SCALE: 1" = 20' VERT. SCALE: 1" = 4'

PROJECT NO. R-1164
SHEET 1 OF 1
FILE NO. 66-91-A