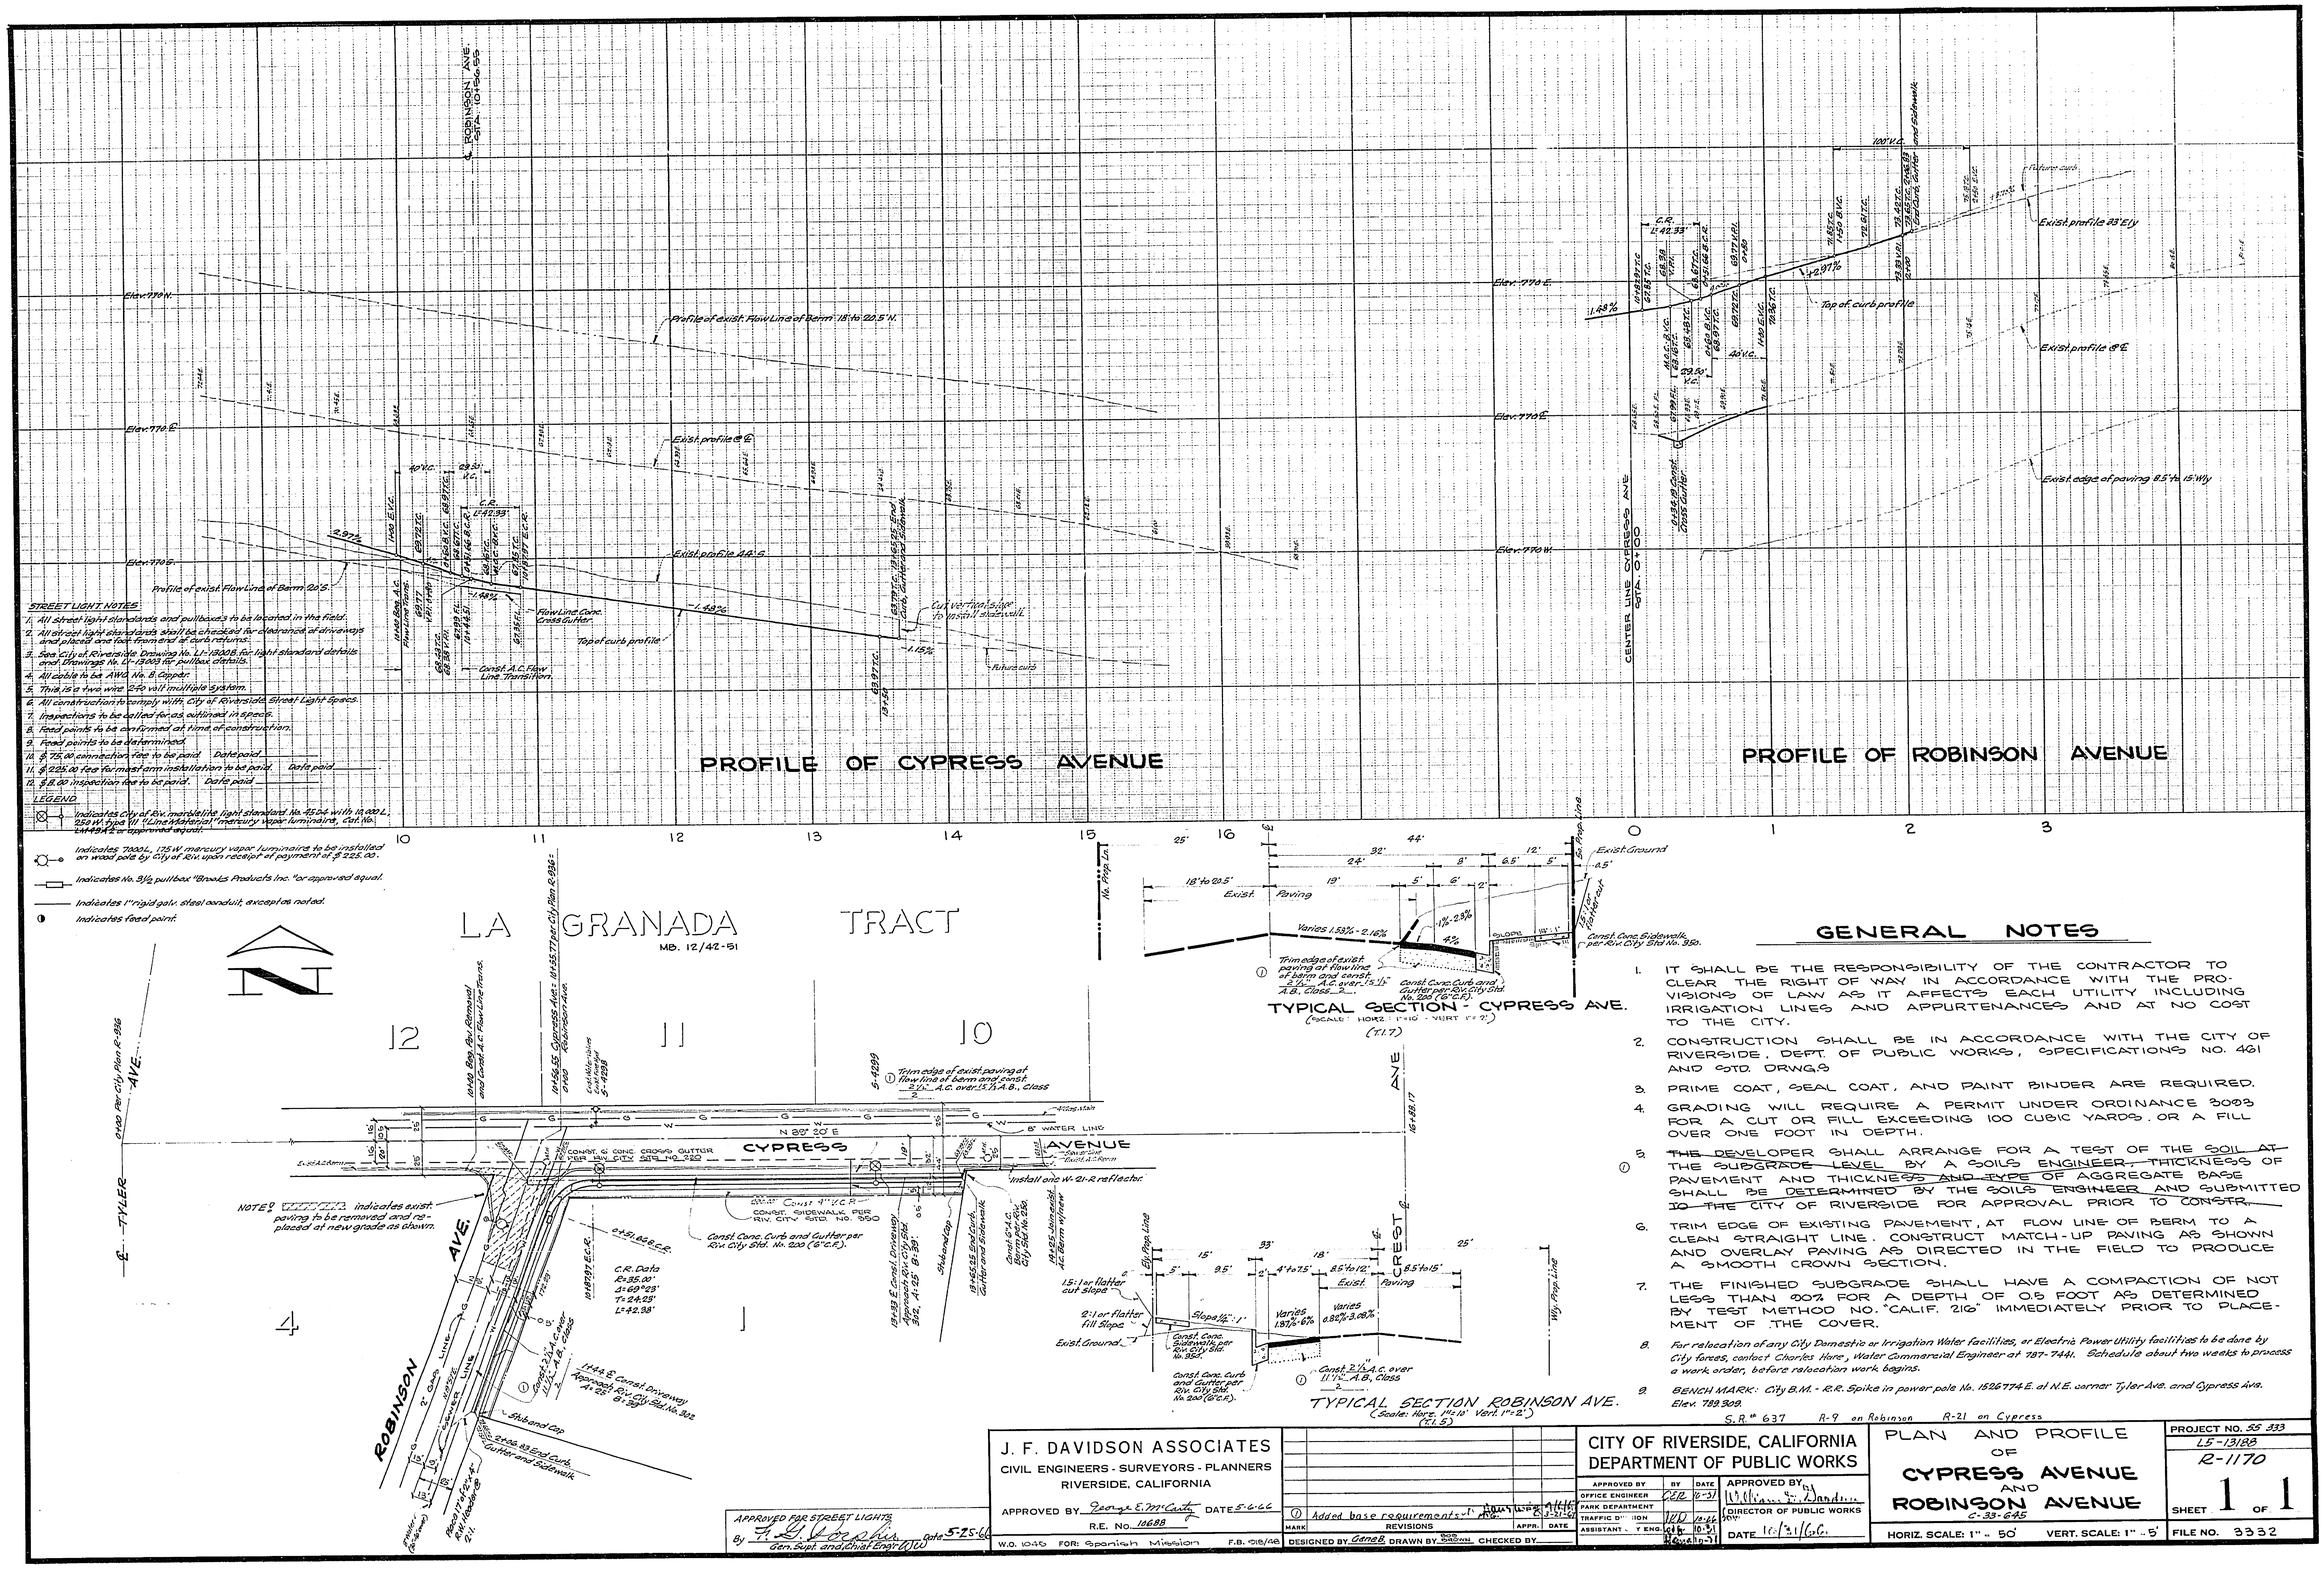

GENERAL NOTES

1. IT SHALL BE THE RESPONSIBILITY OF THE CONTRACTOR TO CLEAR THE RIGHT OF WAY IN ACCORDANCE WITH THE PROVISIONS OF LAW AS IT AFFECTS EACH UTILITY INCLUDING IRRIGATION LINES AND APPURTENANCES AND AT NO COST TO THE CITY.
2. CONSTRUCTION SHALL BE IN ACCORDANCE WITH THE CITY OF RIVERSIDE, DEPT. OF PUBLIC WORKS, SPECIFICATIONS NO. 461 AND STD. DRWGS.
3. PRIME COAT, SEAL COAT, AND PAINT BINDER ARE REQUIRED.
4. GRADING WILL REQUIRE A PERMIT UNDER ORDINANCE 3003 FOR A CUT OR FILL EXCEEDING 100 CUBIC YARDS, OR A FILL OVER ONE FOOT IN DEPTH.
5. ~~THE DEVELOPER SHALL ARRANGE FOR A TEST OF THE SOIL AT THE SUBGRADE LEVEL BY A SOILS ENGINEER. THICKNESS OF PAVEMENT AND THICKNESS AND TYPE OF AGGREGATE BASE SHALL BE DETERMINED BY THE SOILS ENGINEER AND SUBMITTED TO THE CITY OF RIVERSIDE FOR APPROVAL PRIOR TO CONSTR.~~
6. TRIM EDGE OF EXISTING PAVEMENT, AT FLOW LINE OF BERM TO A CLEAN STRAIGHT LINE. CONSTRUCT MATCH-UP PAVING AS SHOWN AND OVERLAY PAVING AS DIRECTED IN THE FIELD TO PRODUCE A SMOOTH CROWN SECTION.
7. THE FINISHED SUBGRADE SHALL HAVE A COMPACTION OF NOT LESS THAN 90% FOR A DEPTH OF 0.5 FOOT AS DETERMINED BY TEST METHOD NO. "CALIF. 216" IMMEDIATELY PRIOR TO PLACEMENT OF THE COVER.
8. *For relocation of any City Domestic or Irrigation Water facilities, or Electric Power Utility facilities to be done by City forces, contact Charles Hare, Water Commercial Engineer at 787-7441. Schedule about two weeks to process a work order, before relocation work begins.*
9. BENCH MARK: City B.M. - R.R. Spike in power pole No. 1526774 E. at N.E. corner Tyler Ave. and Cypress Ave. Elev. 789.909

S.R.M. 637 R-9 on Robinson R-21 on Cypress

APPROVED FOR STREET LIGHTS By F. L. Morris Gen. Supt. and Chief Engr. (W) Date 5-25-66

J. F. DAVIDSON ASSOCIATES
CIVIL ENGINEERS - SURVEYORS - PLANNERS
RIVERSIDE, CALIFORNIA

APPROVED BY George E. McCarty DATE 5-6-66
R.E. No. 16688
W.O. 1049 FOR: Spanish Mission F.B. 916/48

MARK	REVISIONS	APPR.	DATE
1	Added base requirements		8-31-66

DESIGNED BY Gene B. DRAWN BY Wm. Brown CHECKED BY

CITY OF RIVERSIDE, CALIFORNIA
DEPARTMENT OF PUBLIC WORKS

APPROVED BY	BY	DATE
OFFICE ENGINEER	CER	10-31
PARK DEPARTMENT		
TRAFFIC D'ION	TEW	10-66
ASSISTANT ... Y ENG.		10-31
		10-31

APPROVED BY William S. Sanders
DIRECTOR OF PUBLIC WORKS
DATE 10/31/66

PLAN AND PROFILE OF CYPRESS AVENUE AND ROBINSON AVENUE
C-33-645

HORIZ. SCALE: 1" = 50' VERT. SCALE: 1" = 5'

PROJECT NO. 55 333
L5-13188
R-1170
SHEET 1 OF 1
FILE NO. 3332