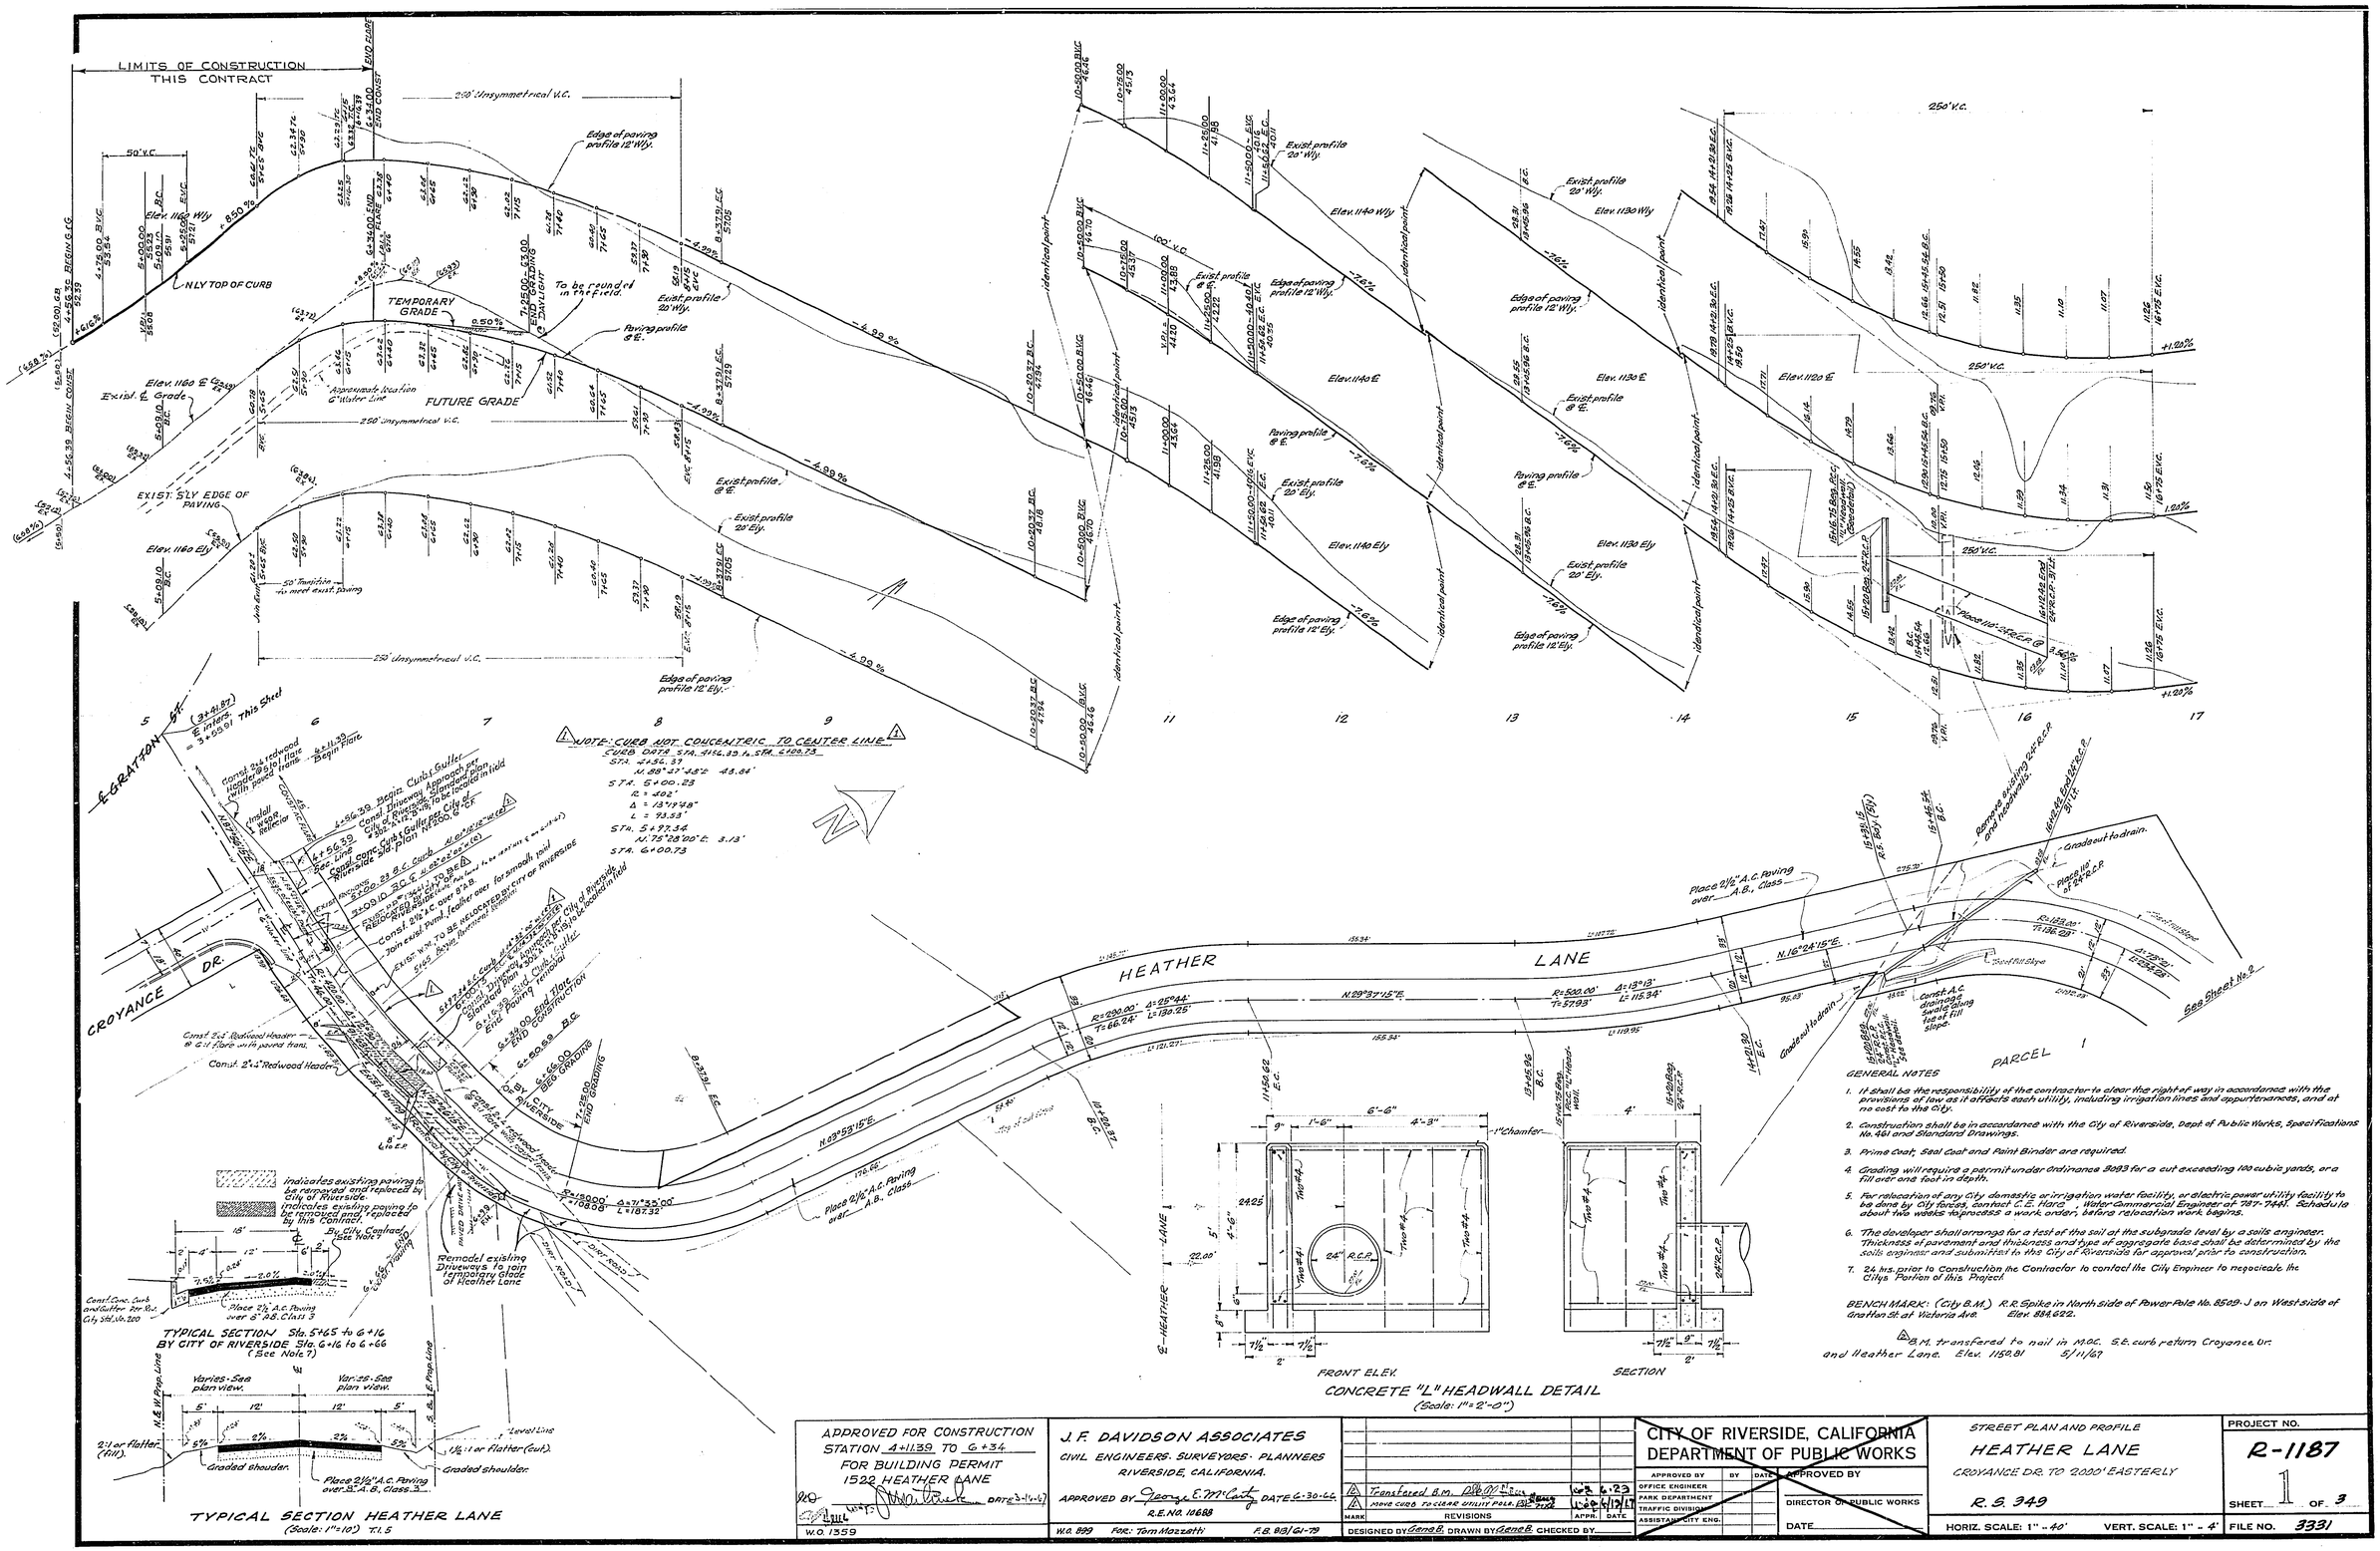

GENERAL NOTES

1. It shall be the responsibility of the contractor to clear the right of way in accordance with the provisions of law as it affects each utility, including irrigation lines and appurtenances, and at no cost to the City.
2. Construction shall be in accordance with the City of Riverside, Dept. of Public Works, Specifications No. 461 and Standard Drawings.
3. Prime Coat, Seal Coat and Paint Binder are required.
4. Grading will require a permit under Ordinance 8093 for a cut exceeding 100 cubic yards, or a fill over one foot in depth.
5. For relocation of any City domestic or irrigation water facility, or electric power utility facility to be done by City forces, contact C.E. Hare, Water Commercial Engineer at 787-7441. Schedule about two weeks to process a work order, before relocation work begins.
6. The developer shall arrange for a test of the soil at the subgrade level by a soils engineer. Thickness of pavement and thickness and type of aggregate base shall be determined by the soils engineer and submitted to the City of Riverside for approval prior to construction.
7. 24 hrs. prior to Construction the Contractor to contact the City Engineer to negociate the City's Portion of this Project.

BENCH MARK: (City B.M.) R.R. Spike in North side of Power Pole No. 8509-J on West side of Grafton St. at Victoria Ave. Elev. 884.622.

B.M. transfered to nail in M.O.C. S.E. curb return Croyance Dr. and Heather Lane. Elev. 1150.81 5/11/67

APPROVED FOR CONSTRUCTION
STATION 4+11.39 TO 6+34
FOR BUILDING PERMIT
1522 HEATHER LANE
DATE 3-14-67
W.O. 1359

J. F. DAVIDSON ASSOCIATES
CIVIL ENGINEERS · SURVEYORS · PLANNERS
RIVERSIDE, CALIFORNIA.
APPROVED BY George E. McCarty DATE 6-30-66
R.E. NO. 10688
W.O. 899 FOR: Tom Mazzetti F.B. 813/61-79

MARK	REVISIONS	APPR.	DATE
2	Transfered B.M.		6-23
1	Move curb to clear utility pole.		6/13/67

DESIGNED BY Gene B. DRAWN BY Gene B. CHECKED BY

CITY OF RIVERSIDE, CALIFORNIA
DEPARTMENT OF PUBLIC WORKS

APPROVED BY	BY	DATE
OFFICE ENGINEER		
PARK DEPARTMENT		
TRAFFIC DIVISION		
ASSISTANT CITY ENG.		

APPROVED BY
DIRECTOR OF PUBLIC WORKS
DATE

STREET PLAN AND PROFILE
HEATHER LANE
CROYANCE DR. TO 2000' EASTERLY
R.S. 349
HORIZ. SCALE: 1" = 40' VERT. SCALE: 1" = 4'

PROJECT NO. R-1187
SHEET 1 OF 3
FILE NO. 3331