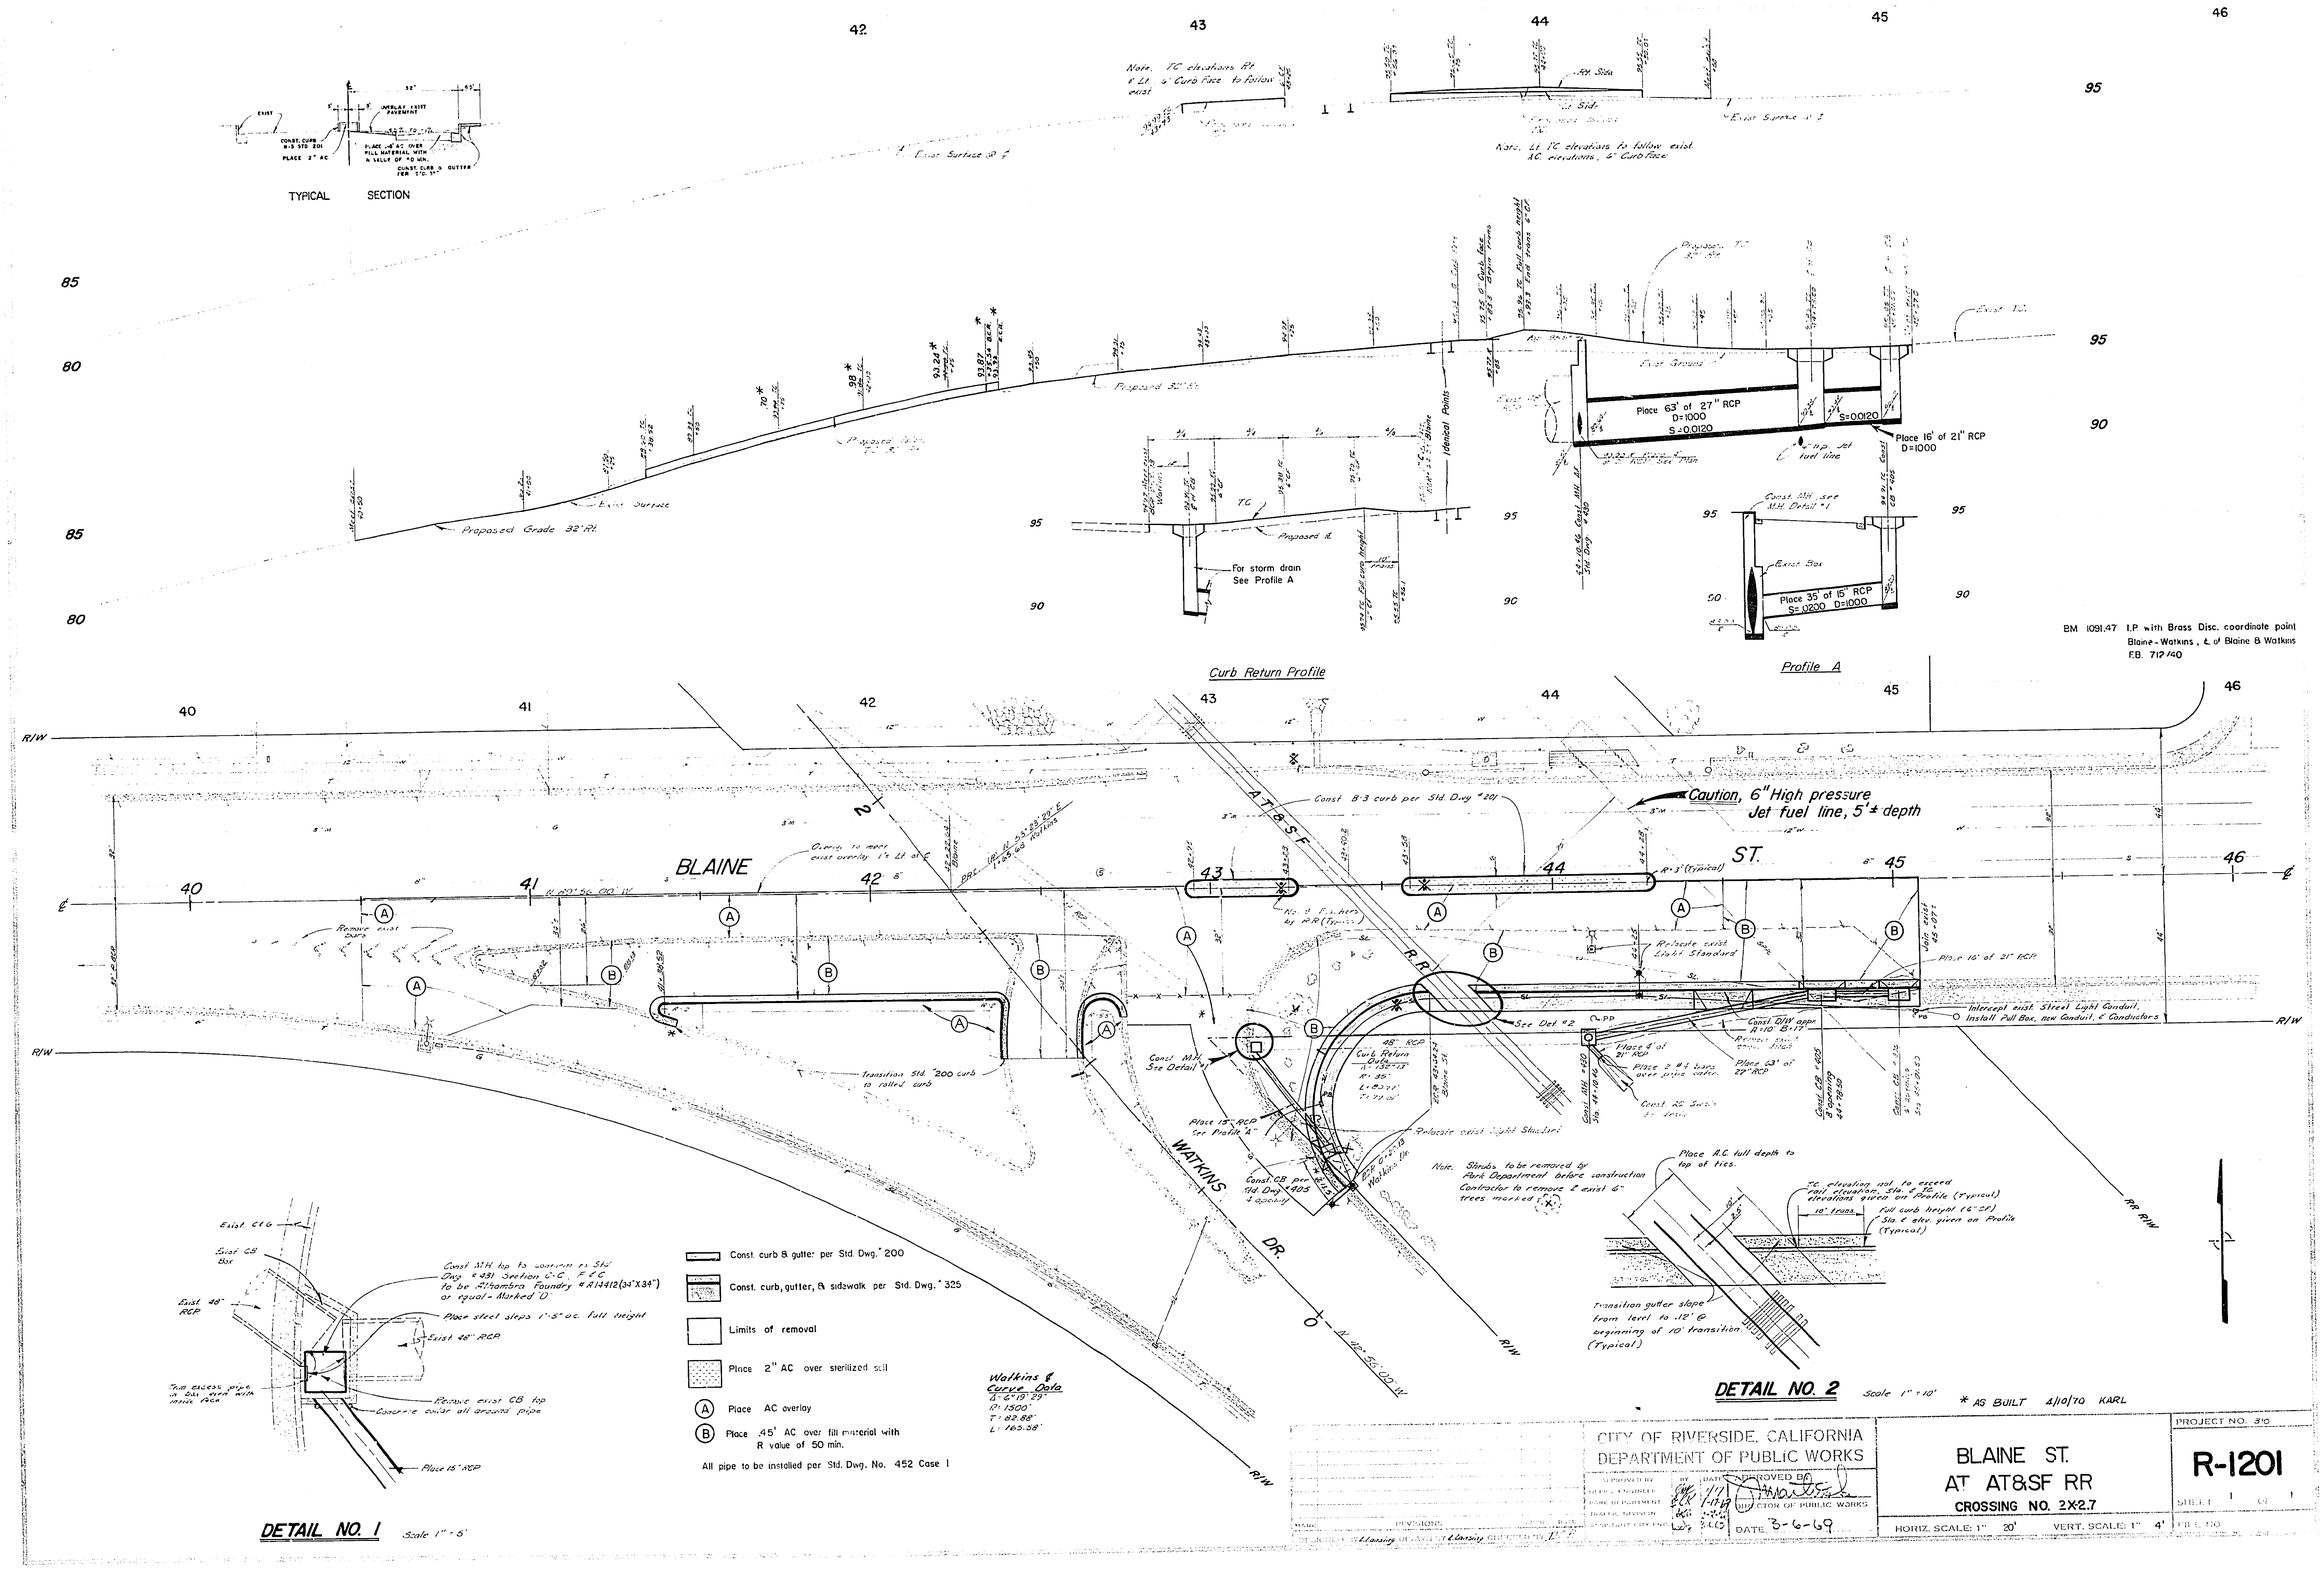

CITY OF RIVERSIDE, CALIFORNIA
DEPARTMENT OF PUBLIC WORKS

APPROVED BY
DIRECTOR OF PUBLIC WORKS
DATE 3-6-69

BLAINE ST.
AT AT&SF RR
CROSSING NO. 2X2.7

HORIZ. SCALE: 1" 20' VERT. SCALE: 1" 4'

PROJECT NO. 310
R-1201
SHEET 1 OF 1
FILE NO.