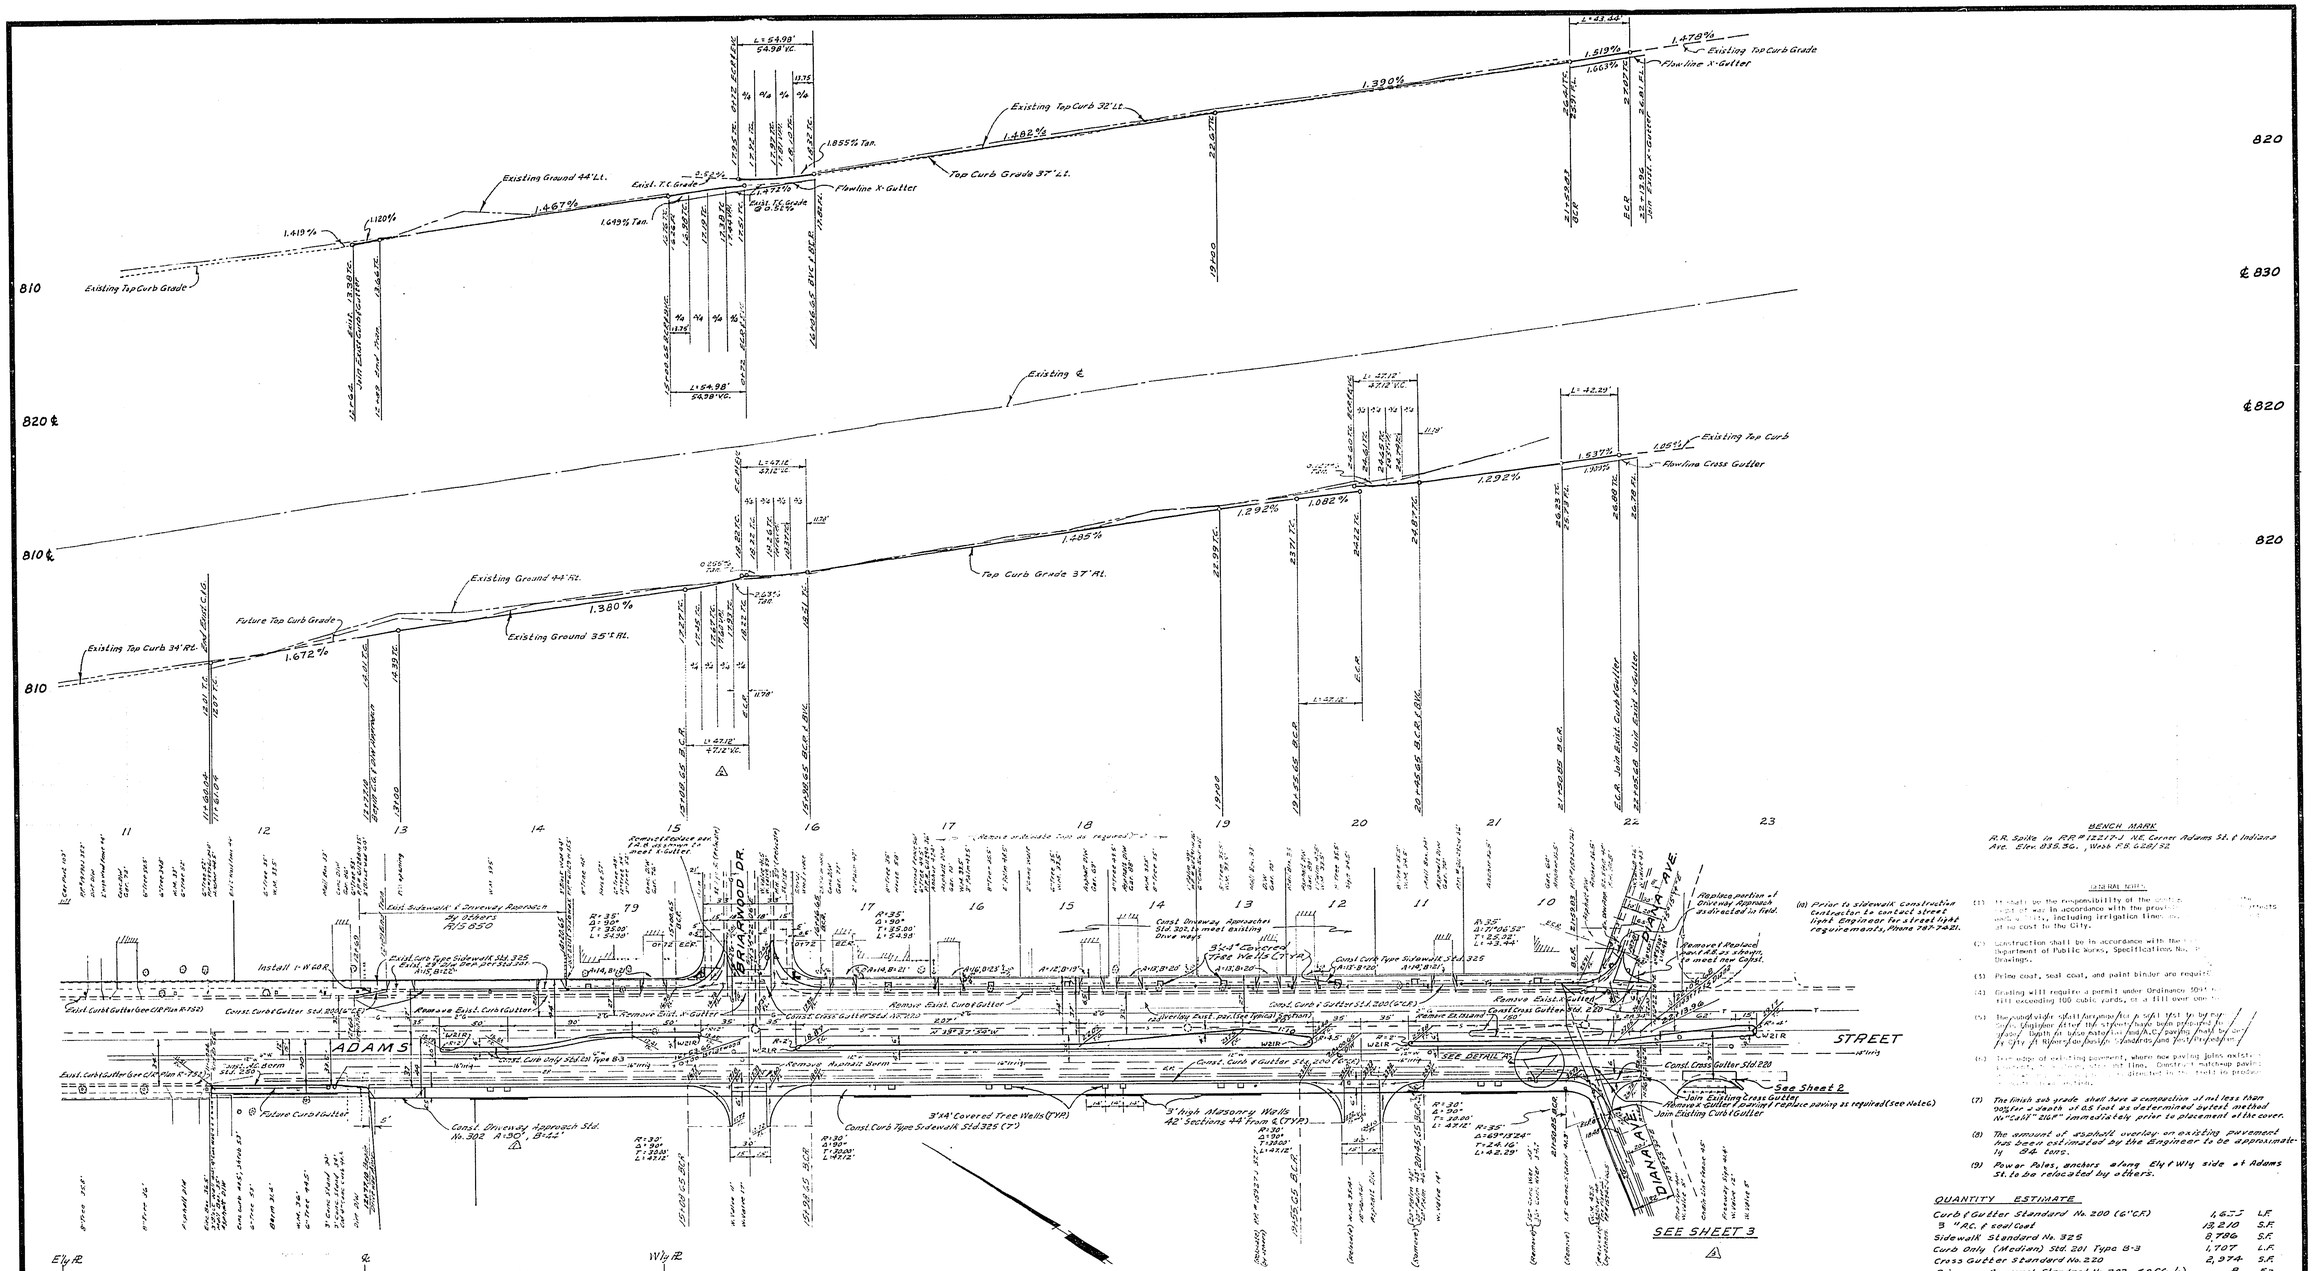

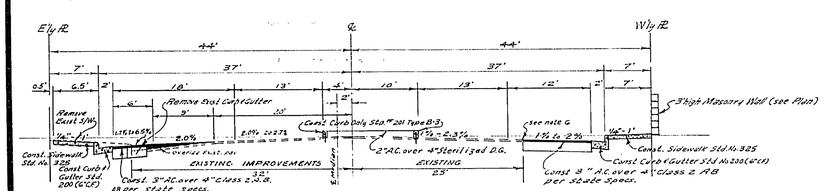

TYPICAL SECTION
ADAMS STREET
NOT TO SCALE
T.I. 7.0

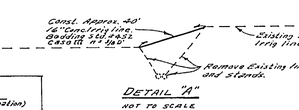

DETAIL "A"
NOT TO SCALE

CAUTION: UNDERGROUND TEL. CABLE
24 hours prior to working in area of Tel. cable, Phone 684-0071.

BENCH MARK
R.R. Spike in R.R. # 12212-J N.E. Corner Adams St. & Indiana Ave. Elev. 835.36, Wash F.B. 628/32

GENERAL NOTES

(1) It shall be the responsibility of the contractor to see that work is in accordance with the grading plan, including irrigation lines, at no cost to the City.

(2) Construction shall be in accordance with the Department of Public Works, Specifications No. ... Drawings.

(3) Prime coat, seal coat, and paint binder are required.

(4) Grading will require a permit under Ordinance 509 ... fill exceeding 100 cubic yards, or a fill over one ...

(5) The curb right of way line shall be set ... City Engineer. After the street has been graded to ... depth in new material, the curb and gutter shall be ... by the City of Riverside Standards and Specifications.

(6) Trim edge of existing pavement, where new paving joins existing ... time. Construct match-up paving ... to be placed to be built in protection ...

(7) The finish sub grade shall have a compaction of not less than 90% for a depth of 6.5 feet as determined current method No. "Cal" 216-F immediately prior to placement of the cover.

(8) The amount of asphalt overlay on existing pavement has been estimated by the Engineer to be approximately 84 tons.

(9) Power Poles, anchors along Ely & Wly side of Adams St. to be relocated by others.

(a) Prior to sidewalk construction Contractor to contact Street Light Engineer for street light requirements, Phone 787-7421.

QUANTITY ESTIMATE

Curb & Gutter Standard No. 200 (6" CF)	1,655	L.F.
3" A.C. & seal Coat	12,210	S.F.
Sidewalk Standard No. 325	8,786	S.F.
Curb Only (Median) Std. 201 Type B-3	1,707	L.F.
Cross Gutter Standard No. 220	2,974	S.F.
Driveway Approach Standard No. 302 (Offsite)	8	Ea.
A.C. Berm Standard No. 250	117	L.F.
Imported Base Material	163	C.Y.
Curb & Gutter Removal	955	L.F.
Cross Gutter Removal	1,384	S.F.
16" Conc. Irrig. pipe	40±	L.F.
W-60-R	1	Ea.
Sidewalk Removal	3,705	S.F.
Sidewalk Standard No. 350	3,325	S.F.
Driveway Approach Standard No. 302 (Onsite)	3	Ea.
Driveway Approach With R=12' (Diana Ave)	2	Ea.

APPROVED BY Leonard R. Crusan
GEN. SUPERVISING ENGINEER (Irrigation)
DATE 12-7-66

ALBERT A. WEBB ASSOCIATES
CIVIL ENGINEERS
RIVERSIDE, CALIFORNIA
APPROVED BY Donald N. Webb DATE 10/6/67
R.E. No. 9876
W.O. 66-215 FOR: HYROSEN PROPERTIES INC. F.B. 628

MARK	REVISIONS	APPR.	DATE
3	Added Sheet 3 of 3 (Diana Ave.)		
2	Revised grade of Sta Return to match Plot Plan		
1	Drive increased to 30'to match Plot Plan		

DESIGNED BY BEL DRAWN BY BEL CHECKED BY

CITY OF RIVERSIDE, CALIFORNIA
DEPARTMENT OF PUBLIC WORKS

	BY	DATE
APPROVED BY		
OFFICE ENGINEER		10-3
PARK DEPARTMENT		10-9
TRAFFIC DIVISION		9-25
ASSISTANT CITY ENG.		10-6

APPROVED BY
DIRECTOR OF PUBLIC WORKS
DATE 10/10/67

STREET PLAN & PROFILE
ADAMS STREET
DIANA AVENUE 1000'± N'ly
R-102-645

HORIZ. SCALE: 1" = 50' VERT. SCALE: 1" = 5'

PROJECT NO. SS. 3-45
R-1202
SHEET 1 OF 3
FILE NO. 66-215-A

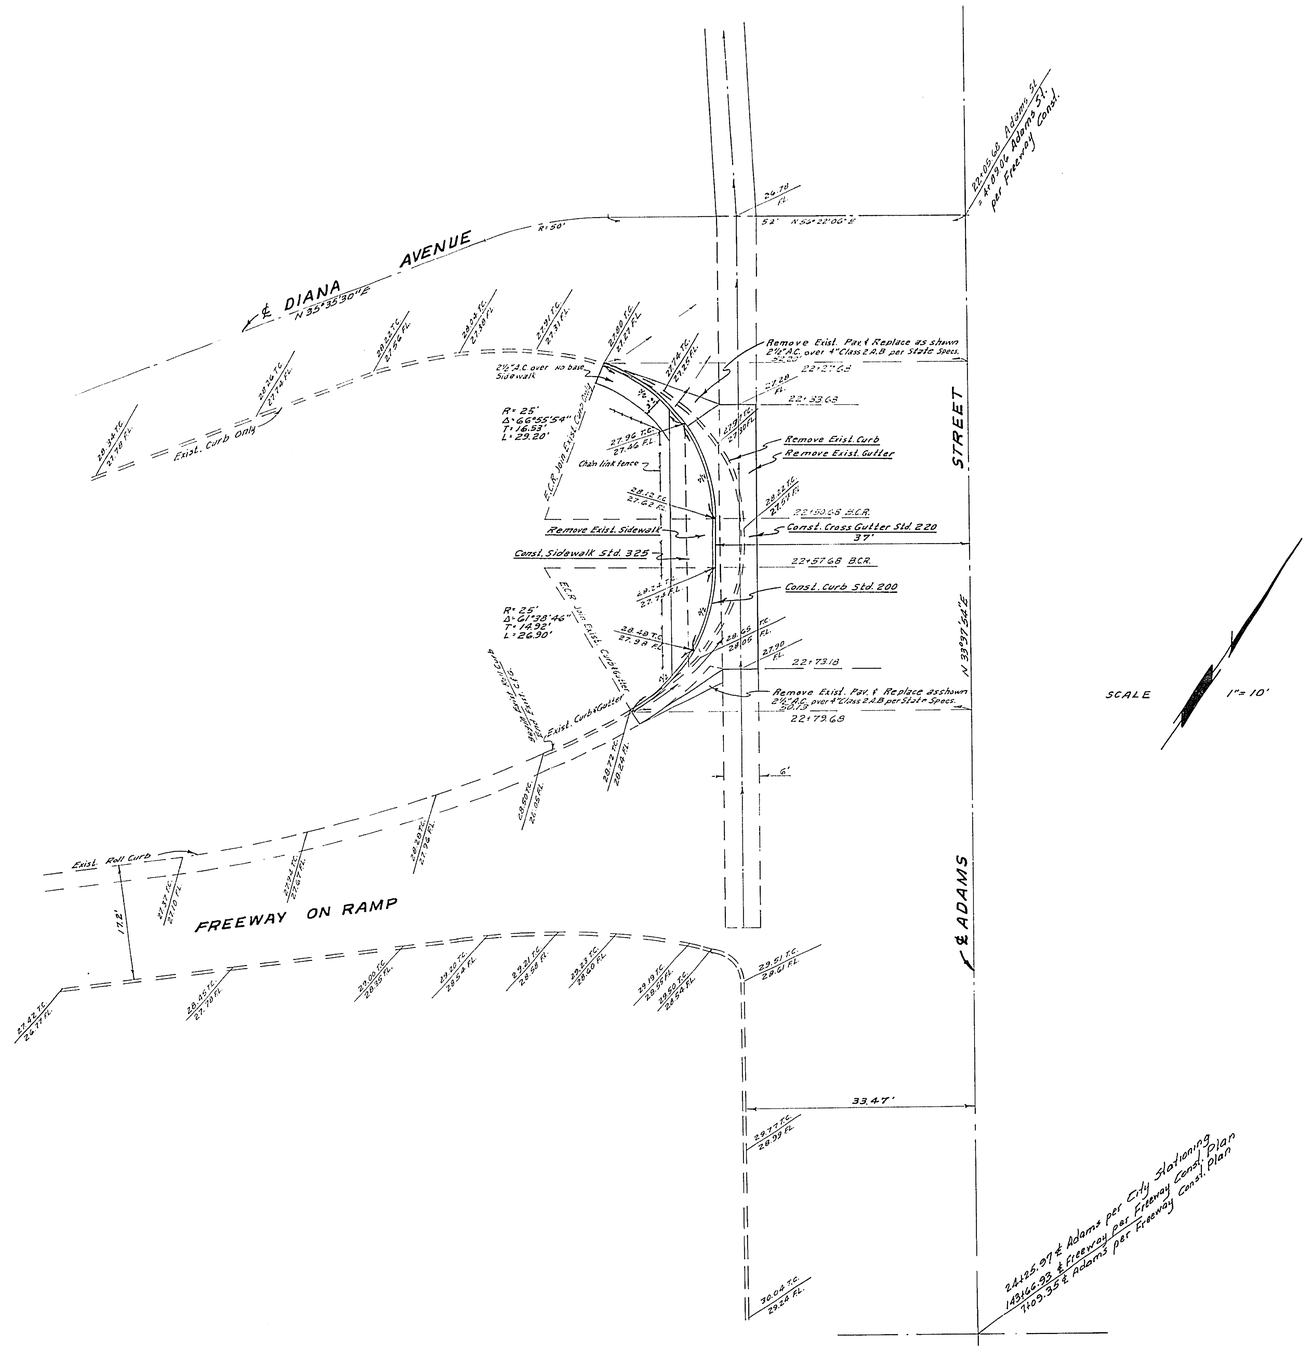

NOTE:

State Division of Highway requirements per encroachment permit No. 867E 761643 shall apply to construction from 5th to 5th ADAMS ST.

Contractor to notify State Highway Dept. at TU9-8511 in San Bernardino 24 hours prior to construction. Inspector - R. O. NORTON Phone 686-3646.

Expiration Date is DECEMBER 29, 1967.

ALBERT A. WEBB ASSOCIATES
CIVIL ENGINEERS
RIVERSIDE, CALIFORNIA

APPROVED BY [signature] DATE 10/6/67
R.E. No. 9876

W.O. 66-215 FOR: HYROSEN PROPERTIES INC. F.B. 628

MARK	REVISIONS	APPR.	DATE

DESIGNED BY BEL DRAWN BY BEL CHECKED BY REC

CITY OF RIVERSIDE, CALIFORNIA
DEPARTMENT OF PUBLIC WORKS

APPROVED BY	BY	DATE
OFFICE ENGINEER	[signature]	10-3
PARK DEPARTMENT		
TRAFFIC DIVISION	[signature]	9/25
ASSISTANT CITY ENG.	[signature]	10-6

APPROVED BY [signature]
DIRECTOR OF PUBLIC WORKS
DATE 10/10/67

STREET PLAN
ADAMS STREET
Westerly side, Between Diana Ave. & On Ramp
R-102-645
~~HORIZ.~~ SCALE: 1" = 10' ~~VERT. SCALE: 1"~~

PROJECT NO. R-1202
SHEET 2 OF 3
FILE NO. 66-215-A

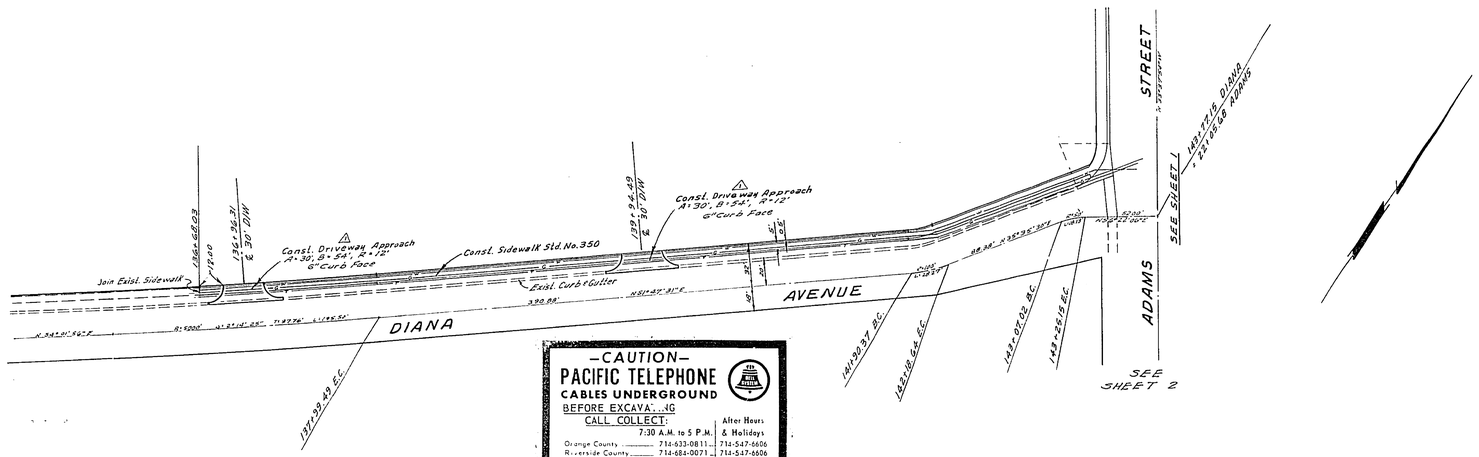

-CAUTION-
PACIFIC TELEPHONE
CABLES UNDERGROUND
BEFORE EXCAVATING
CALL COLLECT:

	7:30 A.M. to 5 P.M.	After Hours & Holidays
Orange County	714-633-0811	714-547-6606
Riverside County	714-684-0071	714-547-6606
Inyo County	714-684-0071	714-547-6606
San Bernardino County	714-684-0071	714-547-6606
Los Angeles County	213-621-3111	24 HOUR SERVICE
Ventura County	213-621-3111	
San Diego County	714-298-0595	714-232-0027

FOR FREE CABLE LOCATING SERVICE

ALBERT A. WEBB ASSOCIATES
CIVIL ENGINEERS
RIVERSIDE, CALIFORNIA
APPROVED BY Ernest N. Webb DATE 12/5/67
R.E. No. 9876
W.O. 66-215 FOR: HYROSEN PROPERTIES INC. F.B. 628

MARK	REVISIONS	APPR.	DATE
1	Revised dies to return type		66-68

DESIGNED BY BEL DRAWN BY BEL CHECKED BY

CITY OF RIVERSIDE, CALIFORNIA
DEPARTMENT OF PUBLIC WORKS

APPROVED BY	BY	DATE
OFFICE ENGINEER		12-14
PARK DEPARTMENT	—	—
TRAFFIC DIVISION		12-11
ASSISTANT CITY ENG.		12-15
		12-11

APPROVED BY
DIRECTOR OF PUBLIC WORKS
DATE 12-15-67

SIDEWALK & DRIVEWAY PLAN
DIANA AVENUE
N. SIDE - ADAMS ST. TO 700'± W'LY
R-102-645
HORIZ. SCALE: 1" = 50' VERT. SCALE: 1" =

PROJECT NO.
R-1202
SHEET 3 OF 3
FILE NO. 66-215-A