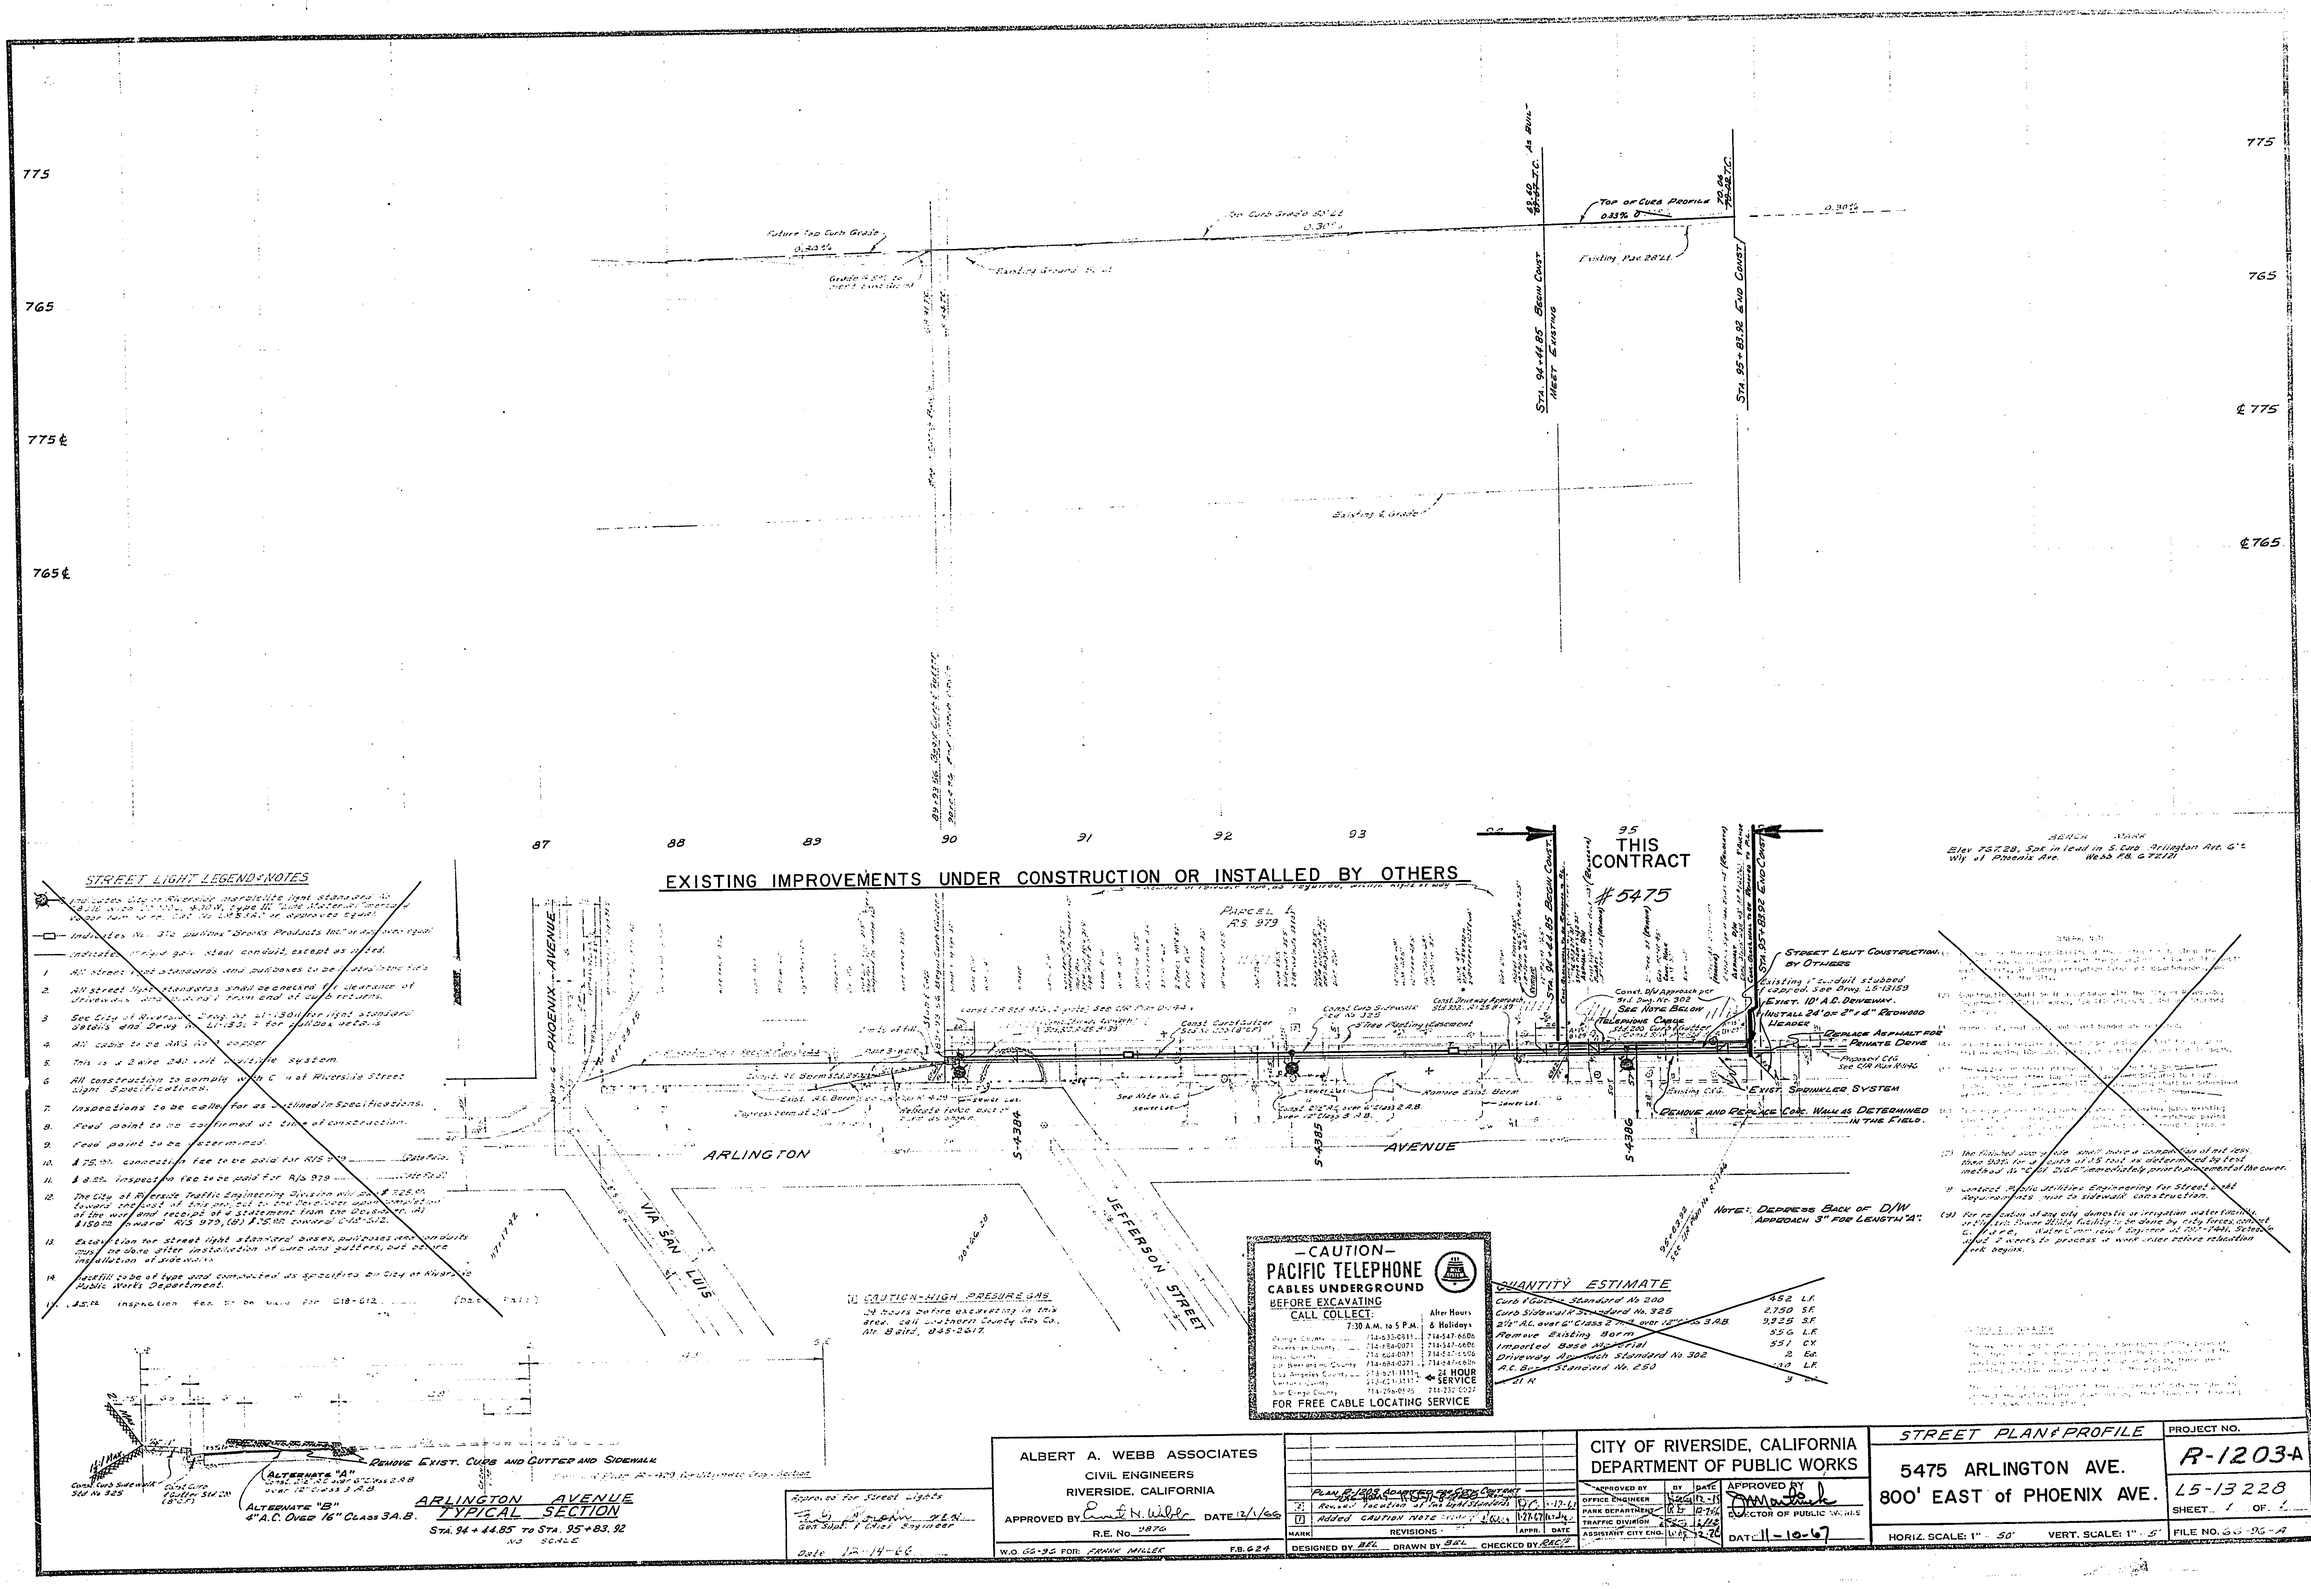

STREET LIGHT LEGEND & NOTES

- Indicates City of Riverside marbelite light standard No. 8 [illegible] with [illegible] 400 W, type III "Line Material" [illegible] [illegible] Lot No. [illegible] or approved equal.
- Indicates No. 3½ pullbox "Brooks Products Inc." or approved equal.
- Indicates 1" rigid galv. steel conduit, except as noted.

1. All street light standards and pullboxes to be installed in the field.
2. All street light standards shall be checked for clearance of driveways and placed 1 from end of curb returns.
3. See City of Riverside Drwg. No. L1-1301 for light standard details and Drwg. No. L1-1302 for pullbox details.
4. All cable to be AWG No. 4 copper.
5. This is a 2 wire 240 volt multiple system.
6. All construction to comply with City of Riverside Street Light Specifications.
7. Inspections to be called for as outlined in Specifications.
8. Feed point to be confirmed at time of construction.
9. Feed point to be determined.
10. $ 75.00 connection fee to be paid for R/S 979 (Date Paid)
11. $ 8.00 inspection fee to be paid for R/S 979 (Date Paid)
12. The City of Riverside Traffic Engineering Division will pay $ 225.00 toward the cost of this project to the Developer upon completion of the work and receipt of a statement from the Developer. (A) $150.00 toward R/S 979, (B) $75.00 toward C-18-612.
13. Excavation for street light standard bases, pullboxes and conduits must be done after installation of curb and gutters, but before installation of sidewalks.
14. Backfill to be of type and compacted as specified by City of Riverside Public Works Department.
15. $5.00 inspection fee to be paid for C18-612 (Date Paid)

ARLINGTON AVENUE
TYPICAL SECTION
Sta. 94+44.85 to Sta. 95+83.92
NO SCALE

CAUTION-HIGH PRESURE GAS
24 hours before excavating in this area, call Southern County Gas Co., Mr. Baird, 845-2617.

-CAUTION-
PACIFIC TELEPHONE
CABLES UNDERGROUND
BEFORE EXCAVATING
CALL COLLECT:
7:30 A.M. to 5 P.M. — After Hours & Holidays
Orange County 714-633-0311 — 714-547-6606
Riverside County 714-684-0071 — 714-547-6606
Imp. County 714-684-0071 — 714-547-6606
San Bernardino County 714-684-0071 — 714-547-6606
Los Angeles County 213-621-1111 — 24 HOUR SERVICE
Ventura County 213-621-1111 — 24 HOUR SERVICE
San Diego County 714-296-0595 — 714-232-0027
FOR FREE CABLE LOCATING SERVICE

QUANTITY ESTIMATE

Curb & Gutter Standard No. 200	452 L.F.
Curb Sidewalk Standard No. 325	2,750 S.F.
2½" A.C. over 6" Class 2 A.B. over 12" Class 3 A.B.	9,925 S.F.
Remove Existing Berm	556 L.F.
Imported Base Material	551 C.Y.
Driveway Approach Standard No. 302	2 Ea.
A.C. Berm Standard No. 250	100 L.F.
[illegible]	3 [illegible]

Approved for Street Lights
[signature]
Gen. Supt. & Chief Engineer
Date 12-14-66

ALBERT A. WEBB ASSOCIATES
CIVIL ENGINEERS
RIVERSIDE, CALIFORNIA
APPROVED BY [signature] DATE 12/1/66
R.E. No. 9876
W.O. 66-96 FOR: FRANK MILLER F.B. 624

PLAN R-1203 ADAPTED FOR CITY CONTRACT
Revised location of the Light Standards
Added caution note
MARK — REVISIONS — APPR. — DATE
DESIGNED BY BEL DRAWN BY BEL CHECKED BY RACH

CITY OF RIVERSIDE, CALIFORNIA
DEPARTMENT OF PUBLIC WORKS

APPROVED BY	BY	DATE
OFFICE ENGINEER	[illegible]	12-15
PARK DEPARTMENT	[illegible]	12-16
TRAFFIC DIVISION	[illegible]	12-16
ASSISTANT CITY ENG.	[illegible]	12-26

APPROVED BY [signature]
DIRECTOR OF PUBLIC WORKS
DATE 11-10-67

STREET PLAN & PROFILE
5475 ARLINGTON AVE.
800' EAST of PHOENIX AVE.
HORIZ. SCALE: 1" = 50' VERT. SCALE: 1" = 5'

PROJECT NO. R-1203-A
L5-13228
SHEET 1 OF 1
FILE NO. 66-96-A