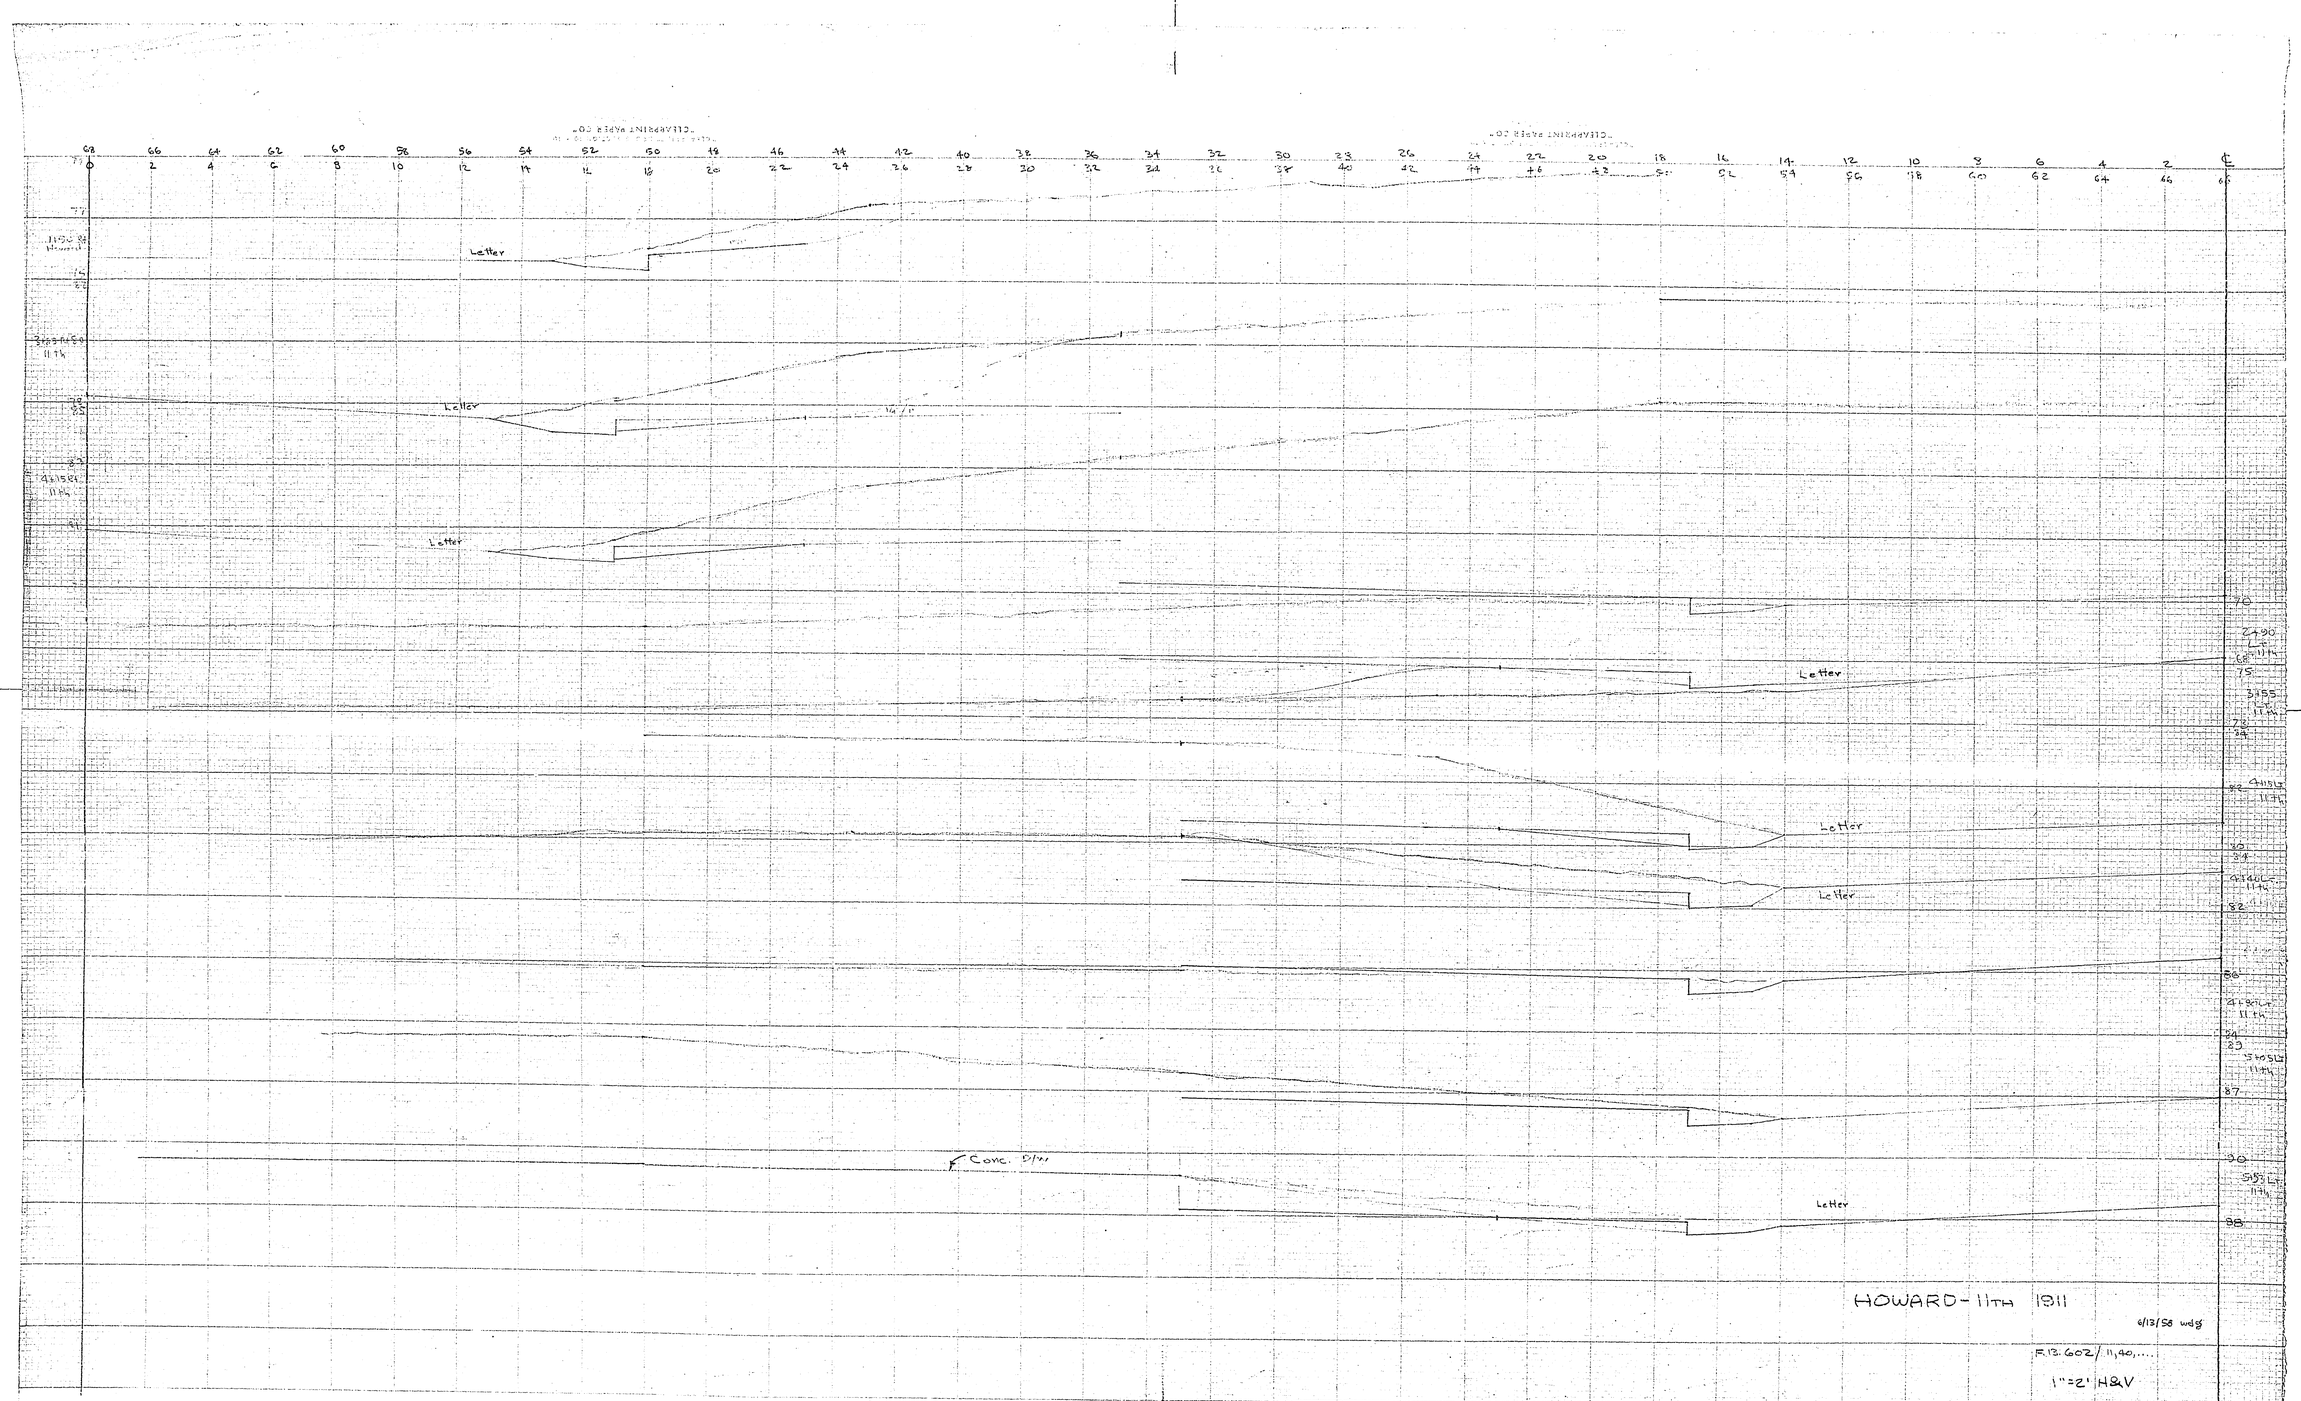

FILE WITH R-121

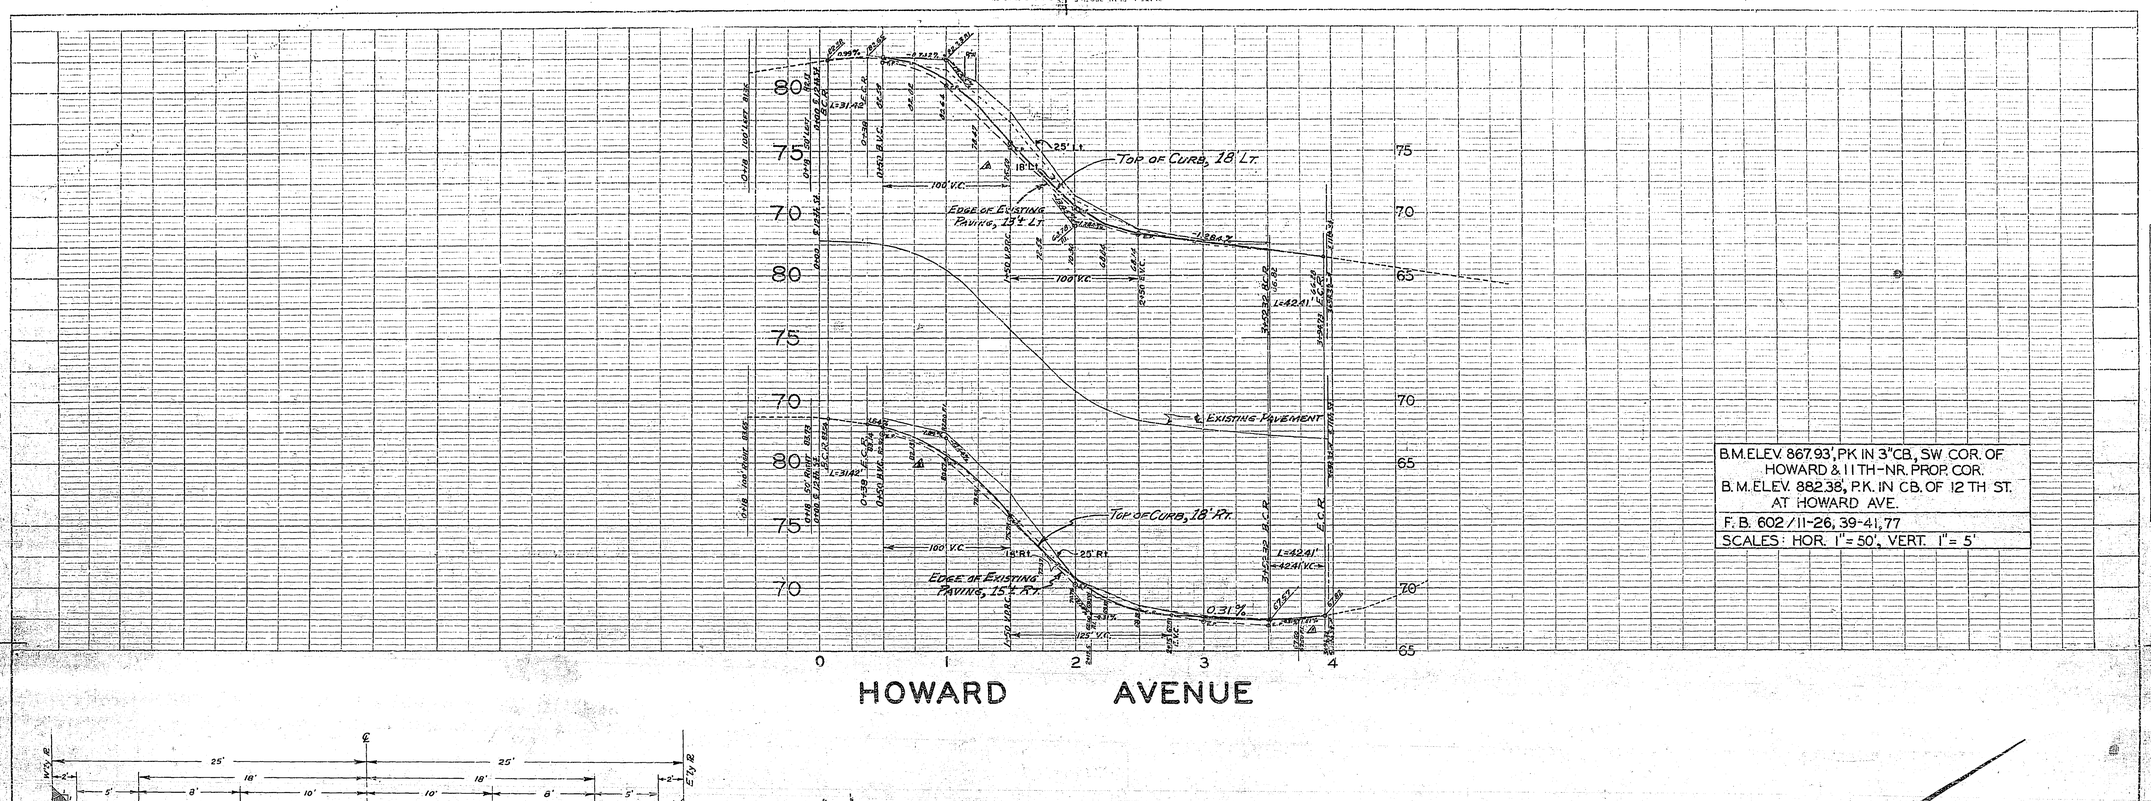

B.M. ELEV. 867.93', PK IN 3" CB., SW. COR. OF HOWARD & 11TH-NR. PROP. COR.
B.M. ELEV. 882.38', P.K. IN CB. OF 12TH ST. AT HOWARD AVE.
F.B. 602/11-26, 39-41, 77
SCALES: HOR. 1" = 50', VERT. 1" = 5'

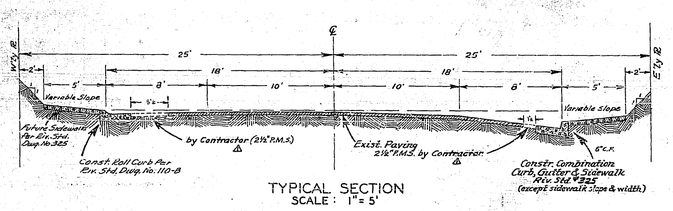

TYPICAL SECTION
SCALE: 1" = 5'

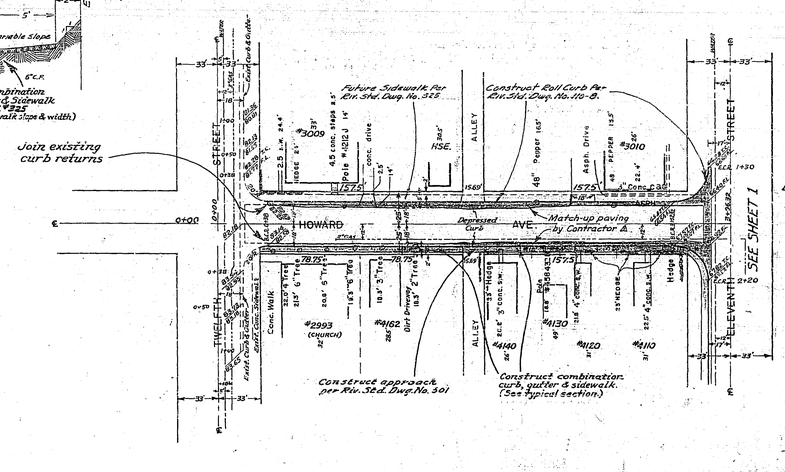

BOTH CURB RETURNS:
R = 27.00'
Δ = 90°00'
L = 42.41'
T = 27.00'

SCALE 1" = 50'

NOTE:
1- Contractor to remove trees and hedges interfering with construction.
2- Contractor to remove portions of private walks within public right-of-way where they interfere with construction.
3- Poles to be relocated by utility concerned.
4- Driveways to be built per Std. Dwg. No. 301 & only as far as back of sidewalk. Number of driveways, size & locations to be determined in the field. Estimate is based on one driveway per lot where curb, gutter & sidewalk are to be constructed, each driveway estimated to be 18' wide overall. Grade driveways within R/W to provide access.
5. All applicable notes on Std. Dwg. No. 299 covering concrete mix, scoring, expansion joints, etc., are to apply to construction of roll curb & gutter Std. Dwg. No. 110-B.

REVISIONS			CITY OF RIVERSIDE CALIFORNIA DEPARTMENT OF PUBLIC WORKS
MARK	DATE	DESCRIPTION	REVISED HOWARD AVE. & ELEVENTH ST. IMPROVEMENT DISTRICT
Δ	3-5-59	Revised Note 1 & match-up paving, w.e.	
	7/6/59	Changed W'ly side Eleventh St to Roll curb with no sidewalk.	
4	9/30/59	Changed Grades & Elev's L.L.P.	
✱	12-30-59	As Built, w.e.	

DESIGNED BY W.D.G. CHECKED BY J.L.B. / W.D.G.
DRAWN BY B. LOW / R.B.M.
RECOMMENDED BY Frances L. Schlueter, ASSISTANT CITY ENGINEER
APPROVED BY M. Martinez, DIRECTOR OF PUBLIC WORKS
DATE 2-24-59

R-121
SHEET 2 OF 2

PROFILE: SUPERVISED / PLOTTED / PROJECTED / R.M.S. NOTED / STRUCTURE NOTES PER DWG. / NOTE BOOK / VOL.

PLAN: SUPERVISED / PLOTTED / PROJECTED / R.M.S. NOTED / STRUCTURE NOTES PER DWG. / NOTE BOOK / VOL.

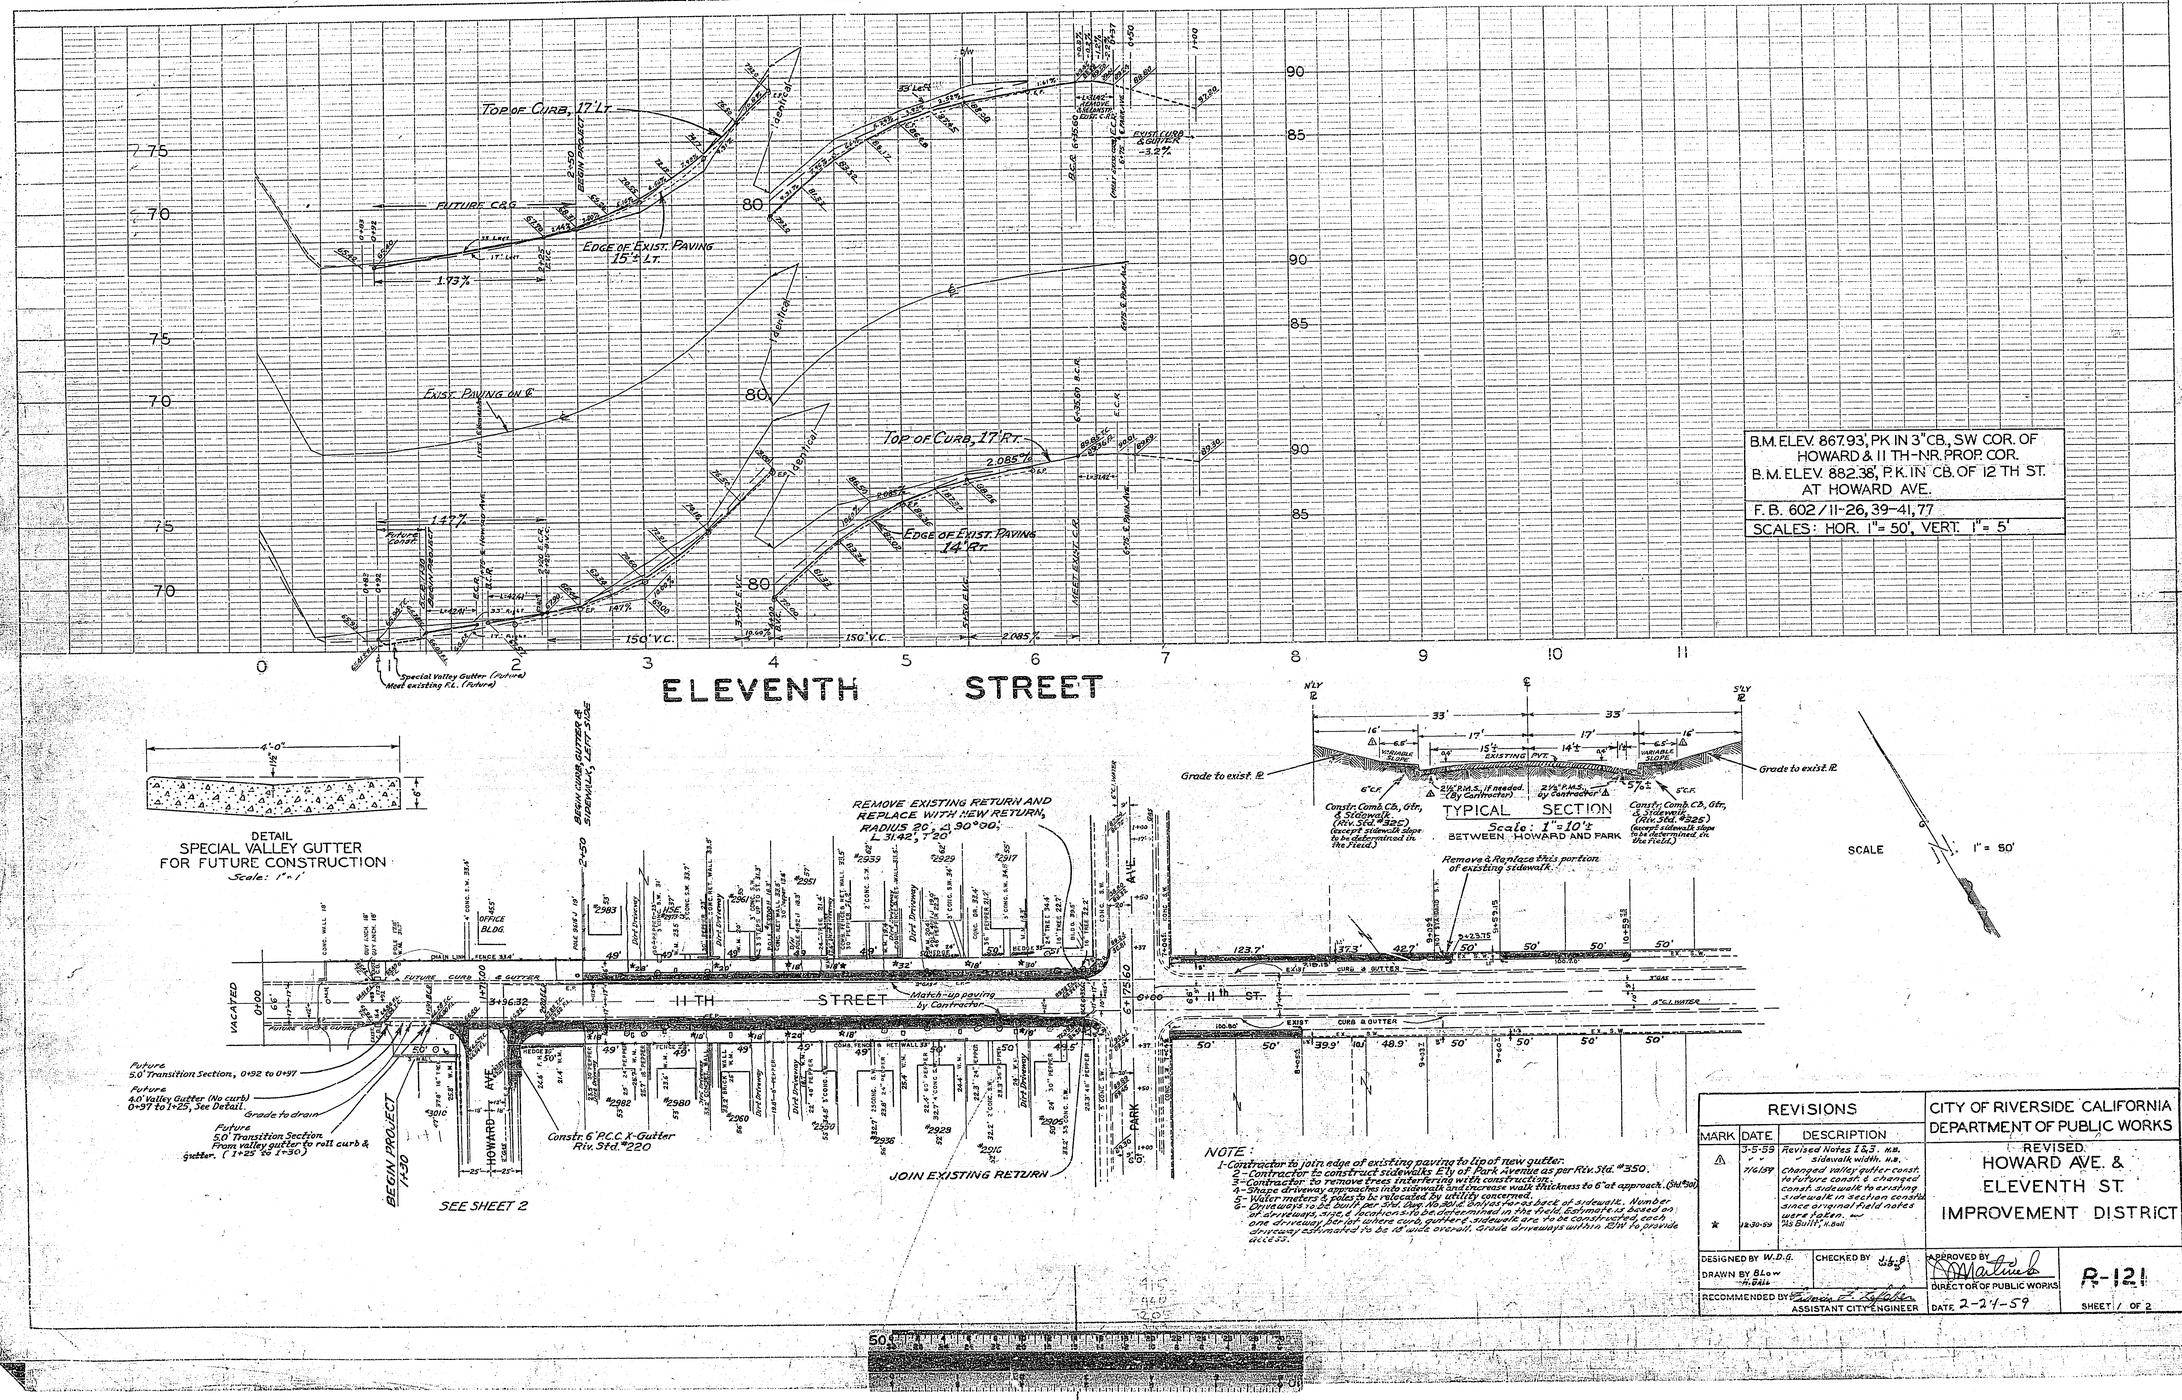

B.M. ELEV. 867.93', PK IN 3" CB., SW COR. OF HOWARD & 11 TH-NR. PROP. COR.
B.M. ELEV. 882.38', P.K. IN CB. OF 12 TH ST. AT HOWARD AVE.

F.B. 602/11-26, 39-41, 77

SCALES: HOR. 1"= 50', VERT. 1"= 5'

NOTE:
1-Contractor to join edge of existing paving to lip of new gutter.
2-Contractor to construct sidewalks E'ly of Park Avenue as per Riv. Std. #350.
3-Contractor to remove trees interfering with construction.
4-Shape driveway approaches into sidewalk and increase walk thickness to 6" at approach. (Std. #301)
5-Water meters & poles to be relocated by utility concerned.
6-Driveways to be built per Std. Dwg. No. 301 & 301 as far as back of sidewalk. Number of driveways, size & locations to be determined in the field. Estimate is based on one driveway per lot where curb, gutter & sidewalk are to be constructed, each driveway estimated to be 18' wide overall. Grade driveways within R/W to provide access.

REVISIONS			CITY OF RIVERSIDE CALIFORNIA DEPARTMENT OF PUBLIC WORKS
MARK	DATE	DESCRIPTION	REVISED HOWARD AVE. & ELEVENTH ST. IMPROVEMENT DISTRICT
△	3-5-59	Revised Notes 1 & 3. N.B.	
	" "	" sidewalk width. N.B.	
	7/6/59	Changed valley gutter const. to future const. & changed const. sidewalk to existing sidewalk in section const. since original field notes were taken.	
★	12-30-59	"As Built", N.Bell	

DESIGNED BY W.D.G. | CHECKED BY J.L.B. | APPROVED BY [signature] DIRECTOR OF PUBLIC WORKS | R-121

DRAWN BY BLow H.BALL | RECOMMENDED BY [signature] ASSISTANT CITY ENGINEER | DATE 2-24-59 | SHEET 1 OF 2