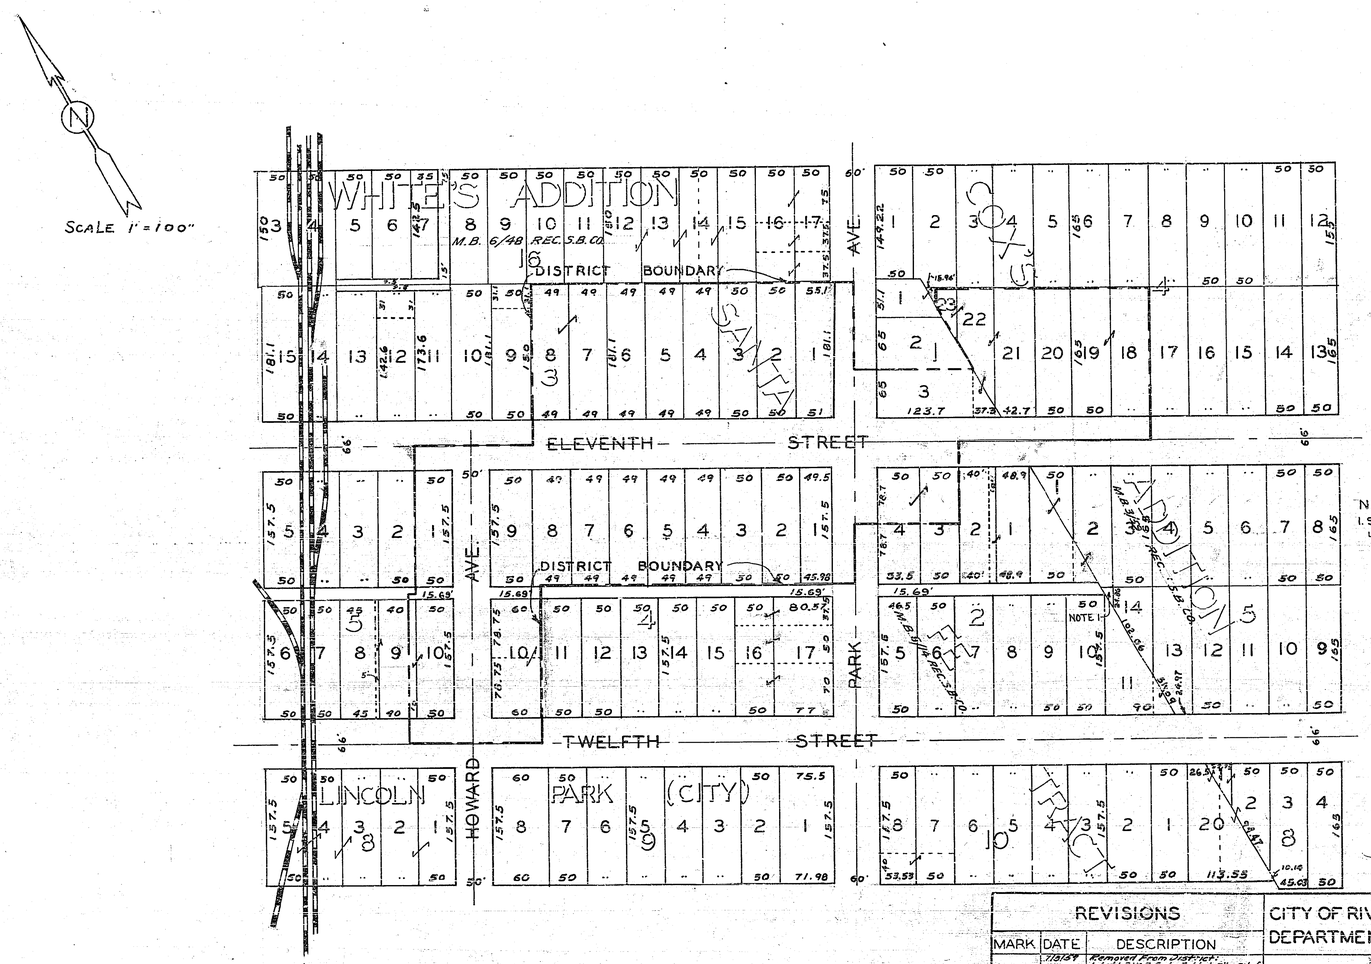

NOTE
1. Small triangular lot is an unnumbered lot of Cox's Add.

REVISIONS		
MARK	DATE	DESCRIPTION
	7/8/59	Removed From District: 1. Lot 1, Blk 6, Cox's Add. & Ely. 50' of Wly. 98.9' of lot 1, Blk 2, Santa Fe Tract. 2. Lot 2, Blk 5, Cox's Add. & Lot 1, Blk 2, Santa Fe Tract except the Wly. 98.9' thereof.

CITY OF RIVERSIDE CALIFORNIA
DEPARTMENT OF PUBLIC WORKS

REVISED
HOWARD AVE. &
ELEVENTH ST.
IMPROVEMENT DISTRICT

MAP SHOWING THE LAND INCLUDED WITHIN THE ASSESSMENT DISTRICT TO BE BENEFITED BY THE CONSTRUCTION OF CURBS & GUTTERS, S/W

DESIGNED BY
DRAWN BY B. Fow
CHECKED BY WDG
RECOMMENDED BY [signature]
ASSISTANT CITY ENGINEER
APPROVED BY [signature]
DIRECTOR OF PUBLIC WORKS
DATE 2-24-59

R-121-A
SHEET 1 OF 1