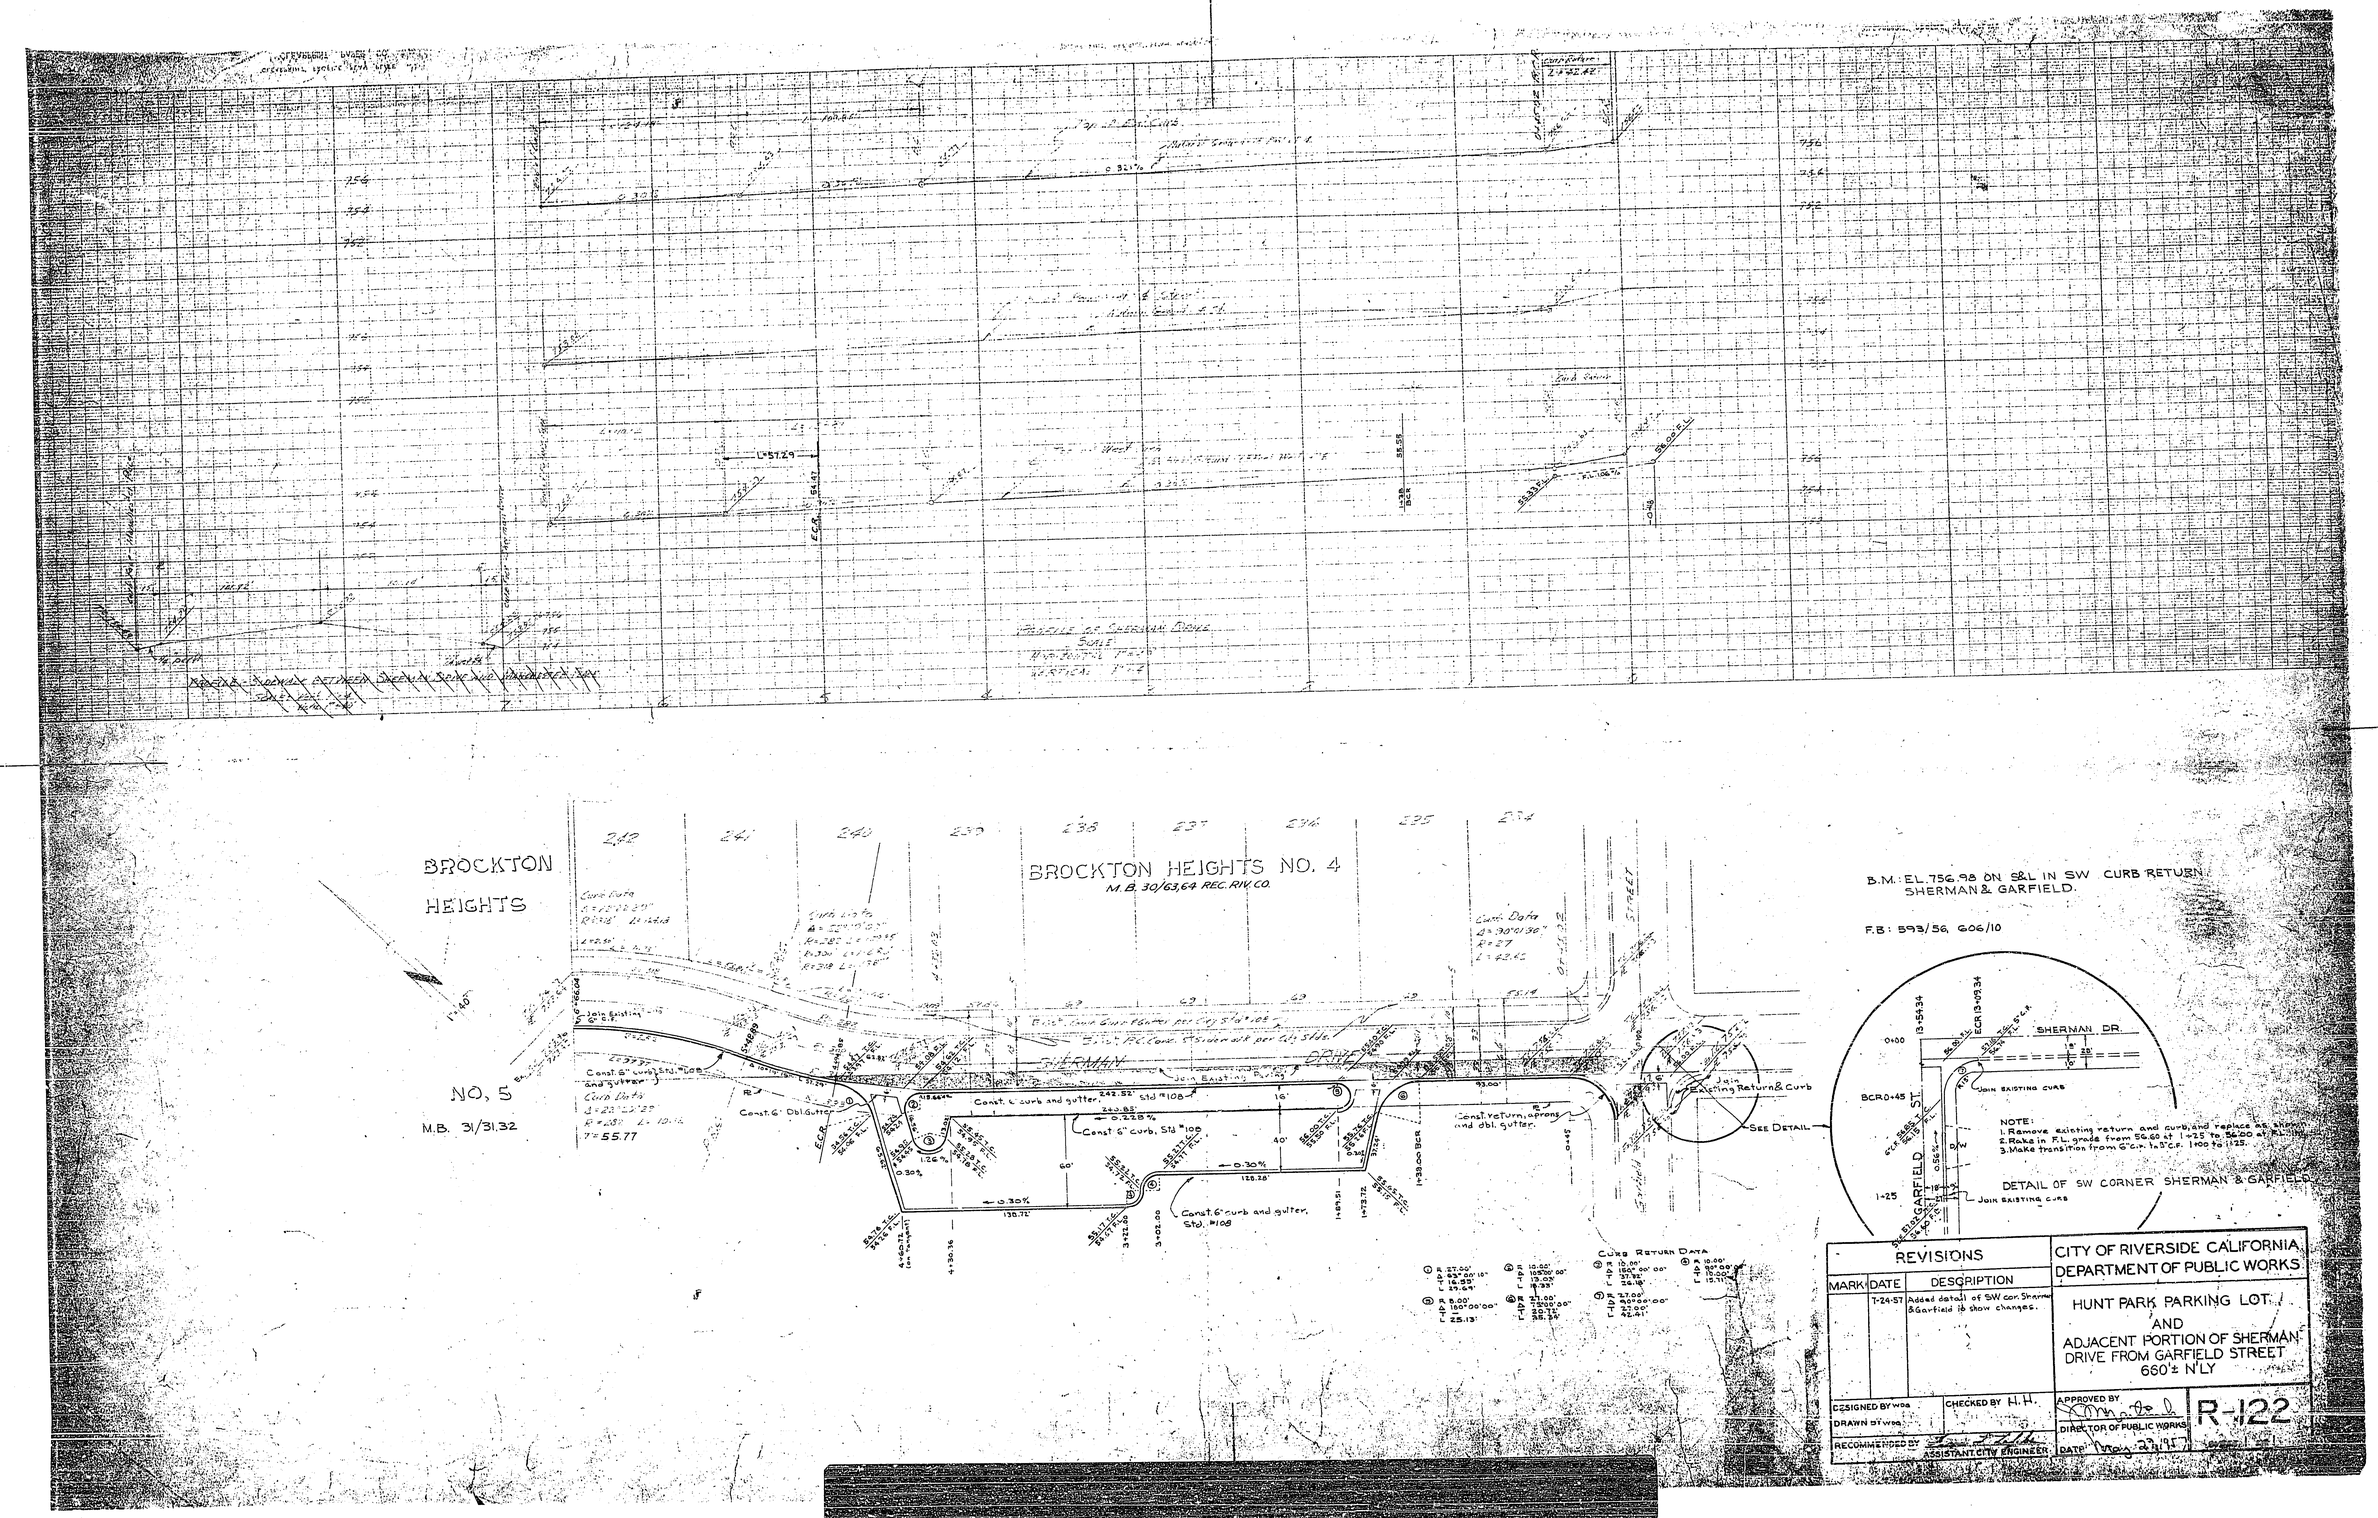

BROCKTON HEIGHTS
NO. 5
M.B. 31/31.32
BROCKTON HEIGHTS NO. 4
M.B. 30/63,64 REC. RIV. CO.
SHERMAN DRIVE
Const. 6" curb and gutter, Std. #108
Const. 6" Dbl. Gutter
Const. return, aprons and dbl. gutter.
Join Existing Return & Curb
See Detail
Curb Return Data
B.M.: EL. 756.98 ON S&L IN SW CURB RETURN SHERMAN & GARFIELD.
F.B.: 593/56, 606/10
SHERMAN DR.
GARFIELD ST.
Join Existing Curb
NOTE:
1. Remove existing return and curb, and replace as shown.
2. Rake in F.L. grade from 56.60 at 1+25 to 56.00 at F.L.
3. Make transition from 6" c.r. to 5" c.r. 1+00 to 1+25.
DETAIL OF SW CORNER SHERMAN & GARFIELD
REVISIONS
MARK
DATE
DESCRIPTION
7-24-57
Added detail of SW cor. Sherman & Garfield to show changes.
CITY OF RIVERSIDE CALIFORNIA
DEPARTMENT OF PUBLIC WORKS
HUNT PARK PARKING LOT
AND
ADJACENT PORTION OF SHERMAN DRIVE FROM GARFIELD STREET
660'± N'LY
DESIGNED BY WDG
DRAWN BY WDG
CHECKED BY H.H.
RECOMMENDED BY
ASSISTANT CITY ENGINEER
APPROVED BY
DIRECTOR OF PUBLIC WORKS
DATE May 23, 1957
R-122