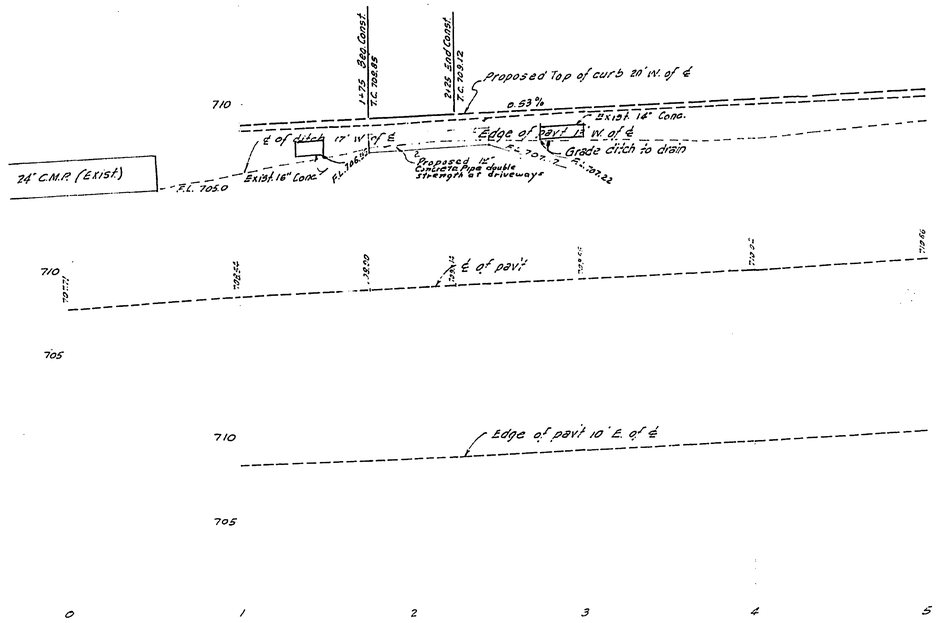

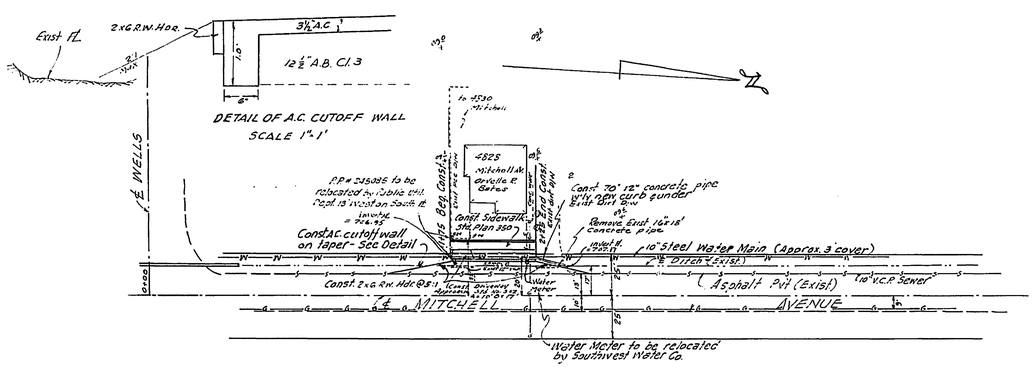

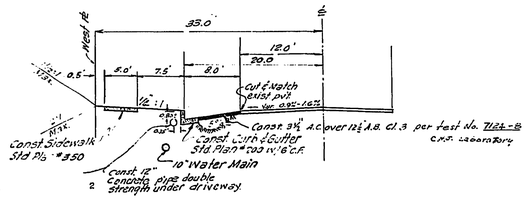

TYPICAL SECTION
MITCHELL AVE.
T.I. = 6.0
SCALE: Horiz. 1" = 10'
Vert. - No Scale

BENCH MARK: El. 714.424
R.R. Spike in Pole 262710 E on NE
cor. Mitchell & Bushnell F.B. 704/29

GENERAL NOTES

1. It shall be the responibility of the contractor to clear the right of way in accordance with the provisions of law as it affects each utility including irrigation lines and appurtenances and at no cost to the City.
2. Construction shall be in accordance with the City of Riverside Department of Public Works, Specifications No. 461, and Standard Drawings.
3. Prime coat, seal coat and paint binder are required.
4. Grading will require a permit under Ordinance 3093 for a cut or fill exceeding 100 cubic yards or a fill of one foot in depth.
5. Trim edge of existing pavement where new paving joins existing pavement to a clean straight edge. Construct match-up paving as shown and overlay paving as directed in the field to produce a smooth crown section. The engineer estimates the amount of asphalt overlay to be none.
6. The finish subgrade shall have a compaction of not less than 90% for a depth of 0.5' as determined by test method No. "Calif. 216 F" immediately prior to placement of the cover.
7. Sewer lateral is Clear of Construction

S.R. #681 R=16

JOE K. WILLIAMS & ASSOC.
ELSINORE CALIF.
APPROVED BY J. D. McCue MARCH 31, 1967
R.C.E. 15,438

MARK	REVISIONS	APPR.	DATE
1	Transite pipe may be used in lieu of concrete pipe near back of curb	Fwc	5/26/68
2	Conc. pipe to be used in lieu of transite as previously planned transite material not available	Wdg	6-6-68

DESIGNED BY F.W.C. DRAWN BY J.C.B. CHECKED BY J.K.W.

CITY OF RIVERSIDE, CALIFORNIA
DEPARTMENT OF PUBLIC WORKS

APPROVED BY	BY	DATE
OFFICE ENGINEER	[illegible]	6-20
PARK DEPARTMENT		
TRAFFIC DIVISION	[illegible]	6-14
ASSISTANT CITY ENG.	[illegible]	6-19

APPROVED BY [signature]
DIRECTOR OF PUBLIC WORKS
DATE 6/23/67

MITCHELL AVENUE
W. SIDE 200'± NORTH OF WELLS
NO. 4828 MITCHELL AVE.
BUILDING PERMIT
HORIZ. SCALE: 1" = 40' VERT. SCALE: 1" = 4'

PROJECT NO. R-1228
SHEET 1 OF 1
FILE NO.