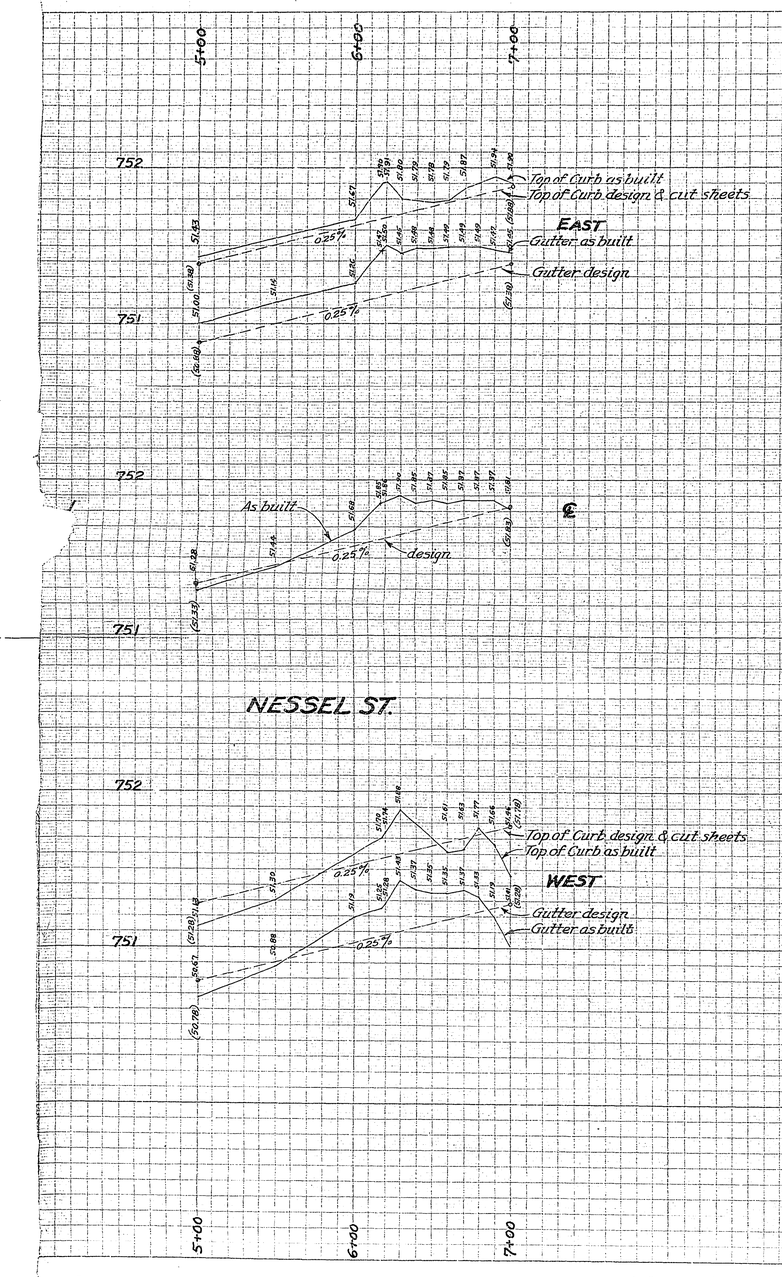

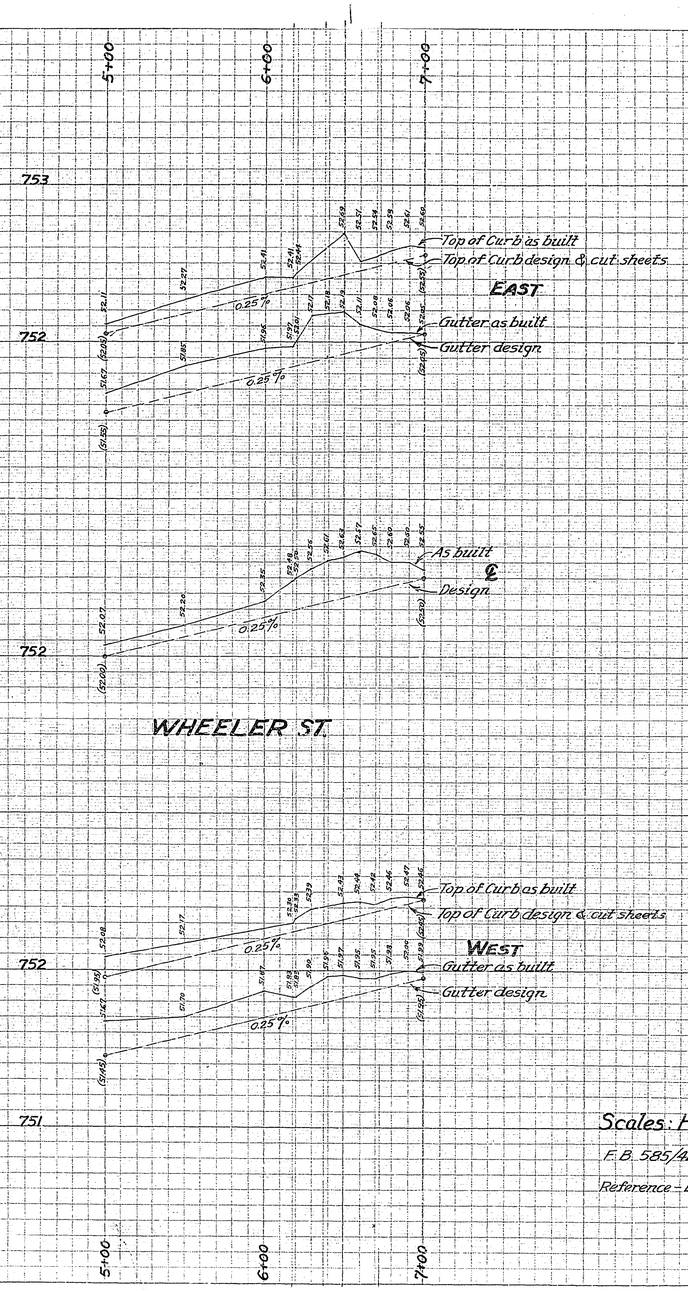

Scales: Hor 1"=40', Vert 1"=04'

F.B. 585/42,43

Reference – Dwg. #1516, Sheets 3 & 4

REVISIONS		
MARK	DATE	DESCRIPTION

CITY OF RIVERSIDE CALIFORNIA
DEPARTMENT OF PUBLIC WORKS

"As Built" Curb & Gutter
NESSEL STREET &
WHEELER STREET
500 ft. to 700 ft. South
of California Avenue

DESIGNED BY
DRAWN BY H.Ball 8-13-47
CHECKED BY H.H.
RECOMMENDED BY
ASSISTANT CITY ENGINEER
APPROVED BY
DIRECTOR OF PUBLIC WORKS
DATE

R-124

SHEET 1 OF 1