GENERAL CONSTRUCTION NOTES

DISREGARD ALL CONSTRUCTION NOTES EXCEPT TREE REMOVAL NOTES

TREE REMOVAL

REMOVE AND DISPOSE OF TREE OFFSITE. REMOVE STUMP BY MILLING TO TWO FEET BELOW THE ADJACENT CURB. OPTIONAL METHODS OF REMOVING CERTAIN STUMPS MAY BE AVAILABLE TO THE CONTRACTOR WHEN APPROVED BY THE ENGINEER. BACKFILL STUMP HOLE.

I SIZE CLASS

TREE TO BE REMOVED

SIZE CLASS

I ····· OVER 6" TO 18" DIAMETER

II ····· OVER 18" TO 36" DIAMETER

III ····· OVER 36" DIAMETER

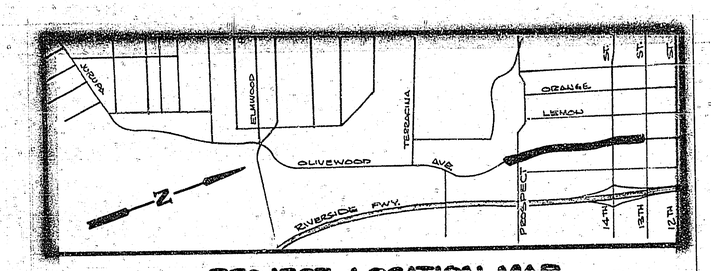

PROJECT LOCATION MAP

NO SCALE

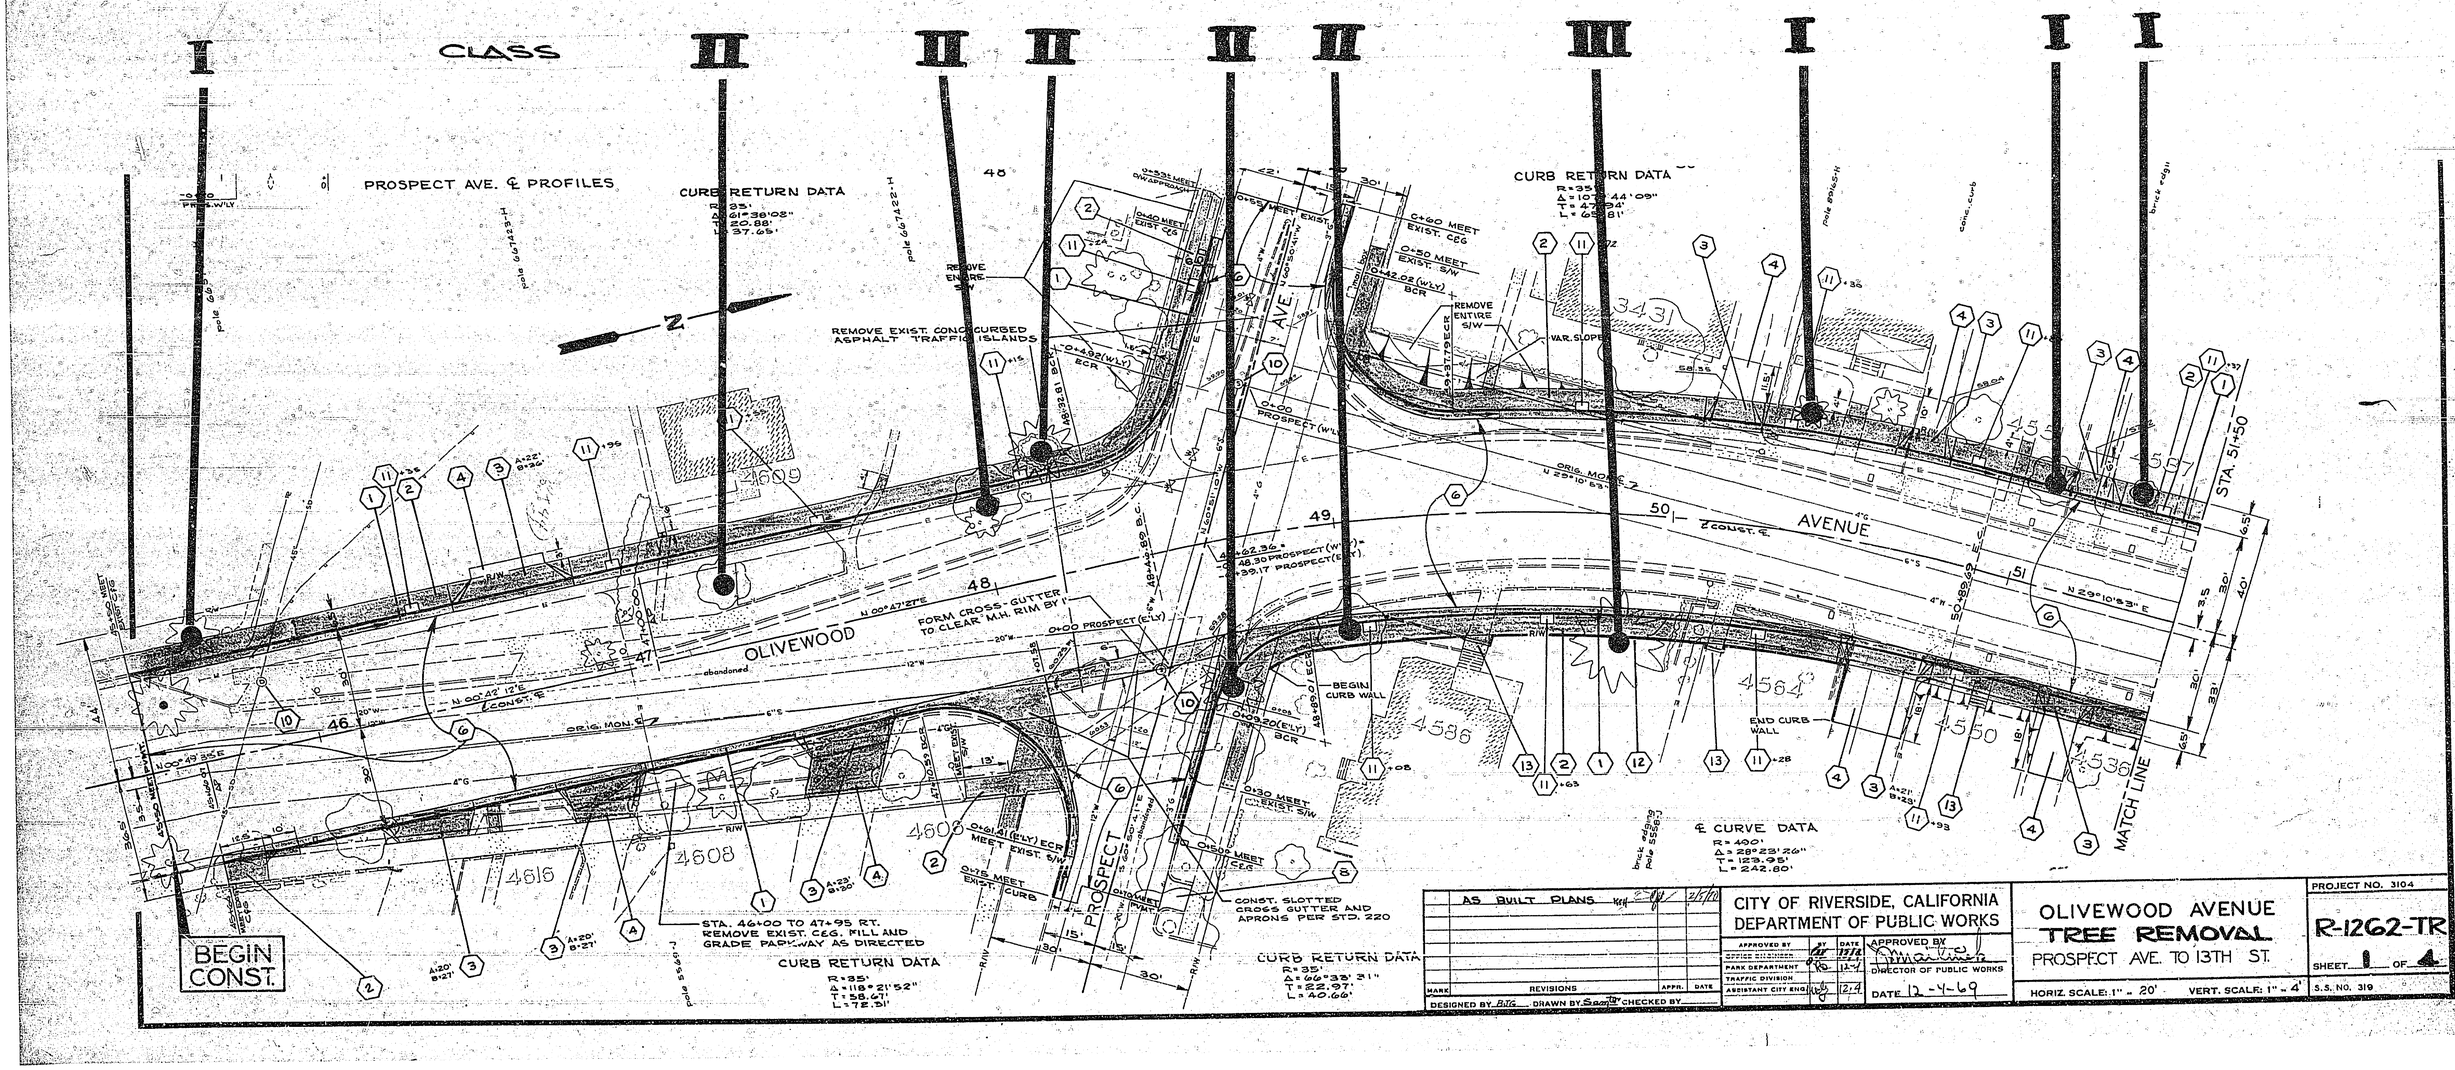

MARK	REVISIONS	APPR.	DATE
	AS BUILT PLANS		2/5/70

DESIGNED BY BTG DRAWN BY CHECKED BY

CITY OF RIVERSIDE, CALIFORNIA
DEPARTMENT OF PUBLIC WORKS

APPROVED BY	BY	DATE	APPROVED BY
OFFICE DIVISION			DIRECTOR OF PUBLIC WORKS
PARK DEPARTMENT		12-4	
TRAFFIC DIVISION			
ASSISTANT CITY ENGR.		12-4	DATE 12-4-69

OLIVEWOOD AVENUE
TREE REMOVAL
PROSPECT AVE. TO 13TH ST.

HORIZ. SCALE: 1" = 20' VERT. SCALE: 1" = 4'

PROJECT NO. 3104

R-1262-TR

SHEET 1 OF 4

S.S. NO. 319

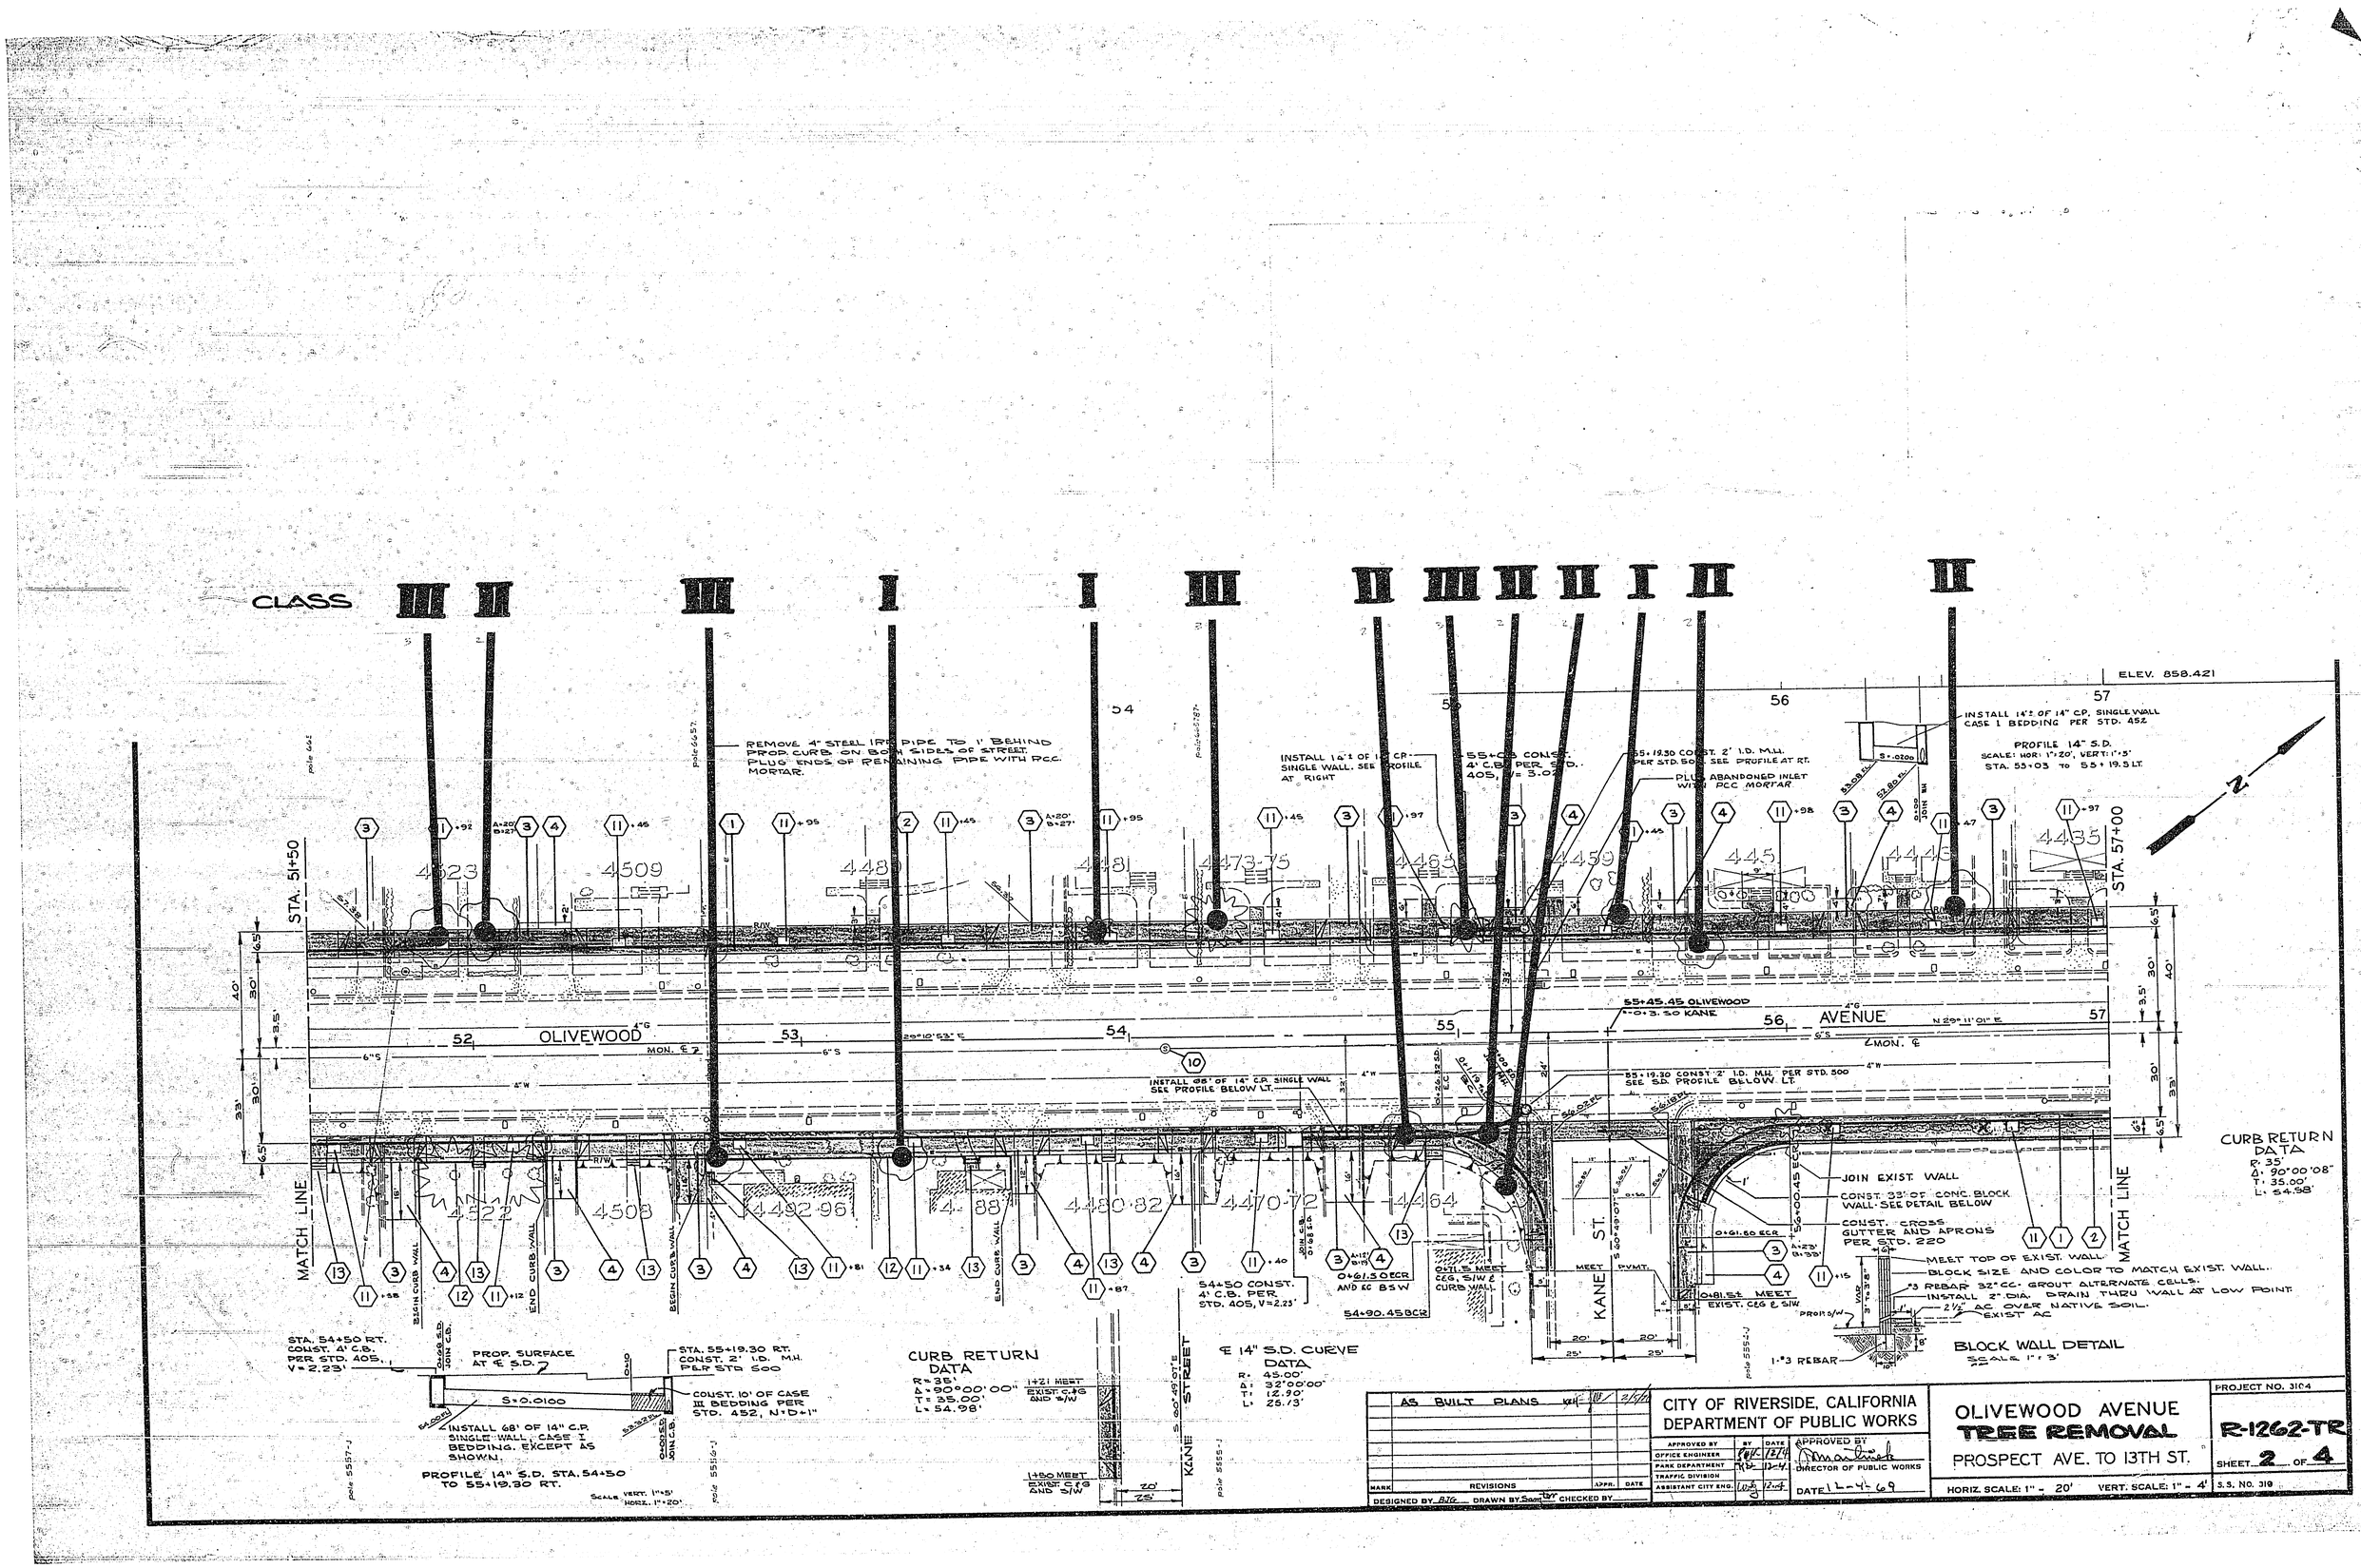
CLASS III II III I I III II III II II I II II
ELEV. 858.421
REMOVE 4" STEEL IRR PIPE TO 1' BEHIND PROP. CURB ON BOTH SIDES OF STREET. PLUG ENDS OF REMAINING PIPE WITH PCC MORTAR.
INSTALL 14"± OF 14" CP SINGLE WALL. SEE PROFILE AT RIGHT
55+03 CONST. 4' C.B. PER STD. 405, V=3.07
55+19.30 CONST. 2' I.D. M.H. PER STD. 500. SEE PROFILE AT RT.
PLUG ABANDONED INLET WITH PCC MORTAR
INSTALL 14"± OF 14" CP. SINGLE WALL CASE 1 BEDDING PER STD. 452
PROFILE 14" S.D.
SCALE: HOR: 1"=20', VERT: 1"=5'
STA. 55+03 TO 55+19.5 LT.
STA. 51+50
STA. 57+00
OLIVEWOOD AVENUE
MATCH LINE
55+45.45 OLIVEWOOD
INSTALL 68' OF 14" C.P. SINGLE WALL SEE PROFILE BELOW LT.
55+19.30 CONST. 2' I.D. M.H. PER STD. 500 SEE S.D. PROFILE BELOW LT.
JOIN EXIST. WALL
CONST. 33' OF CONC. BLOCK WALL. SEE DETAIL BELOW
CONST. CROSS GUTTER AND APRONS PER STD. 220
MEET TOP OF EXIST. WALL
BLOCK SIZE AND COLOR TO MATCH EXIST. WALL.
#3 REBAR 32" CC. GROUT ALTERNATE CELLS.
INSTALL 2" DIA. DRAIN THRU WALL AT LOW POINT.
2½" AC OVER NATIVE SOIL.
EXIST AC
1-#3 REBAR
BLOCK WALL DETAIL
SCALE 1"=3'
CURB RETURN DATA
R=35'
Δ=90°00'08"
T=35.00'
L=54.98'
KANE ST.
54+50 CONST. 4' C.B. PER STD. 405, V=2.23'
54+90.45 BCR
0+61.50 ECR AND EC BSW
0+71.5 MEET C&G, S/W & CURB WALL
0+81.5± MEET EXIST. C&G & S/W
STA. 54+50 RT. CONST. 4' C.B. PER STD. 405, V=2.23'
PROP. SURFACE AT ℄ S.D.
STA. 55+19.30 RT. CONST. 2' I.D. M.H. PER STD 500
CONST. 10' OF CASE III BEDDING PER STD. 452, N=D+1"
S=0.0100
INSTALL 68' OF 14" C.P. SINGLE WALL, CASE I BEDDING. EXCEPT AS SHOWN.
PROFILE 14" S.D. STA. 54+50 TO 55+19.30 RT.
SCALE VERT. 1"=5' HORIZ. 1"=20'
CURB RETURN DATA
R=35'
Δ=90°00'00"
T=35.00'
L=54.98'
1+21 MEET EXIST. C&G AND S/W
1+50 MEET EXIST. C&G AND S/W
KANE STREET
℄ 14" S.D. CURVE DATA
R=45.00'
Δ=32°00'00"
T=12.90'
L=25.13'
AS BUILT PLANS
CITY OF RIVERSIDE, CALIFORNIA
DEPARTMENT OF PUBLIC WORKS
APPROVED BY
OFFICE ENGINEER
PARK DEPARTMENT
TRAFFIC DIVISION
ASSISTANT CITY ENG.
DIRECTOR OF PUBLIC WORKS
DATE 12-4-69
OLIVEWOOD AVENUE
TREE REMOVAL
PROSPECT AVE. TO 13TH ST.
PROJECT NO. 3104
R-1262-TR
SHEET 2 OF 4
HORIZ. SCALE: 1" - 20'
VERT. SCALE: 1" - 4'
S.S. NO. 319
DESIGNED BY BJG DRAWN BY Sam CHECKED BY

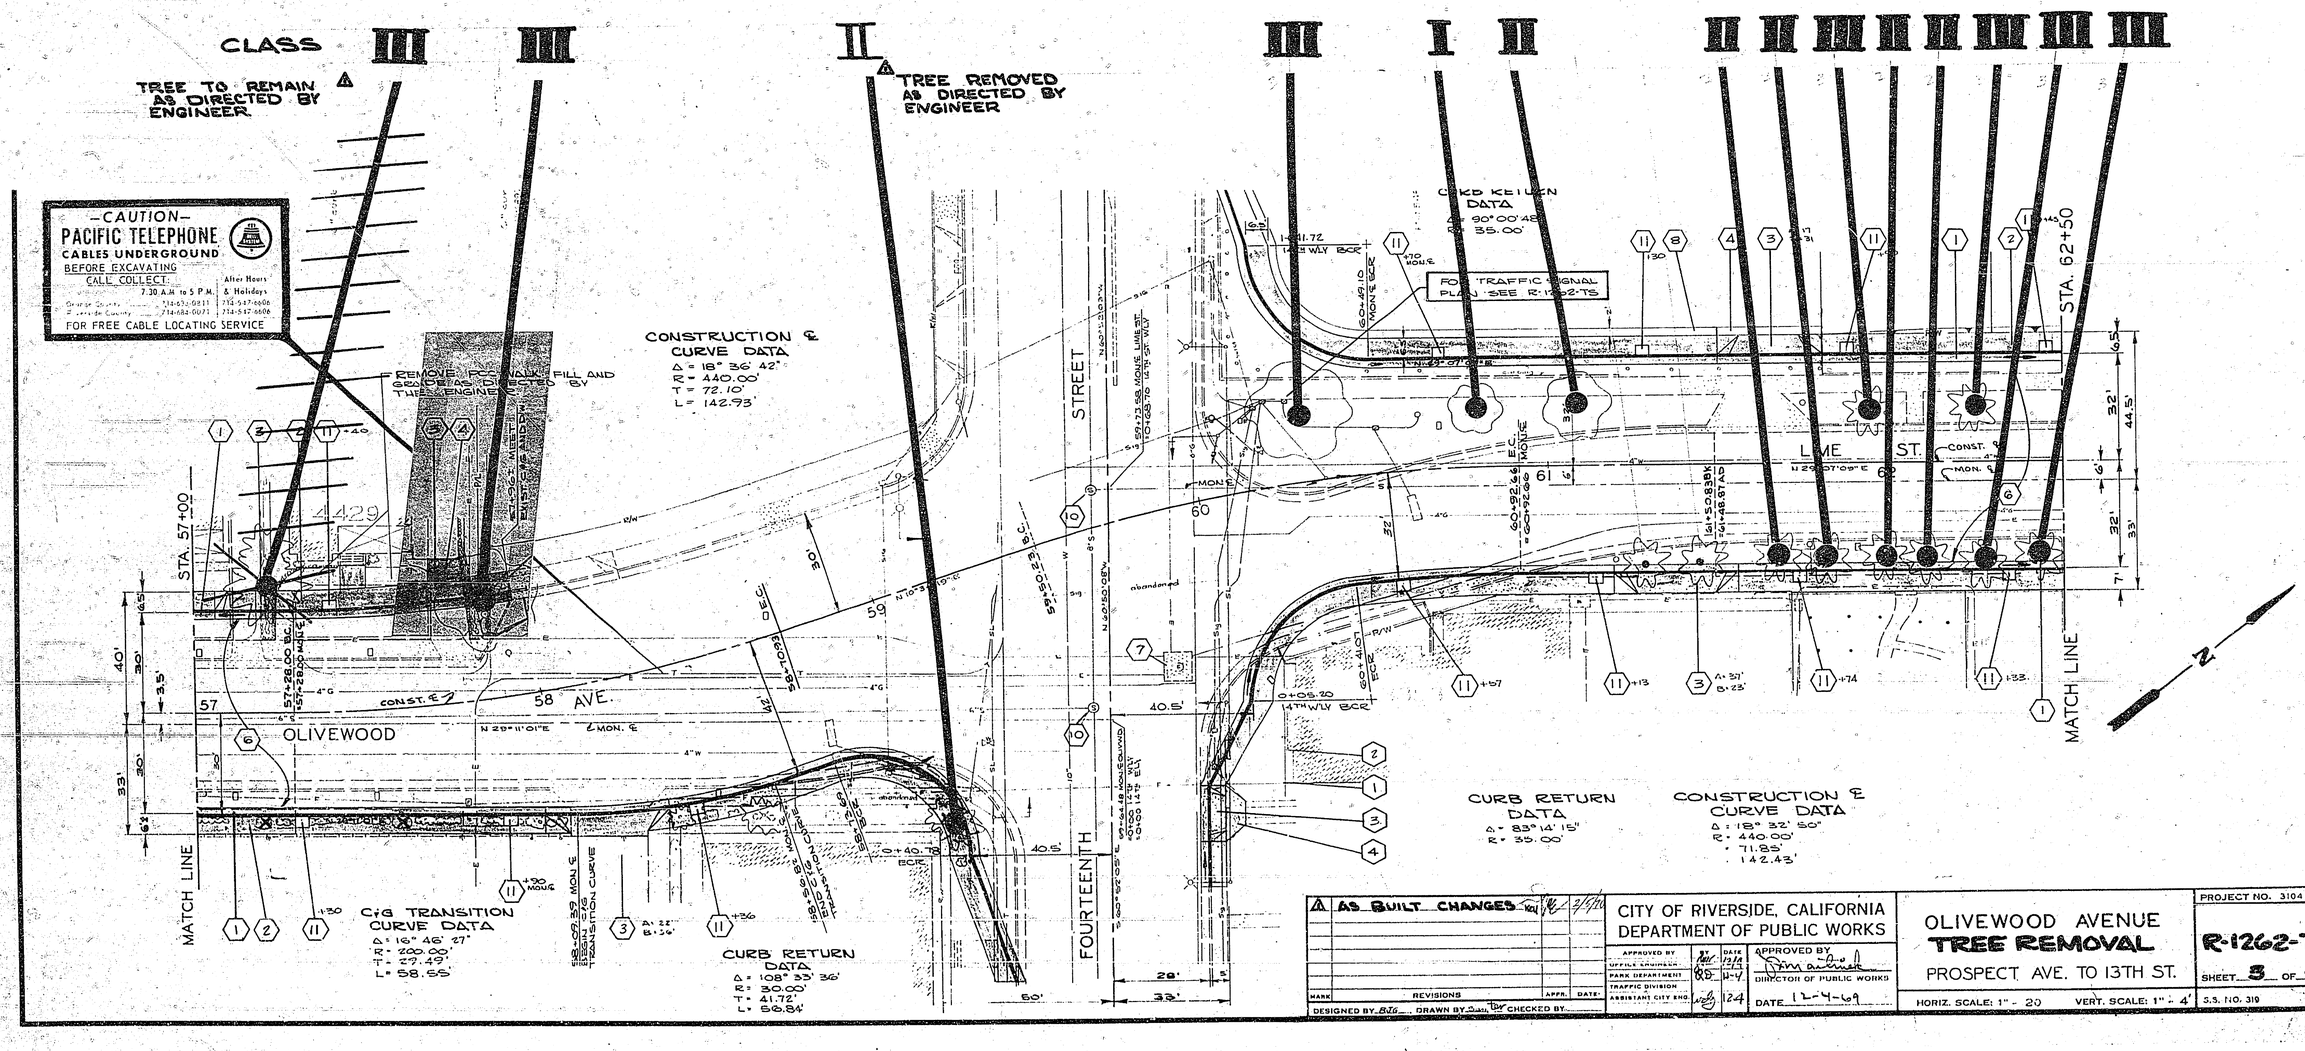

AS BUILT CHANGES			
MARK	REVISIONS	APPR.	DATE

DESIGNED BY BJG DRAWN BY CHECKED BY

CITY OF RIVERSIDE, CALIFORNIA
DEPARTMENT OF PUBLIC WORKS

APPROVED BY	BY	DATE
UFFICE ENGINEER		
PARK DEPARTMENT		
TRAFFIC DIVISION		
ASSISTANT CITY ENG.		12-4

APPROVED BY
DIRECTOR OF PUBLIC WORKS
DATE 12-4-69

OLIVEWOOD AVENUE
TREE REMOVAL
PROSPECT AVE. TO 13TH ST.

HORIZ. SCALE: 1" = 20 VERT. SCALE: 1" = 4'

PROJECT NO. 3104
R-1262-TR
SHEET 3 OF 4
S.S. NO. 319

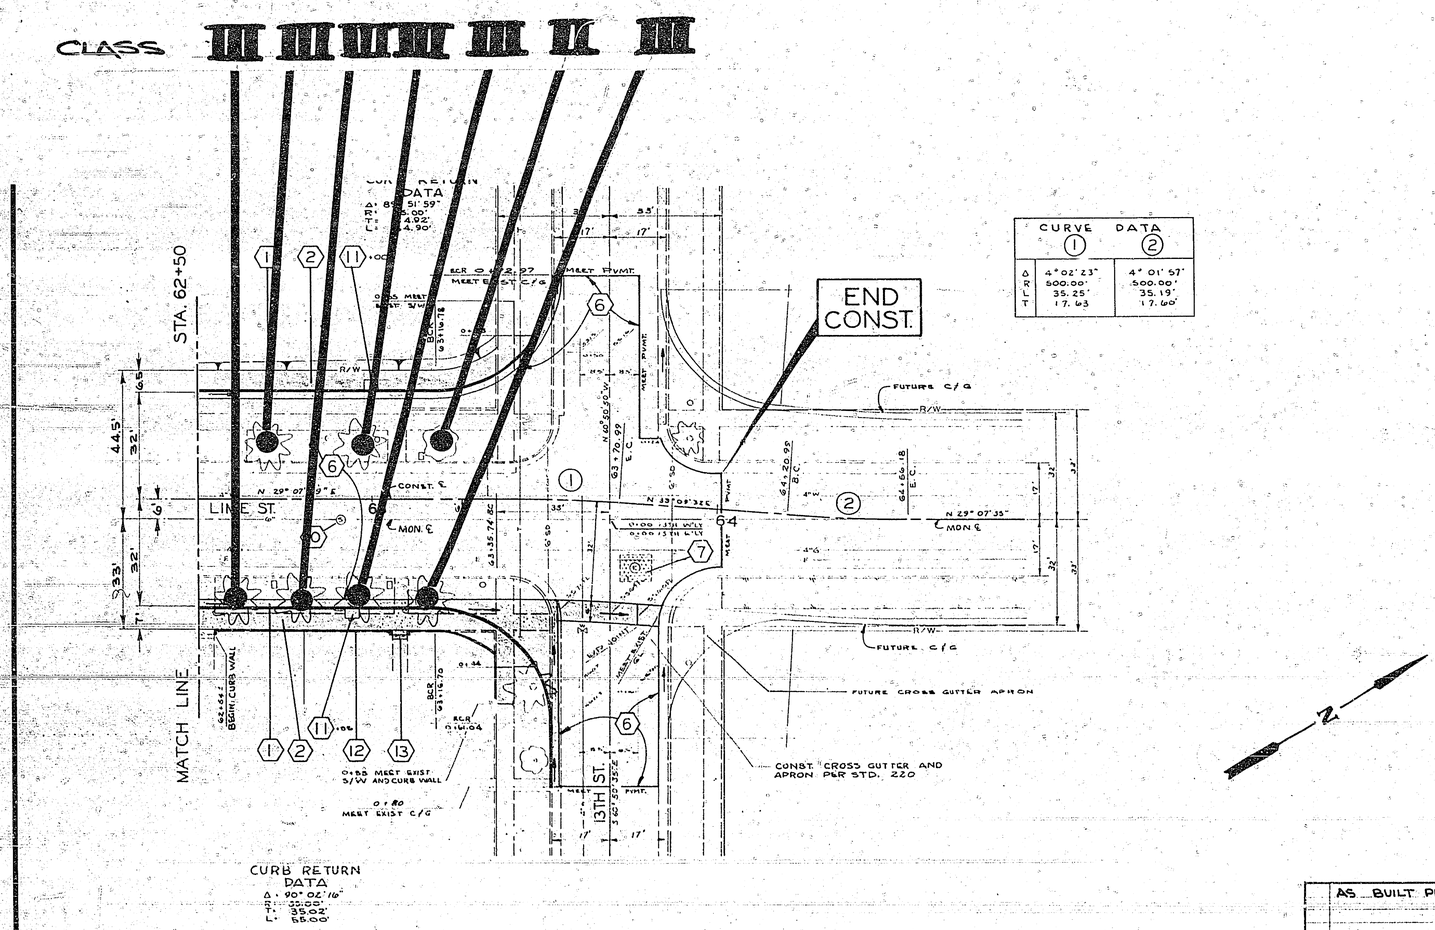

CURVE DATA	①	②
Δ	4° 02' 23"	4° 01' 57"
R	500.00'	500.00'
L	35.25'	35.19'
T	17.63	17.60'

CURB RETURN DATA
Δ: 90° 02' 16"
R: 35.00'
T: 35.02'
L: 55.00'

MARK	REVISIONS	APPR	DATE
	AS BUILT PLANS		4/5/70

DESIGNED BY BVG DRAWN BY CHECKED BY

CITY OF RIVERSIDE, CALIFORNIA
DEPARTMENT OF PUBLIC WORKS

APPROVED BY	BY	DATE
OFFICE ENGINEER		12/4
PARK DEPARTMENT		12-4
TRAFFIC DIVISION		
ASSISTANT CITY ENG		12-4

APPROVED BY
DIRECTOR OF PUBLIC WORKS
DATE 12-4-69

OLIVEWOOD AVENUE TREE REMOVAL

PROSPECT AVE. TO 13TH, ST.

HORIZ. SCALE: 1" = 20' VERT. SCALE: 1" = 4'

PROJECT NO. 3104

R-1262-TR

SHEET 4 OF 4

S.S.NO. 310