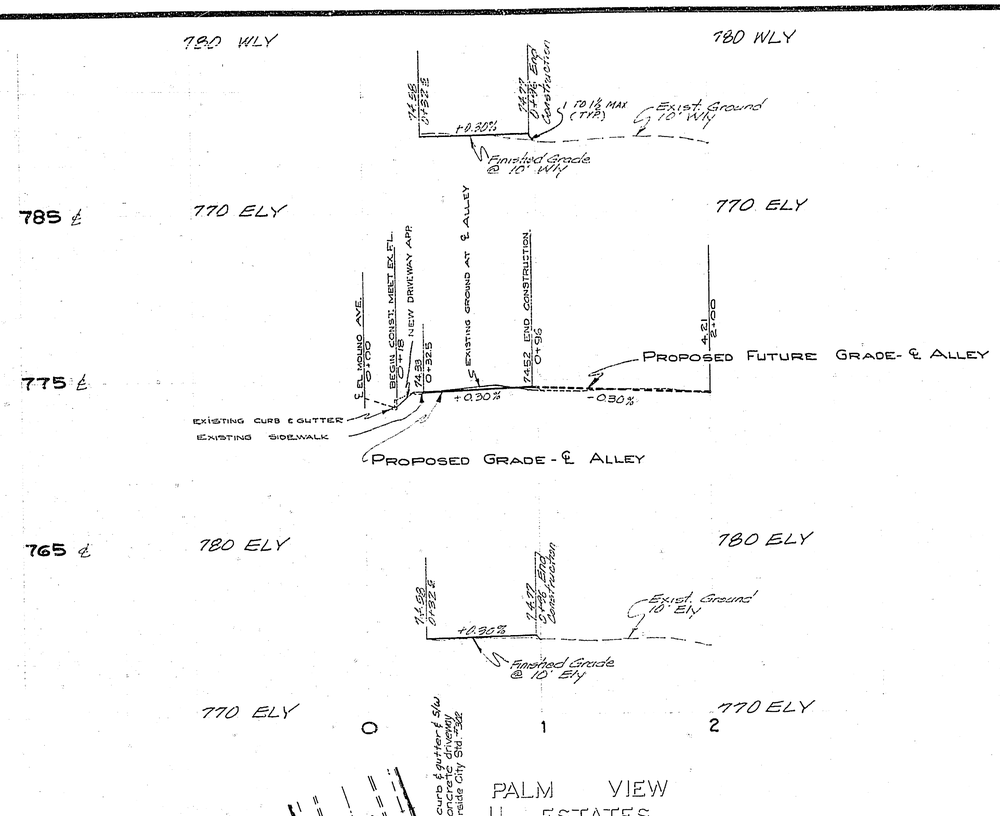

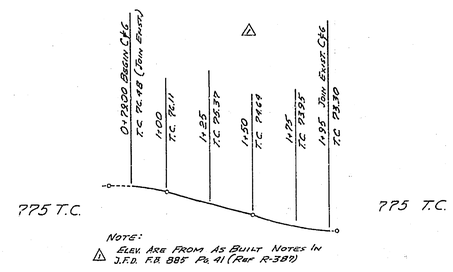

△ EL MOLINO AVE. T.C. PROFILE

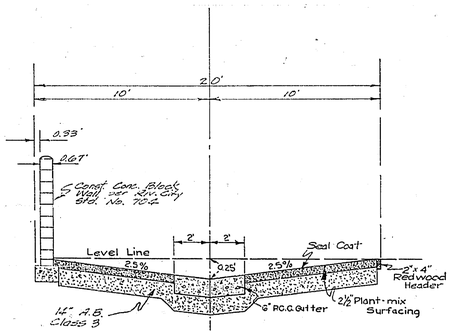

TYPICAL SECTION

NOT TO SCALE

T.I. = 5.0

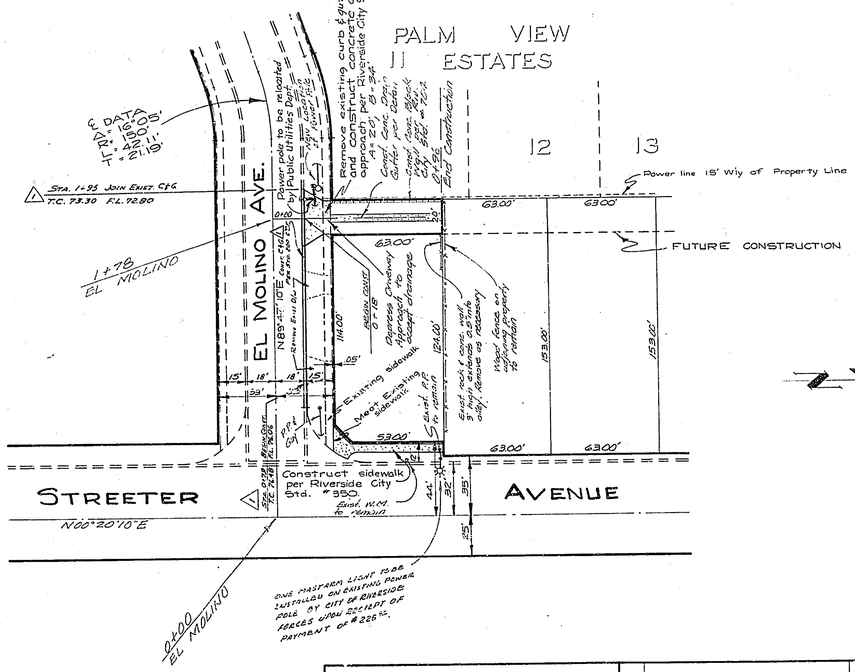

GENERAL NOTES

1. For relocation of any City domestic or irrigation water facility, or electric power utility facility to be done by City forces, contact C. Hare, Water Commercial Engineer at 787-7426. Schedule about two weeks to process a work order before ocfore relocation work begins.
2. It shall be the responsibility of the Contractor to clear the right of way in accordance with the provisions of law as it affects each utility including irrigation lines and appurtenances and at no extra cost to the City.
3. Construction shall be in accordances with the City of Riverside, Department of Public Works, Specifications No. 461 and Standard Drawings.
4. Prime coat, seal coat, and paint binder are required.
5. Grading will require a permit under Ordinance 3093 for a cut or fill exceeding 100 cubic yards, or a fill over one food in depth.

BENCH MARK:
Spike and lead in south curb of Granada Ave., 50' West of original centerline of Streeter Ave.
Riverside City F.B. 539/10 ELEV 775.697
S.R. 89 R=4

J. F. DAVIDSON ASSOCIATES
CIVIL ENGINEERS - SURVEYORS - PLANNERS
RIVERSIDE, CALIFORNIA

APPROVED BY Robert L. Hogan DATE 10-4-67
R.E. NO. 13261

W.O. 1275 FOR: FRED BIEWERS F.B. 888/39-43

MARK	REVISIONS	APPR.	DATE
△	Approved Contr. on El Molino to Replace Removed Sta. 1+95		6-27-68

DESIGNED BY ____ DRAWN BY Sob CHECKED BY ____

CITY OF RIVERSIDE, CALIFORNIA
DEPARTMENT OF PUBLIC WORKS

	BY	DATE
APPROVED BY		
OFFICE ENGINEER		11-12
PARK DEPARTMENT	—	—
TRAFFIC DIVISION		1-10
ASSISTANT CITY ENG.		1-9
		1-12

APPROVED BY William D. Jackson
DIRECTOR OF PUBLIC WORKS
DATE 2/7/68

ALLEY PLAN AND PROFILE
ZONE CASE R-28-667

HORIZ. SCALE: 1" = 40' VERT. SCALE: 1" = 4'

PROJECT NO. R-1265
SHEET 1 OF 1
FILE NO. 3724