—CAUTION—
PACIFIC TELEPHONE
CABLES UNDERGROUND
BEFORE EXCAVATING
CALL COLLECT:

	7:30 A.M. to 5 P.M.	After Hours & Holidays
Orange County	714-673-0811	714-547-6606
Riverside County	714-684-0071	714-547-6606
Inyo County	714-684-0071	714-547-6606
San Bernardino County	714-684-0071	714-547-6606
Los Angeles County	213-621-3111	24 HOUR SERVICE
Ventura County	213-621-3111	
San Diego County	714-278-2575	714-222-0027

FOR FREE CABLE LOCATING SERVICE

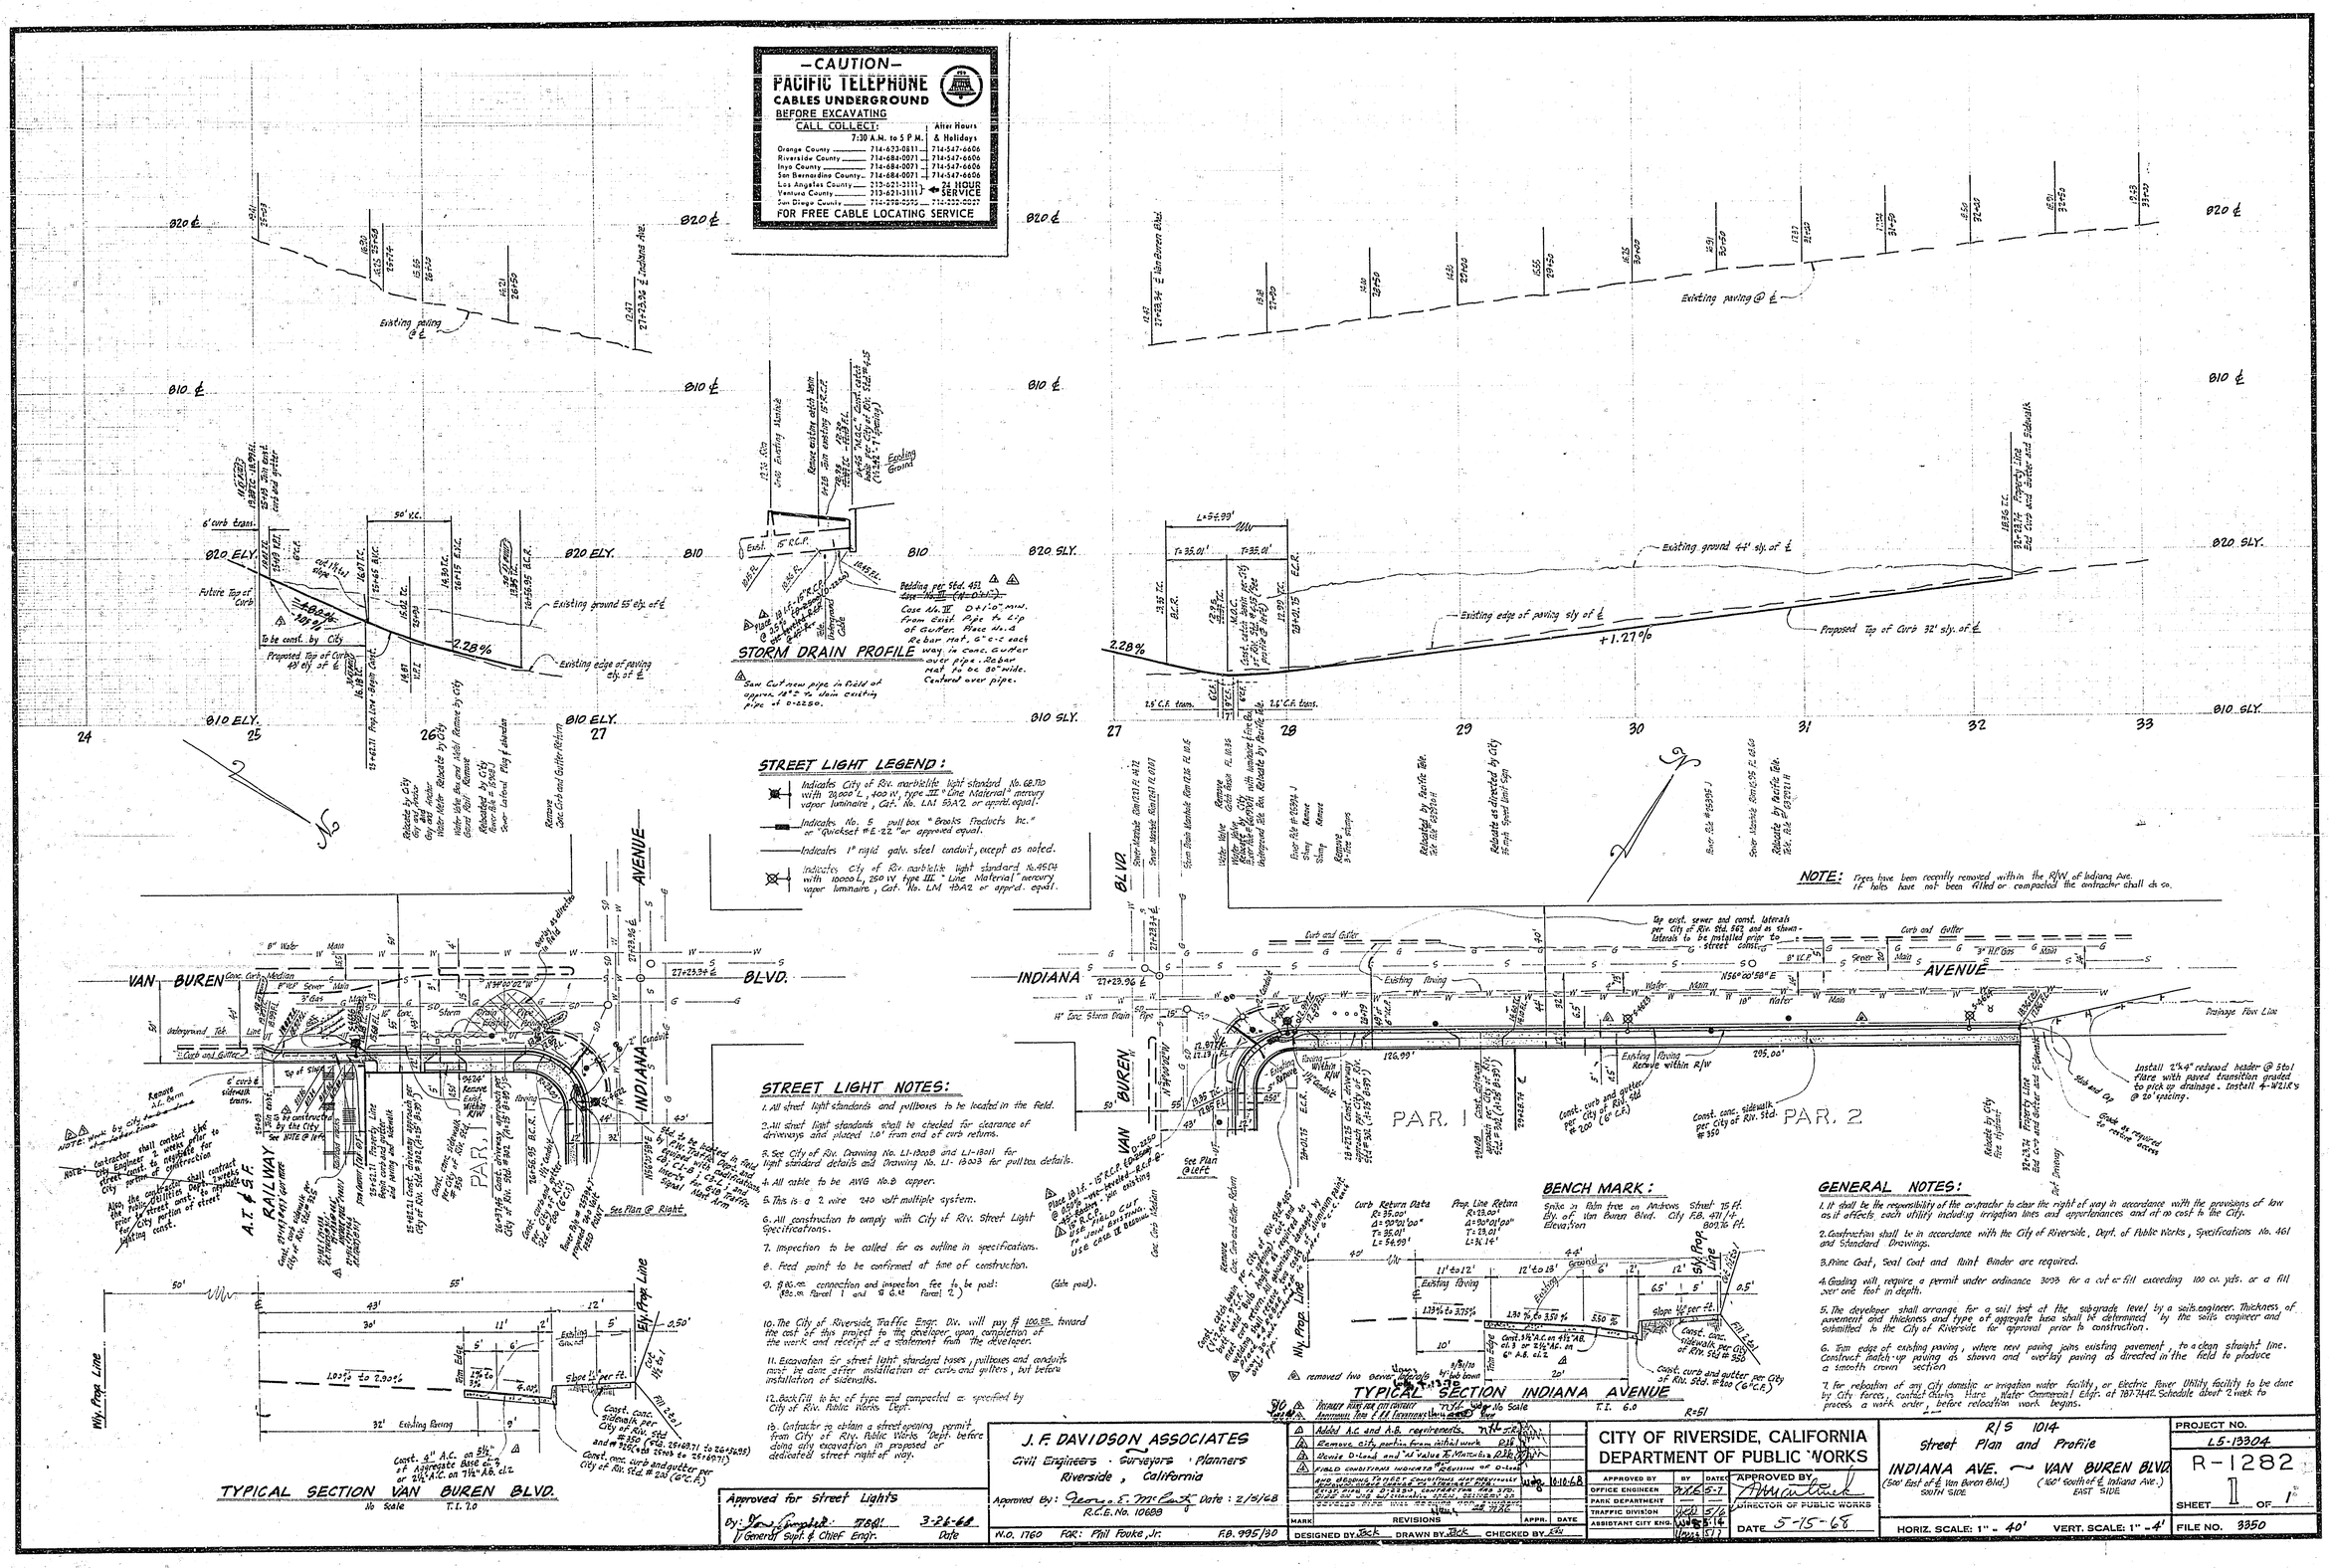

STREET LIGHT NOTES:

1. All street light standards and pullboxes to be located in the field.
2. All street light standards shall be checked for clearance of driveways and placed 1.0' from end of curb returns.
3. See City of Riv. Drawing No. L1-18008 and L1-18011 for light standard details and Drawing No. L1-18003 for pull box details.
4. All cable to be AWG No.6 copper.
5. This is a 2 wire 240 volt multiple system.
6. All construction to comply with City of Riv. Street Light Specifications.
7. Inspection to be called for as outline in specifications.
8. Feed point to be confirmed at time of construction.
9. $8.00 connection and inspection fee to be paid: ($20.00 Parcel 1 and $ 6.00 Parcel 2) (Site paid).
10. The City of Riverside Traffic Engr. Div. will pay $ 100.00 toward the cost of this project to the developer, upon completion of the work and receipt of a statement from the developer.
11. Excavation for street light standard bases, pullboxes and conduits must be done after installation of curb and gutters, but before installation of sidewalks.
12. Backfill to be of type and compacted as specified by City of Riv. Public Works Dept.
13. Contractor to obtain a street opening permit from City of Riv. Public Works Dept. before doing any excavation in proposed or dedicated street right of way.

GENERAL NOTES:

1. It shall be the responsibility of the contractor to clear the right of way in accordance with the provisions of law as it affects each utility including irrigation lines and appurtenances and at no cost to the City.
2. Construction shall be in accordance with the City of Riverside, Dept. of Public Works, Specifications No. 461 and Standard Drawings.
3. Prime Coat, Seal Coat and Plant Binder are required.
4. Grading will require a permit under ordinance 3093 for a cut or fill exceeding 100 cu. yds. or a fill over one foot in depth.
5. The developer shall arrange for a soil test at the subgrade level by a soils engineer. Thickness of pavement and thickness and type of aggregate base shall be determined by the soils engineer and submitted to the City of Riverside for approval prior to construction.
6. Trim edge of existing paving, where new paving joins existing pavement, to a clean straight line. Construct match-up paving as shown and overlay paving as directed in the field to produce a smooth crown section
7. For relocation of any City domestic or irrigation water facility, or Electric Power Utility facility to be done by City forces, contact Claire Hare Water Commercial Engr. at 787-7440. Schedule about 2 week to process a work order, before relocation work begins.

Approved for Street Light's
By: Jon Gimpler 3-26-68
General Supt. & Chief Engr. Date

J. F. DAVIDSON ASSOCIATES
Civil Engineers · Surveyors · Planners
Riverside, California
Approved by: George E. McCook Date: 2/3/68
R.C.E. No. 10688
W.O. 1760 FOR: Phil Fouke, Jr. F.B. 995/30

MARK	REVISIONS	APPR.	DATE
A	Added A.C. and A.B. requirements.		
B	Remove city portion from initial work		
C	Revise D-Land and "A" Value To Match		
D	FIELD CONDITIONS INDICATE REVISION OF D-LAND		6-10-68
E	PER ORDERS TO PROCEED FOR "INTERIM" PAVEMENT WORK ON PORTIONS OF PROJECT, CONSTRUCT PER STD. DRWG. NO. L1-18300, CONSTRUCT PER STD. DWG. NO. 308 OF STANDARD DRWG. DELIVERED 3/6.		
F	REVISE PAVING TO REFLECT CURRENT CONDITIONS AS PER FIELD NOTES.		

DESIGNED BY Jack DRAWN BY Jack CHECKED BY Edy

CITY OF RIVERSIDE, CALIFORNIA
DEPARTMENT OF PUBLIC WORKS

	BY	DATE
OFFICE ENGINEER		5-7
PARK DEPARTMENT		
TRAFFIC DIVISION		5/6
ASSISTANT CITY ENG.		5/14

APPROVED BY
DIRECTOR OF PUBLIC WORKS
DATE 5-15-68

R/S 1014
Street Plan and Profile
INDIANA AVE. ~ VAN BUREN BLVD.
(560' East of ℄ Van Buren Blvd.) SOUTH SIDE
(400' South of ℄ Indiana Ave.) EAST SIDE

HORIZ. SCALE: 1" = 40' VERT. SCALE: 1" = 4'

PROJECT NO. L5-13304
R-1282
SHEET 1 OF 1
FILE NO. 3350