CROSS SECTIONS

Scale: 1 Inch = 5 feet

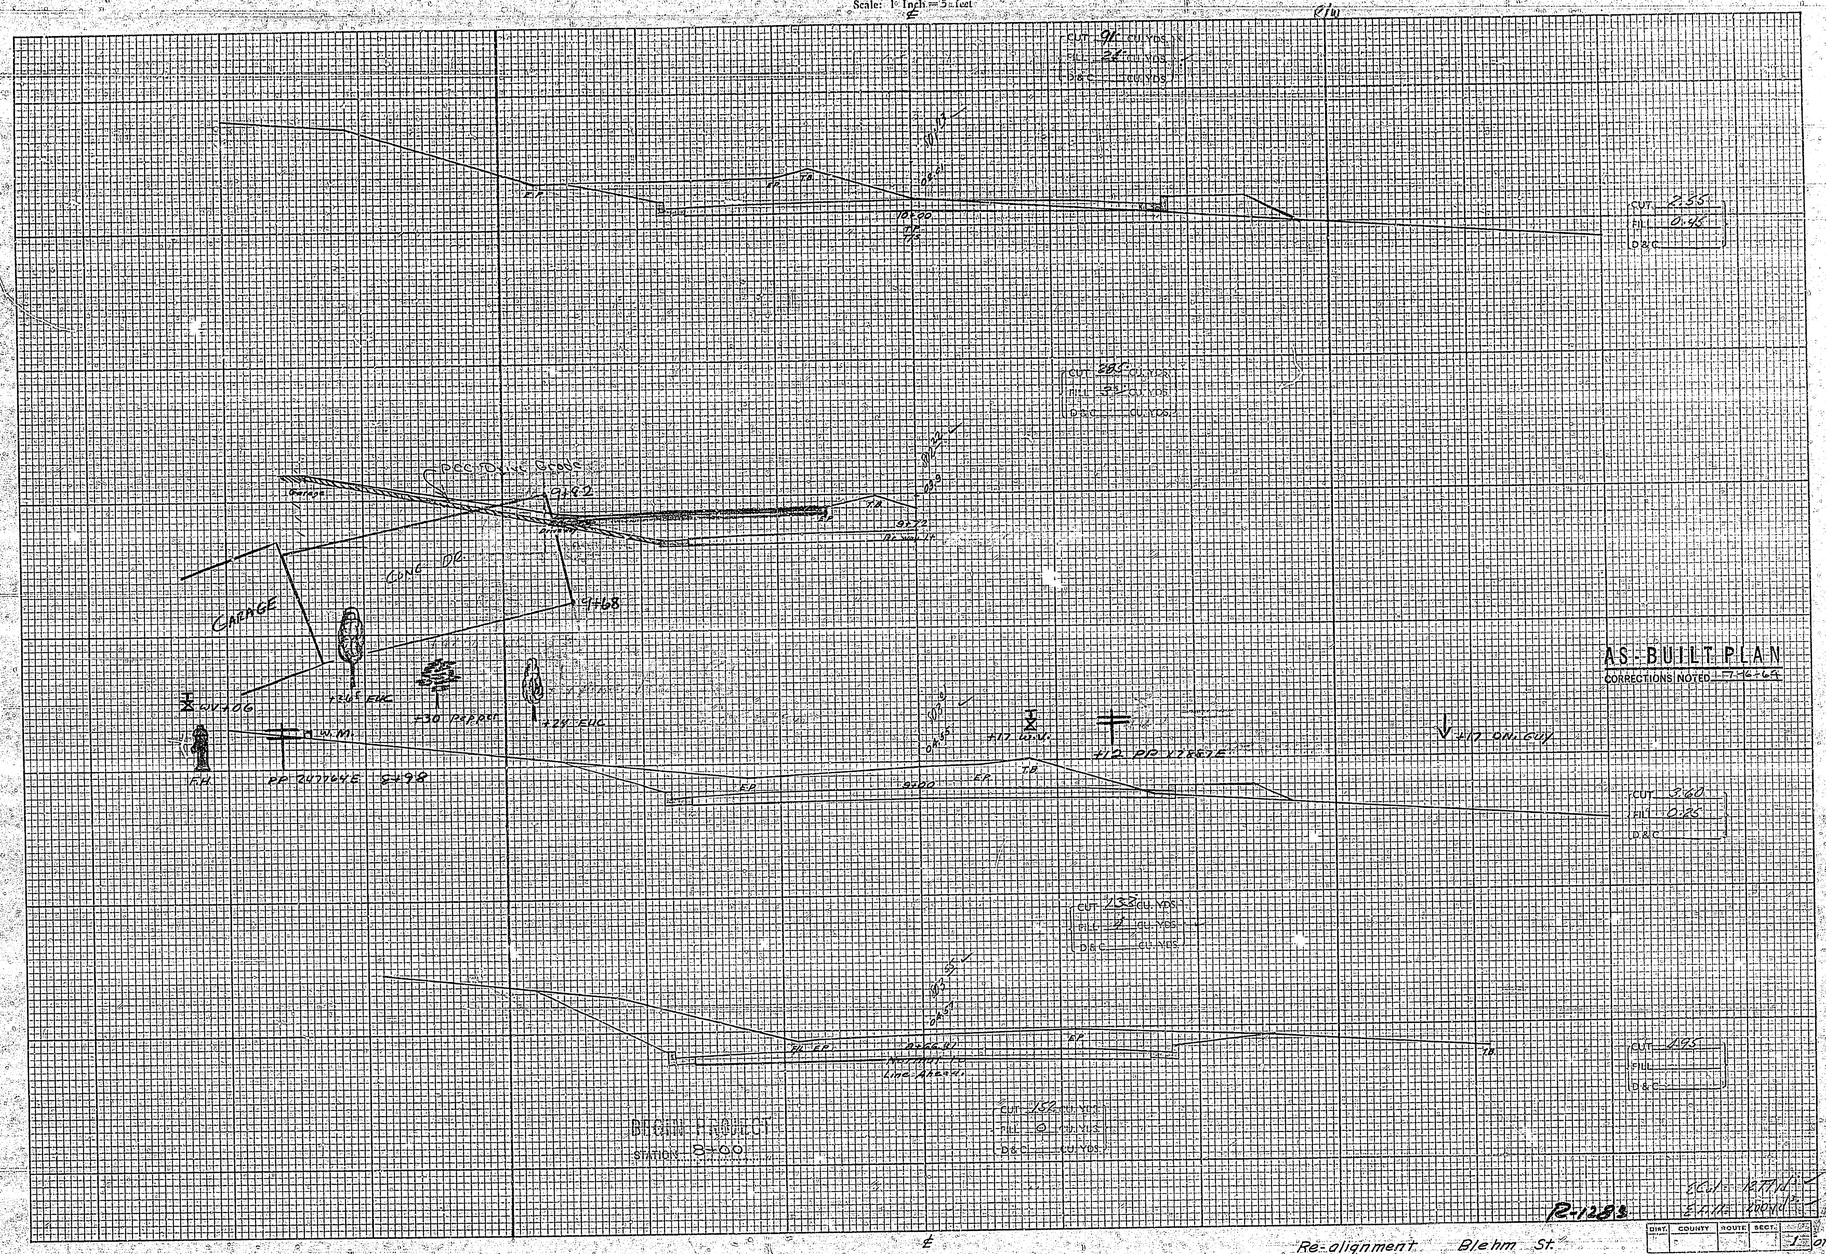

AS-BUILT PLAN

CORRECTIONS NOTED 7-16-69

R-1283

Re-alignment Blehm St.

DIST.	COUNTY	ROUTE	SECT.	
				1 of 5

CROSS SECTIONS

Scale: 1 Inch = 5 feet

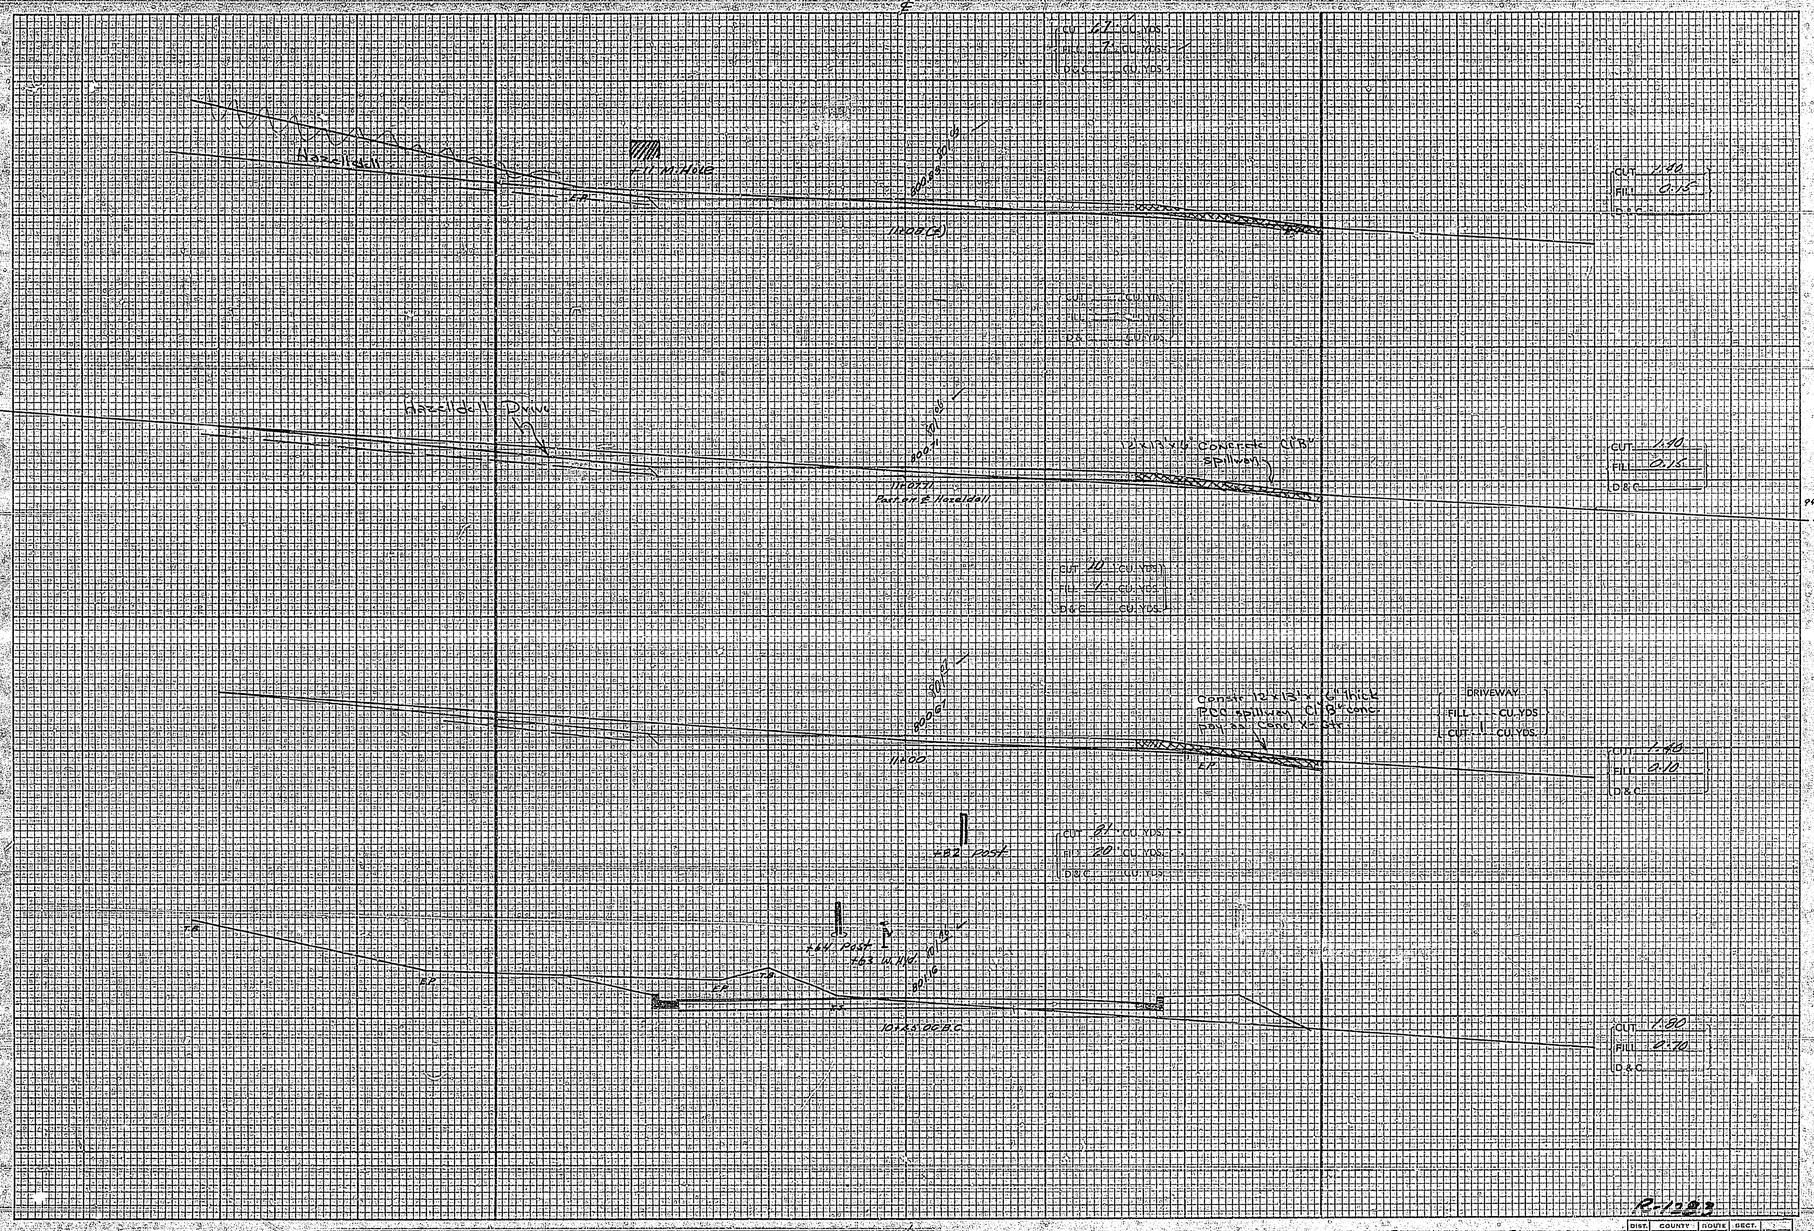

R-1283

DIST.	COUNTY	ROUTE	SECT.	
				2 of 5

CROSS SECTIONS

Scale: 1 Inch = 5 feet

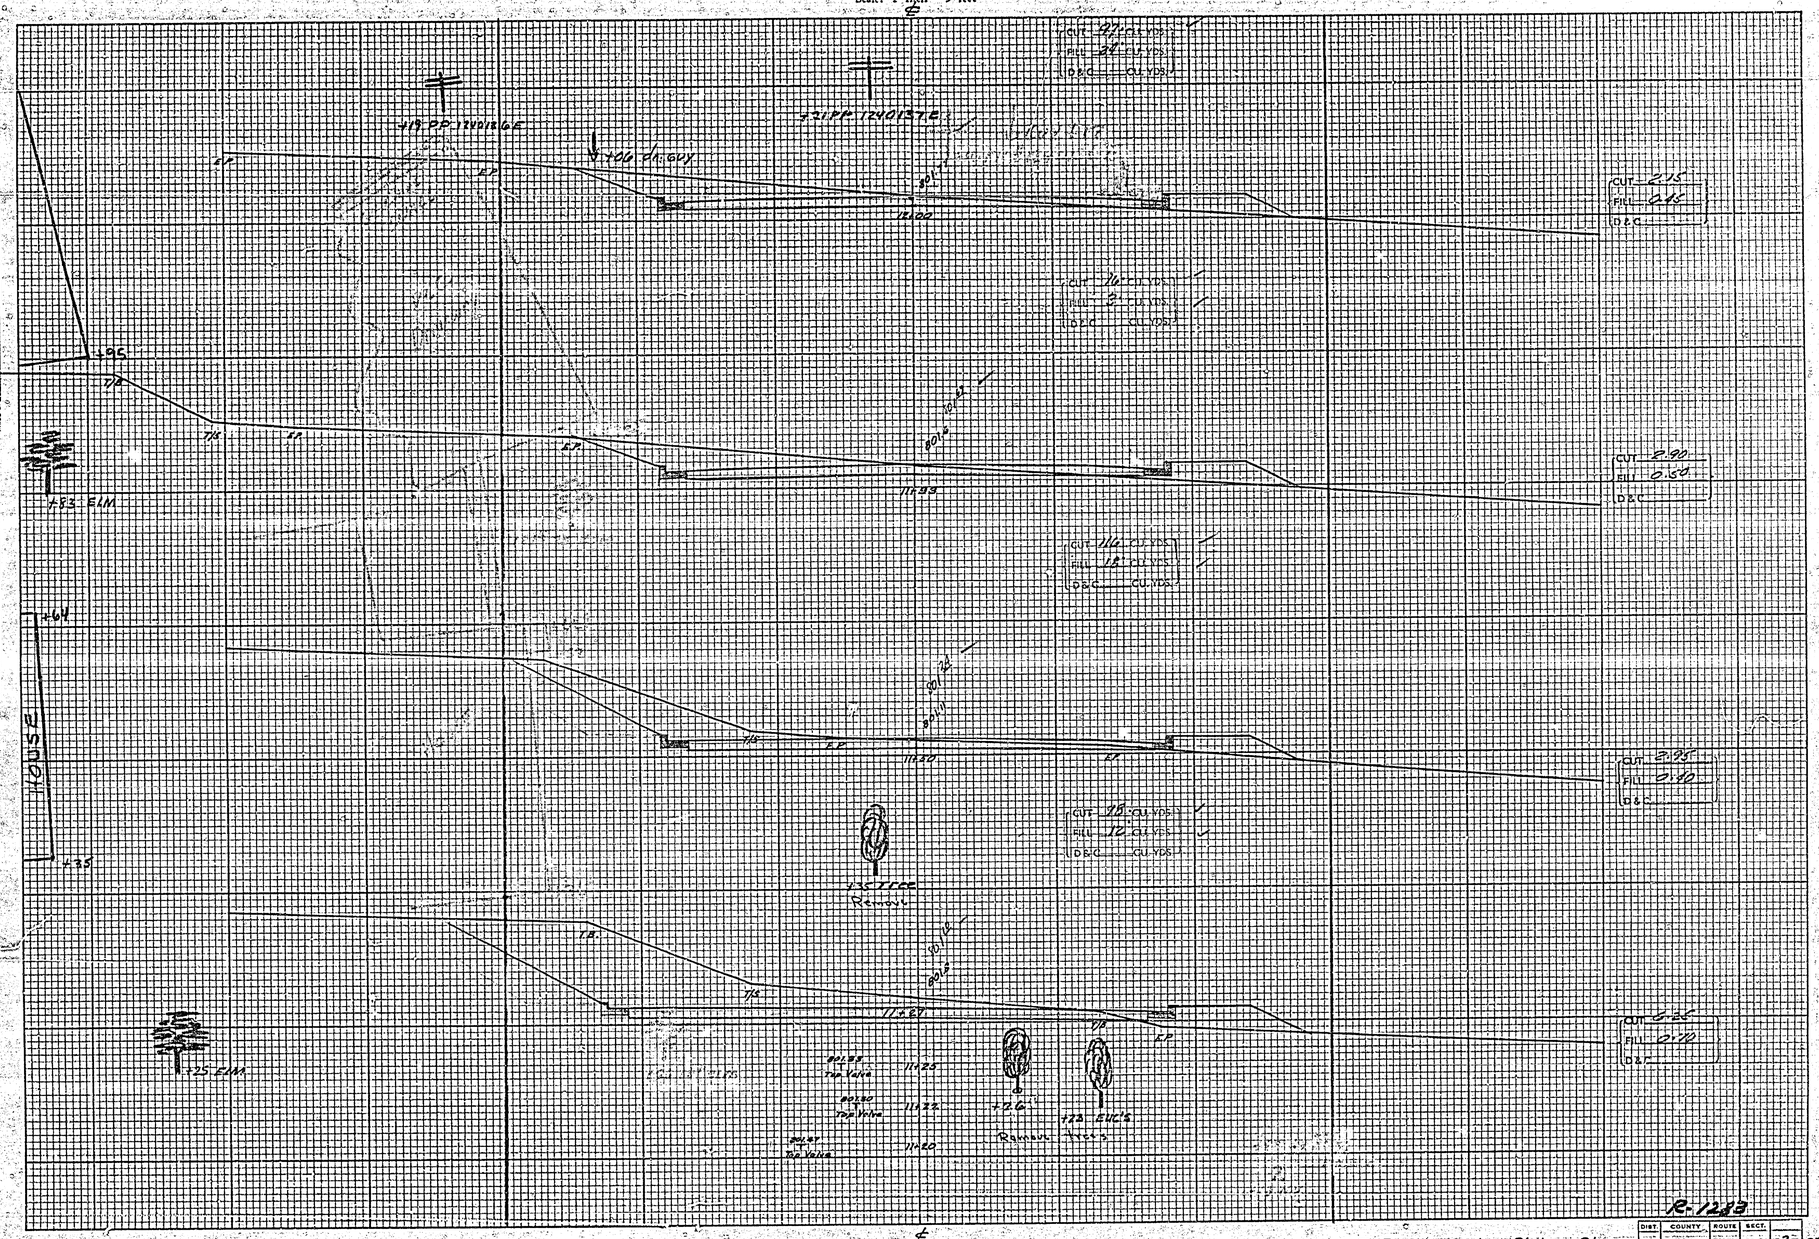

CROSS SECTIONS

Scale: 1 Inch = 5 feet

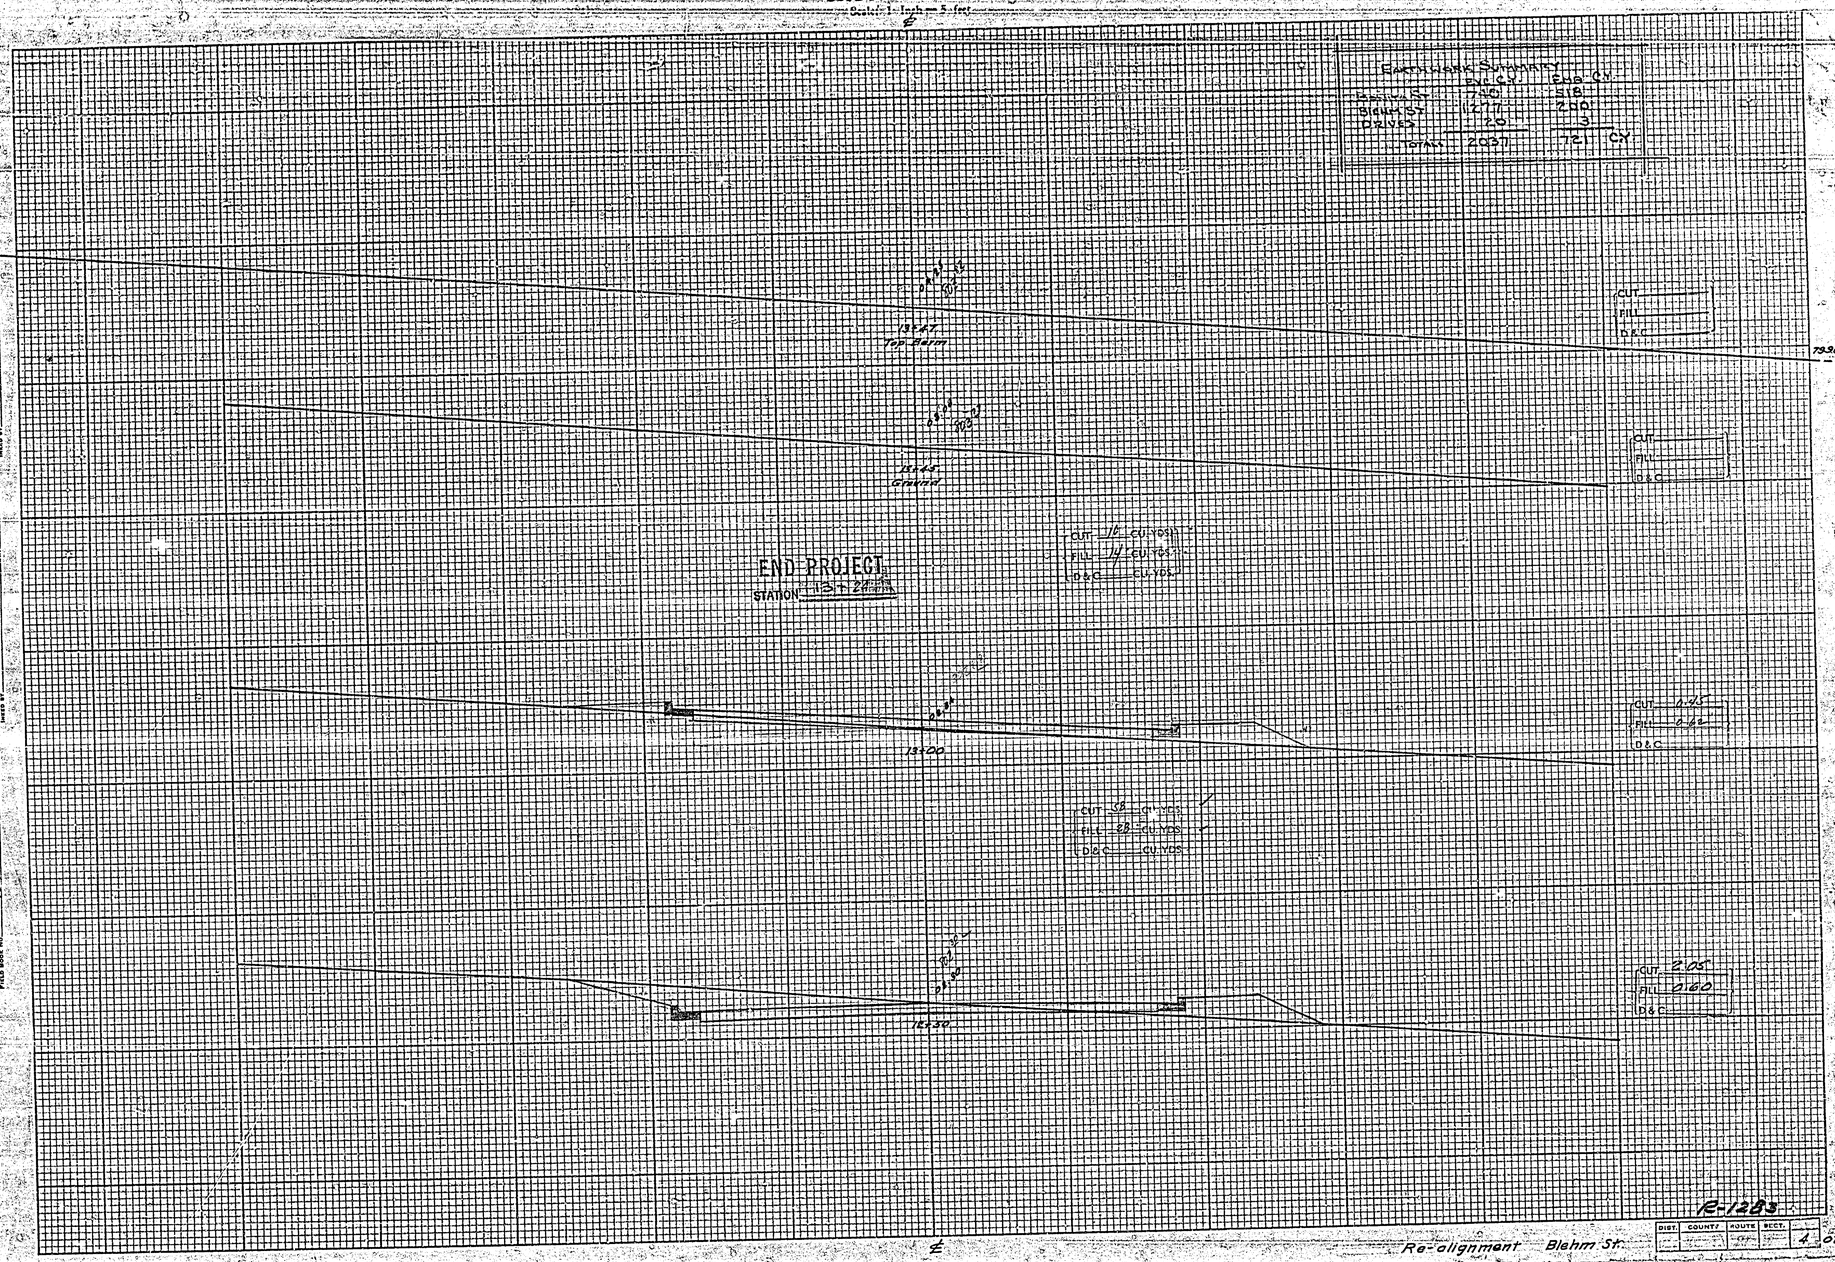

EARTHWORK SUMMARY	EVC CY	EMB CY
BLEHM ST	740	518
BLEHM ST	1277	200
DRIVES	20	3
TOTALS	2037	721 CY

TEMPLET

PLOTTED BY Hanning DATE 7-28-83
CHECKED BY Thurlow DATE
PLANIMETER BY Hanning DATE
MEED BY DATE

GROUND

PLOTTED BY T.E.M. DATE 5-29-83
CHECKED BY DATE
MEED BY DATE

SURVEYED BY 3376
FIELD BOOK NO. 904

R-1283

Re-alignment Blehm St.

DIST.	COUNTY	ROUTE	SECT.	
				4 of 5

CROSS SECTIONS

Scale: 1 Inch = 5 feet

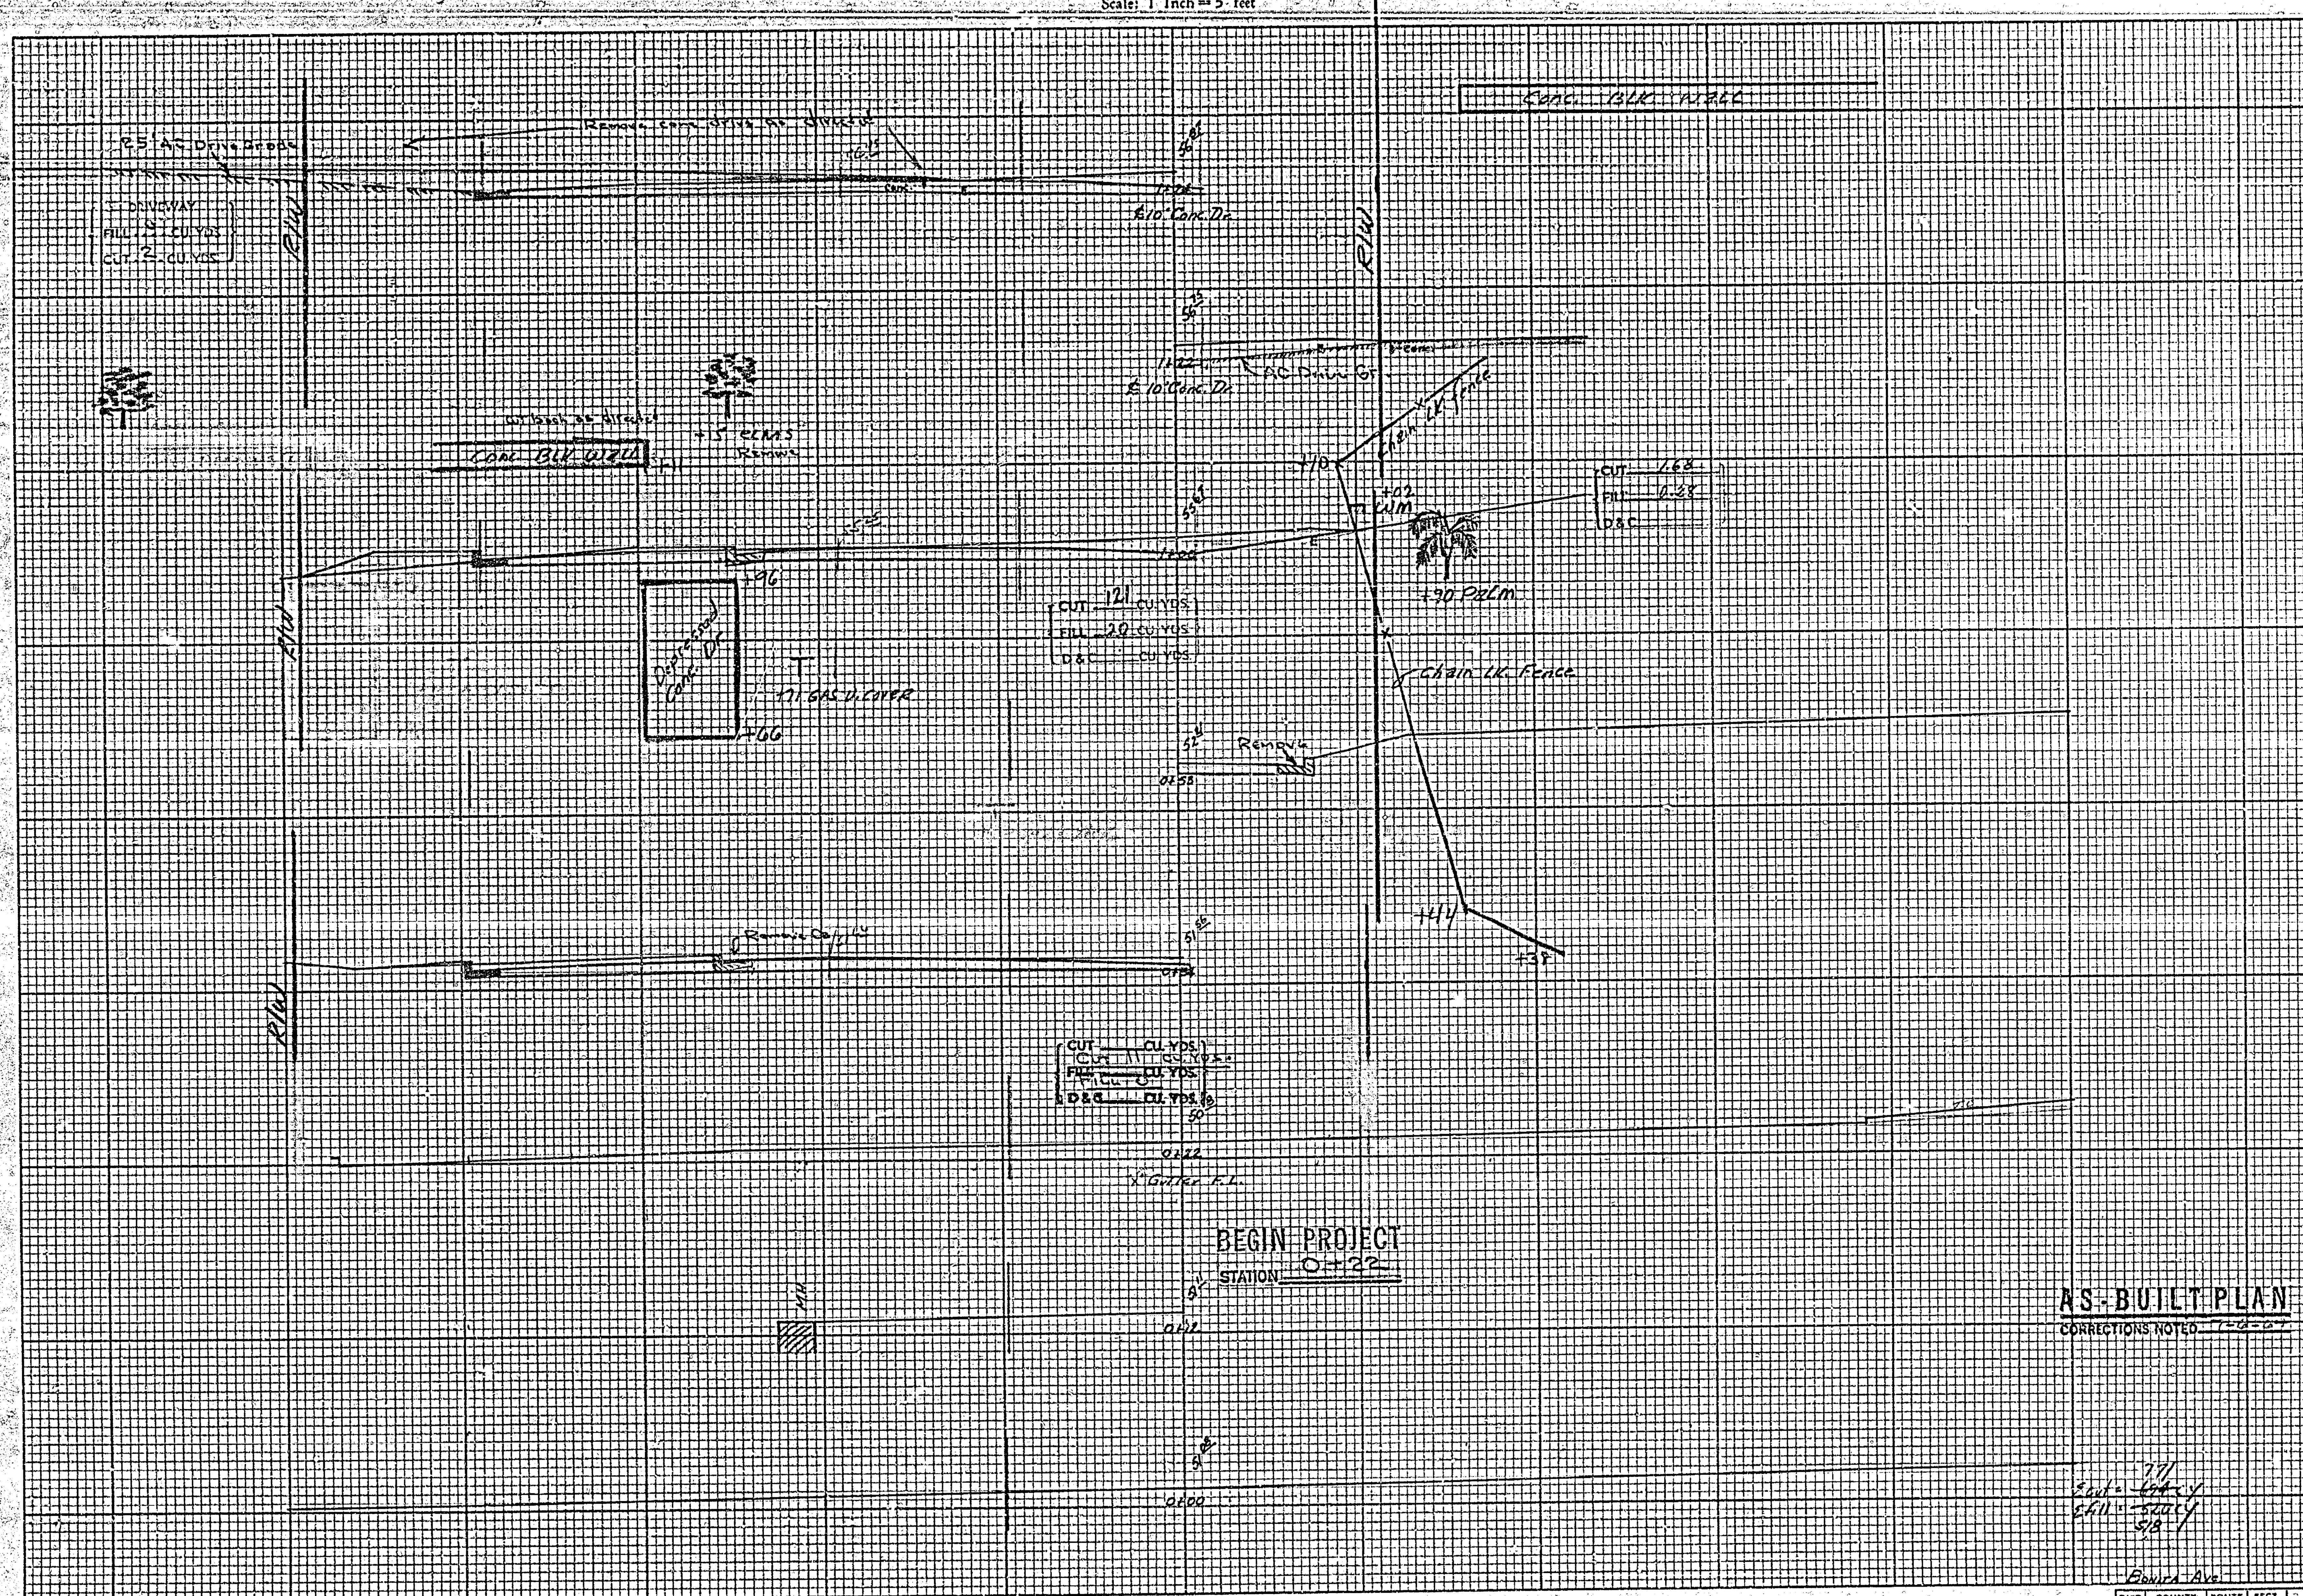

TEMPLET
PLOTTED BY Manning DATE
CHECKED BY Thornton DATE 1-12-61
PLANIMETER BY DATE
INKED BY DATE

GROUND
PLOTTED BY Manning DATE
CHECKED BY DATE
INKED BY DATE

SURVEYED BY 3376
FIELD BOOK NO. 904

R-1288

DIST.	COUNTY	ROUTE	SECT.	
				1

764-I

CROSS SECTIONS

Scale: 1 Inch = 5 feet

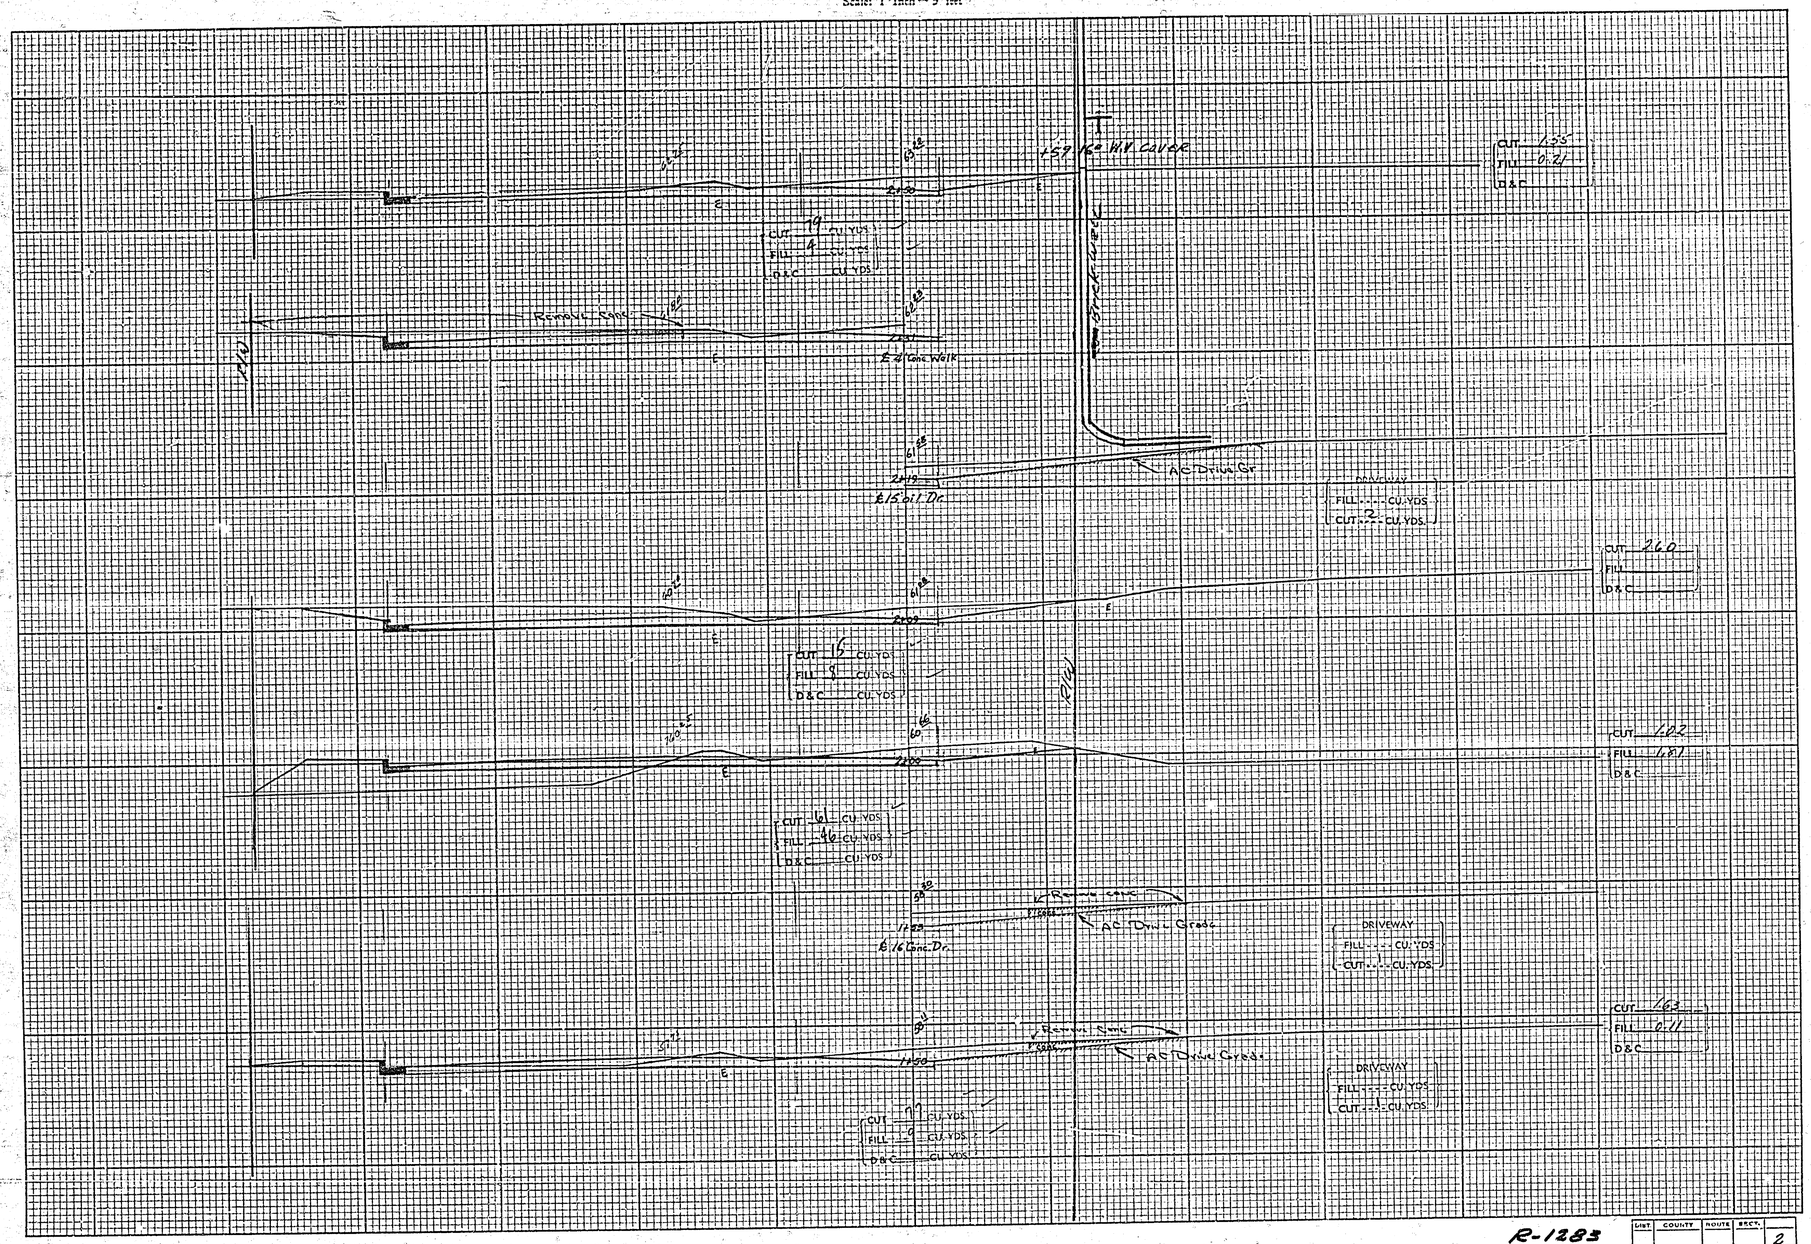

R-1283

DIST.	COUNTY	ROUTE	SECT.	
				2

TEMPLET

PLOTTED BY ____ DATE ____
CHECKED BY ____ DATE ____
PLANIMETER BY ____ DATE ____
INKED BY ____ DATE ____

GROUND

PLOTTED BY Manning DATE ____
CHECKED BY ____ DATE ____
INKED BY ____ DATE ____

SURVEYED BY 3376
FIELD BOOK NO. 904

CROSS SECTIONS

Scale: 1 Inch = 5 feet

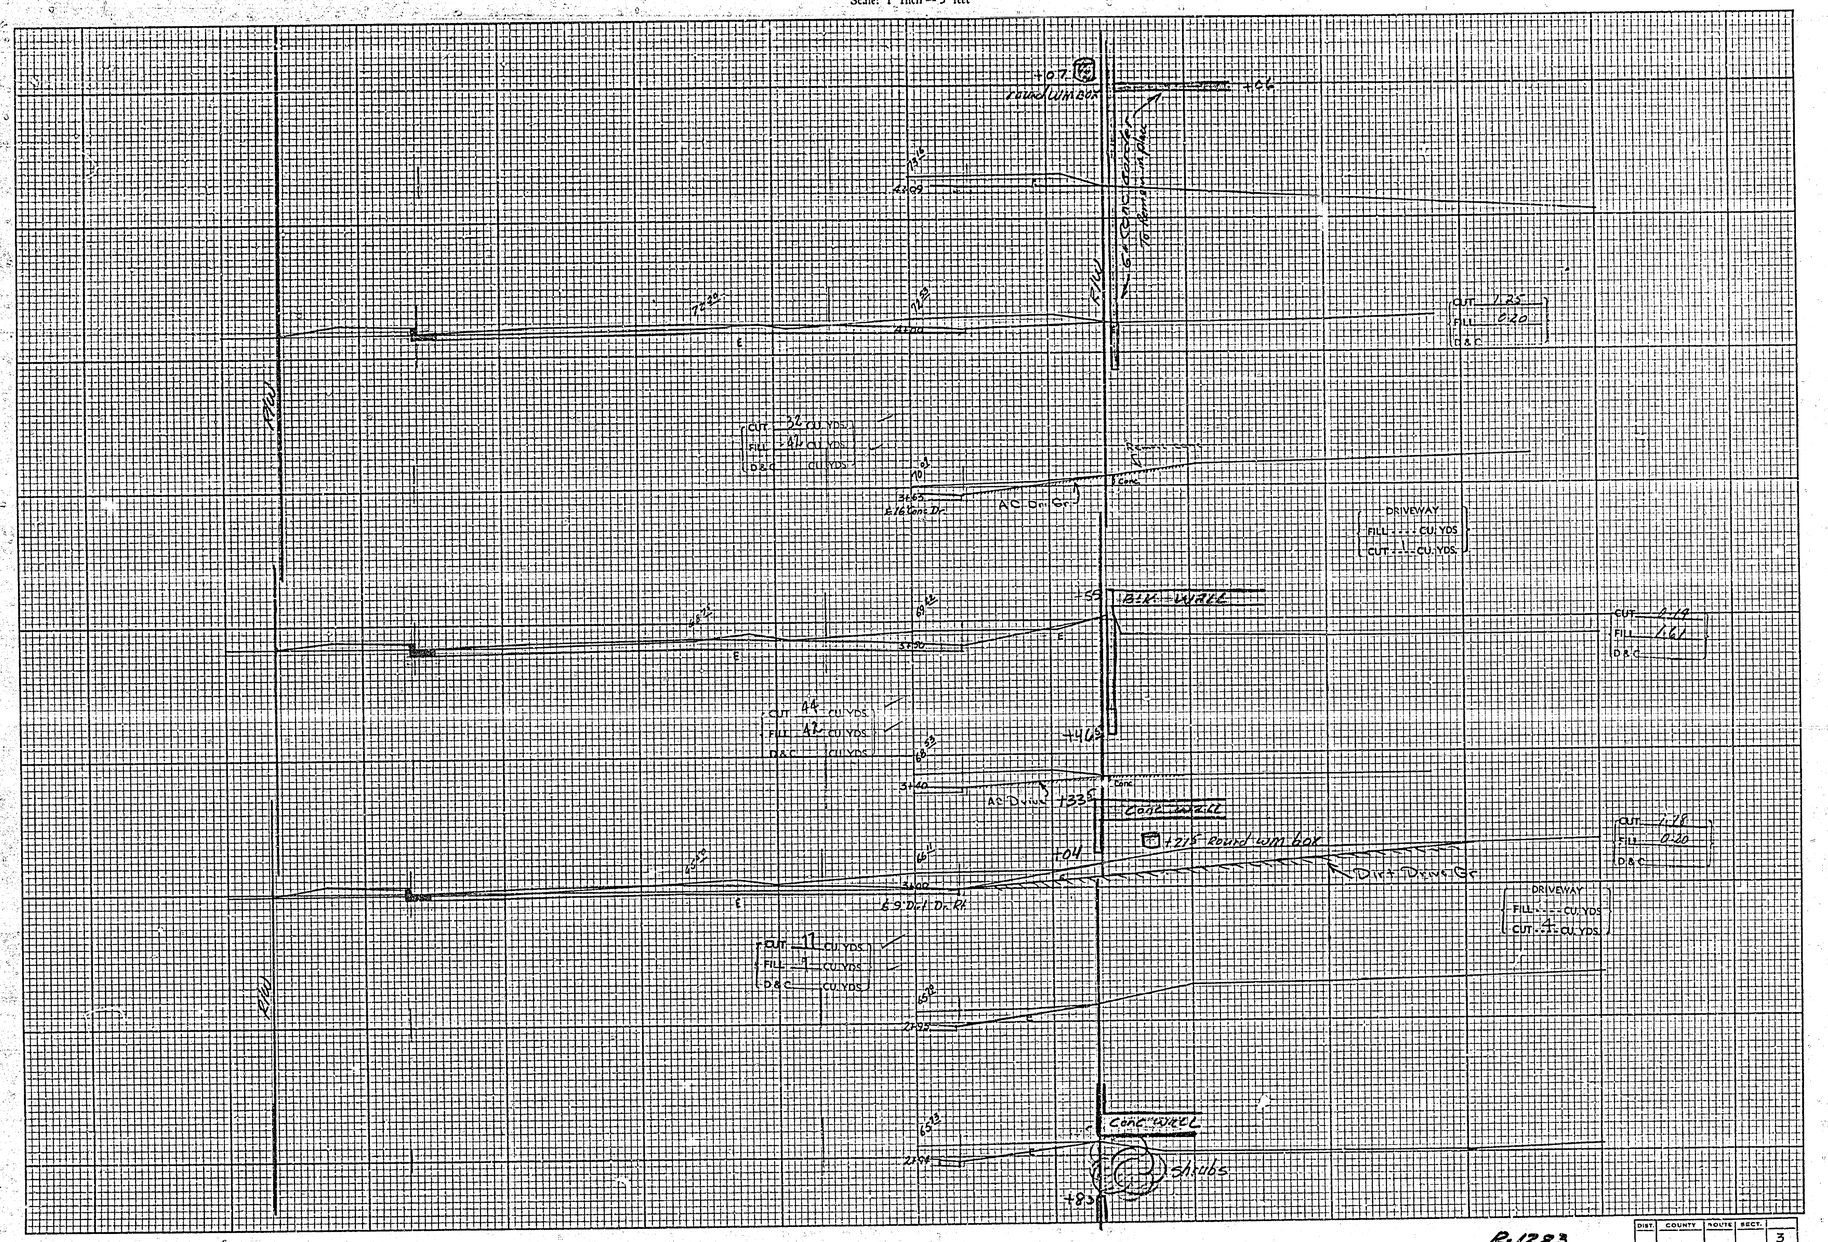

R-1283

DIST.	COUNTY	ROUTE	SECT.	
				3

TEMPLET

PLOTTED BY ____ DATE ____
CHECKED BY ____ DATE ____
PLANIMETER BY ____ DATE ____
INKED BY ____ DATE ____

GROUND

PLOTTED BY ____ DATE ____
CHECKED BY ____ DATE ____
INKED BY ____ DATE ____

SURVEYED BY ____
FIELD BOOK NO. ____

CROSS SECTIONS

Scale: 1 Inch = 5 feet

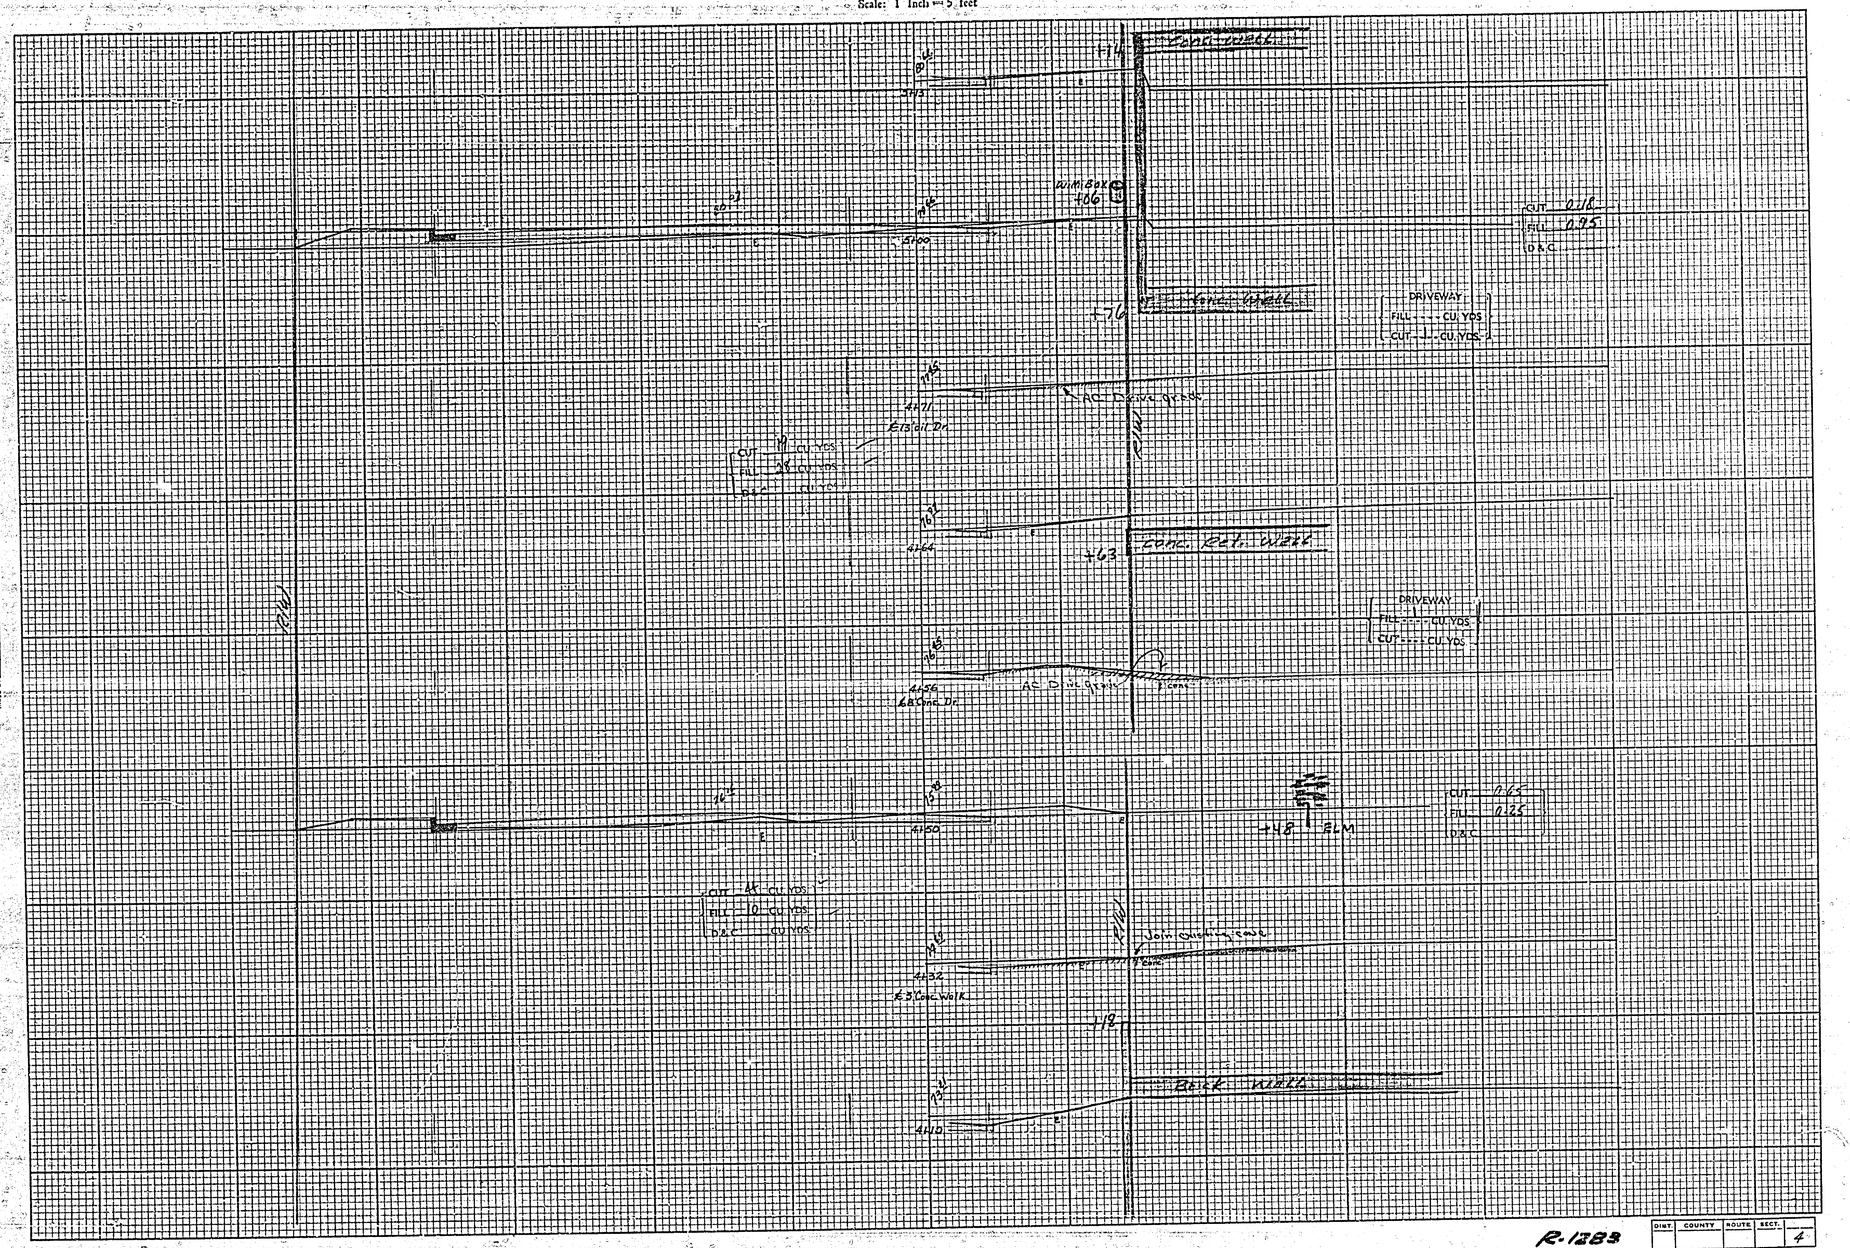

R-1283

DIST.	COUNTY	ROUTE	SECT.	
				4

TEMPLET

PLOTTED BY ____ DATE ____
CHECKED BY ____ DATE ____
PLANIMETER NO. ____ DATE ____
INKED BY ____ DATE ____

GROUND

PLOTTED BY ____ DATE ____
CHECKED BY ____ DATE ____
INKED BY ____ DATE ____

SUBMITTED BY ____
FIELD BOOK NO. ____

CROSS SECTIONS

Scale: 1 Inch = 5 feet

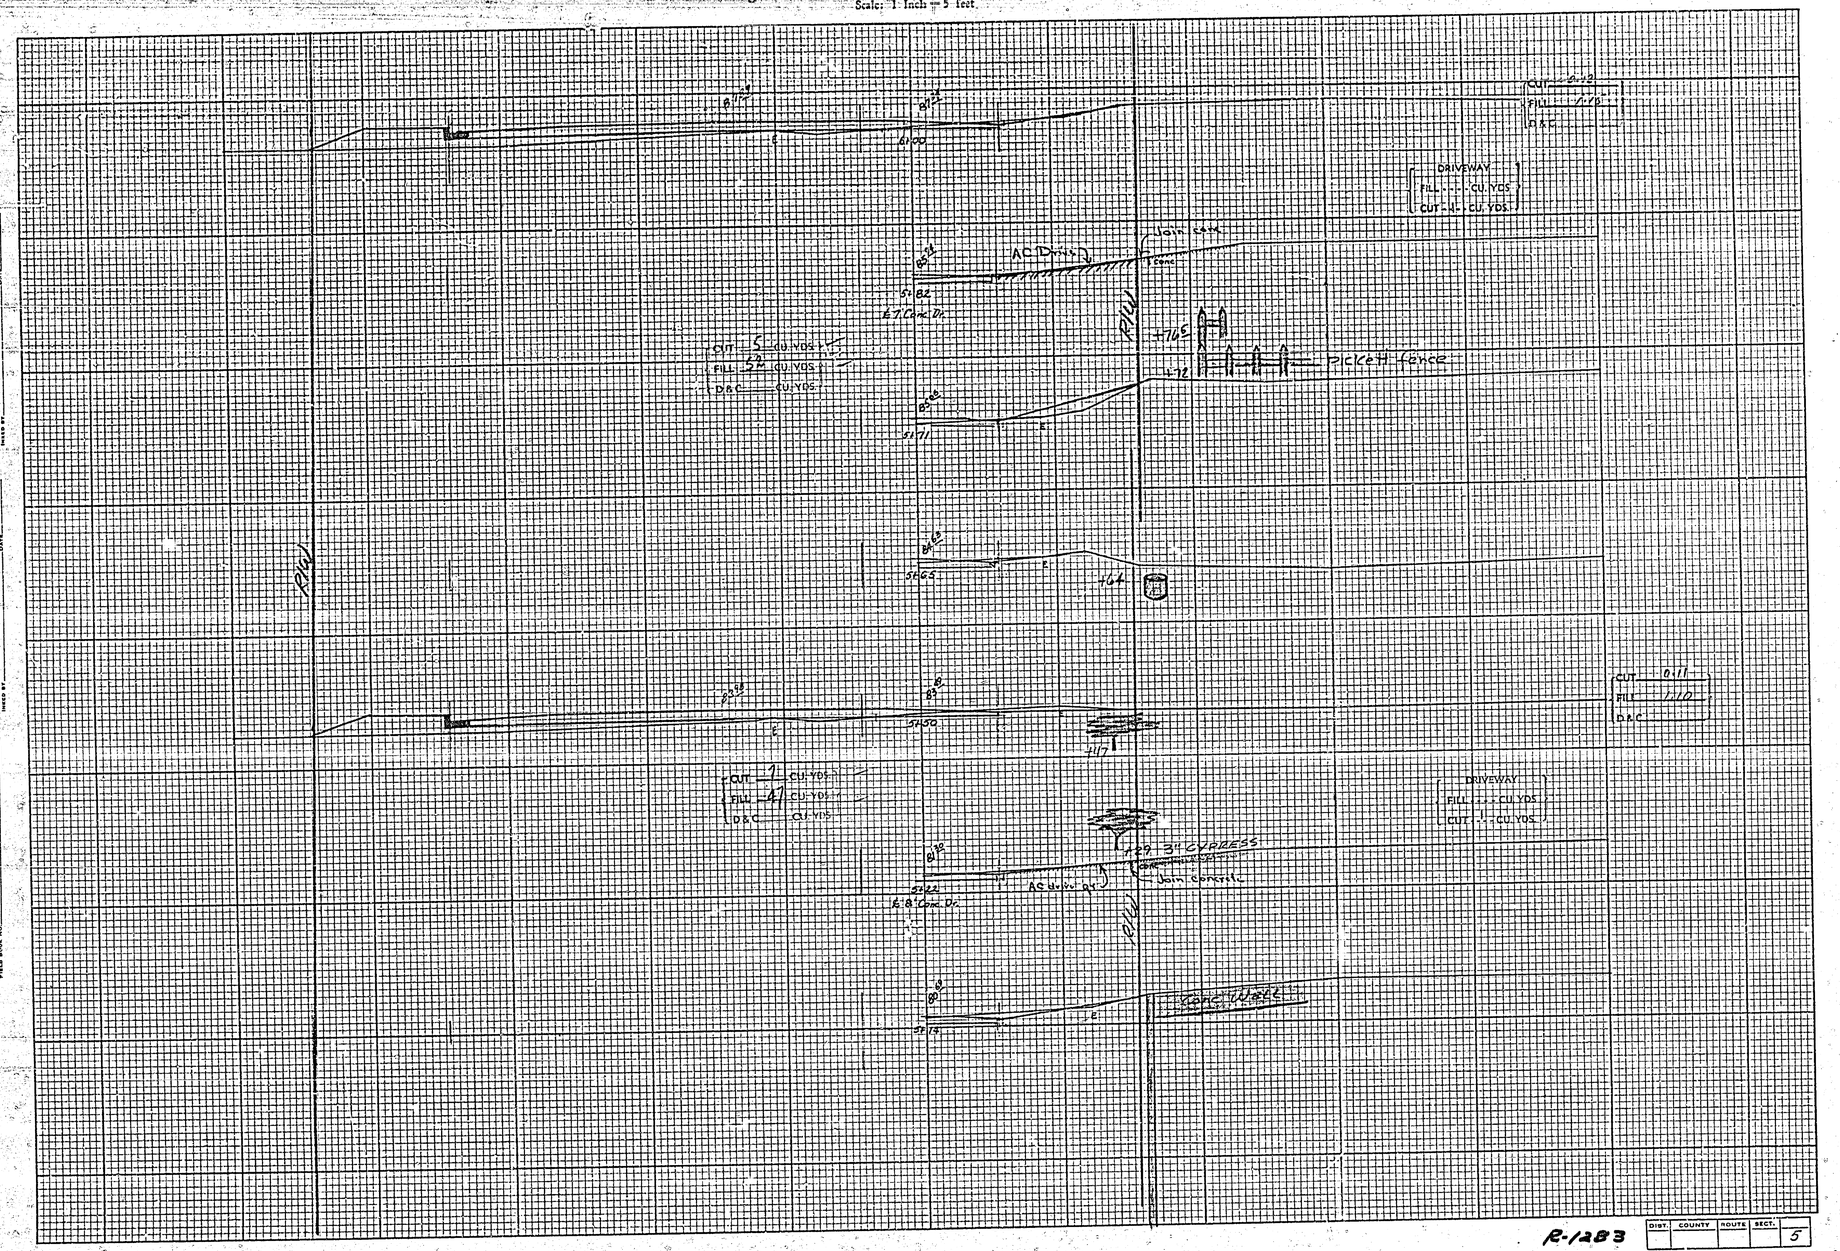

R-1283

DIST.	COUNTY	ROUTE	SECT.	
				5

CROSS SECTIONS

Scale: 1 Inch = 5 feet

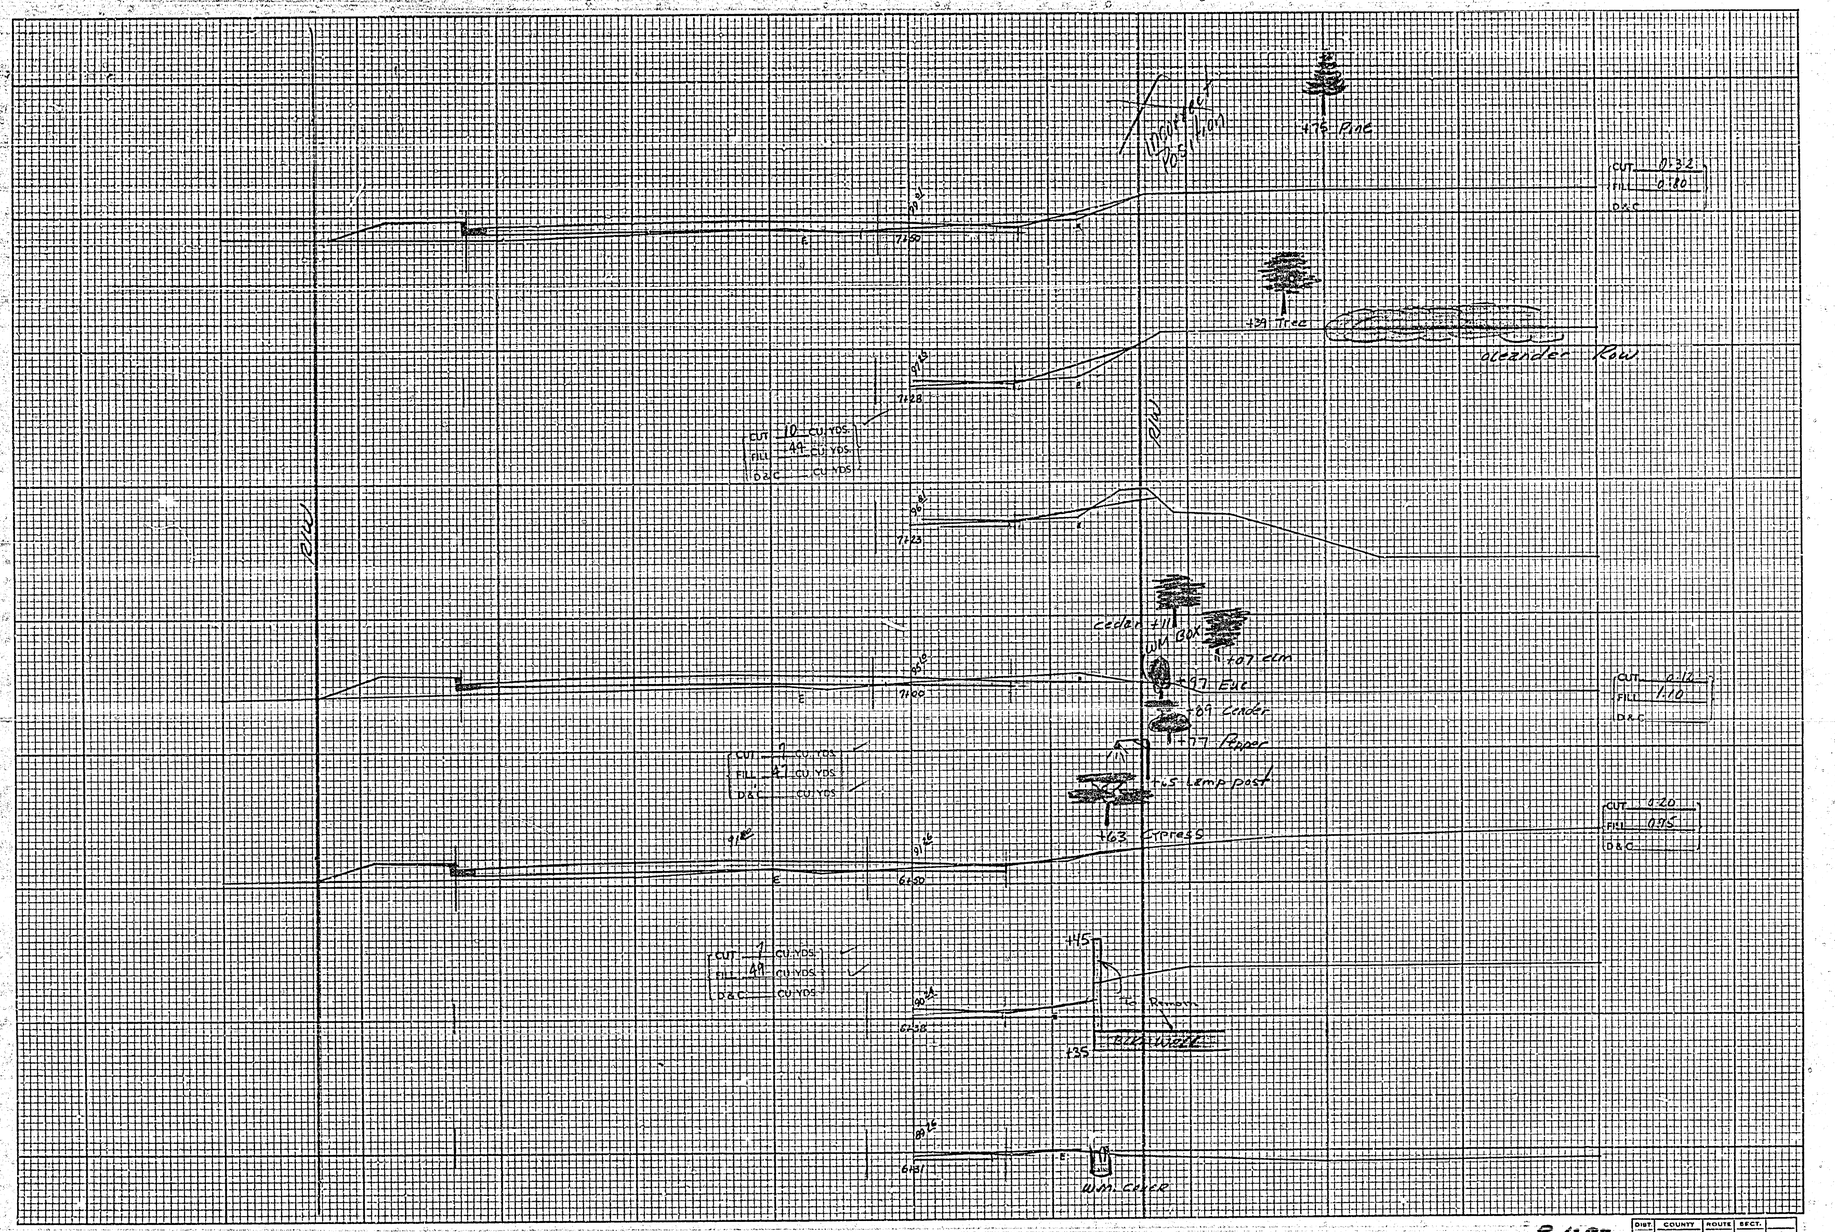

DIST.	COUNTY	ROUTE	SECT.	
				6

R-1283

TEMPLET — PLOTTED BY ___ DATE ___ CHECKED BY ___ DATE ___ PLANIMETER BY ___ DATE ___ INKED BY ___ DATE ___

GROUND — PLOTTED BY ___ DATE ___ CHECKED BY ___ DATE ___ INKED BY ___ DATE ___

SURVEYED BY ___ FIELD BOOK NO. ___

CROSS SECTIONS

Scale: 1" Inch = 5' feet

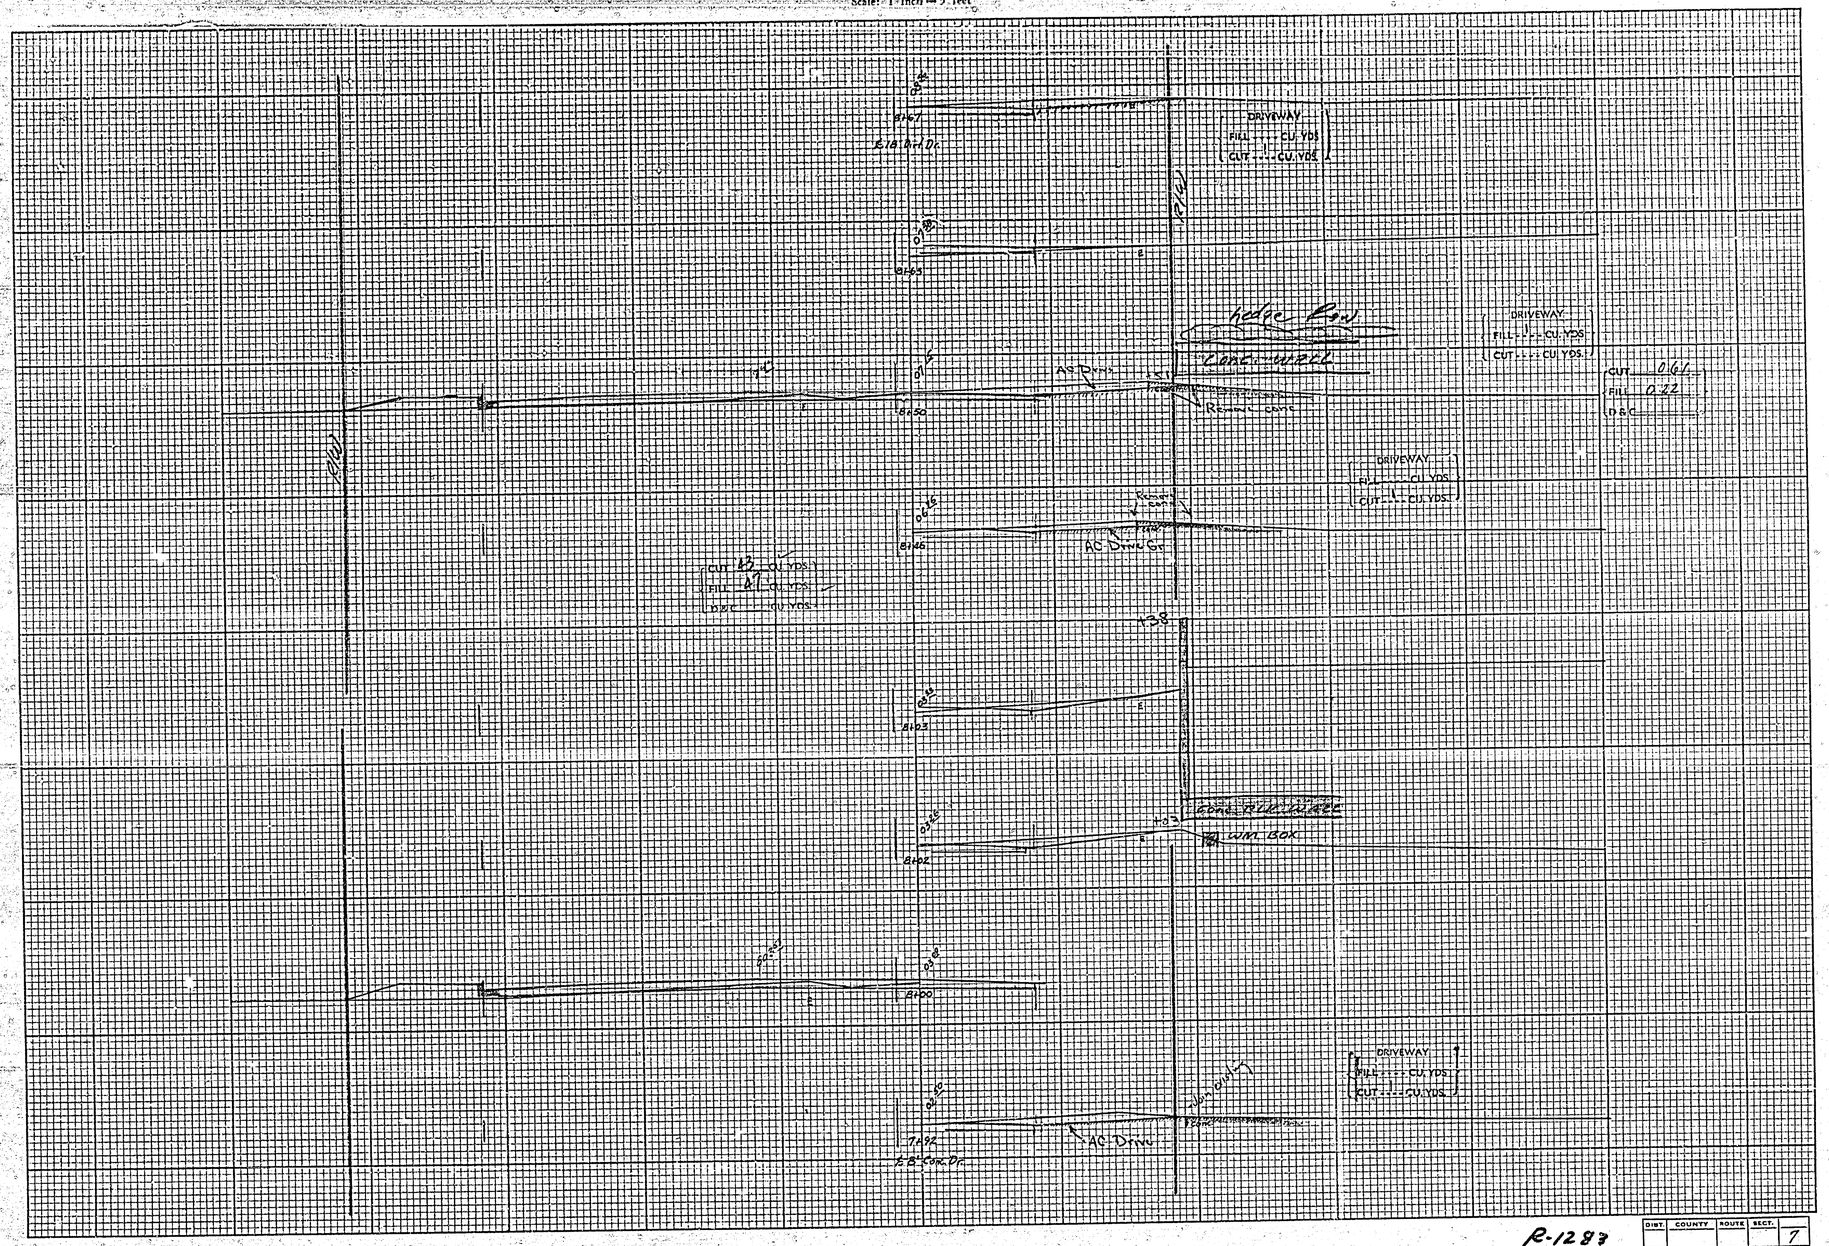

TEMPLET

PLOTTED BY DATE
CHECKED BY DATE
PLANIMETER BY DATE
INDEX BY DATE

GROUND

PLOTTED BY DATE
CHECKED BY DATE
INDEX BY DATE

SURVEYED BY
FIELD BOOK NO.

R-1287

DIST.	COUNTY	ROUTE	SECT.	
				7

CROSS SECTIONS

Scale: 1 Inch = 5 feet

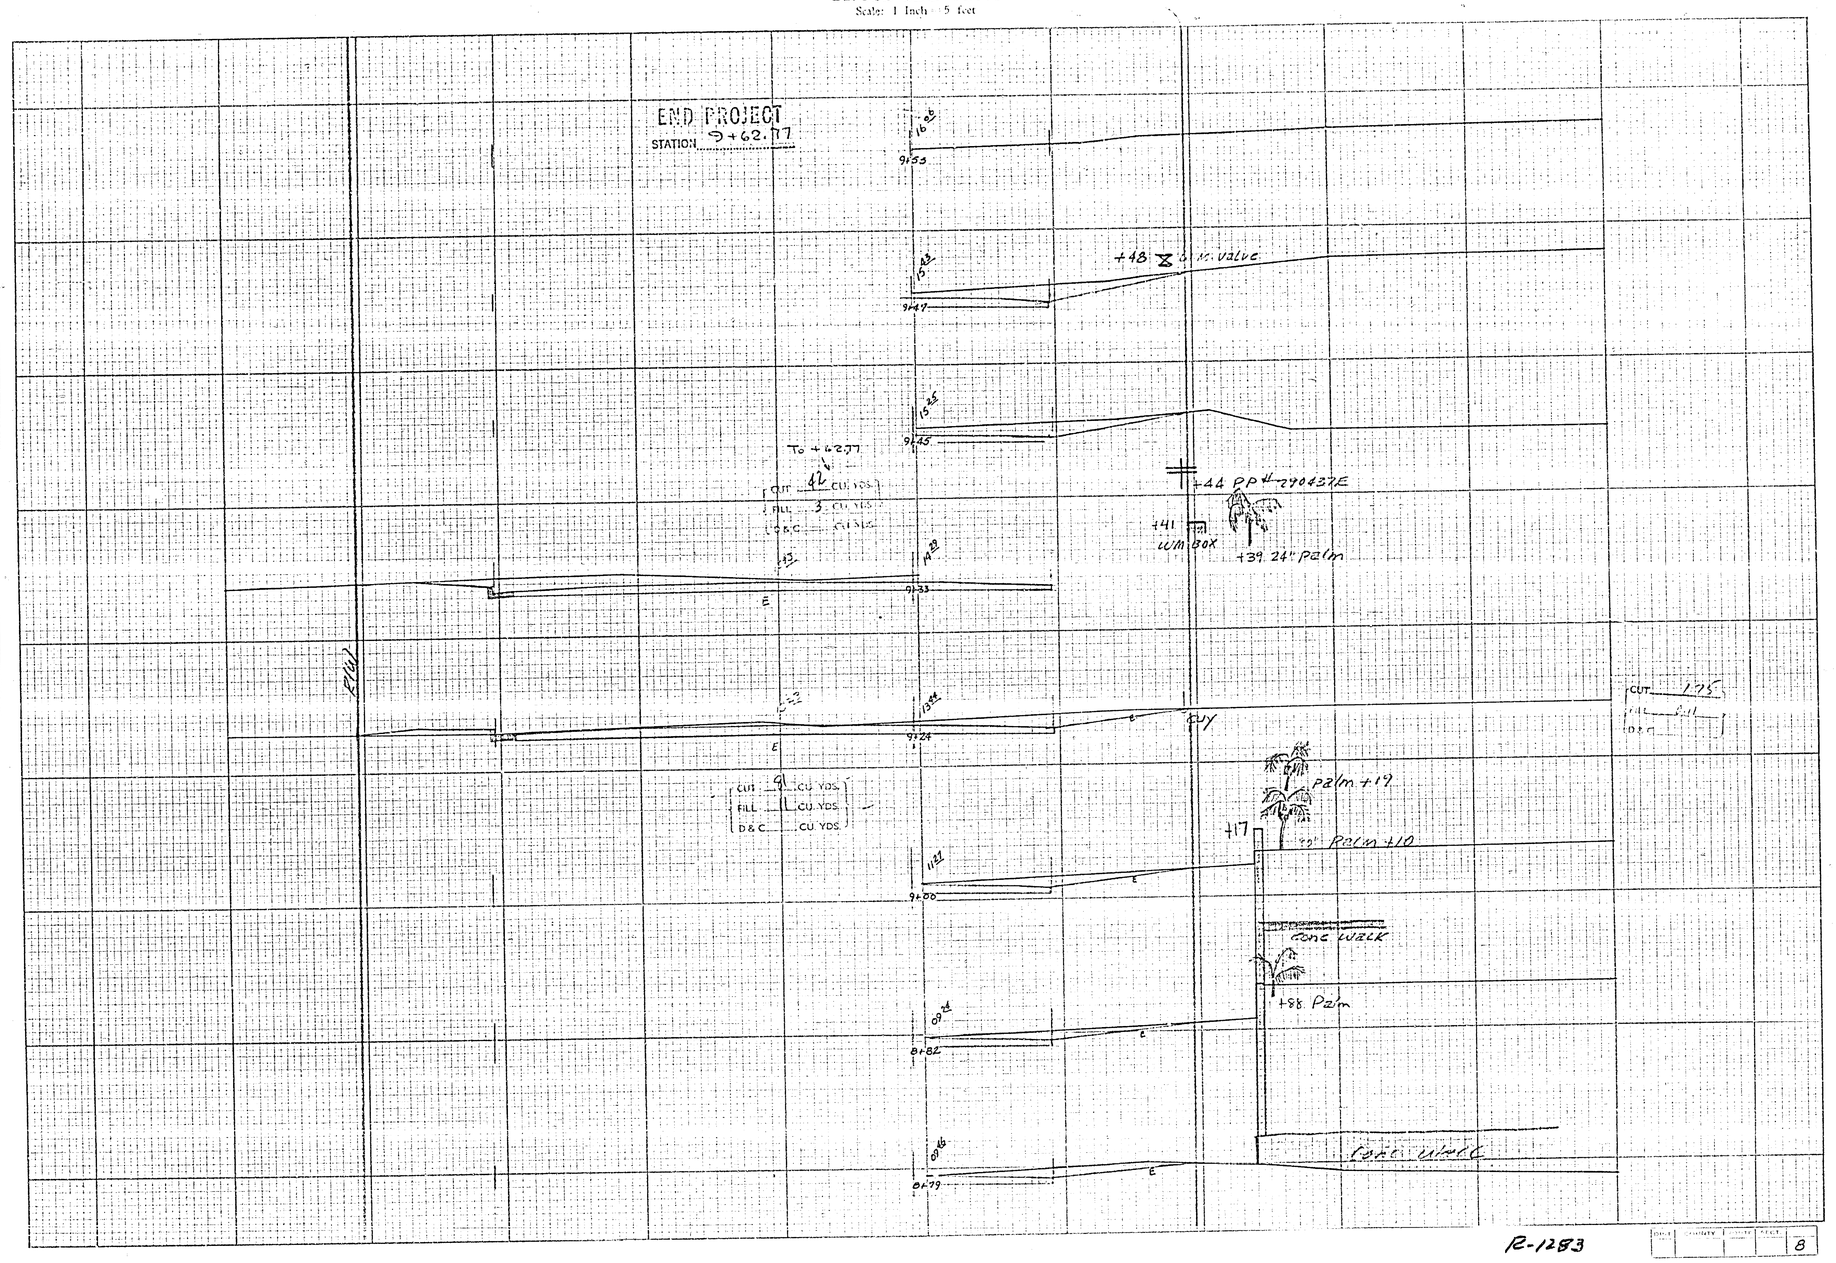

R-1283

8

BLEHM STREET

PEPPER DRIVE TO BONITA AVENUE

Survey No. 3376 Field Book No. 904
Road No. 1035 Work Order No.
A.C. Keith County Surveyor and Road Commissioner
Jan 1964

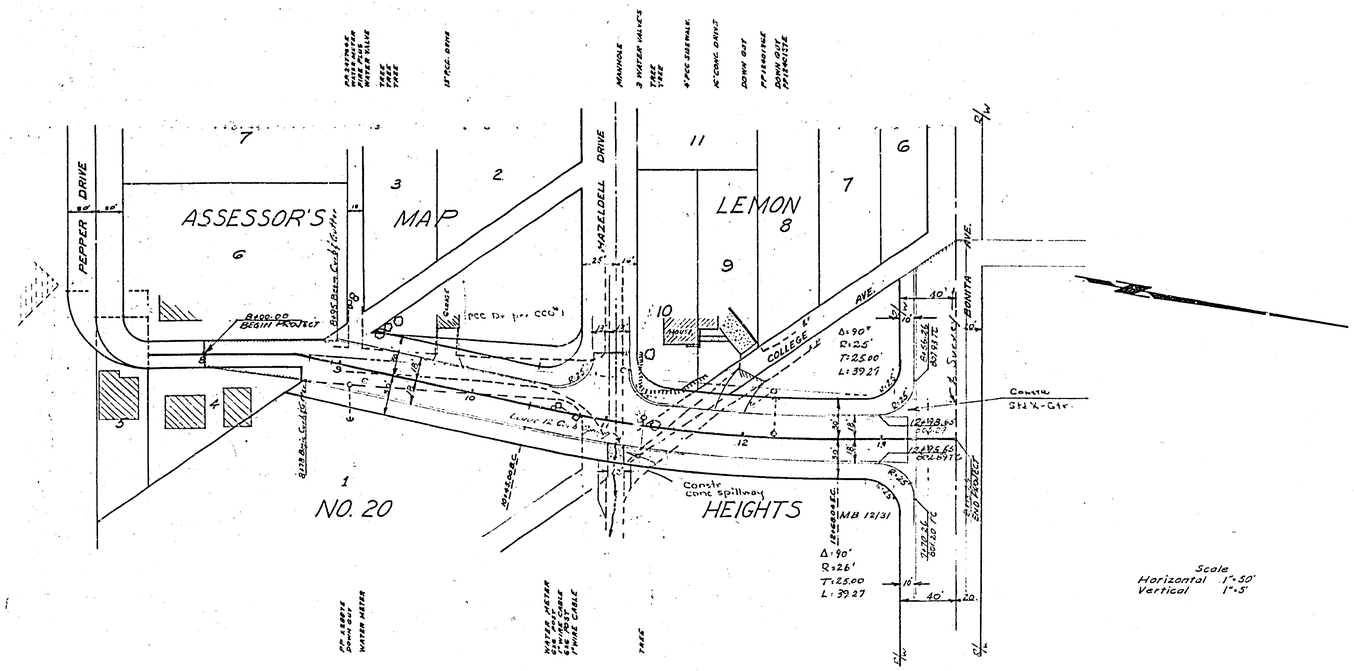

AS-BUILT PLAN
CORRECTIONS NOTED 7-6-69

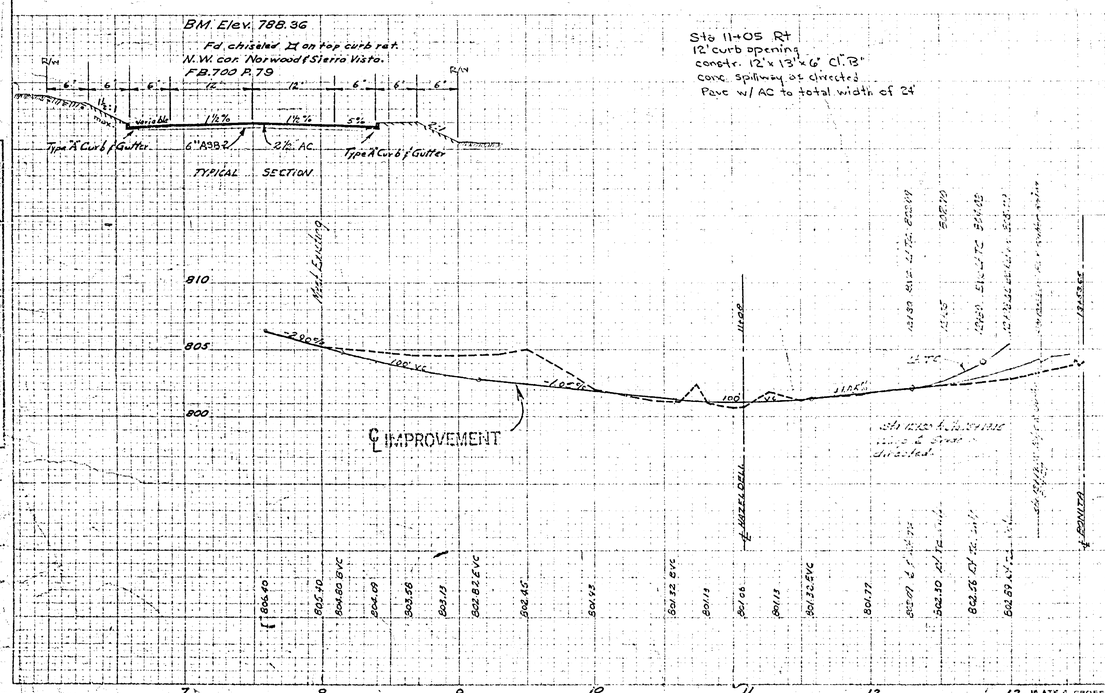

R-1283
1 OF 2
764-I

BONITA AVENUE

SIERRA VISTA TO COLLEGE AVENUE

Survey No. 3376 Field Book No. 904
Road No. 1041 Work Order No.
A.C. Keith County Surveyor and Road Commissioner
Jan. 1964

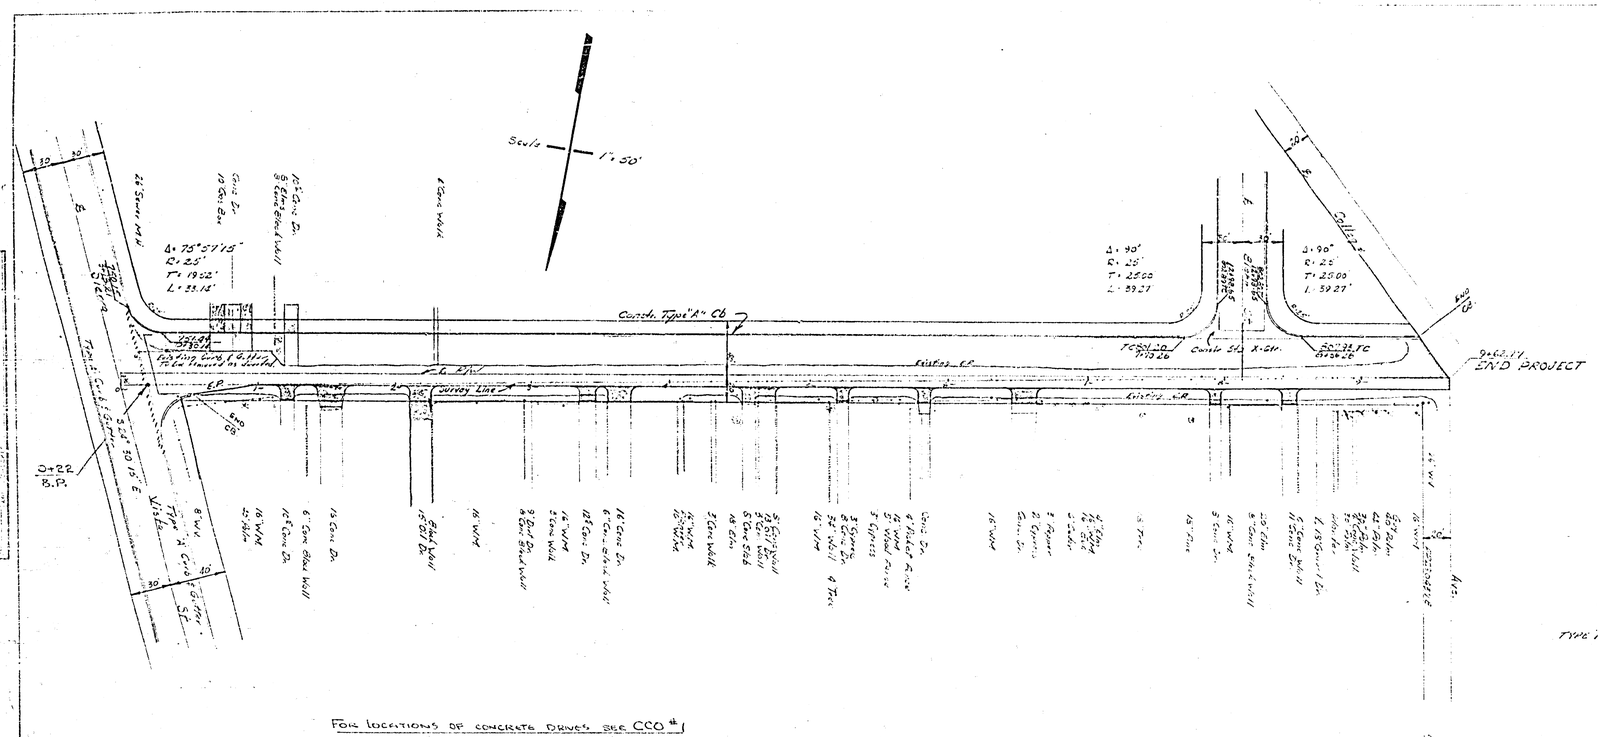

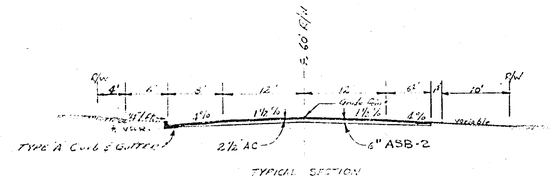

AS-BUILT PLAN
CORRECTIONS NOTED 7-6-64

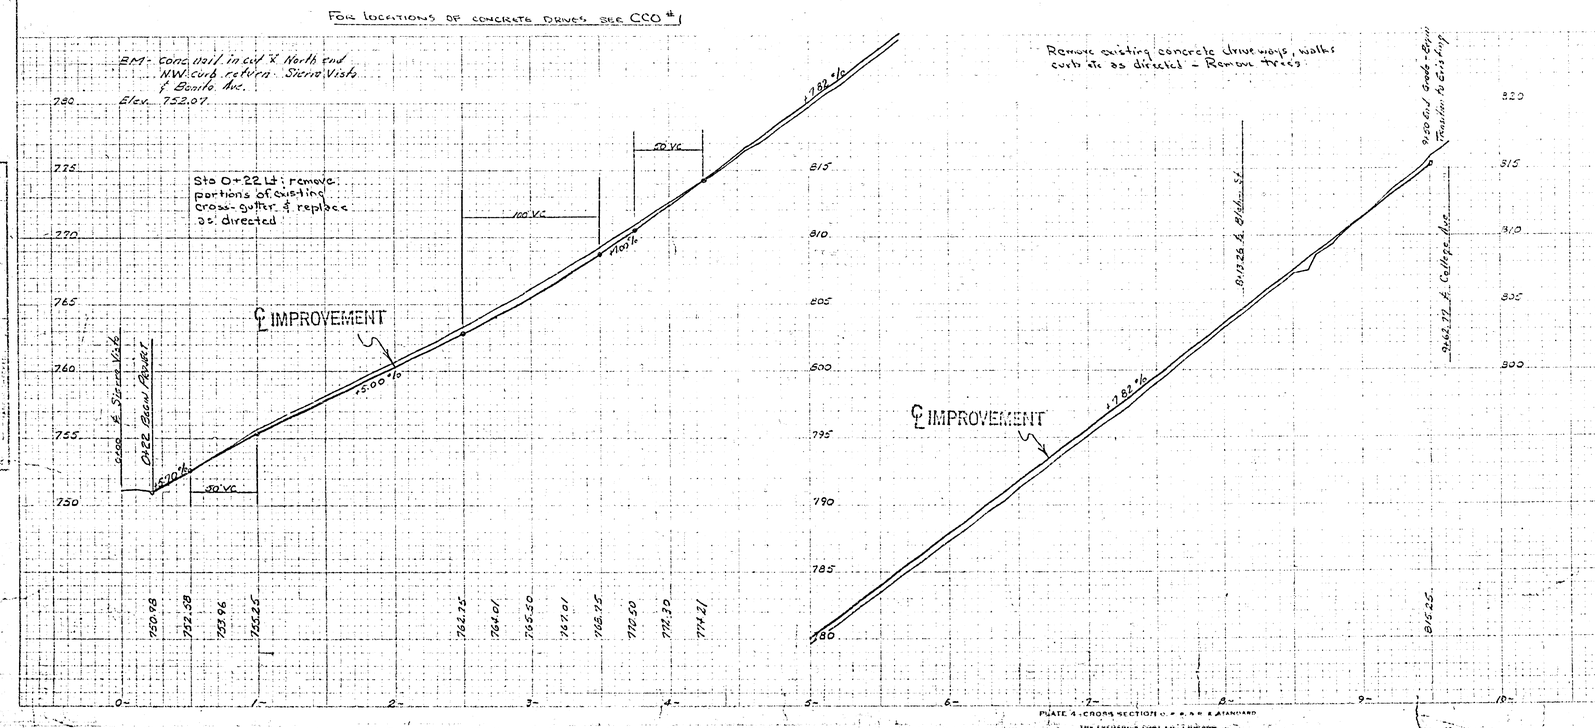

R-1283

2 of 2

764-I