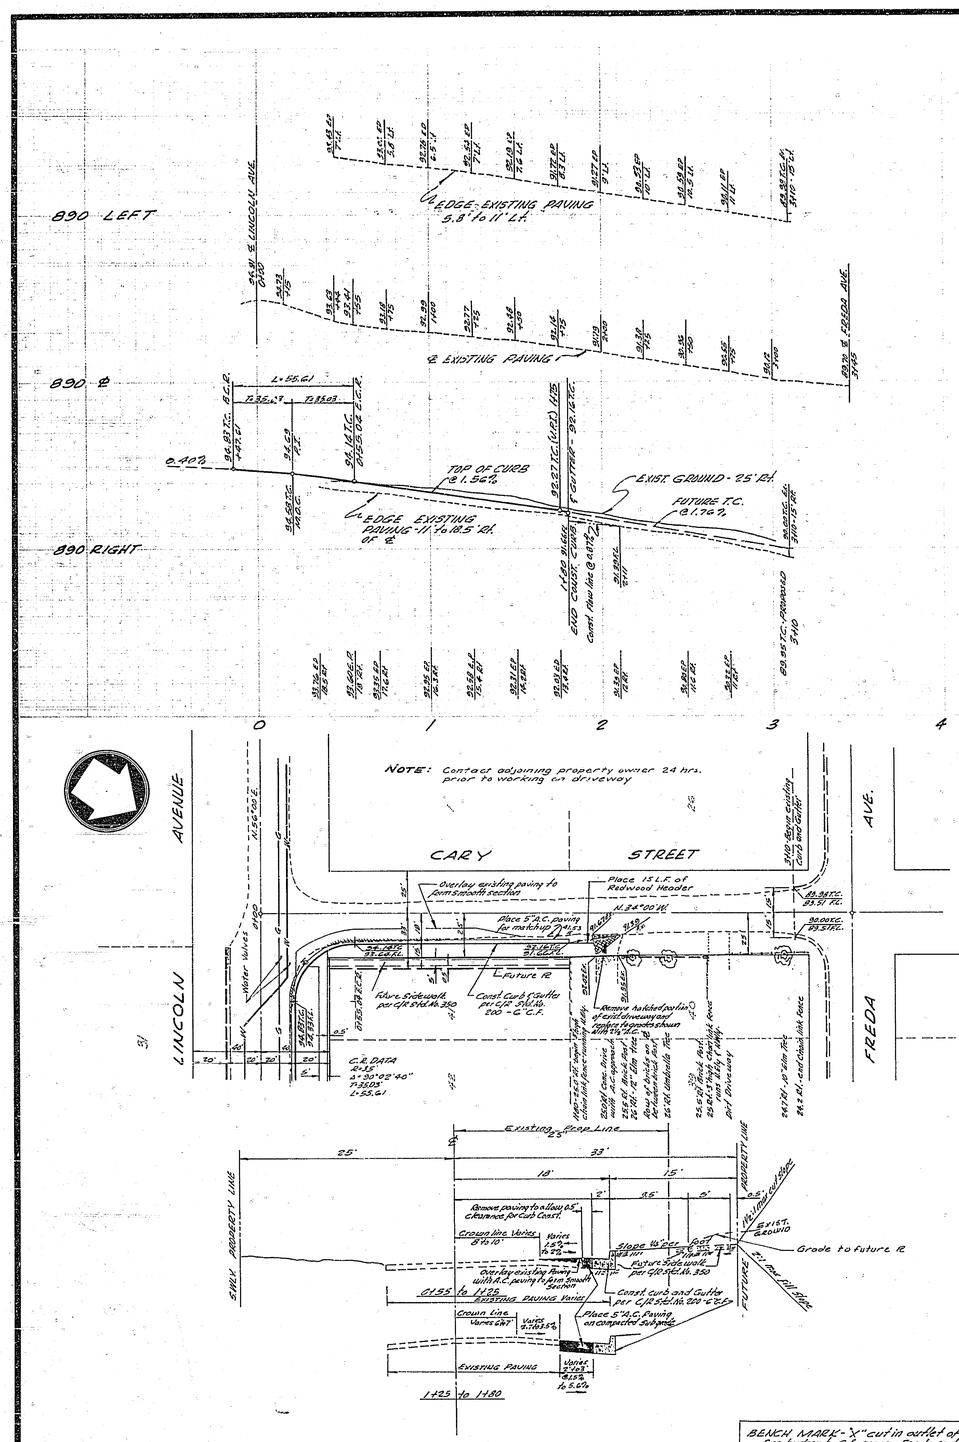

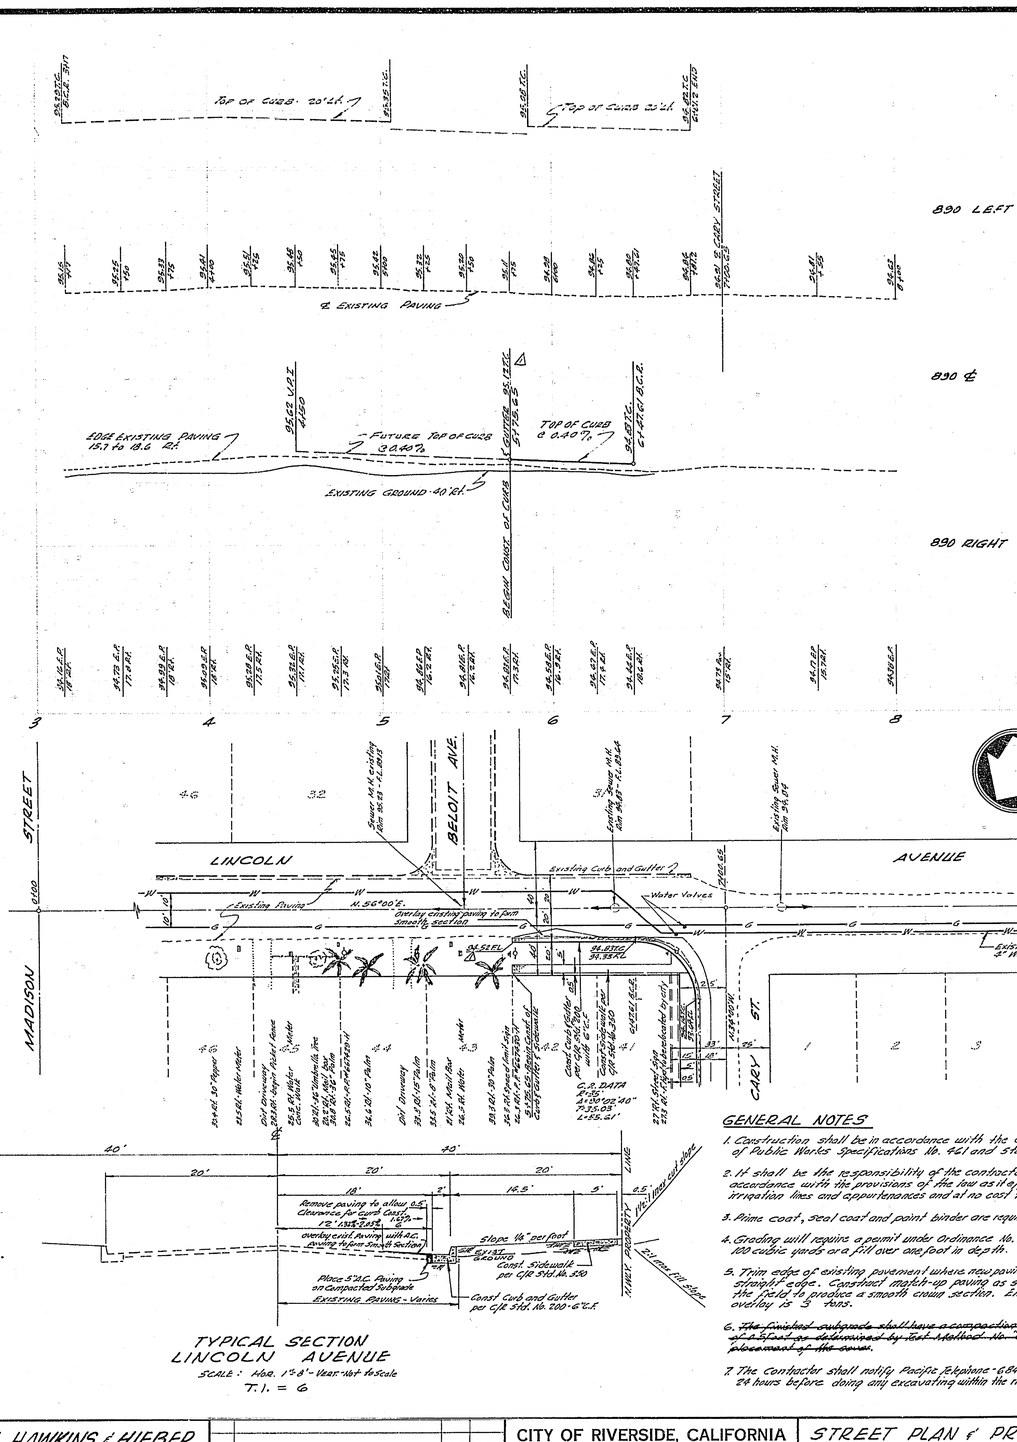

TYPICAL SECTION
CARY STREET
SCALE: Hor. 1" = 8' - Vert. Not to Scale
T.I. = 5

TYPICAL SECTION
LINCOLN AVENUE
SCALE: Hor. 1" = 8' - Vert. Not to Scale
T.I. = 6

GENERAL NOTES

1. Construction shall be in accordance with the City of Riverside, Department of Public Works Specifications No. 451 and Standard Drawings.
2. It shall be the responsibility of the contractor to clear the right of way in accordance with the provisions of the law as it affects each utility including irrigation lines and appurtenances and at no cost to the city.
3. Prime coat, seal coat and paint binder are required.
4. Grading will require a permit under Ordinance No. 3093 for cut or fill exceeding 100 cubic yards or a fill over one foot in depth.
5. Trim edge of existing pavement where new paving joins existing paving to a clean straight edge. Construct match-up paving as shown and overlay as directed in the field to produce a smooth crown section. Engineers estimate of pavement overlay is 5 tons.
6. ~~The finished subgrade shall have a compaction of not less than 90% in a depth of 6" feet as determined by Cal. Method No. Calif. 216 immediately prior to placement of the cover.~~
7. The Contractor shall notify Pacific Telephone - 684-0071 (Cable locations) at least 24 hours before doing any excavating within the rightway.

BENCH MARK - X cut in outlet of fire hydrant S.E. corner Freda and Cary Street per C/R A.B. 4/28/57
Elevation 1011.953

APPROVED FOR STREET LIGHTS

GENERAL SUPT./CHIEF ENGINEER DATE

CRAWLEY, HAWKINS & HIEBER
ENGINEERS AND SURVEYORS
RIVERSIDE, CALIFORNIA - 684-9522
APPROVED George O. Crawley DATE 4/26/68
REG. CIVIL ENGINEER No. 3458
F.B. AGUSTINE LEON JR. F.B. 89

MARK	REVISIONS	APPR.	DATE
Δ	revise T.C. elev. at Sta. 5+75.55	C.E.H.	11-25-70

DESIGNED BY C.N. DRAWN BY C.N. CHECKED BY Chr

CITY OF RIVERSIDE, CALIFORNIA
DEPARTMENT OF PUBLIC WORKS

APPROVED BY	BY	DATE
OFFICE ENGINEER	TOM	6-18
PARK DEPARTMENT		
TRAFFIC DIVISION	JCH	6/18
ASSISTANT CITY ENG.	WJBC	6-18
	JBC	6/18

APPROVED BY
DIRECTOR OF PUBLIC WORKS
DATE 6-19-68

STREET PLAN & PROFILE
LINCOLN AVE. CARY STREET to 175' North Side N.Ely.
CARY STREET LINCOLN AVE to 180' East Side N.Wly.

HORIZ. SCALE: 1" = 40' VERT. SCALE: 1" = 4'

PROJECT NO. R-1288
SHEET 1 OF 1
FILE NO. 4130