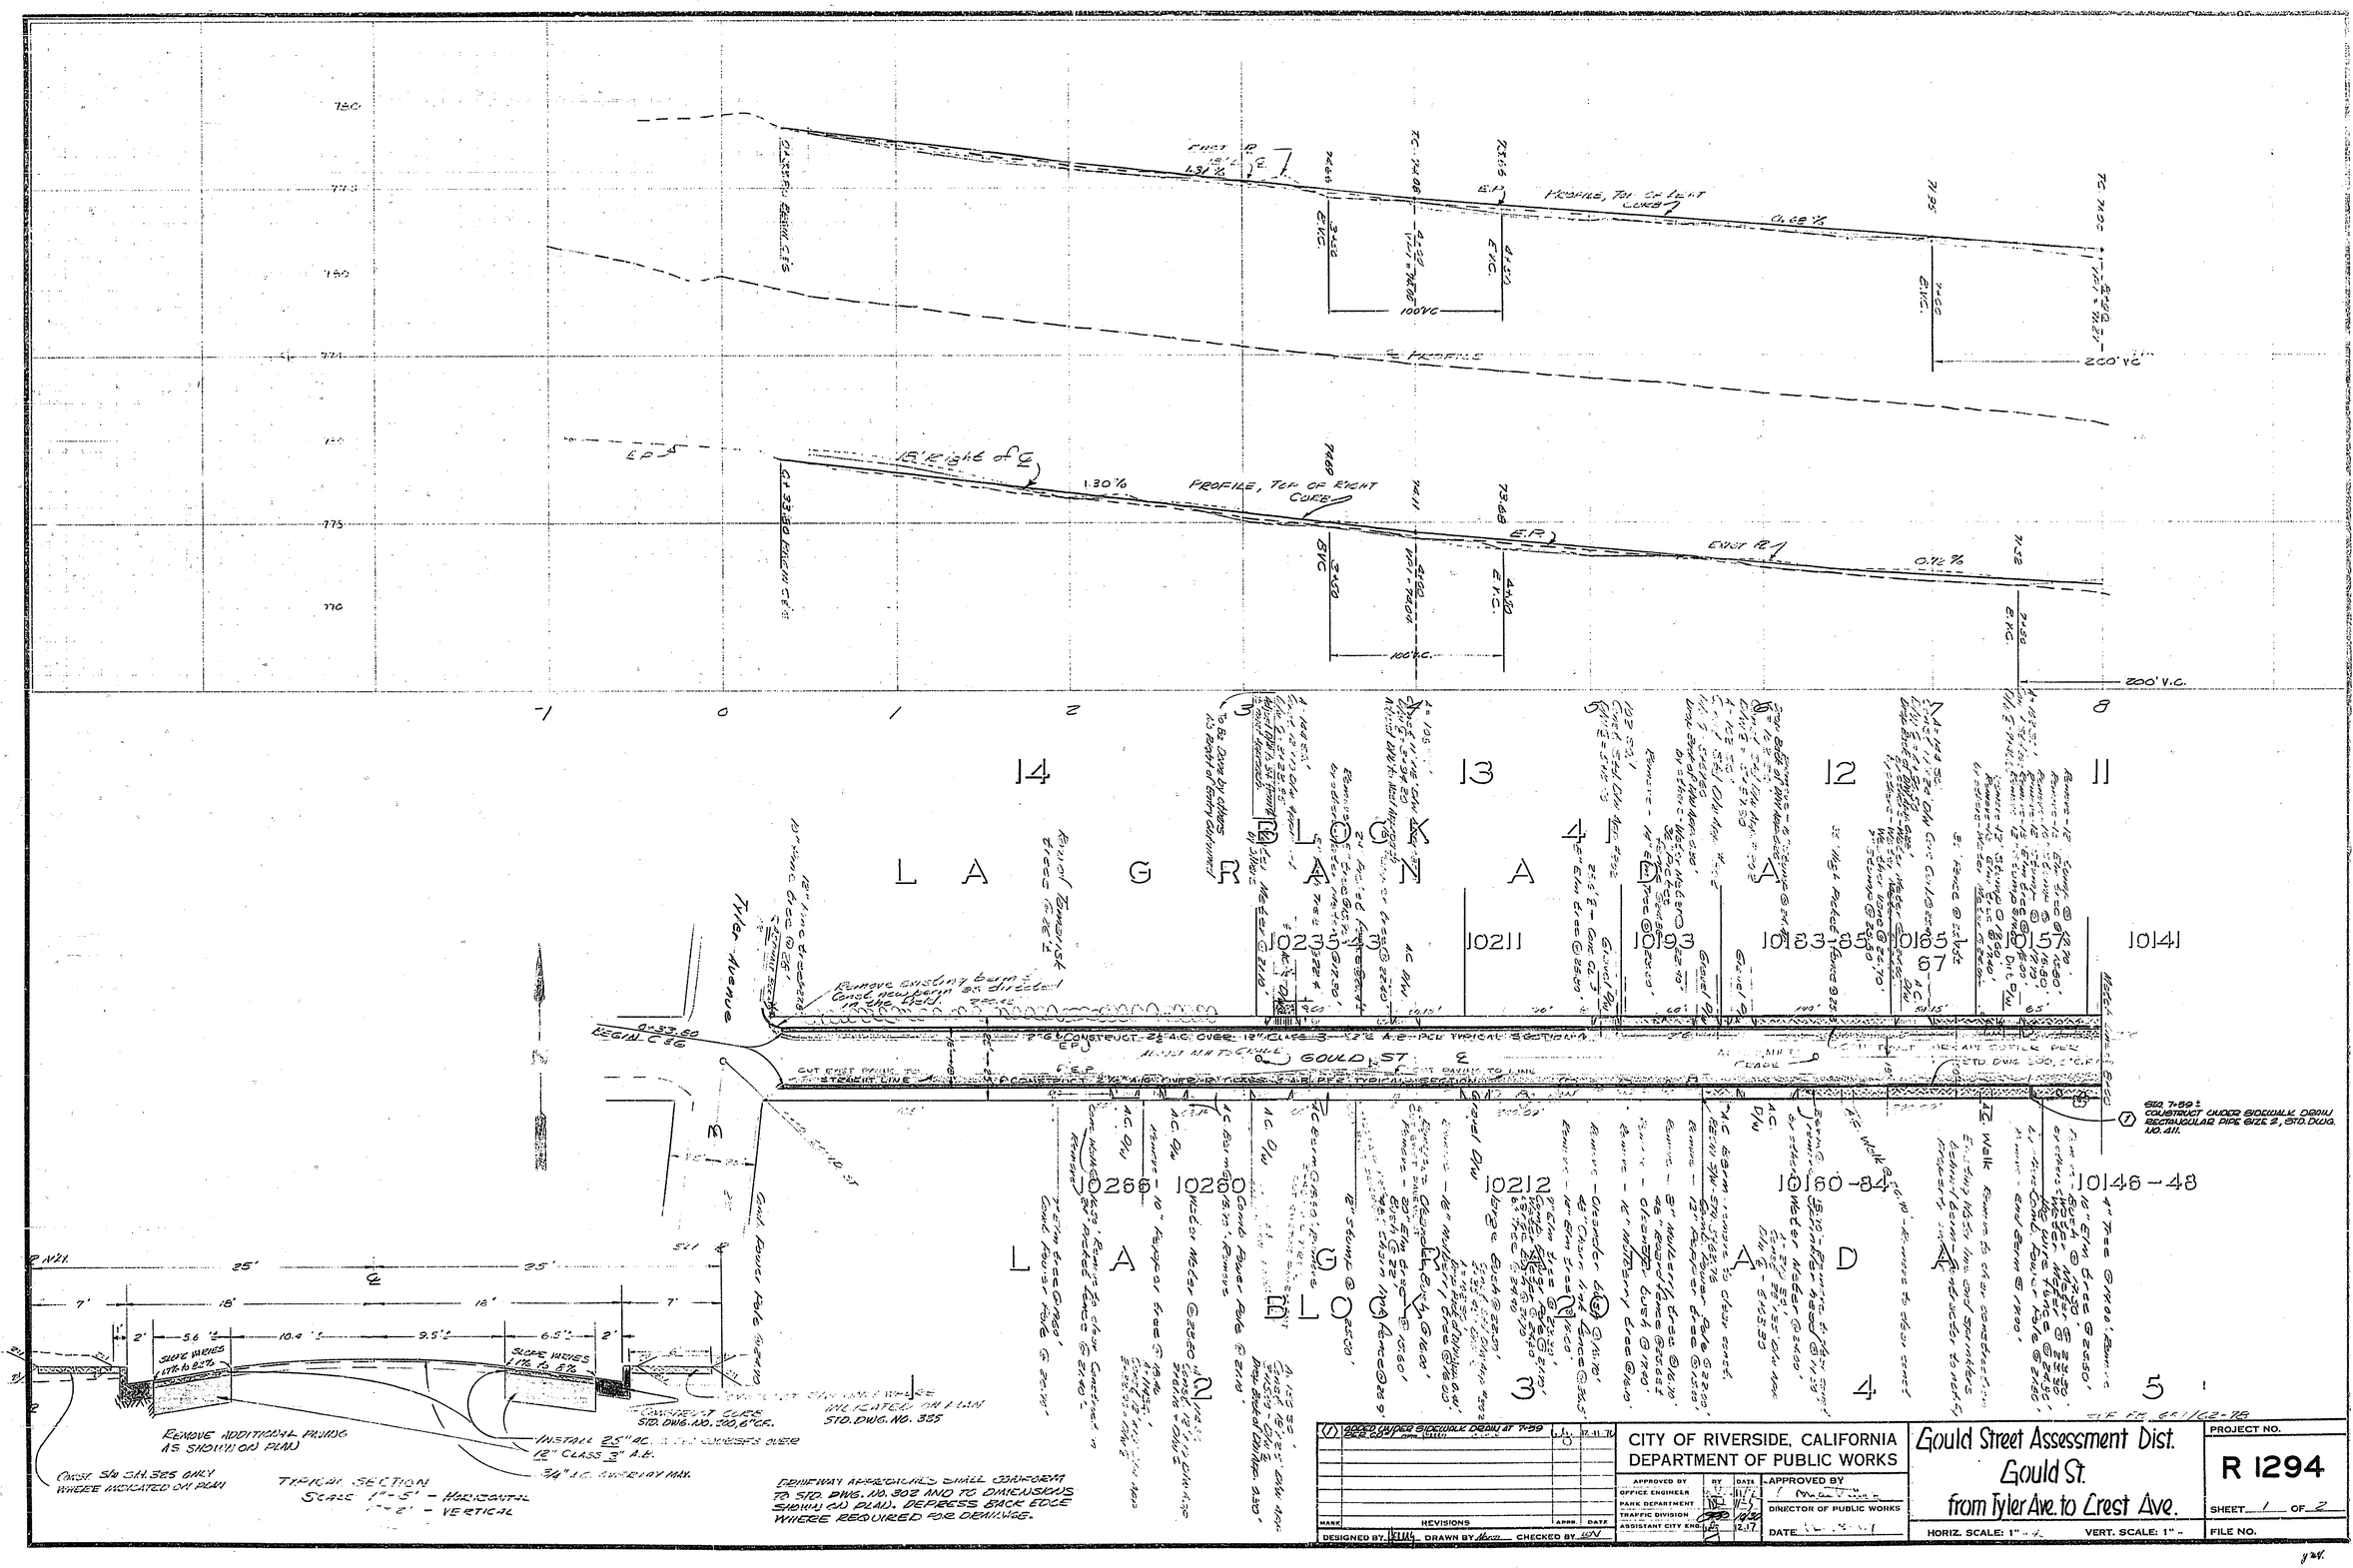

MARK	REVISIONS	APPR.	DATE
1	ADDED UNDER SIDEWALK DRAIN AT 7+59 PER CO		12-11-70

DESIGNED BY [illegible] DRAWN BY [illegible] CHECKED BY [illegible]

CITY OF RIVERSIDE, CALIFORNIA
DEPARTMENT OF PUBLIC WORKS

APPROVED BY	BY	DATE
OFFICE ENGINEER	[illegible]	[illegible]
PARK DEPARTMENT	[illegible]	[illegible]
TRAFFIC DIVISION	[illegible]	[illegible]
ASSISTANT CITY ENG.	[illegible]	12-17

APPROVED BY [illegible]
DIRECTOR OF PUBLIC WORKS
DATE [illegible]

Gould Street Assessment Dist.
Gould St.
from Tyler Ave. to Crest Ave.

HORIZ. SCALE: 1" = 4' VERT. SCALE: 1" =

PROJECT NO. R 1294
SHEET 1 OF 2
FILE NO.

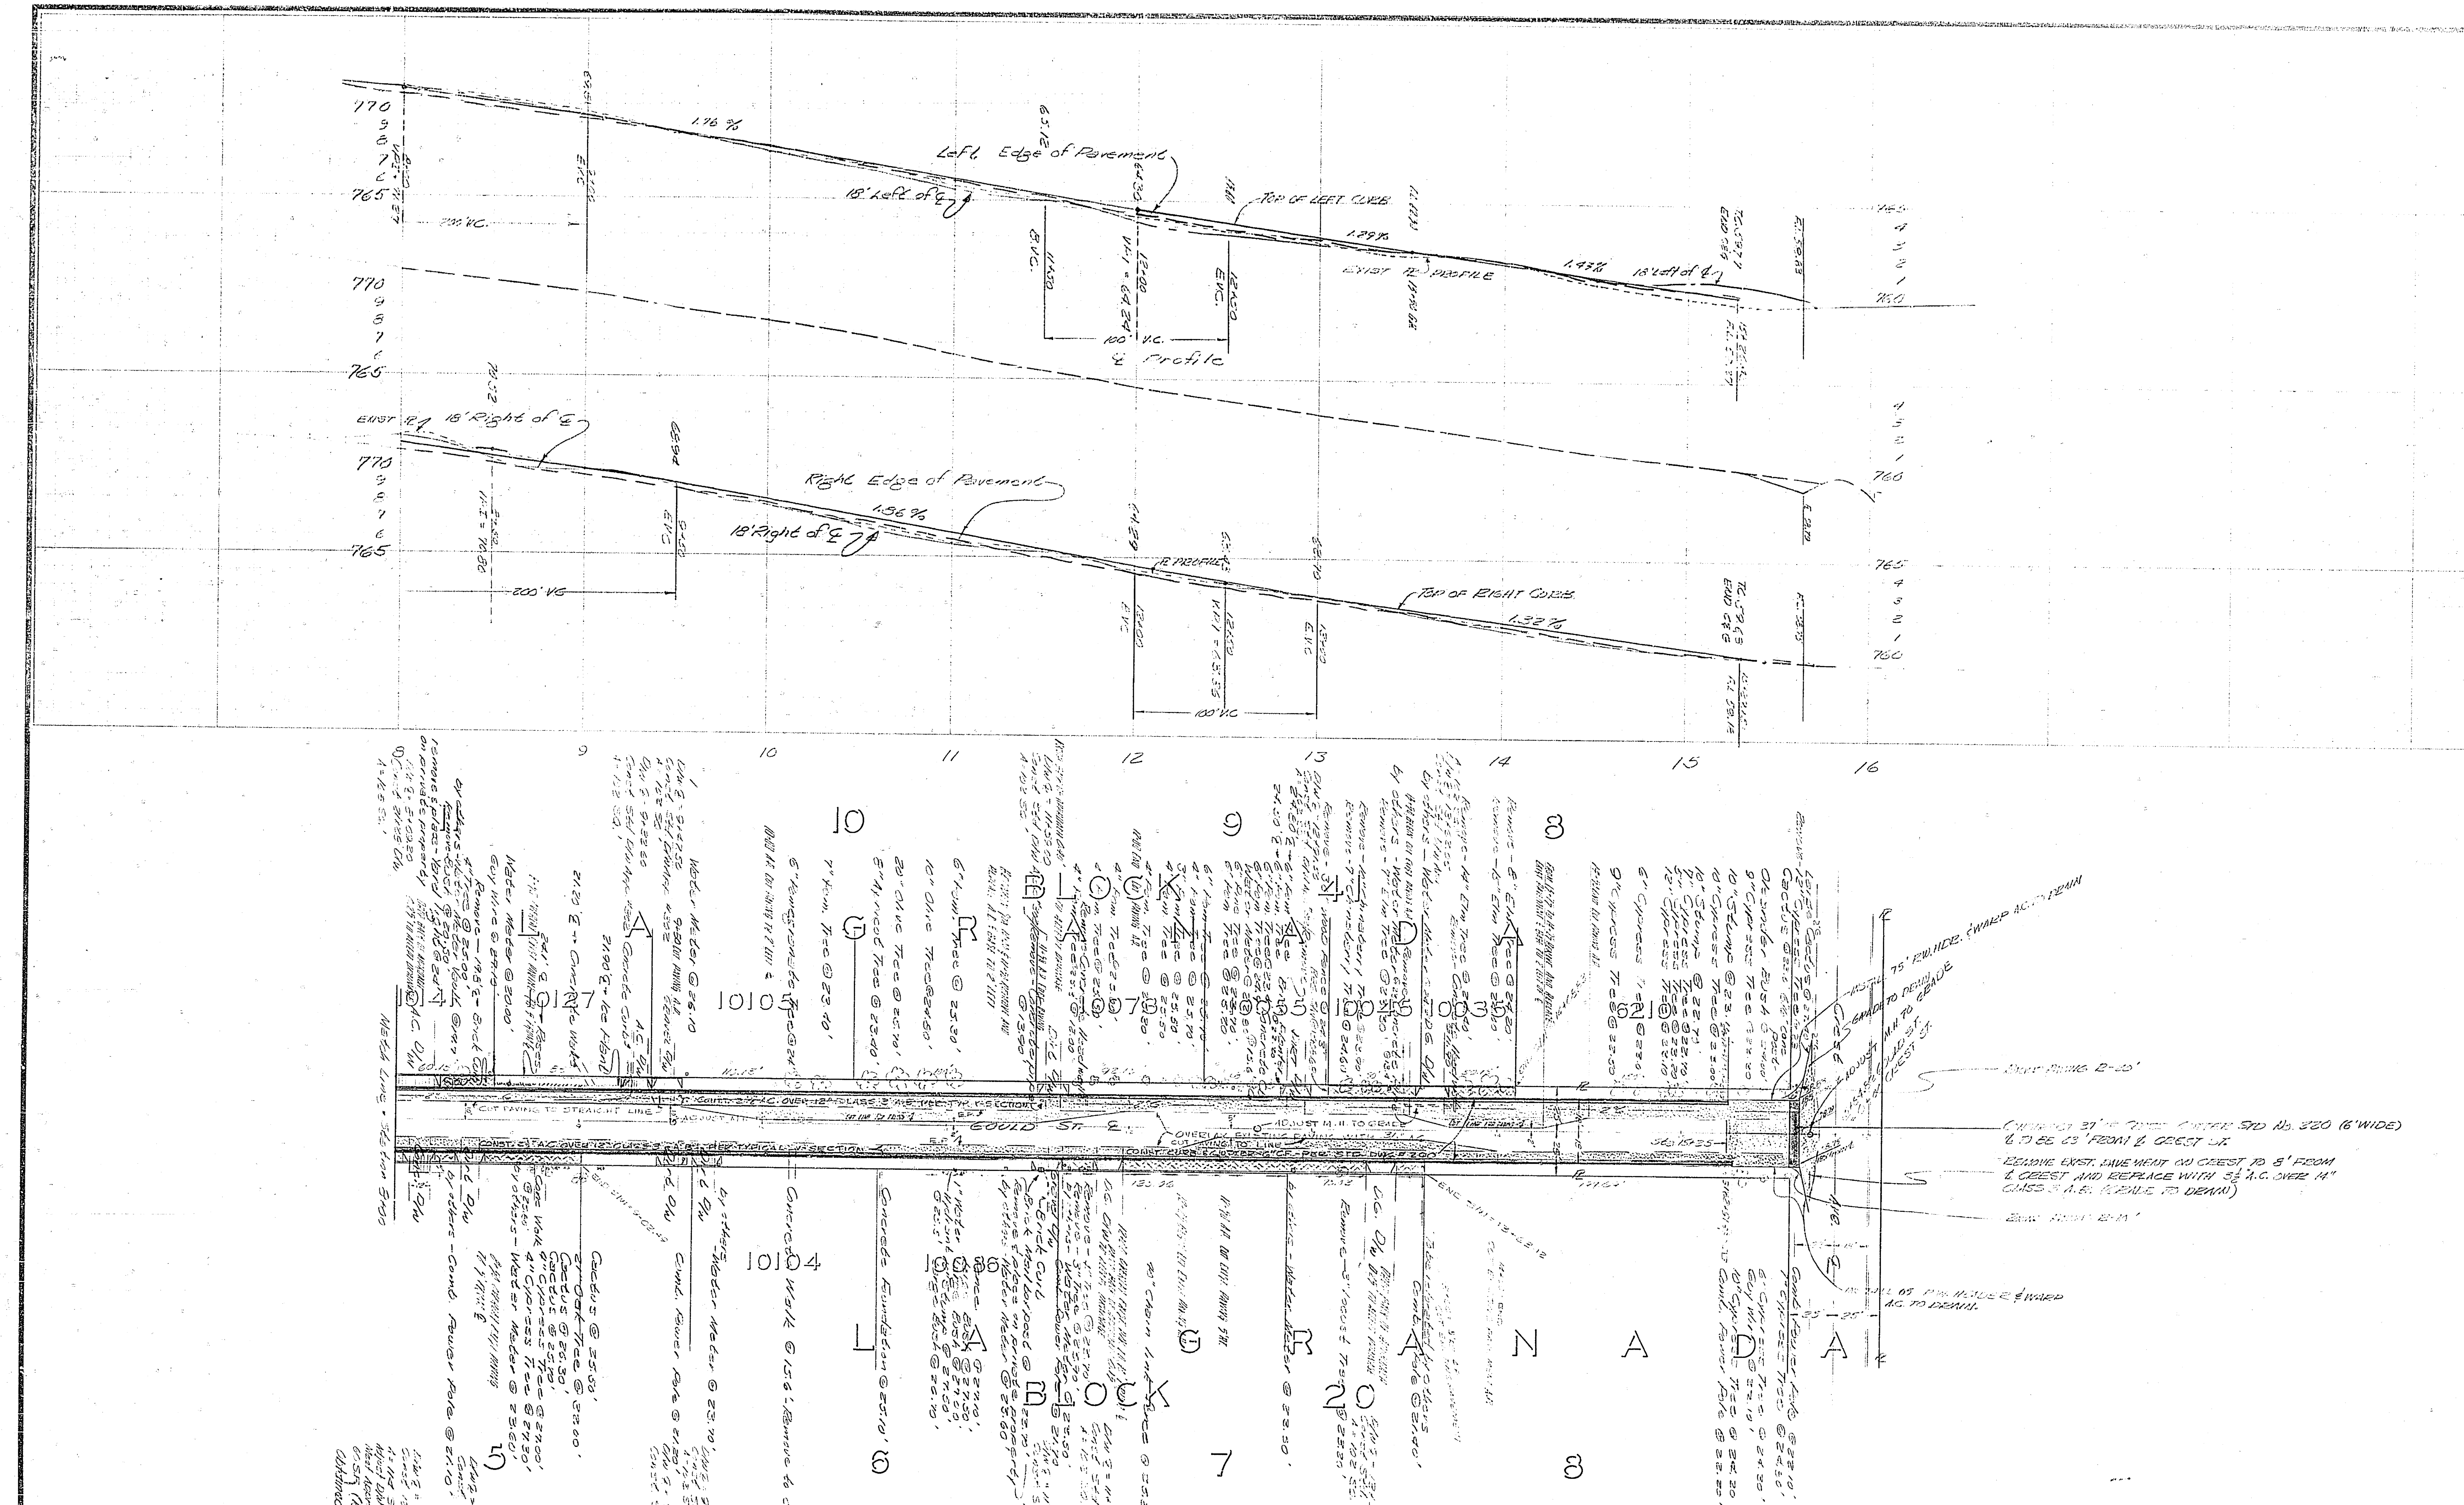

REF F.B. 687 / 42 78

CITY OF RIVERSIDE, CALIFORNIA DEPARTMENT OF PUBLIC WORKS		
APPROVED BY	BY	DATE
OFFICE ENGINEER		11/1
PARK DEPARTMENT		11-5
TRAFFIC DIVISION		10/30
ASSISTANT CITY ENG.		12-17

APPROVED BY: DIRECTOR OF PUBLIC WORKS
DATE 12-18-69

MARK | REVISIONS | APPR. | DATE

DESIGNED BY Haus DRAWN BY Norm CHECKED BY GN

Gould Street Assessment Dist.
Gould St.
from Tyler Ave. to Crest Ave.

HORIZ. SCALE: 1" = 40' VERT. SCALE: 1" = 4'

PROJECT NO. R 1294

SHEET 2 OF 2

FILE NO.