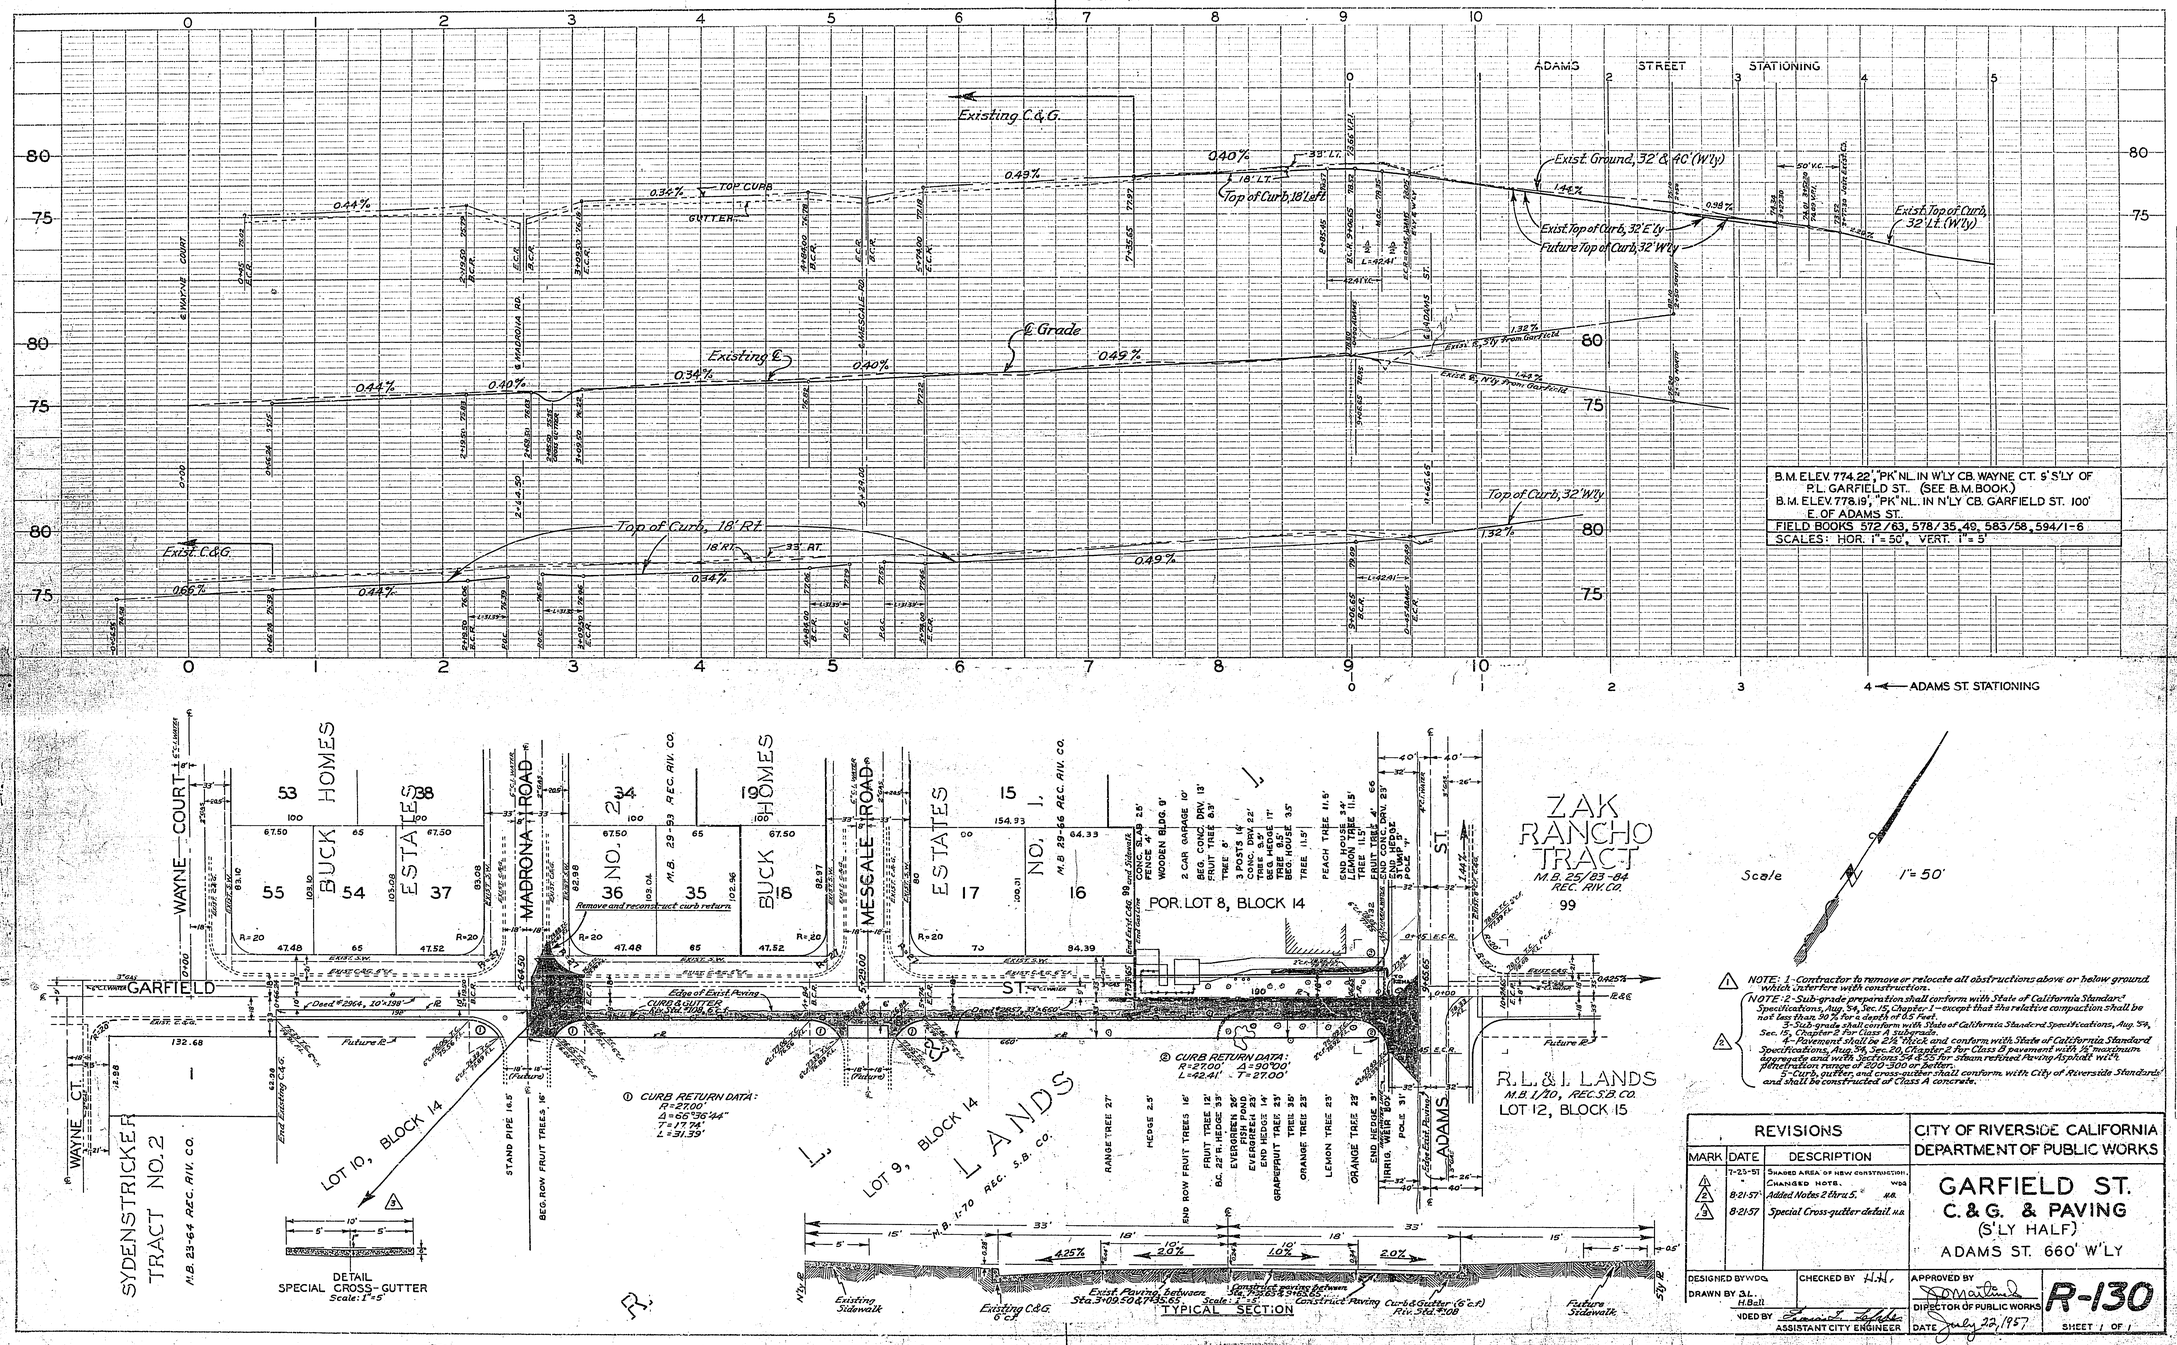

REVISIONS		
MARK	DATE	DESCRIPTION
1	7-23-57	Shaded Area of New Construction. Changed Note. WDB
2	8-21-57	Added Notes 2 thru 5. H.B.
3	8-21-57	Special Cross-gutter detail. H.B.

CITY OF RIVERSIDE CALIFORNIA
DEPARTMENT OF PUBLIC WORKS

GARFIELD ST.
C. & G. & PAVING
(S'LY HALF)
ADAMS ST. 660' W'LY

DESIGNED BY WDB
DRAWN BY S.L.
H.B.(1)
CHECKED BY H.H.
APPROVED BY
DIRECTOR OF PUBLIC WORKS
APPROVED BY
ASSISTANT CITY ENGINEER
DATE July 22, 1957

R-130

SHEET 1 OF 1

PROFILE
PLAN