WESTBOUND OFFRAMP PROFILE
T.C. PROFILE GRADE
EXISTING ℄ LEFT
1.70%
E.P. PROFILE GRADE
200' ADJUSTED V.C.
(PORTIONS OF V.C. ADJUSTED TO FIT EXIST. CONDITIONS)
WESTBOUND OFFRAMP
SYMBOLS
BEGINNING OF CONSTRUCTION (P.C.C.)
SAWCUT, JOIN EXIST C&G
CURB TRANS (8"TO 6") B.L.F. - STD. 210
OVERLAY EXISTING PAVEMENT PER TYPICAL SECTION
STA. 0+97± TO 4+08
PLACE 2½" A.C. OVER 6" A.B. CLASS 2
END C&G STD. 201, BEGIN A.C. BERM STD. 250
STA. 2+88 A.P.-E.P.
END OF CONSTRUCTION - MEET EXIST. BERM
STA. 4+08
Chain Link Fence
F'WY R.O.W. LINE
TOP OF SLOPE
A.C. Berm (Remove)
Exist. A.C. Berm (Remove)
Exist. Curb and Gutter - Type A-2
Random Line
ADAMS STREET
WESTBOUND OFFRAMP
BEGIN C&G STD. 201 TYPE B-2
STA. 0+72.5±
EXIST. E.C. R=2000
STA. 2+88
CONTRACT TE-70-3
F.B. 849, 45-49
CITY OF RIVERSIDE, CALIFORNIA
DEPARTMENT OF PUBLIC WORKS
ADAMS ST. OFFRAMPS
AT THE RIVERSIDE F'WY
WIDENING OF OFFRAMPS
PROJECT NO.
R-1305
SHEET 1 OF 2
FILE NO.
HORIZ. SCALE: 1" = 20'
VERT. SCALE: 1" = 2
DATE 1/23/70
DIRECTOR OF PUBLIC WORKS
REVISIONS
DESIGNED BY
DRAWN BY
CHECKED BY

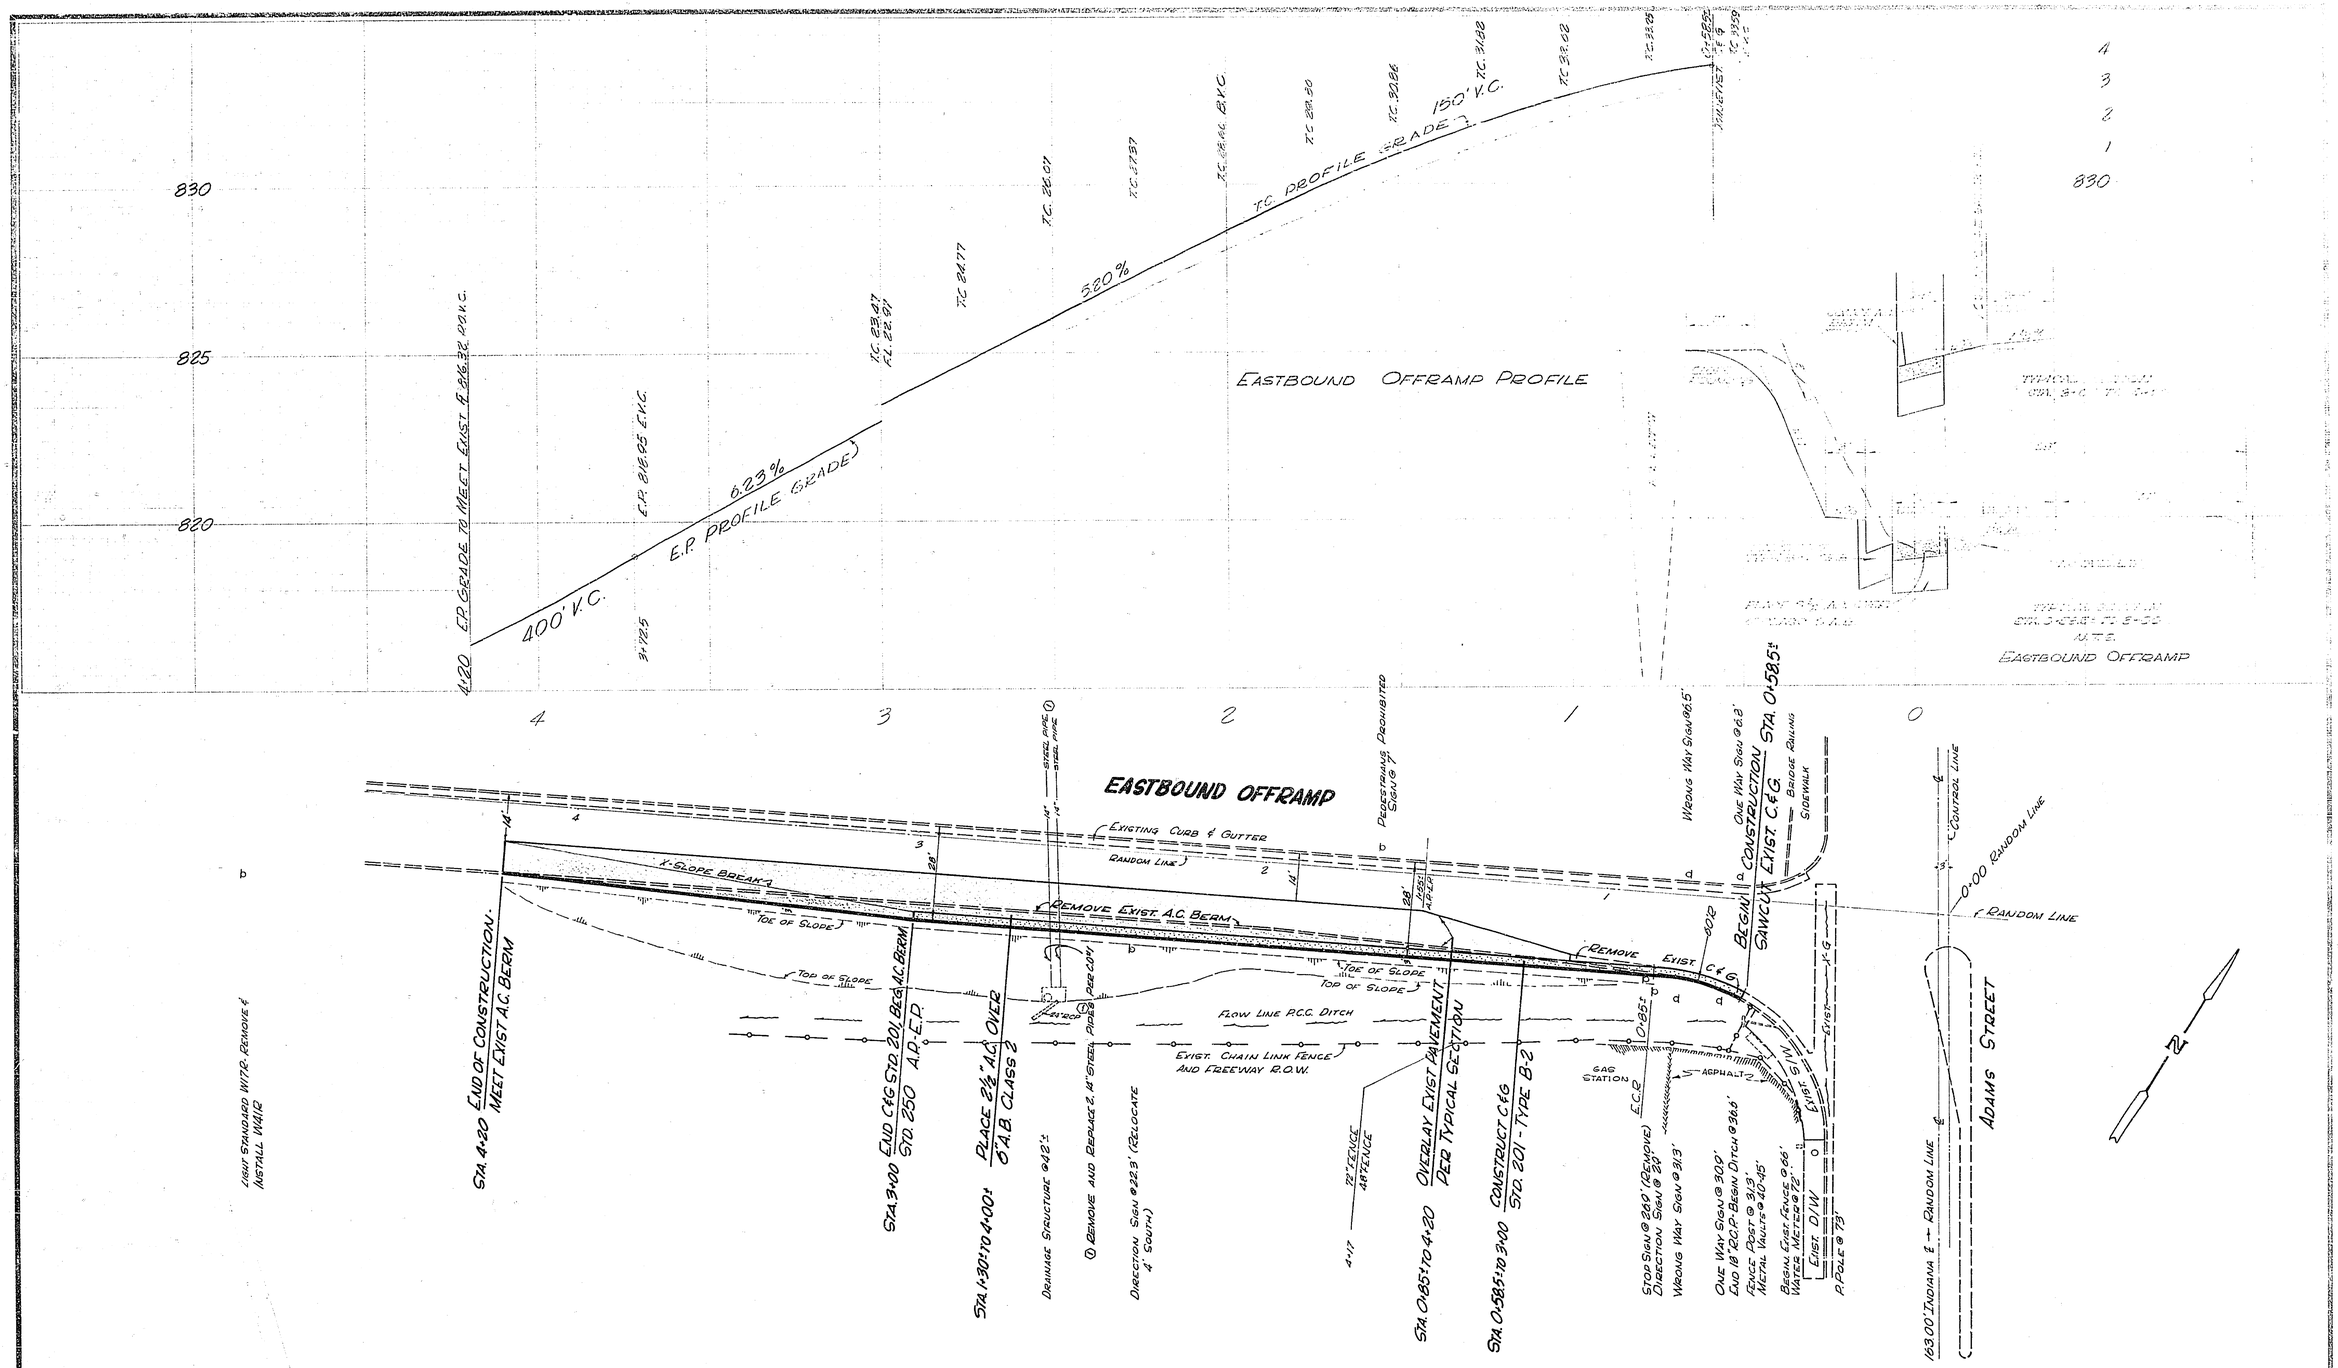

CONTRACT TE-70-3

F.B. 849, 45-49

MARK	REVISIONS	APPR.	DATE
①	ADJUSTED TOP OF SLOPE LINE. ADDED 14" STEEL PIPES, 24" RCP, AND 14" STEEL PIPE REMOVAL NOTE.		

DESIGNED BY LN DRAWN BY Alexander CHECKED BY

CITY OF RIVERSIDE, CALIFORNIA
DEPARTMENT OF PUBLIC WORKS

APPROVED BY	BY	DATE
CITY ENGINEER		
PARK DEPARTMENT		
TRAFFIC DIVISION		
ASSISTANT CITY ENG.		

APPROVED BY William D. Goodman
DIRECTOR OF PUBLIC WORKS
DATE 12-3-70

ADAMS ST. OFFRAMPS AT THE RIVERSIDE F'WY

WIDENING OF OFFRAMPS

HORIZ. SCALE: 1" = 20' VERT. SCALE: 1" = 2'

PROJECT NO. R-1305

SHEET 2 OF 2

FILE NO.