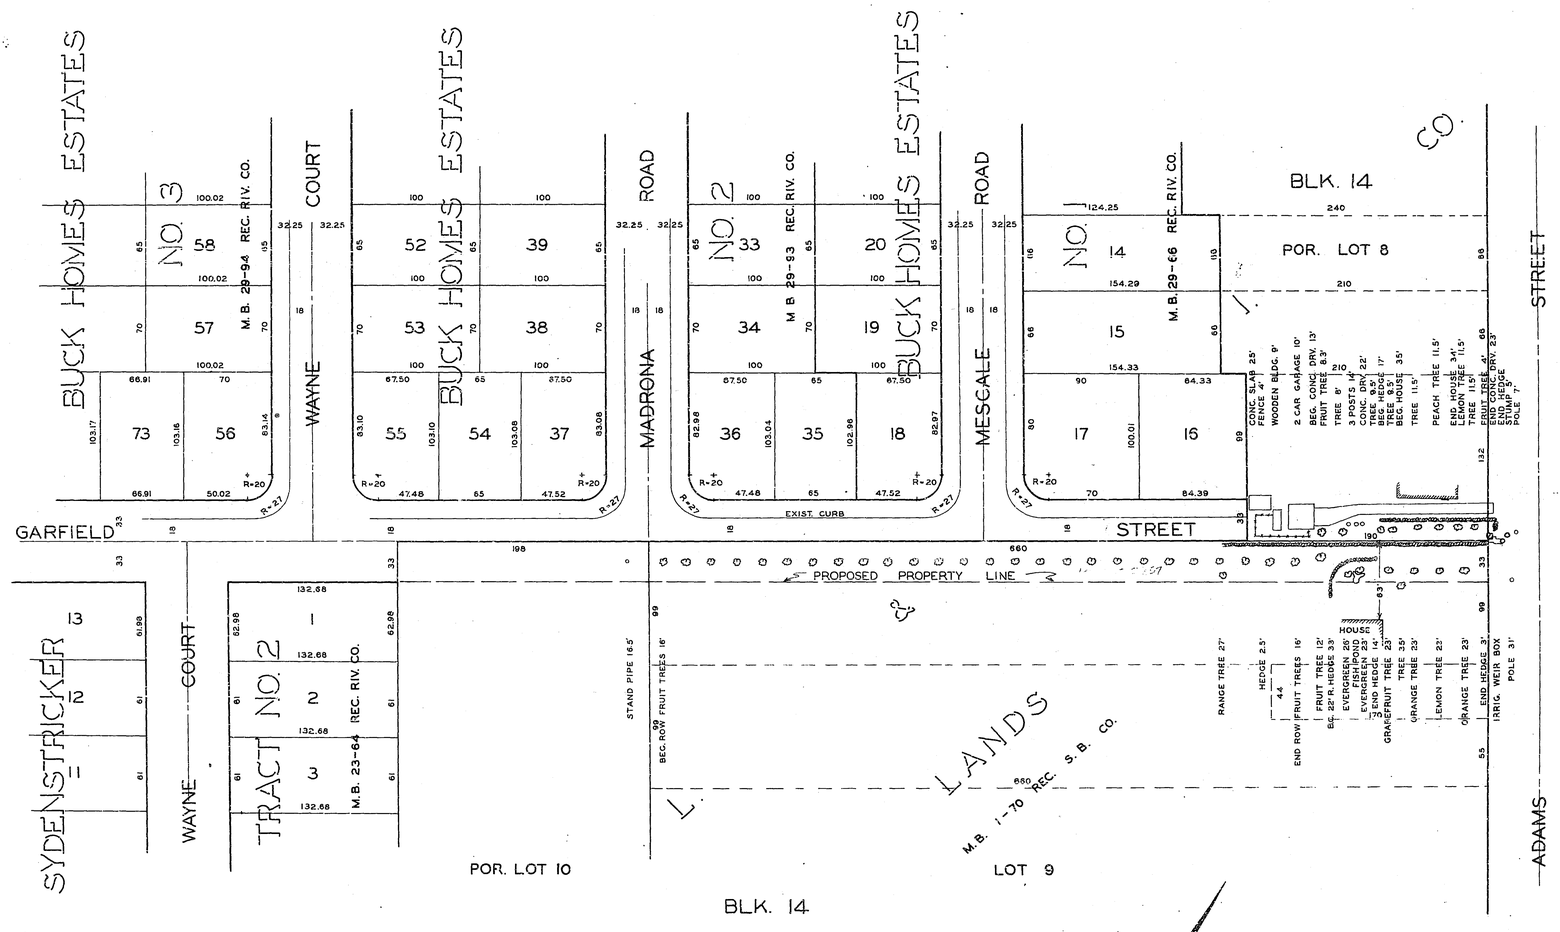

SCALE: 1" = 50'

F.B. 584-1

REVISIONS		
MARK	DATE	DESCRIPTION

CITY OF RIVERSIDE CALIFORNIA
DEPARTMENT OF PUBLIC WORKS

PLAN SHOWING THE PROPOSED OPENING OF GARFIELD STREET BETWEEN WAYNE CT. & ADAMS ST.

DESIGNED BY
DRAWN BY
CHECKED BY
RECOMMENDED BY
ASSISTANT CITY ENGINEER
APPROVED BY
DIRECTOR OF PUBLIC WORKS
DATE

R-130-A

SHEET 1 OF 1

[redacted]