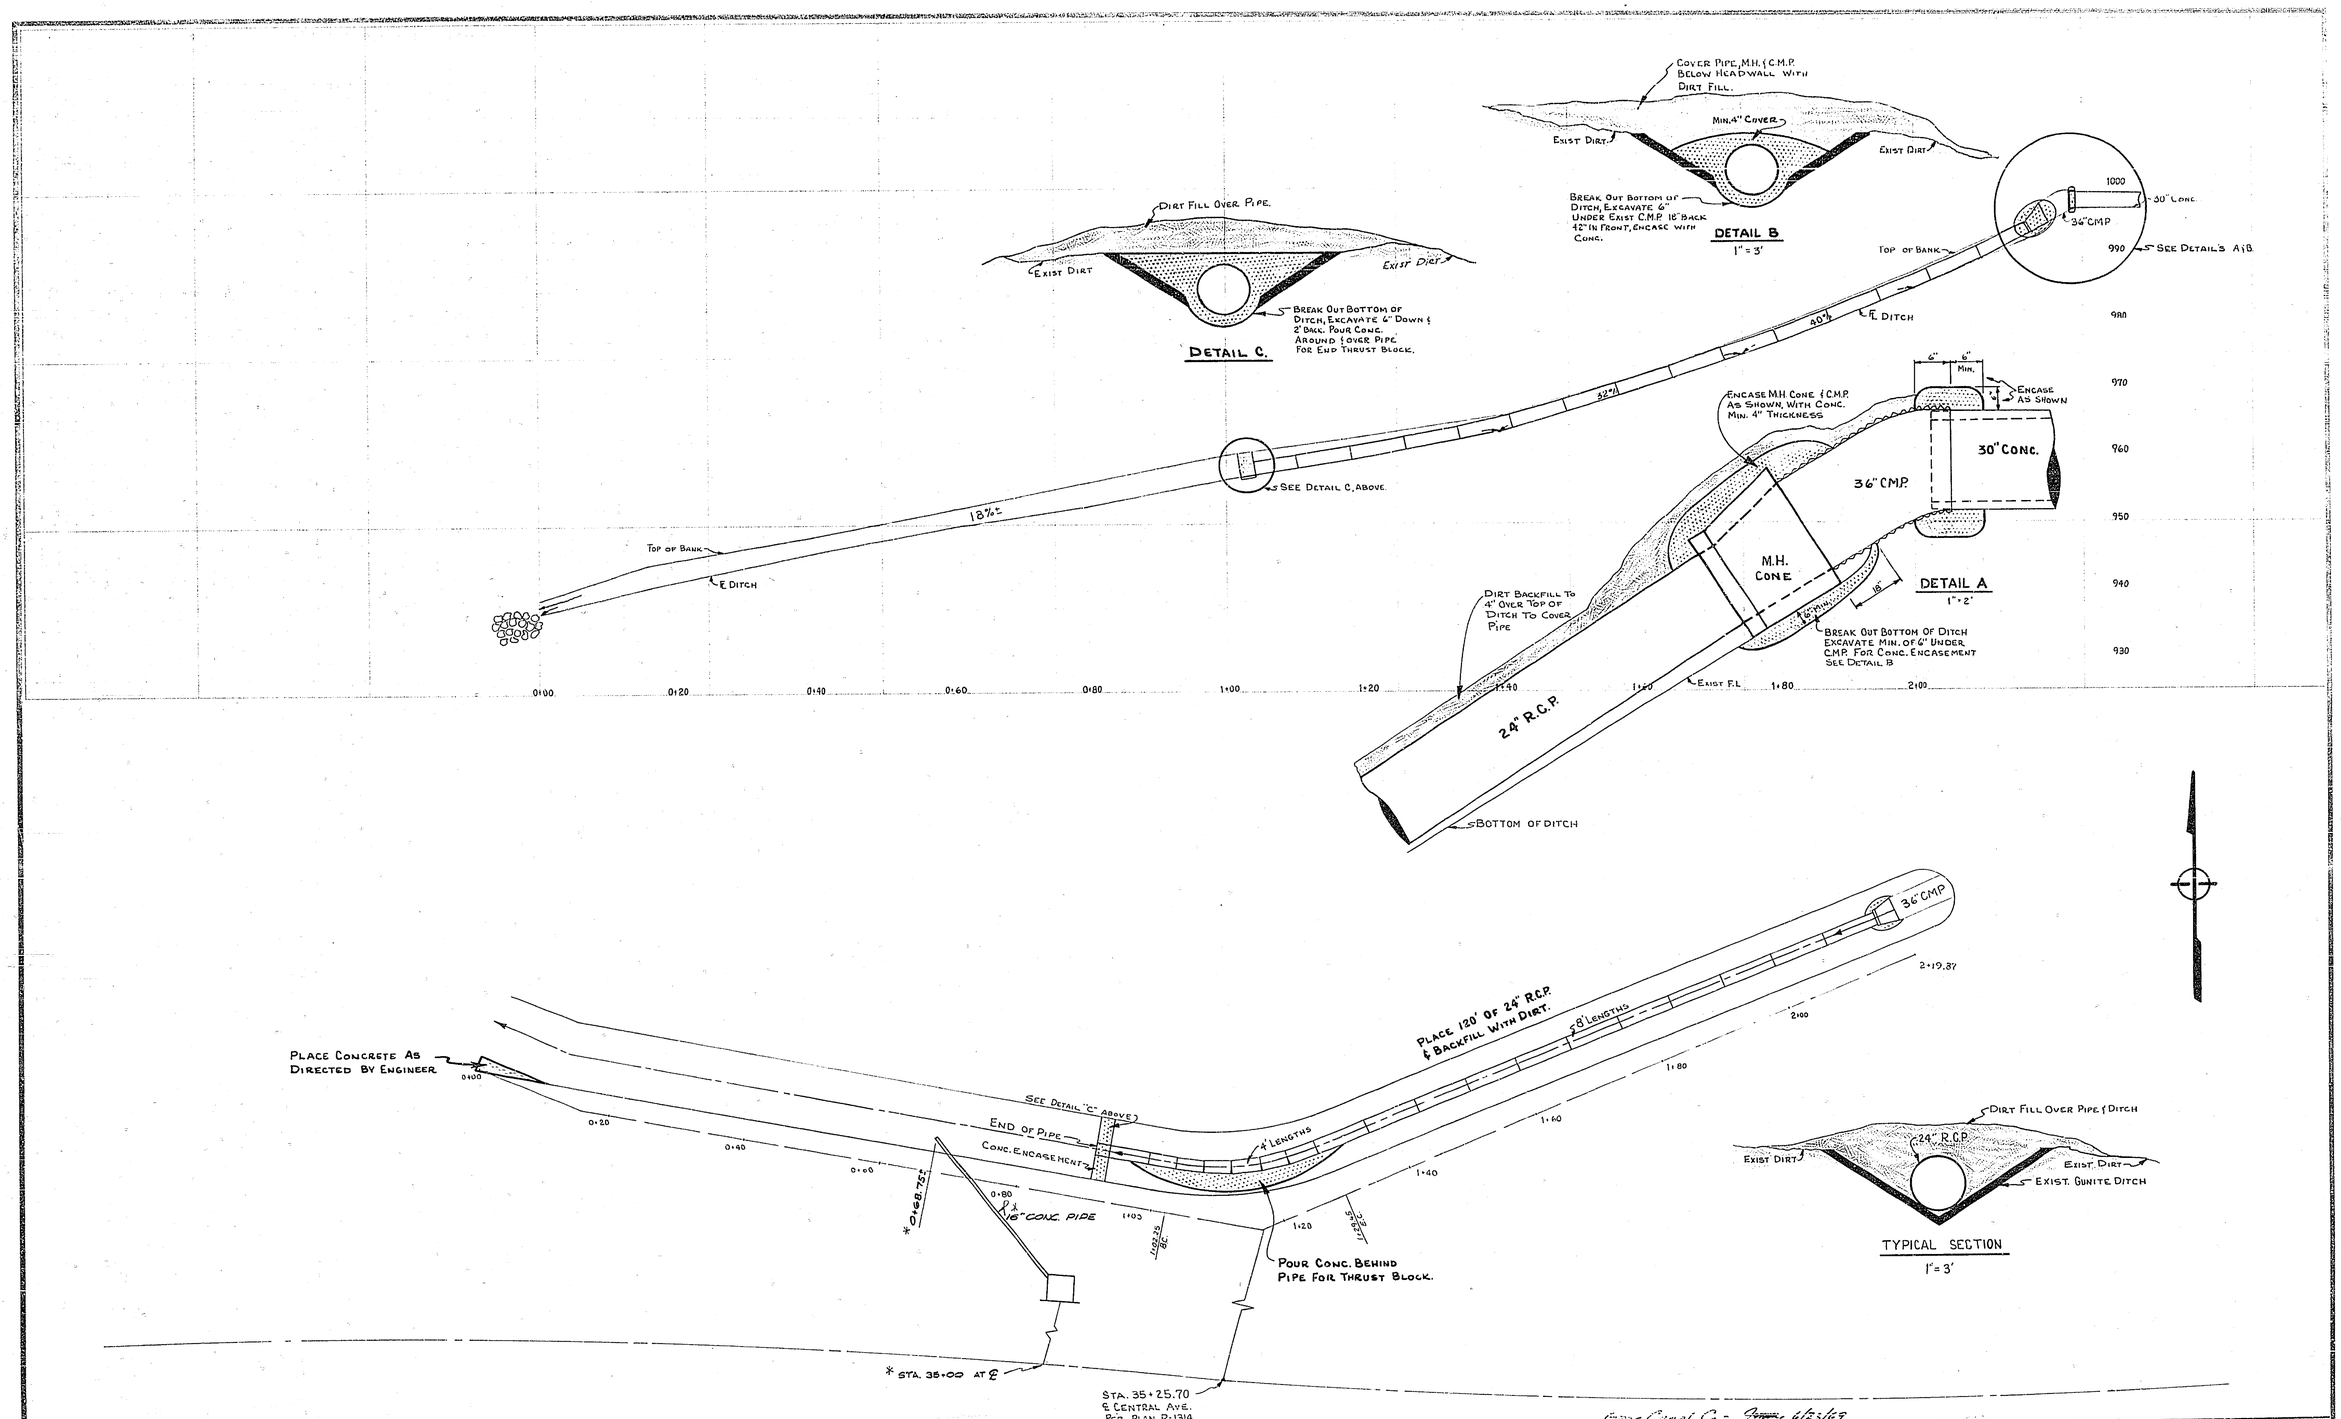

Gage Canal Co. - 6/23/69

CITY OF RIVERSIDE, CALIFORNIA DEPARTMENT OF PUBLIC WORKS	CHICAGO & CENTRAL AVE GUNITE DITCH IMPROVEMENTS BELOW GAGE CANAL HEADWORKS	PROJECT NO. 303 R-1314-A SHEET 1 OF 1	
APPROVED BY / OFFICE ENGINEER / PARK DEPARTMENT / TRAFFIC DIVISION / ASSISTANT CITY ENG. — BY — DATE	APPROVED BY DIRECTOR OF PUBLIC WORKS DATE 5-19-69	HORIZ. SCALE: 1" = 10' VERT. SCALE: 1" = 10'	FILE NO.

MARK — REVISIONS — APPR — DATE

DESIGNED BY — DRAWN BY RCK — CHECKED BY DCH

* AS BUILT 6/16/70 KABL