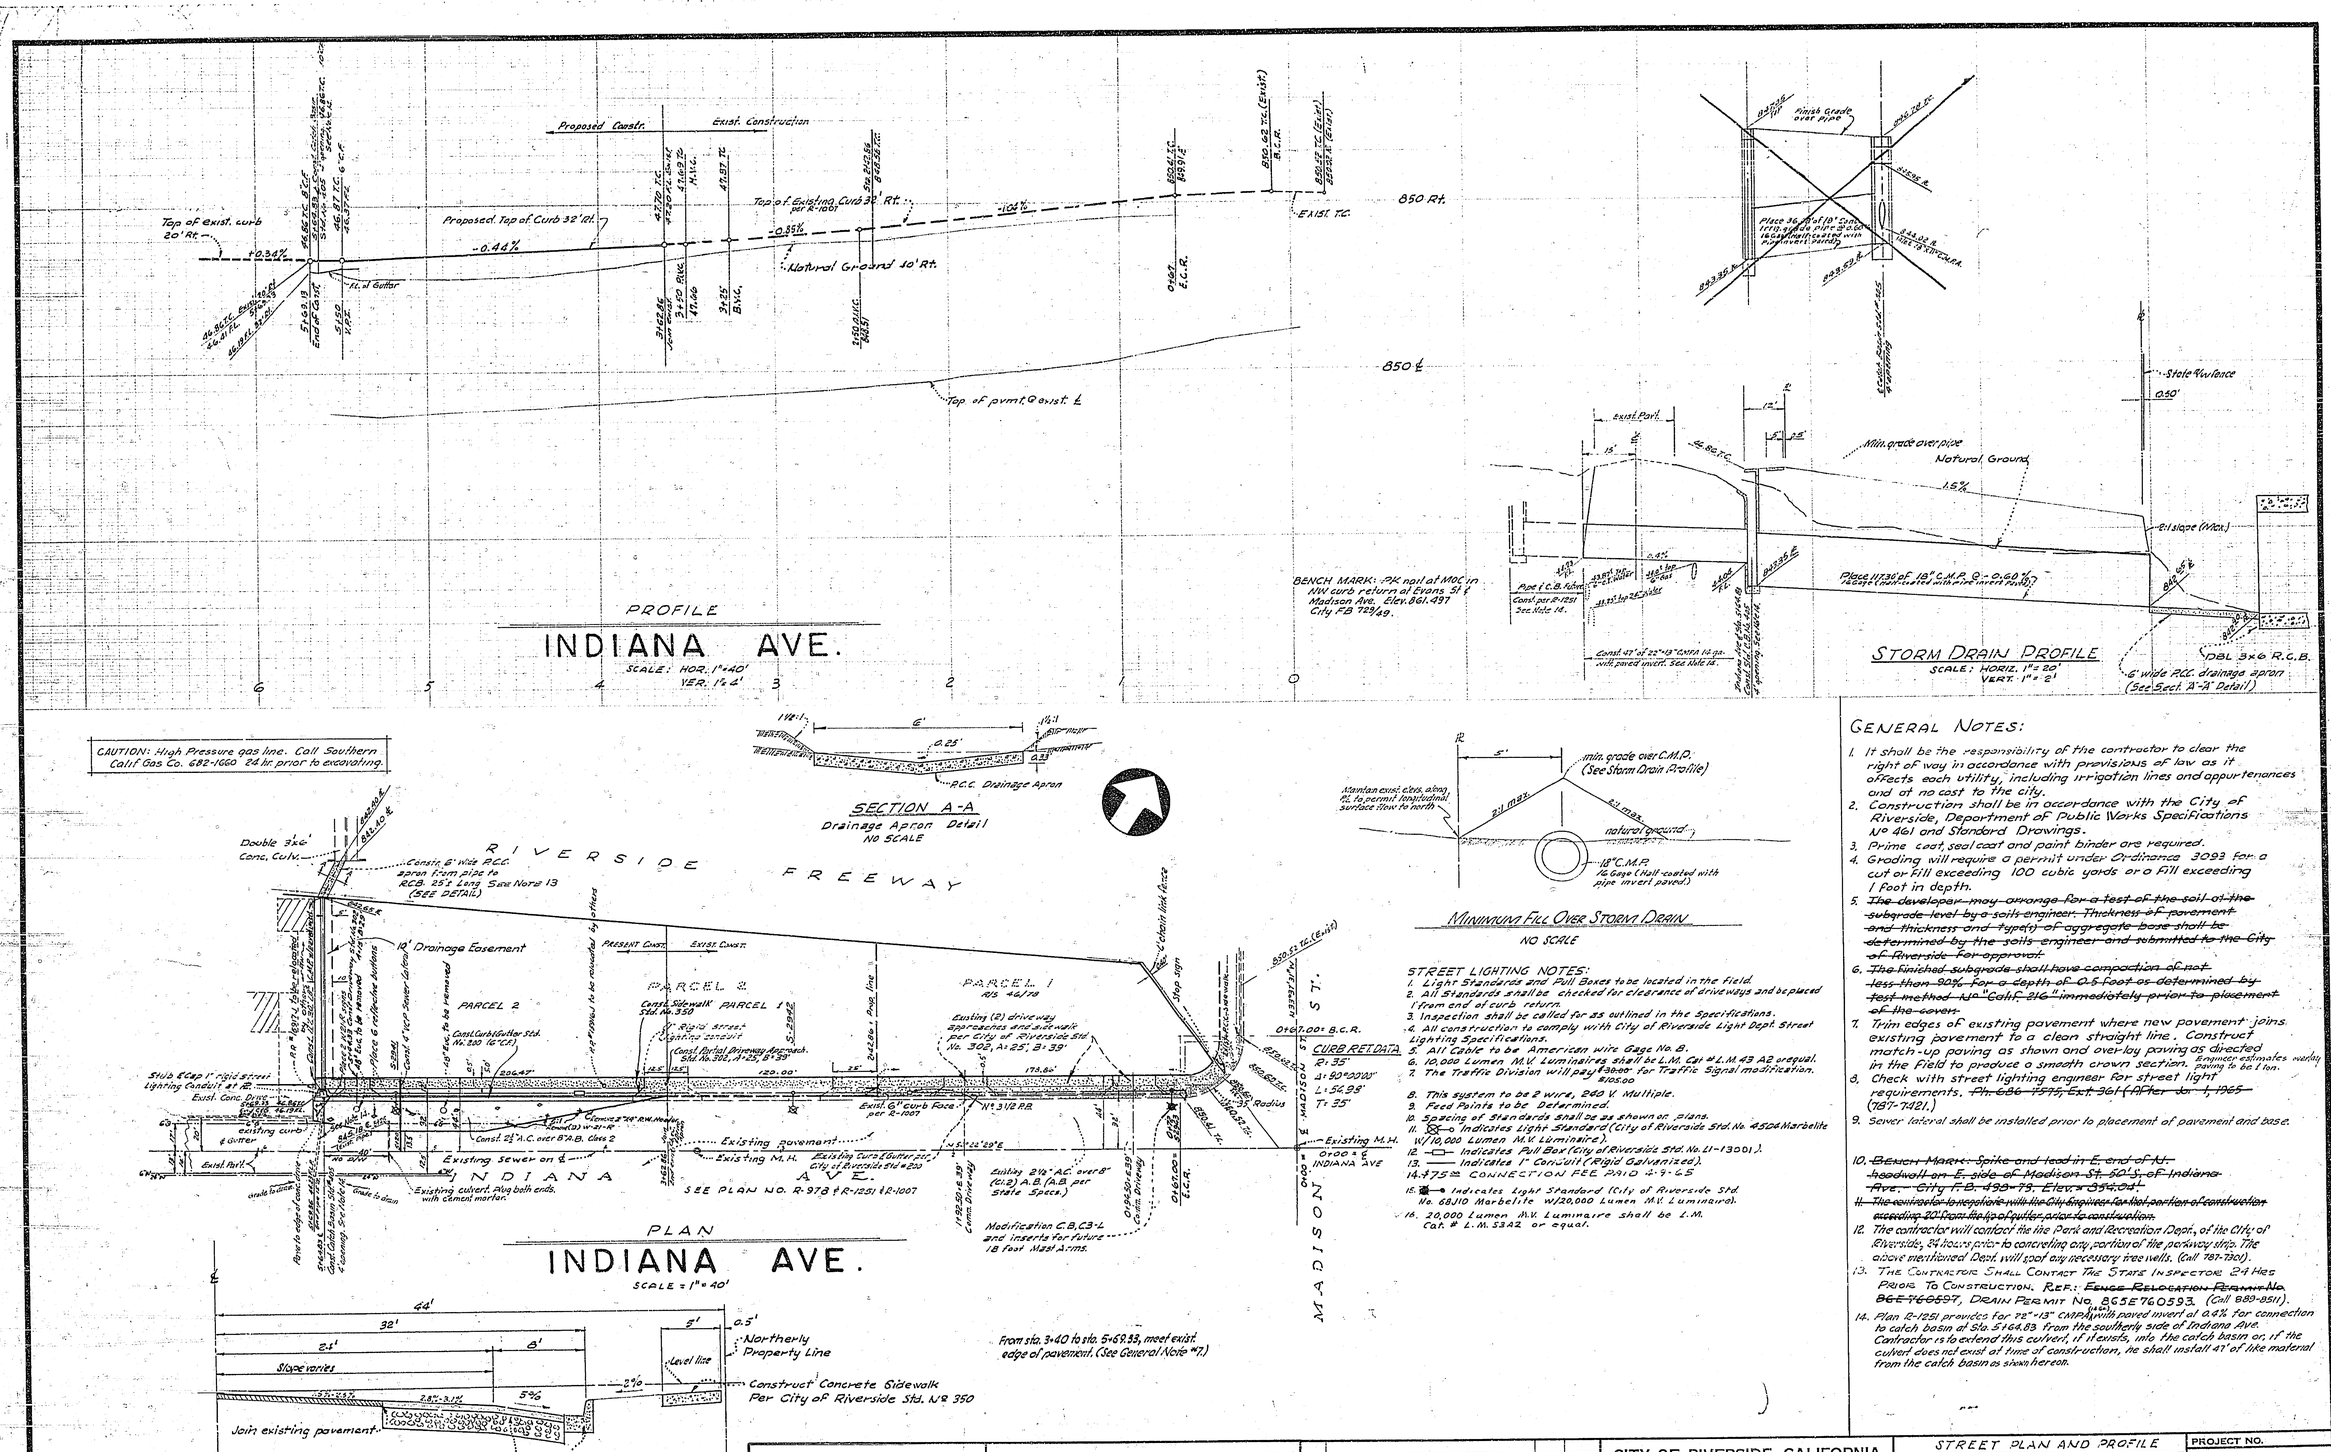

GENERAL NOTES:

1. It shall be the responsibility of the contractor to clear the right of way in accordance with provisions of law as it affects each utility, including irrigation lines and appurtenances and at no cost to the city.
2. Construction shall be in accordance with the City of Riverside, Department of Public Works Specifications Nº 461 and Standard Drawings.
3. Prime coat, seal coat and paint binder are required.
4. Grading will require a permit under Ordinance 3093 for a cut or fill exceeding 100 cubic yards or a fill exceeding 1 foot in depth.
5. ~~The developer may arrange for a test of the soil of the subgrade level by a soils engineer. Thickness of pavement and thickness and type(s) of aggregate base shall be determined by the soils engineer and submitted to the City of Riverside for approval.~~
6. ~~The finished subgrade shall have compaction of not less than 90% for a depth of 0.5 foot as determined by test method No "Calif. 216" immediately prior to placement of the cover.~~
7. Trim edges of existing pavement where new pavement joins existing pavement to a clean straight line. Construct match-up paving as shown and overlay paving as directed in the field to produce a smooth crown section. Engineer estimates working paving & det. lon.
8. Check with street lighting engineer for street light requirements. ~~Ph. 686-1575, Ext. 361 (After Jan. 1, 1965~~ (787-7421.)
9. Sewer lateral shall be installed prior to placement of pavement and base.
10. ~~Bench Mark: Spike and lead in E. end of U-headwall on E. side of Madison St. 50' S. of Indiana Ave. City F.B. 499-19. Elev. = 854.04'.~~
11. ~~The contractor to negotiate with the City Engineer for that portion of construction exceeding 20' from the lip of gutter prior to construction.~~
12. The contractor will contact the the Park and Recreation Dept., of the City of Riverside, 24 hours prior to concreting any portion of the parkway strip. The above mentioned Dept. will spot any necessary tree wells. (Call 787-7301).
13. The Contractor Shall Contact The Staff Inspector 24 Hrs Prior To Construction. Ref.: ~~Fence Relocation Permit No. BGE760597~~, Drain Permit No. BGSE760593. (Call 889-8511).
14. Plan R-1251 provides for 72"-13" CMP with paved invert at 0.6% for connection to catch basin at Sta. 5+64.83 from the southerly side of Indiana Ave. Contractor is to extend this culvert, if it exists, into the catch basin or, if the culvert does not exist at time of construction, he shall install 47' of like material from the catch basin as shown hereon.

STREET LIGHTING NOTES:

1. Light Standards and Pull Boxes to be located in the field.
2. All Standards shall be checked for clearance of driveways and be placed 1' from end of curb return.
3. Inspection shall be called for as outlined in the Specifications.
4. All construction to comply with City of Riverside Light Dept. Street Lighting Specifications.
5. All Cable to be American wire Gage No. 8.
6. 10,000 Lumen M.V. Luminaires shall be L.M. Cat # L.M. 43 A2 or equal.
7. The Traffic Division will pay $100.00 for Traffic Signal modification.
8. This system to be 2 wire, 240 V. Multiple.
9. Feed Points to be Determined.
10. Spacing of Standards shall be as shown on plans.
11. ⊗ Indicates Light Standard (City of Riverside Std. No. 4504 Marbelite W/10,000 Lumen M.V. Luminaire).
12. —□— Indicates Pull Box (City of Riverside Std. No. LI-13001).
13. —— Indicates 1" Conduit (Rigid Galvanized).
14. .75 = CONNECTION FEE PAID 4-9-65
15. ● Indicates Light Standard (City of Riverside Std. No. 6811D Marbelite W/20,000 Lumen M.V. Luminaire).
16. 20,000 Lumen M.V. Luminaire shall be L.M. Cat. # L.M. 53A2 or equal.

APPROVED FOR STREET LIGHTS — DATE 11-12-68 — CHIEF ENGINEER

CRAWLEY, HAWKINS & ASSOCIATES
ENGINEERS AND SURVEYORS
RIVERSIDE
APPROVED George O. Crawley DATE 10/10/68
REG. CIVIL ENGINEER No. 9435
FOR: COOPERS YARDAGE. FB 94/19

MARK	REVISIONS	APPR.	DATE

DESIGNED BY ___ DRAWN BY ___ CHECKED BY ___

CITY OF RIVERSIDE, CALIFORNIA
DEPARTMENT OF PUBLIC WORKS

APPROVED BY	BY	DATE
OFFICE ENGINEER		11/20
PARK DEPARTMENT		
TRAFFIC DIVISION		11-22
ASSISTANT CITY ENG.		11-22

APPROVED BY — DIRECTOR OF PUBLIC WORKS
DATE 11-25-68

STREET PLAN AND PROFILE
INDIANA AVENUE (NORTH SIDE)
FROM MADISON ST. TO 569.33' WESTERLY
ZONING CASE NO. R-50-634
RECORD OF SURVEY 795 & 975
HORIZ. SCALE: 1" = 40' VERT. SCALE: 1" = 4'

PROJECT NO. R-1315
L5-13014
SHEET 1 OF 1
FILE NO. 4139

INDIANA AVE