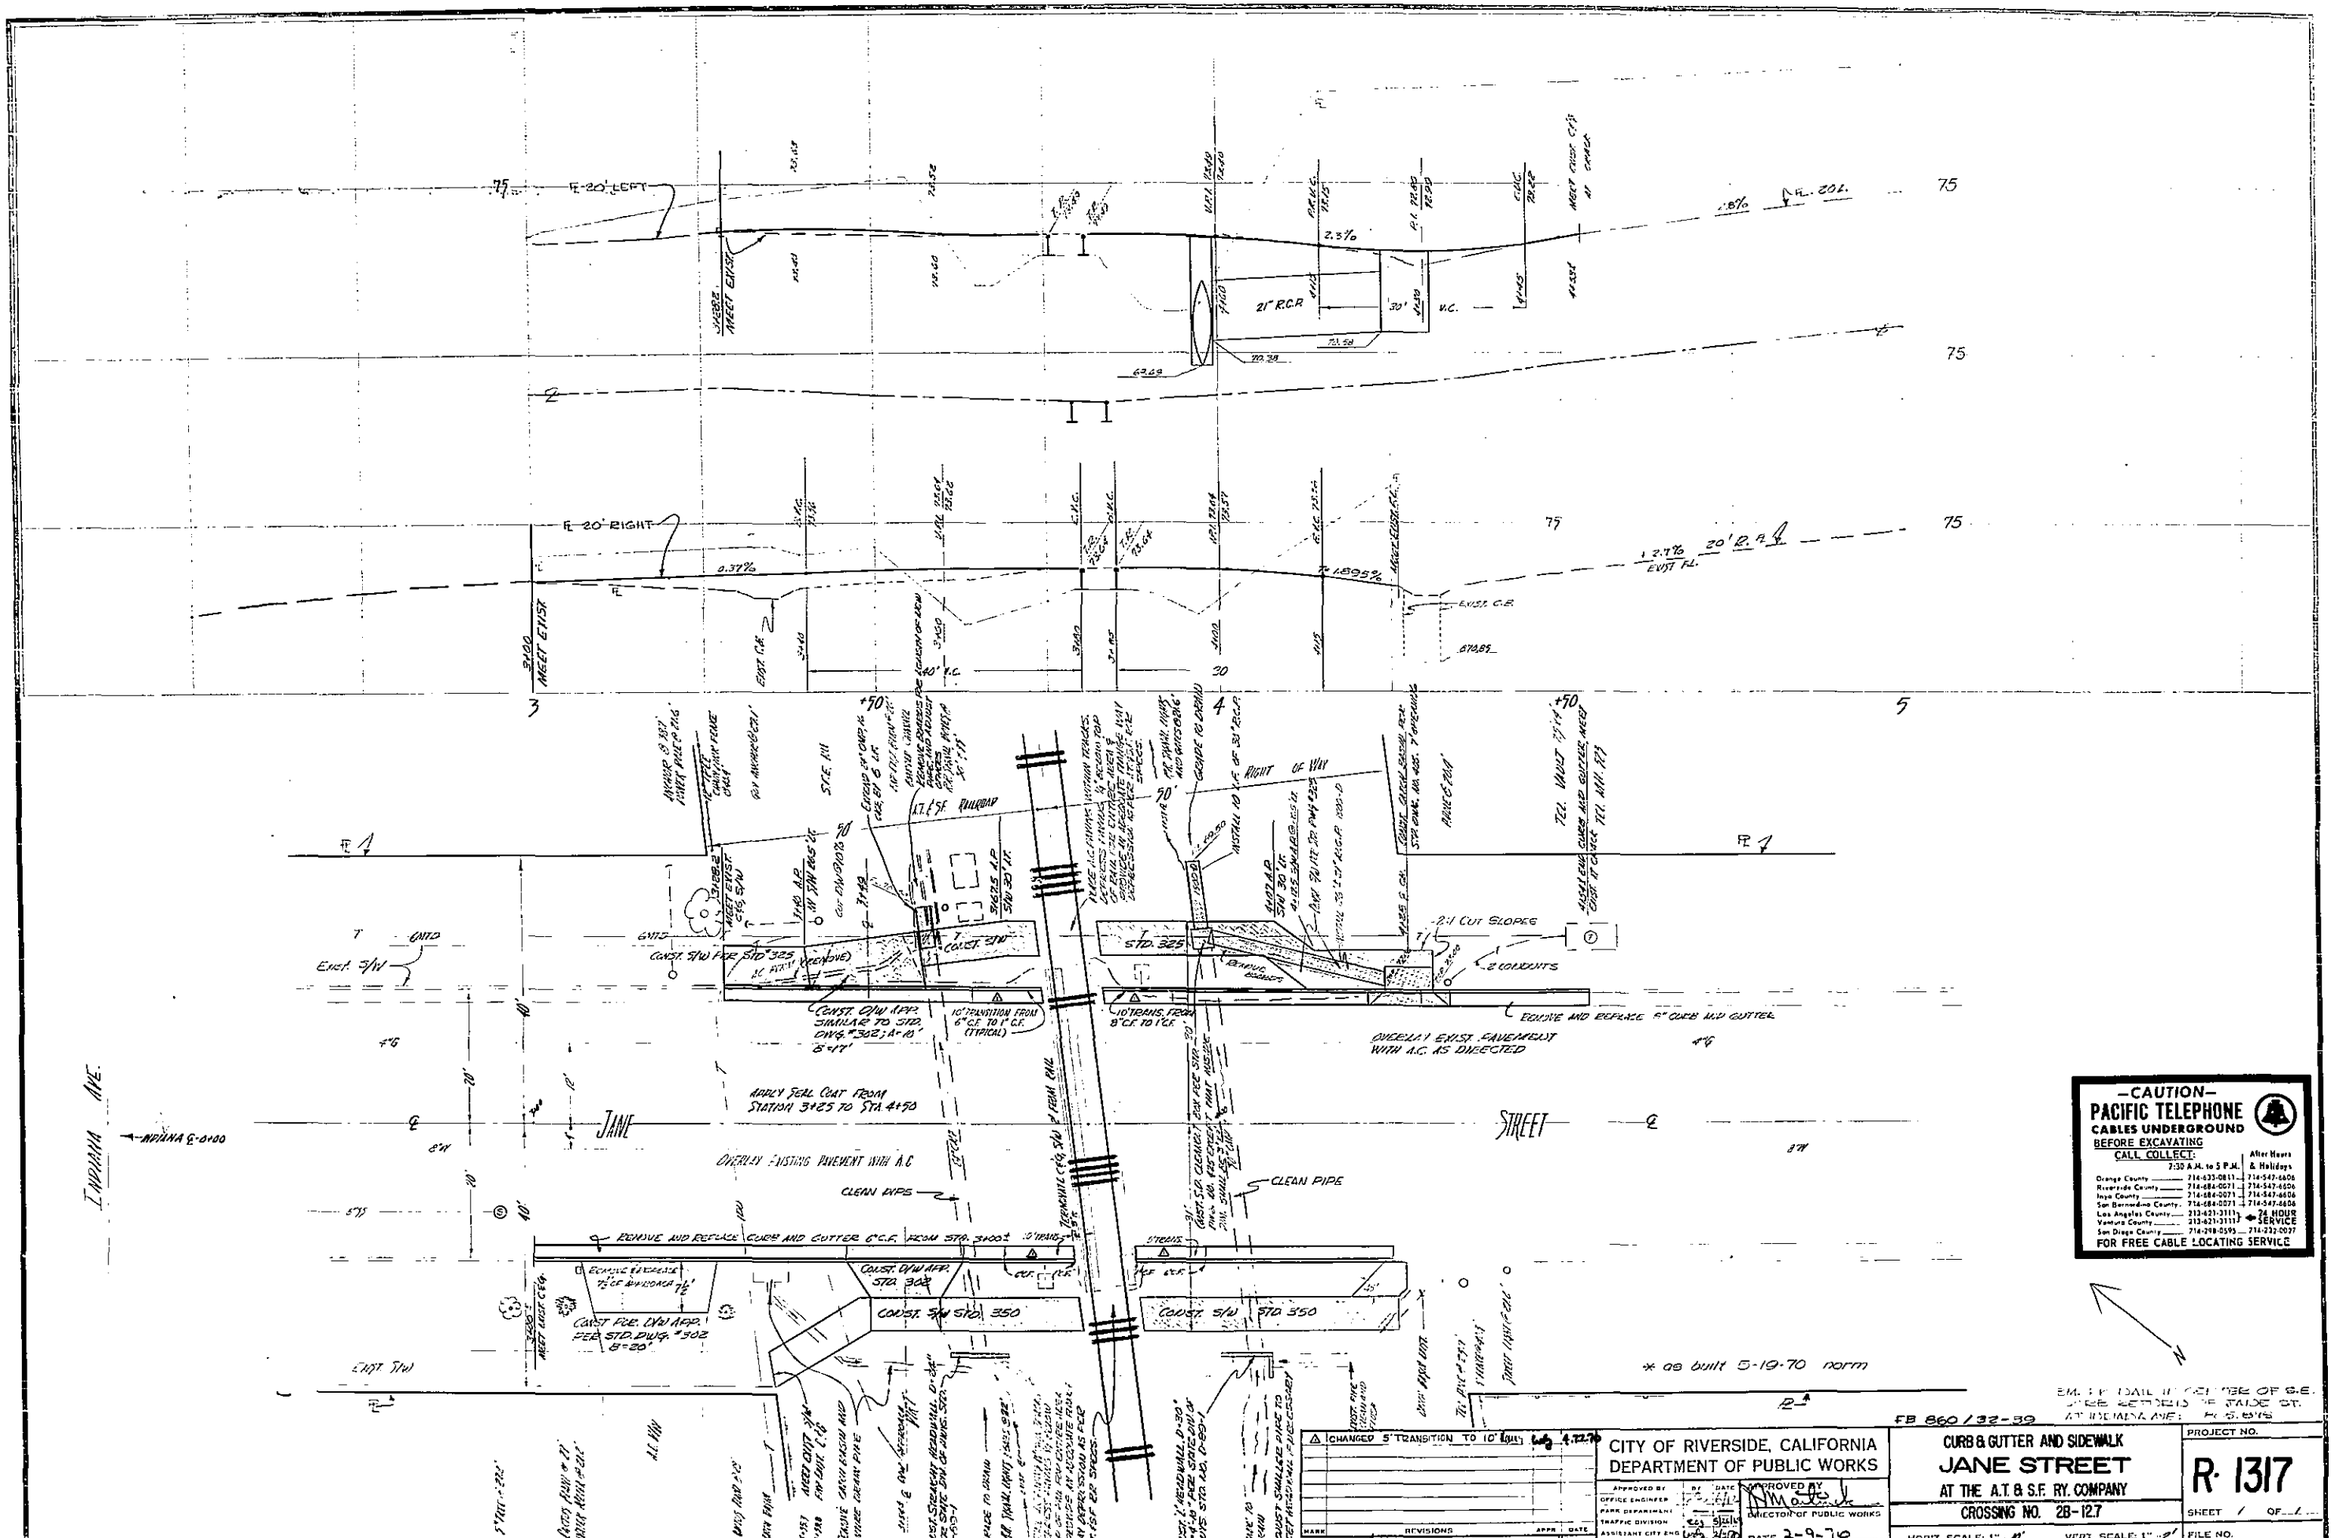
JANE STREET
INDIANA AVE.
AT & SF RAILROAD
RIGHT OF WAY
21" R.C.P.
30' V.C.
40' V.C.
2.3%
0.37%
1.8%
1.895%
2.7%
EL. 20'
EL. 20' LEFT
EL. 20' RIGHT
EXIST. C.B.
2:1 CUT SLOPES
2 COLUMNS
REMOVE AND REPLACE 6" CURB AND GUTTER
OVERLAY EXIST. PAVEMENT WITH A.C. AS DIRECTED
APPLY SEAL COAT FROM STATION 3+25 TO STA. 4+50
OVERLAY EXISTING PAVEMENT WITH A.C.
CLEAN PIPE
REMOVE AND REPLACE CURB AND GUTTER 6" C.F. FROM STA. 3+00±
CONST. S/W STD. 350
CONST. D/W APP. STD. 302
CONST. S/W STD. 325
CONST. D/W APP. SIMILAR TO STD. DWG. #302; A=18'
10' TRANSITION FROM 6" C.F. TO 1' C.F. (TYPICAL)
10' TRANS. FROM 8" C.F. TO 1' C.F.
CONST. FOR D/W APP. PER STD. DWG. #302 B=20'
EXIST. S/W
* as built 5-19-70 norm
FB 860 / 32-39
CHANGED 5' TRANSITION TO 10' Equiv. 4-22-70
CITY OF RIVERSIDE, CALIFORNIA
DEPARTMENT OF PUBLIC WORKS
APPROVED BY
OFFICE ENGINEER
PARK DEPARTMENT
TRAFFIC DIVISION
ASSISTANT CITY ENG.
DIRECTOR OF PUBLIC WORKS
DATE 2-9-70
MARK REVISIONS APPR. DATE
DESIGNED BY DRAWN BY CHECKED BY
CURB & GUTTER AND SIDEWALK
JANE STREET
AT THE A.T. & S.F. RY. COMPANY
CROSSING NO. 2B-12.7
PROJECT NO.
R-1317
SHEET 1 OF 1
FILE NO.
HORIZ. SCALE: 1" = 10'
VERT. SCALE: 1" = 2'
—CAUTION—
PACIFIC TELEPHONE
CABLES UNDERGROUND
BEFORE EXCAVATING
CALL COLLECT:
7:30 A.M. to 5 P.M.
After Hours & Holidays
Orange County 714-633-0811 714-547-6606
Riverside County 714-684-0071 714-547-6606
Inyo County 714-684-0071 714-547-6606
San Bernardino County 714-684-0071 714-547-6606
Los Angeles County 213-621-3111 24 HOUR SERVICE
Ventura County 213-621-3111 24 HOUR SERVICE
San Diego County 714-298-0595 714-232-0037
FOR FREE CABLE LOCATING SERVICE