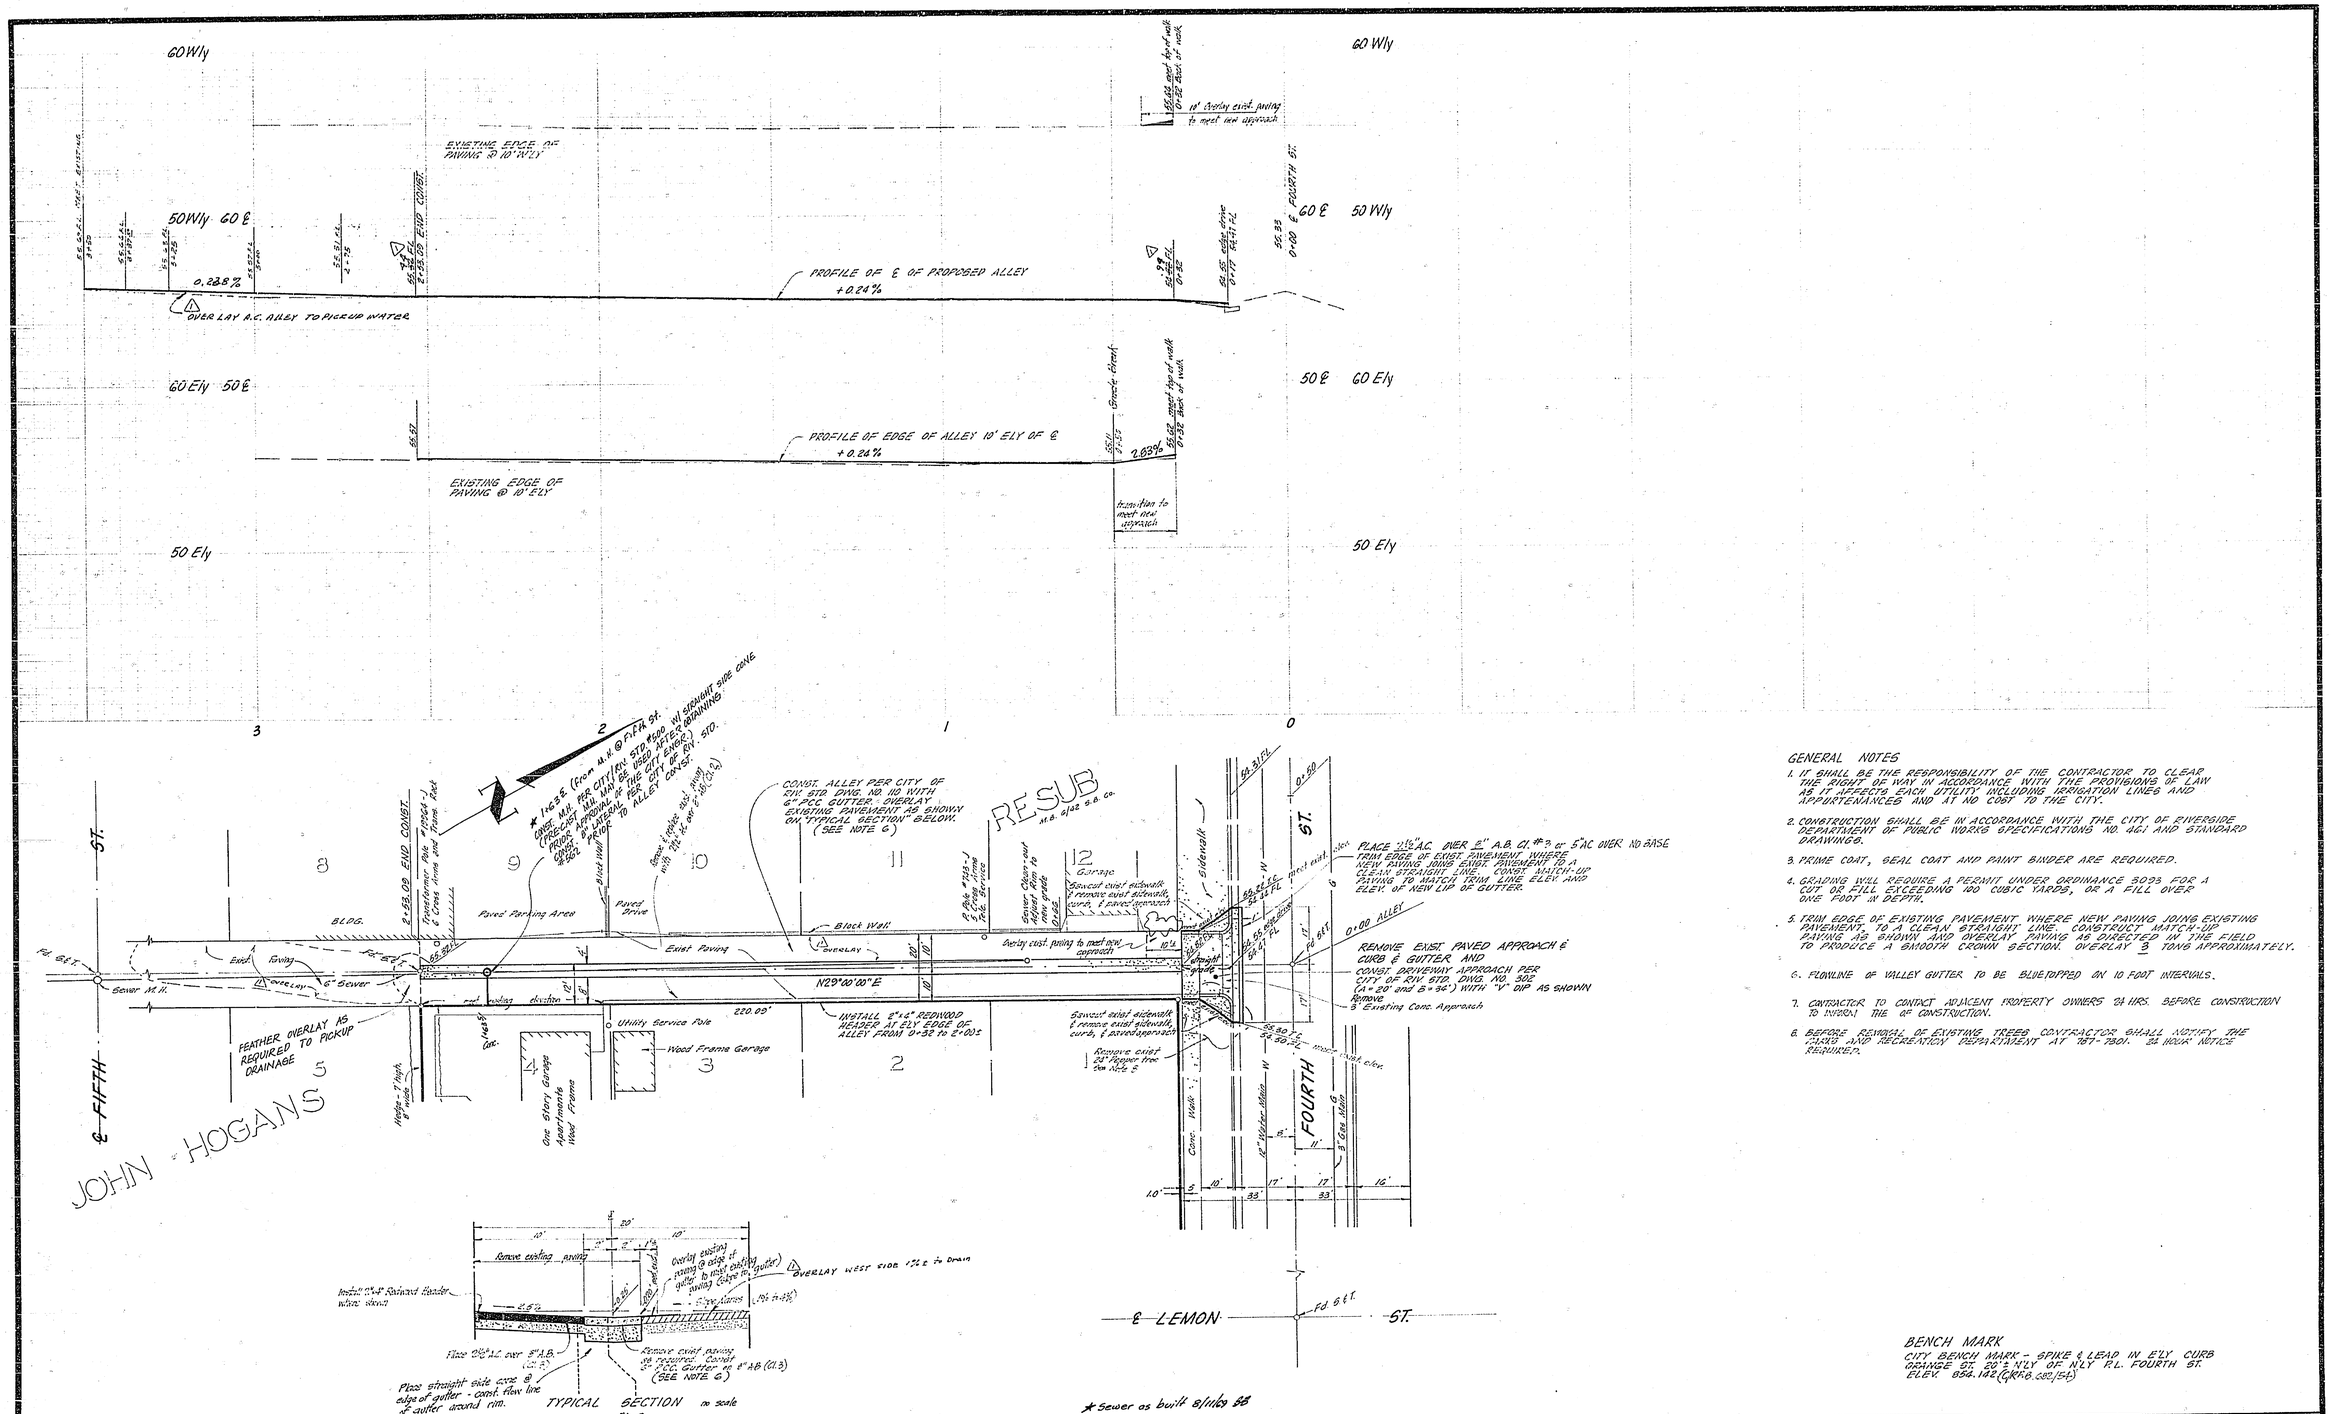

★ Sewer as built 8/16/63

GENERAL NOTES

1. IT SHALL BE THE RESPONSIBILITY OF THE CONTRACTOR TO CLEAR THE RIGHT OF WAY IN ACCORDANCE WITH THE PROVISIONS OF LAW AS IT AFFECTS EACH UTILITY INCLUDING IRRIGATION LINES AND APPURTENANCES AND AT NO COST TO THE CITY.
2. CONSTRUCTION SHALL BE IN ACCORDANCE WITH THE CITY OF RIVERSIDE DEPARTMENT OF PUBLIC WORKS SPECIFICATIONS NO. 461 AND STANDARD DRAWINGS.
3. PRIME COAT, SEAL COAT AND PAINT BINDER ARE REQUIRED.
4. GRADING WILL REQUIRE A PERMIT UNDER ORDINANCE 3093 FOR A CUT OR FILL EXCEEDING 100 CUBIC YARDS, OR A FILL OVER ONE FOOT IN DEPTH.
5. TRIM EDGE OF EXISTING PAVEMENT WHERE NEW PAVING JOINS EXISTING PAVEMENT, TO A CLEAN STRAIGHT LINE. CONSTRUCT MATCH-UP PAVING AS SHOWN AND OVERLAY PAVING AS DIRECTED IN THE FIELD TO PRODUCE A SMOOTH CROWN SECTION. OVERLAY 3" TONS APPROXIMATELY.
6. FLOWLINE OF VALLEY GUTTER TO BE BLUETOPPED ON 10 FOOT INTERVALS.
7. CONTRACTOR TO CONTACT ADJACENT PROPERTY OWNERS 24 HRS. BEFORE CONSTRUCTION TO INFORM THE OF CONSTRUCTION.
8. BEFORE REMOVAL OF EXISTING TREES CONTRACTOR SHALL NOTIFY THE PARKS AND RECREATION DEPARTMENT AT 787-7801. 24 HOUR NOTICE REQUIRED.

BENCH MARK

CITY BENCH MARK - SPIKE & LEAD IN E'LY CURB ORANGE ST. 20 ± N'LY OF N'LY P.L. FOURTH ST.
ELEV. 858.142 (G.K.R.S. 2301/F5F)

J. F. DAVIDSON ASSOCIATES
CIVIL ENGINEERS - SURVEYORS - PLANNERS
RIVERSIDE, CALIFORNIA

APPROVED BY Robert S. Tripp DATE 10-24-68
R.E. NO. 16291

W.O. 2068 FOR. RETIREMENT HOUSING F.B. 927-39

MARK	REVISIONS	APPR.	DATE
1	Add overlay at curb line & west side for drainage		12-15-67

DESIGNED BY JACK DRAWN BY PAUL CHECKED BY GEN

CITY OF RIVERSIDE, CALIFORNIA
DEPARTMENT OF PUBLIC WORKS

APPROVED BY	BY	DATE
OFFICE ENGINEER		12-16
PARK DEPARTMENT		12-5
TRAFFIC DIVISION		12-13
ASSISTANT CITY ENG.		12-17

APPROVED BY
DIRECTOR OF PUBLIC WORKS
DATE 12-17-67

PLAN AND PROFILE
ALLEY
SOUTHERLY OF FOURTH ST.
BETWEEN ORANGE AND LEMON
C-20-645

HORIZ. SCALE: 1" = 20' VERT. SCALE: 1" = 4'

PROJECT NO. R-1322
SHEET 1 OF 1
FILE NO. 3356