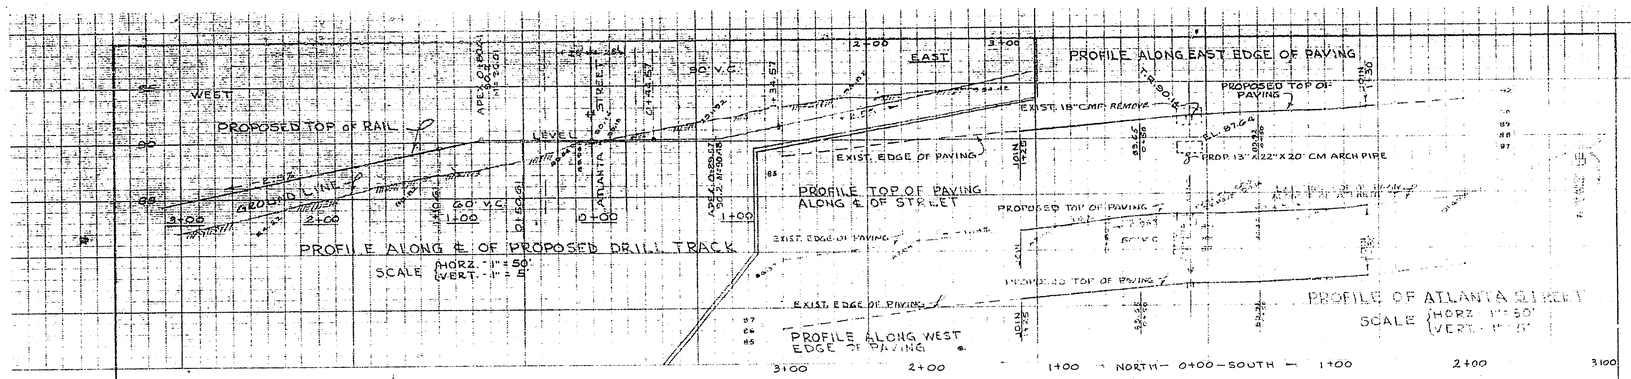

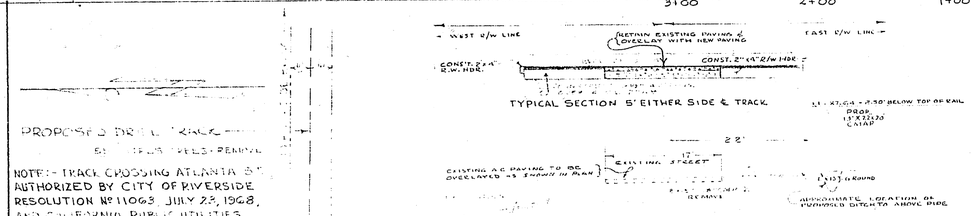

PROPOSED DRILL TRACK

NOTE:- TRACK CROSSING ATLANTA ST. AUTHORIZED BY CITY OF RIVERSIDE RESOLUTION № 11063 JULY 23, 1968, AND CALIFORNIA PUBLIC UTILITIES COMMISSION DECISION № 74774, OCT 8, 1968. - CROSSING ASSIGNED № "BJ-544.45-C"

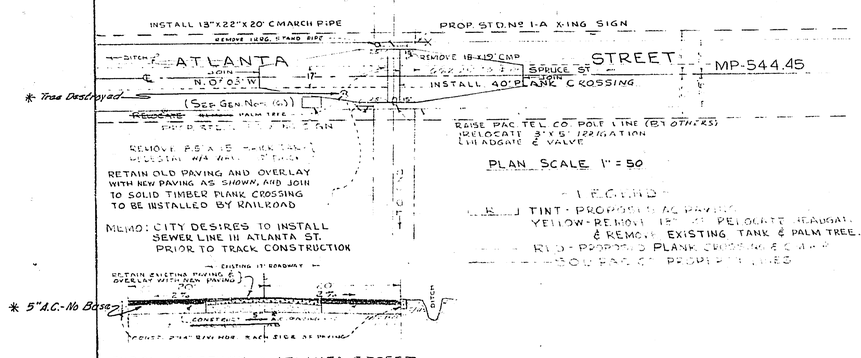

~ GENERAL NOTES ~

(1) IT SHALL BE THE RESPONSIBILITY OF THE CONTRACTOR TO CLEAR THE RIGHT OF WAY IN ACCORDANCE WITH THE PROVISIONS OF LAW AS IT AFFECTS EACH UTILITY, INCLUDING IRRIGATION LINES AND APPURTENANCES, AND AT NO COST TO THE CITY.

(2) CONSTRUCTION SHALL BE IN ACCORDANCE WITH THE CITY OF RIVERSIDE, DEPARTMENT OF PUBLIC WORKS, SPECIFICATIONS № 461 AND STANDARD DRAWINGS.

(3) PRIME COAT, SEAL COAT, AND PAINT BINDER ARE REQUIRED.

(4) TRIM EDGE OF EXISTING PAVEMENT, WHERE NEW PAVING JOINS EXISTING PAVEMENT, TO A CLEAN, STRAIGHT LINE. CONSTRUCT MATCH-UP PAVING AS SHOWN AND OVERLAY PAVING AS DIRECTED IN THE FIELD TO PRODUCE A SMOOTH CROWN SECTION

(5) RAILROAD SHALL INSTALL TWO STANDARD № 1-A "REFLECTORIZED" CROSSING SIGNS PER P.U.C GENERAL ORDER № 75-B.

NOTE: CONTRACTOR IS TO CONTACT THE CITY ENGINEER PRIOR TO CONSTRUCTION TO NEGOTIATE CITY OF RIVERSIDE ("BY OTHERS") PORTION OF CONSTRUCTION.

NOTICE TO CONTRACTOR: THE EXISTENCE AND LOCATION OF ANY UNDERGROUND UTILITY PIPES OR STRUCTURES SHOWN ON THESE PLANS ARE OBTAINED BY A SEARCH OF THE AVAILABLE RECORDS. TO THE BEST OF OUR KNOWLEDGE, THERE ARE NO EXISTING UTILITIES EXCEPT AS SHOWN ON THESE PLANS.

THE CONTRACTOR IS REQUIRED TO TAKE DUE PRECAUTIONARY MEASURES TO PROTECT THE UTILITY LINES SHOWN AND ANY OTHER LINES NOT OF RECORD OR NOT SHOWN ON THESE PLANS.

THE CONTRACTOR IS TO ACQUIRE PERMITS AND ARRANGE FOR TRAFFIC PROTECTION WITH CITY OF RIVERSIDE

(6) THE CONTRACTOR SHALL RELOCATE THIS PALM TREE TO IOWA AVE. NORTH OF S.P. MAIN LINE, PER CITY PARK & RECREATION DEPT. SPECS. — CONTACT MR. DAVENPORT @ 787-7518 PRIOR TO RELOCATING.

SOUTHERN PACIFIC COMPANY
PACIFIC LINES
RIVERSIDE

STREET PLAN AND PROFILE - ATLANTA STREET AT RAILROAD'S PROPOSED TRACK CROSSING AT GRADE M.P. 544.45

* As Built - Norm 7-31-69

REV MAR 17, 1969

L.A. DWN.
DWG. B 5179
SHEET № 1

MARK	REVISIONS	APPR.	DATE

DESIGNED BY ____ DRAWN BY ____ CHECKED BY ____

CITY OF RIVERSIDE, CALIFORNIA
DEPARTMENT OF PUBLIC WORKS

APPROVED BY	BY	DATE
OFFICE ENGINEER		
PARK DEPARTMENT		
TRAFFIC DIVISION		
ASSISTANT CITY ENG.		3-27

APPROVED BY ____ DIRECTOR OF PUBLIC WORKS
DATE ____

ATLANTA STREET
AT PROPOSED S.P.R.R. CROSSING
BETWEEN SPRUCE AND SUMAN

HORIZ. SCALE: 1" = 50' VERT. SCALE: 1" = 5'

PROJECT NO. R-1344
SHEET 1 OF 1
FILE NO.