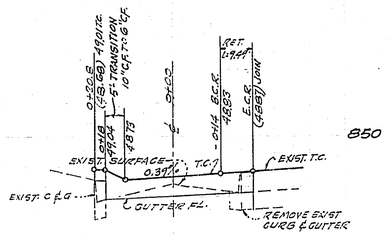

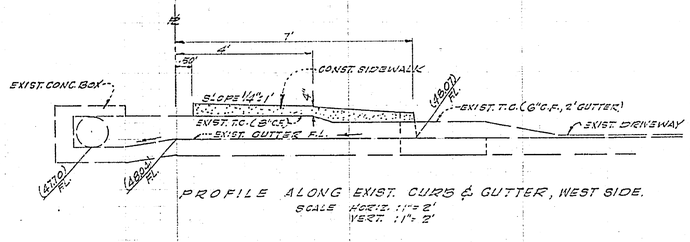

PROFILE ALONG EXIST. CURB & GUTTER, WEST SIDE.
SCALE HORIZ. : 1" = 2'
VERT. : 1" = 2'

PROFILE SCALE
HORIZ. : 1" = 20'
VERT. : 1" = 2'

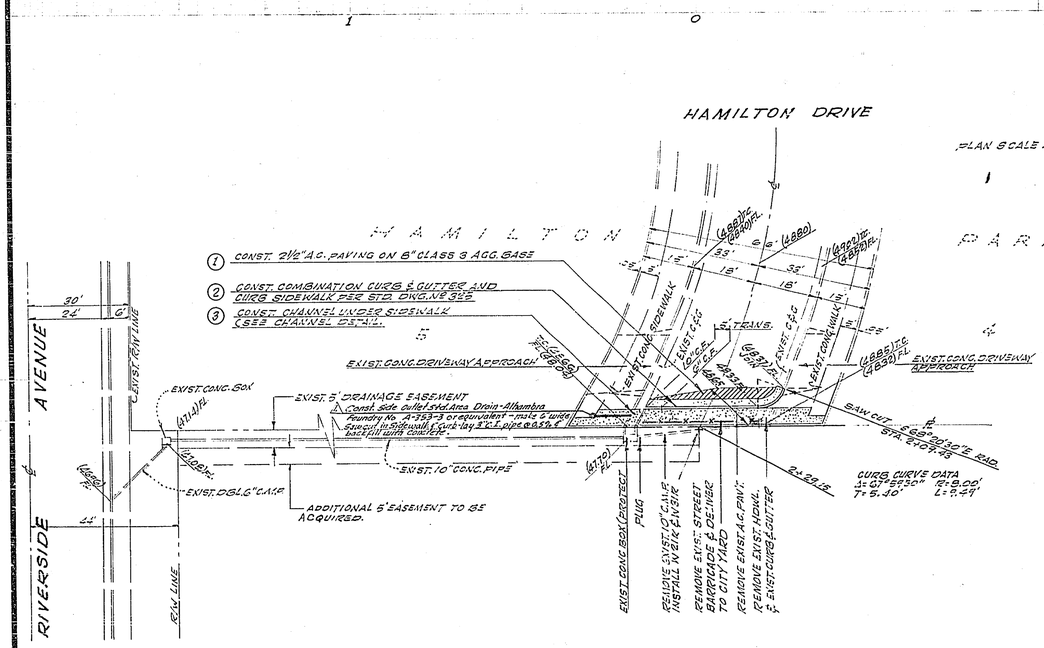

PLAN SCALE : 1" = 20'

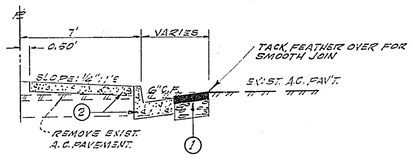

TYPICAL SECTION
COMB. CURB & GUTTER AND CURB SIDEWALK.
SCALE: 1" = 4'

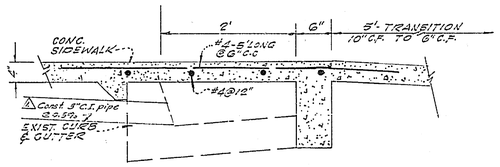

CHANNEL DETAIL
SCALE: 1" = 1'

GENERAL NOTES

1. CONSTRUCTION SHALL BE IN ACCORDANCE WITH THE CITY OF RIVERSIDE DEPT. OF PUBLIC WORKS, SPECIFICATIONS No 461 AND STANDARD DRAWINGS.
2. IT SHALL BE THE RESPONSIBILITY OF THE CONTRACTOR TO CLEAR THE RIGHT OF WAY IN ACCORDANCE WITH THE PROVISIONS OF LAW AS IT AFFECTS EACH UTILITY INCLUDING IRRIGATION LINES AND APPURTENANCES AND AT NO COST TO THE CITY.
3. PRIME COAT, SEAL COAT AND PAINT BINDER ARE REQUIRED.
4. TRIM EDGE OF EXISTING PAVEMENT WHERE NEW PAVEMENT JOINS EXISTING PAVEMENT TO A CLEAN STRAIGHT LINE. CONSTRUCT MATCH UP PAVING AS SHOWN.

BENCH MARK
PK NAIL IN LEAD IN SW CURB RETURN, CENTRAL & RIVERSIDE AVE. CITY F.G. 727/57
ELEV. 835.61

CRAWLEY, HAWKINS & ASSOC.
ENGINEERS AND SURVEYORS
3769 ELIZABETH ST., RIVERSIDE, CALIF.
APPROVED: George O. Crawley 3/12 1969
R.C.E. 9455 DATE

MARK	REVISIONS	APPR.	DATE
1	Add outlet and 3" cast iron pipe		14/1/69

DESIGNED BY ____ DRAWN BY ____ CHECKED BY ____

CITY OF RIVERSIDE, CALIFORNIA
DEPARTMENT OF PUBLIC WORKS

APPROVED BY	BY	DATE
OFFICE ENGINEER		4/3
PARK DEPARTMENT		
TRAFFIC DIVISION		4-3
ASSISTANT CITY ENG.		4/3

APPROVED BY William D. Gardner
DIRECTOR OF PUBLIC WORKS
DATE 4/3/69

STREET PLAN AND PROFILE
HAMILTON DRIVE
CLOSING OF SOUTH END
C-9-689
HORIZ. SCALE: 1" = 20' VERT. SCALE: 1" =

PROJECT NO. R-1347
SHEET 1 OF 1
FILE NO. 4148

J.O. 1025 | FOR: ORANGE COAST CONST. CO. | F.B. 94/39