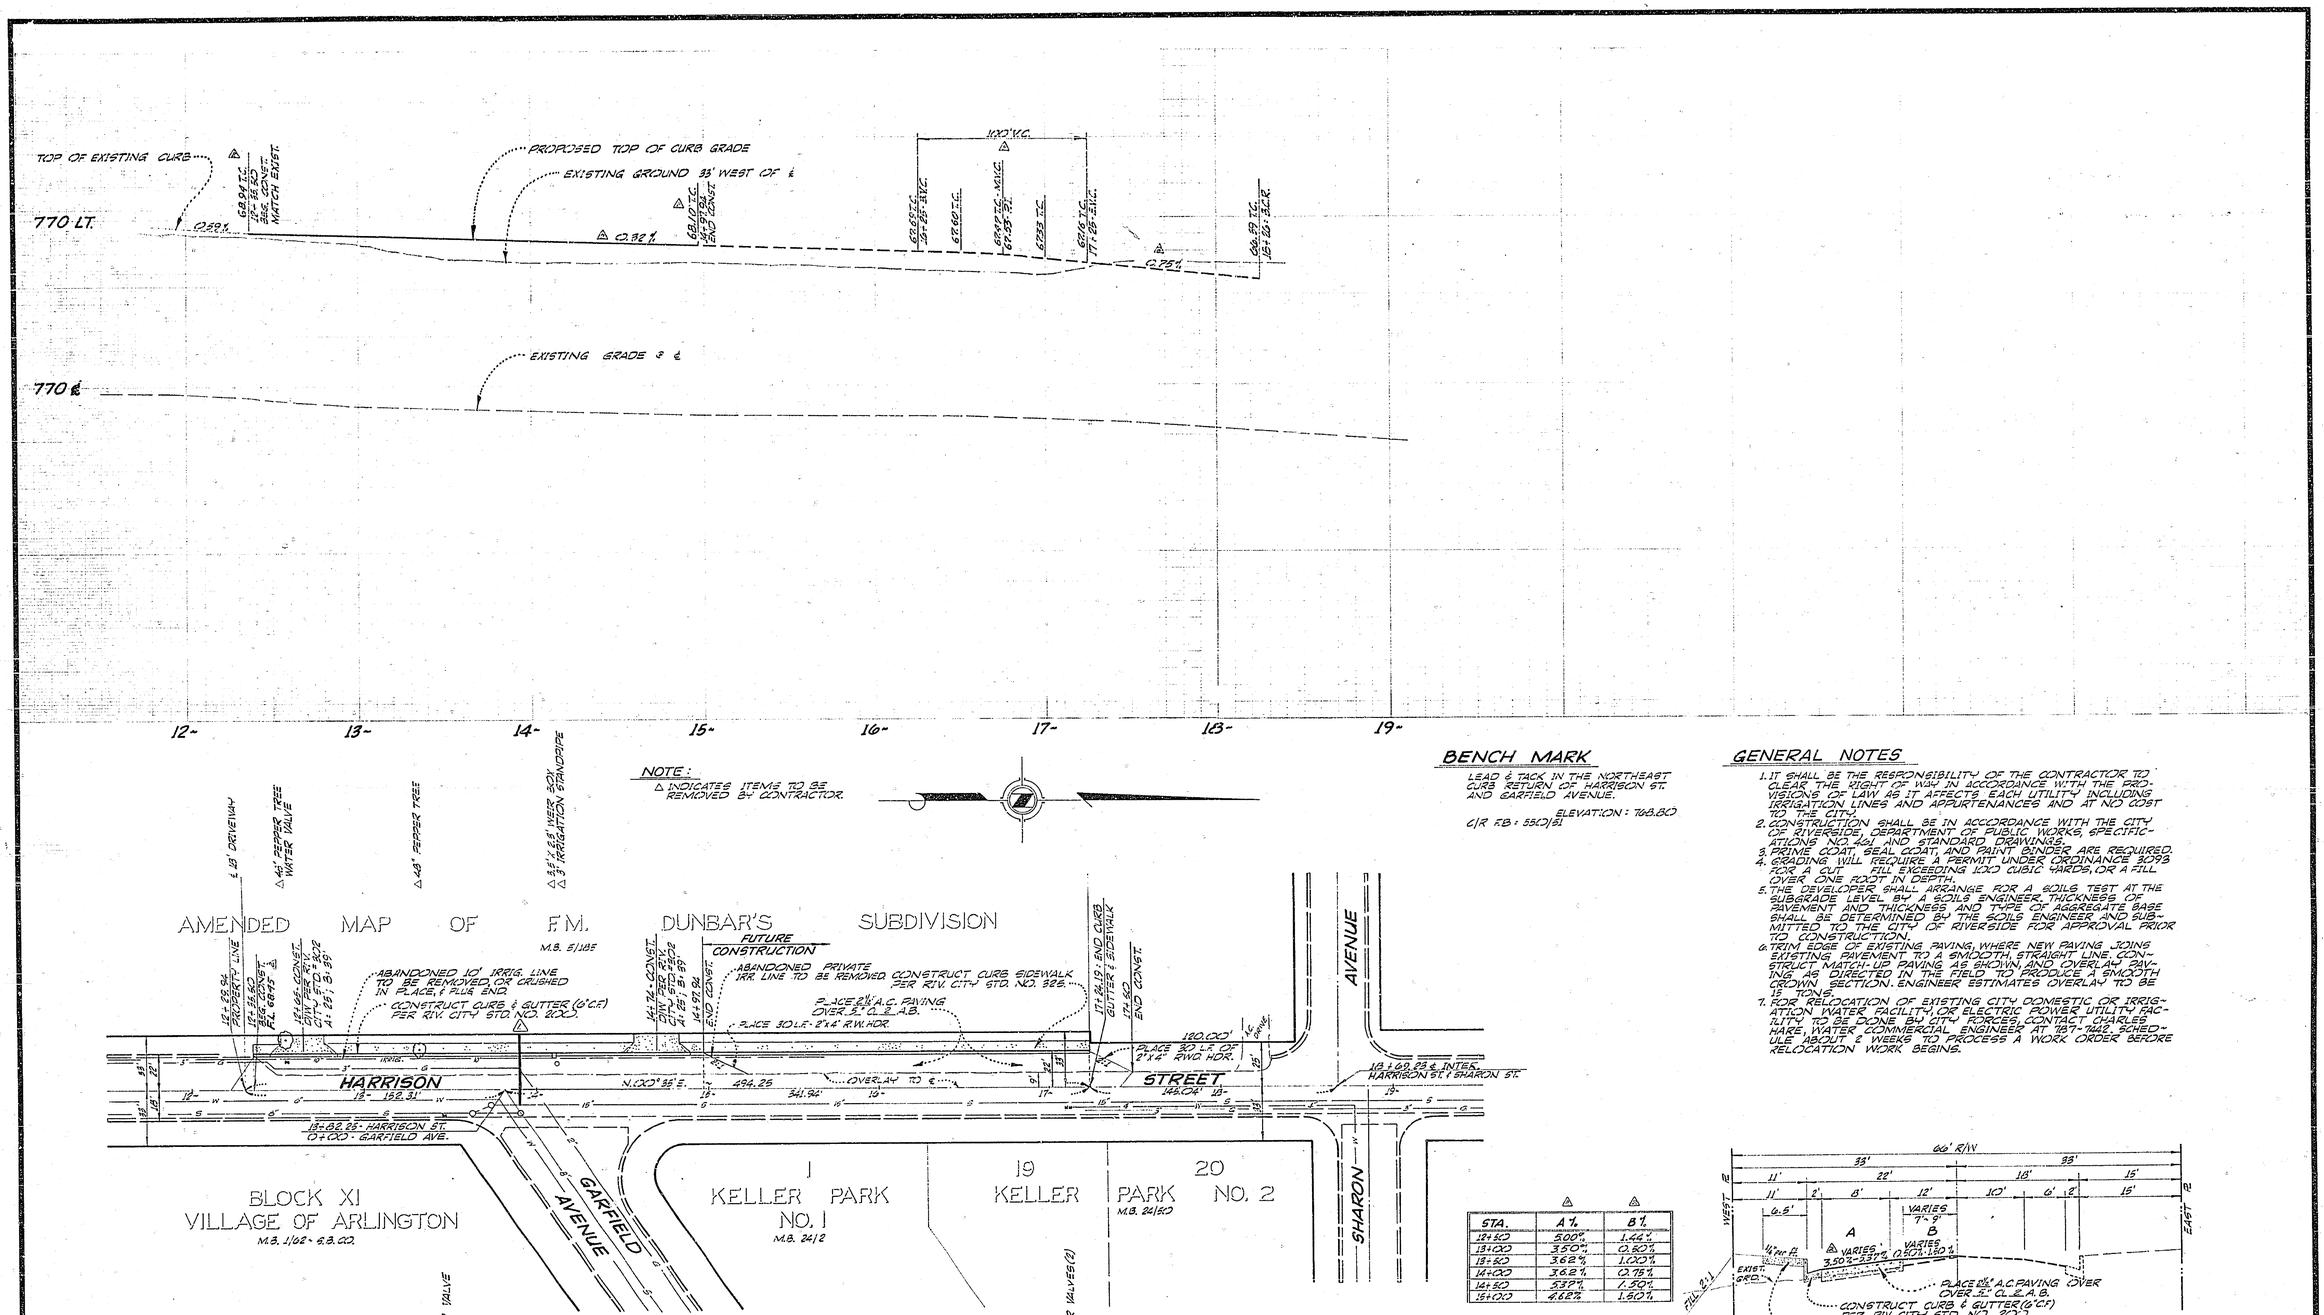

NOTE:
△ INDICATES ITEMS TO BE REMOVED BY CONTRACTOR.

BENCH MARK

LEAD & TACK IN THE NORTHEAST CURB RETURN OF HARRISON ST. AND GARFIELD AVENUE.

ELEVATION: 768.80

C/R F.B.: 55/0/81

GENERAL NOTES

1. IT SHALL BE THE RESPONSIBILITY OF THE CONTRACTOR TO CLEAR THE RIGHT OF WAY IN ACCORDANCE WITH THE PROVISIONS OF LAW AS IT AFFECTS EACH UTILITY INCLUDING IRRIGATION LINES AND APPURTENANCES AND AT NO COST TO THE CITY.
2. CONSTRUCTION SHALL BE IN ACCORDANCE WITH THE CITY OF RIVERSIDE, DEPARTMENT OF PUBLIC WORKS, SPECIFICATIONS NO. 401 AND STANDARD DRAWINGS.
3. PRIME COAT, SEAL COAT, AND PAINT BINDER ARE REQUIRED.
4. GRADING WILL REQUIRE A PERMIT UNDER ORDINANCE 3098 FOR A CUT FILL EXCEEDING 100 CUBIC YARDS, OR A FILL OVER ONE FOOT IN DEPTH.
5. THE DEVELOPER SHALL ARRANGE FOR A SOILS TEST AT THE SUBGRADE LEVEL BY A SOILS ENGINEER. THICKNESS OF PAVEMENT AND THICKNESS AND TYPE OF AGGREGATE BASE SHALL BE DETERMINED BY THE SOILS ENGINEER AND SUBMITTED TO THE CITY OF RIVERSIDE FOR APPROVAL PRIOR TO CONSTRUCTION.
6. TRIM EDGE OF EXISTING PAVING WHERE NEW PAVING JOINS EXISTING PAVEMENT TO A SMOOTH, STRAIGHT LINE. CONSTRUCT MATCH-UP PAVING AS SHOWN AND OVERLAY PAVING AS DIRECTED IN THE FIELD TO PRODUCE A SMOOTH CROWN SECTION. ENGINEER ESTIMATES OVERLAY TO BE 15 TONS.
7. FOR RELOCATION OF EXISTING CITY DOMESTIC OR IRRIGATION WATER FACILITY, OR ELECTRIC POWER UTILITY FACILITY TO BE DONE BY CITY FORCES, CONTACT CHARLES HARE, WATER COMMERCIAL ENGINEER AT 787-7802 SCHEDULE ABOUT 2 WEEKS TO PROCESS A WORK ORDER BEFORE RELOCATION WORK BEGINS.

STA.	A %	B %
12+50	5.00%	1.44%
13+00	3.50%	0.80%
13+50	3.62%	1.00%
14+00	3.62%	0.75%
14+50	5.37%	1.50%
15+00	4.62%	1.50%

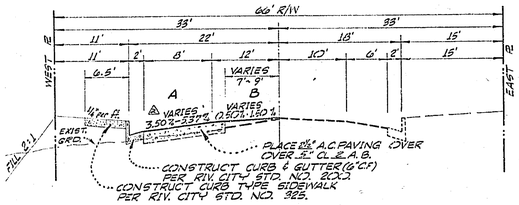

TYPICAL SECTION
HARRISON STREET
NO SCALE, T.I. = 0

Approved by Irrig. Dept.
Thomas L. Brown 5/7/69
CHIEF UTILITIES ENGINEER DATE

J.F. DAVIDSON ASSOCIATES
CIVIL ENGINEERS • SURVEYORS • PLANNERS
RIVERSIDE, CALIFORNIA
APPROVED BY R.C.E. 17550 4-15-69 DATE

W.O. 2218 FOR: H. ROSENBERG F.B. 930/68-69

MARK	REVISIONS	APPR.	DATE
	Revised to conform with Garfield Avenue & Harrison St. Intersection		
A	Relocate lateral to As Built per C/R		

DESIGNED BY R.D.D. DRAWN BY R.D.D. CHECKED BY

CITY OF RIVERSIDE, CALIFORNIA
DEPARTMENT OF PUBLIC WORKS

	BY	DATE
APPROVED BY		
OFFICE ENGINEER		
PARK DEPARTMENT		
TRAFFIC DIVISION		
ASSISTANT CITY ENG.		

APPROVED BY
DIRECTOR OF PUBLIC WORKS
DATE 4-15-68

ZONING CASE: C-20-689
STREET PLAN AND PROFILE
HARRISON STREET
FROM 152' ± SOUTHERLY OF THE ℄ OF GARFIELD AVE. TO 145' ± SOUTHERLY OF ℄ SHARON AVE.

HORIZ. SCALE: 1" = 40' VERT. SCALE: 1" = 4'

PROJECT NO. R-1353
SHEET I OF I
FILE NO. 8363