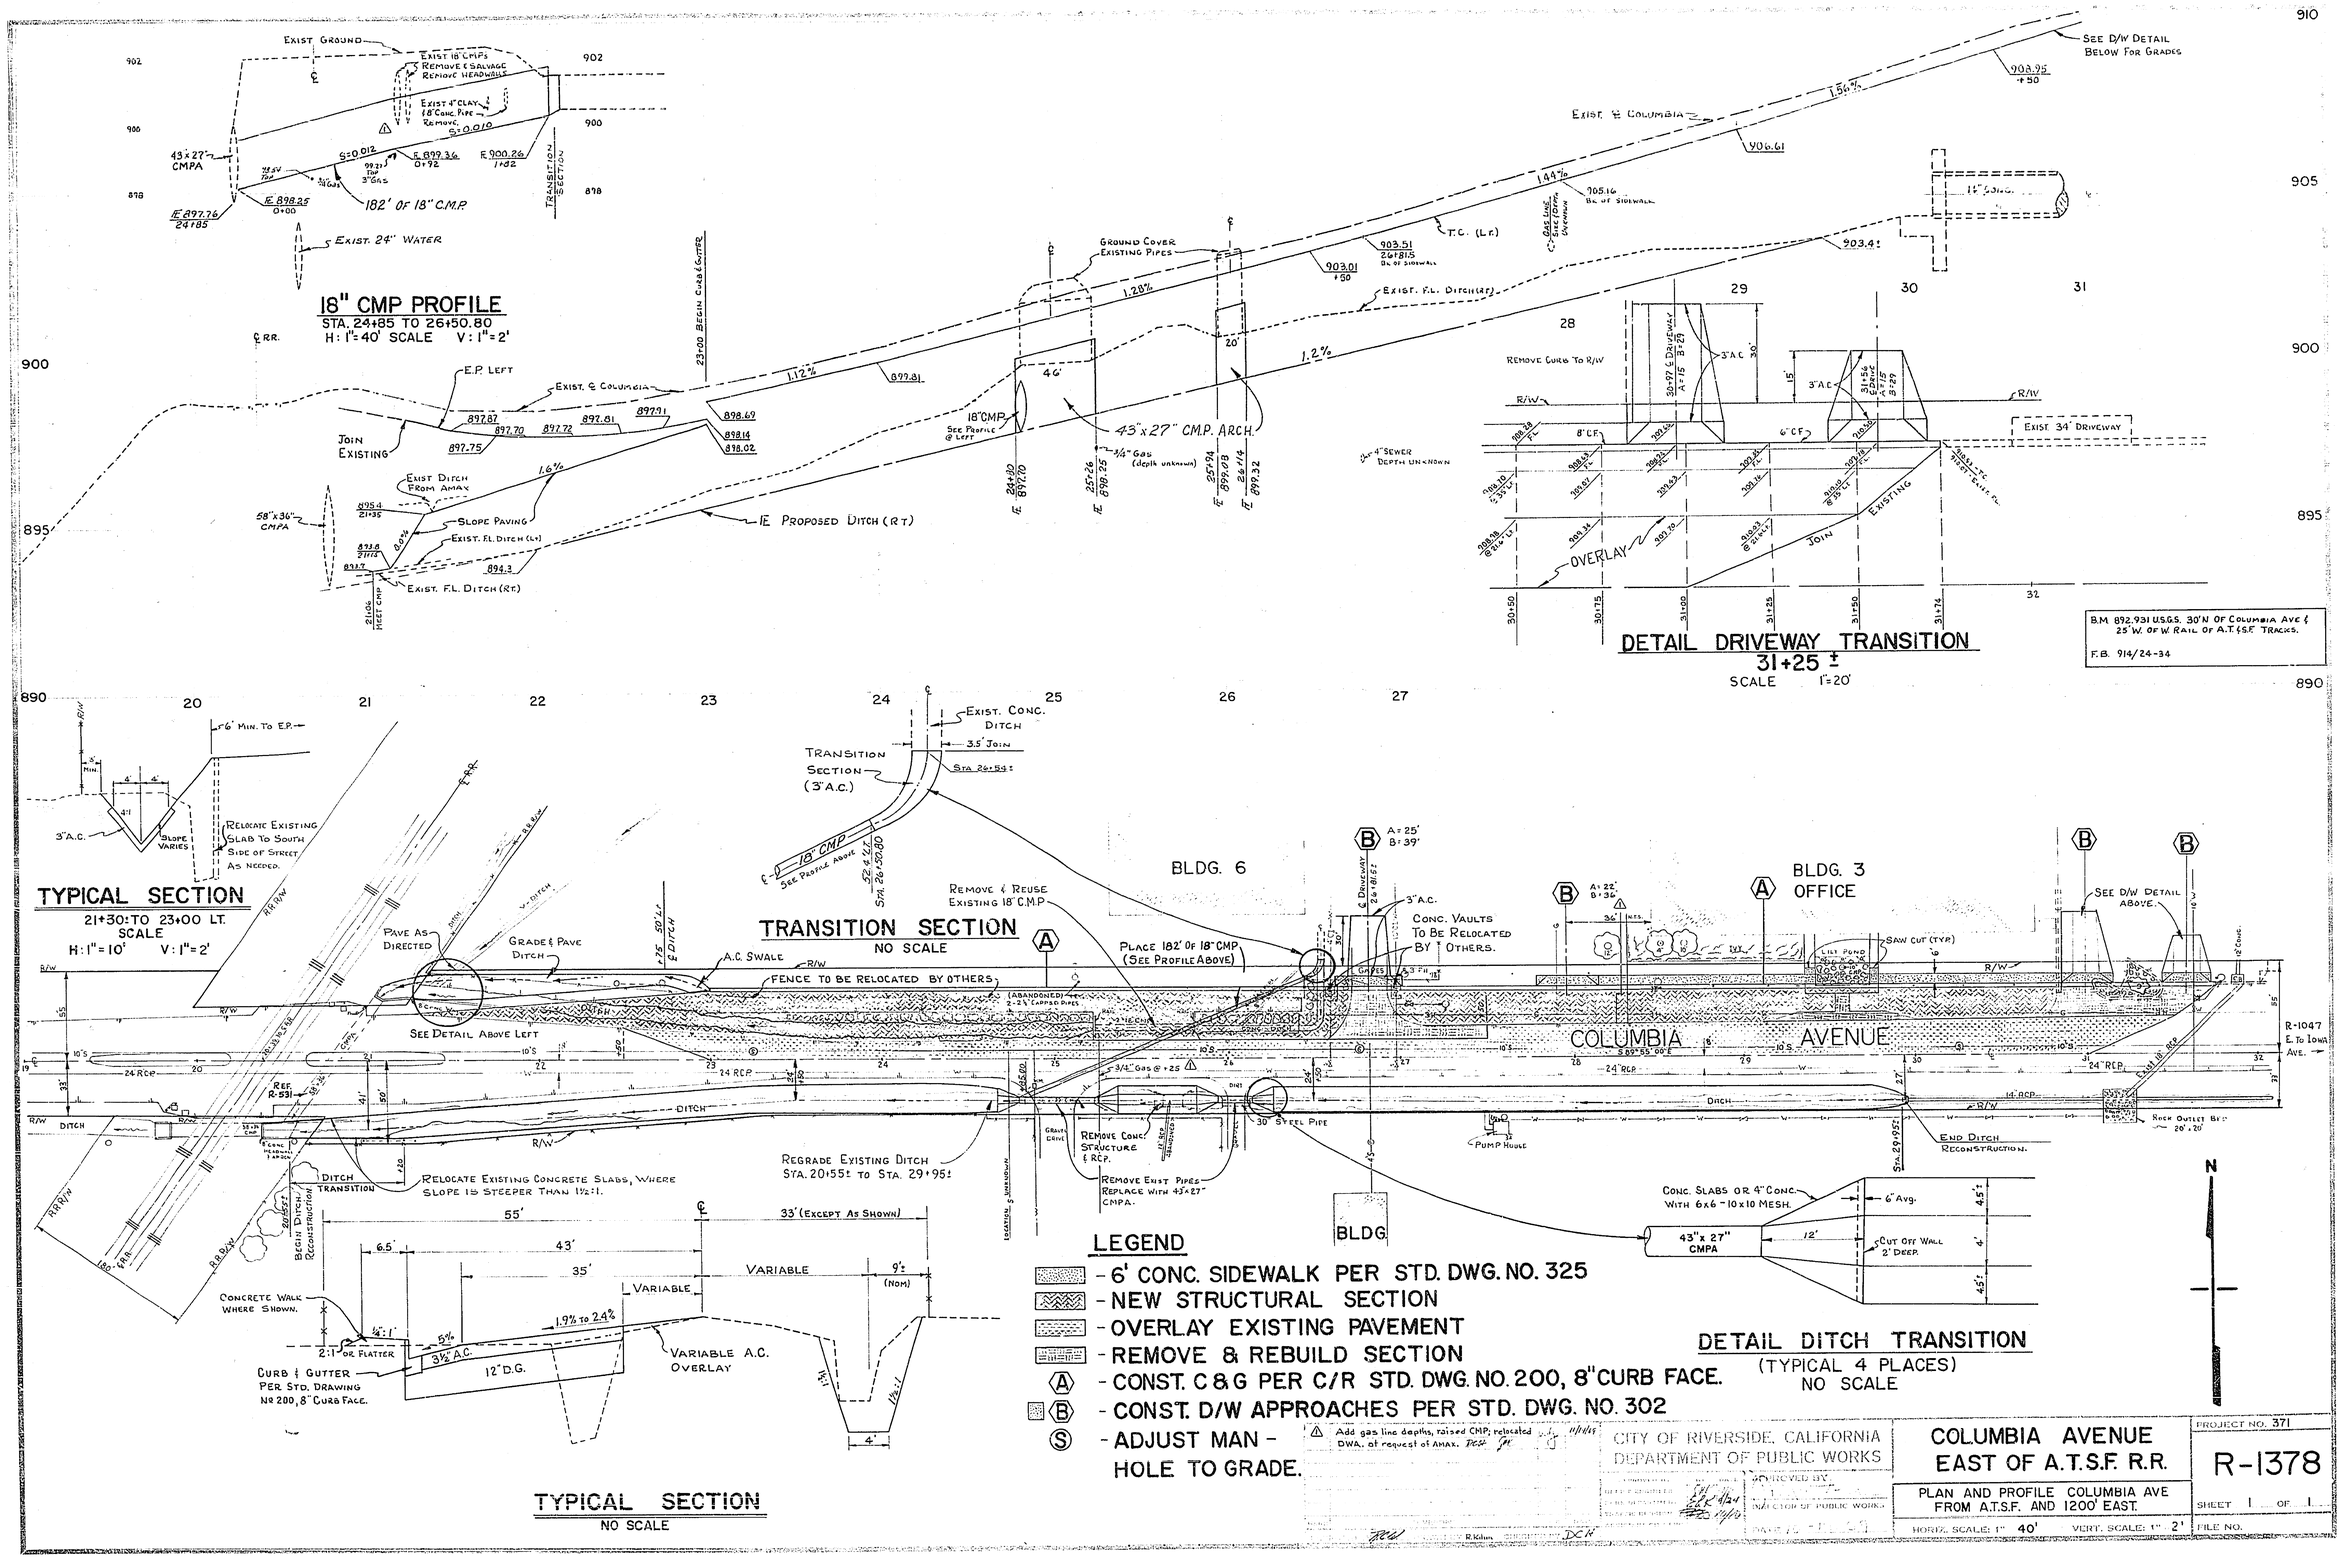
18" CMP PROFILE
STA. 24+85 TO 26+50.80
H: 1"=40' SCALE V: 1"=2'
DETAIL DRIVEWAY TRANSITION
31+25 ±
SCALE 1"=20'
B.M. 892.931 U.S.G.S. 30'N OF COLUMBIA AVE & 25'W. OF W. RAIL OF A.T.&S.F. TRACKS.
F.B. 914/24-34
TYPICAL SECTION
21+30±TO 23+00 LT.
SCALE
H: 1"=10' V: 1"=2'
TRANSITION SECTION
NO SCALE
BLDG. 6
BLDG. 3
OFFICE
COLUMBIA AVENUE
DETAIL DITCH TRANSITION
(TYPICAL 4 PLACES)
NO SCALE
TYPICAL SECTION
NO SCALE
LEGEND
- 6' CONC. SIDEWALK PER STD. DWG. NO. 325
- NEW STRUCTURAL SECTION
- OVERLAY EXISTING PAVEMENT
- REMOVE & REBUILD SECTION
Ⓐ - CONST. C&G PER C/R STD. DWG. NO. 200, 8" CURB FACE.
Ⓑ - CONST. D/W APPROACHES PER STD. DWG. NO. 302
Ⓢ - ADJUST MAN - HOLE TO GRADE.
CITY OF RIVERSIDE, CALIFORNIA
DEPARTMENT OF PUBLIC WORKS
COLUMBIA AVENUE
EAST OF A.T.S.F. R.R.
PLAN AND PROFILE COLUMBIA AVE FROM A.T.S.F. AND 1200' EAST.
PROJECT NO. 371
R-1378
SHEET 1 OF 1
HORIZ. SCALE: 1" 40'
VERT. SCALE: 1" 2'
FILE NO.