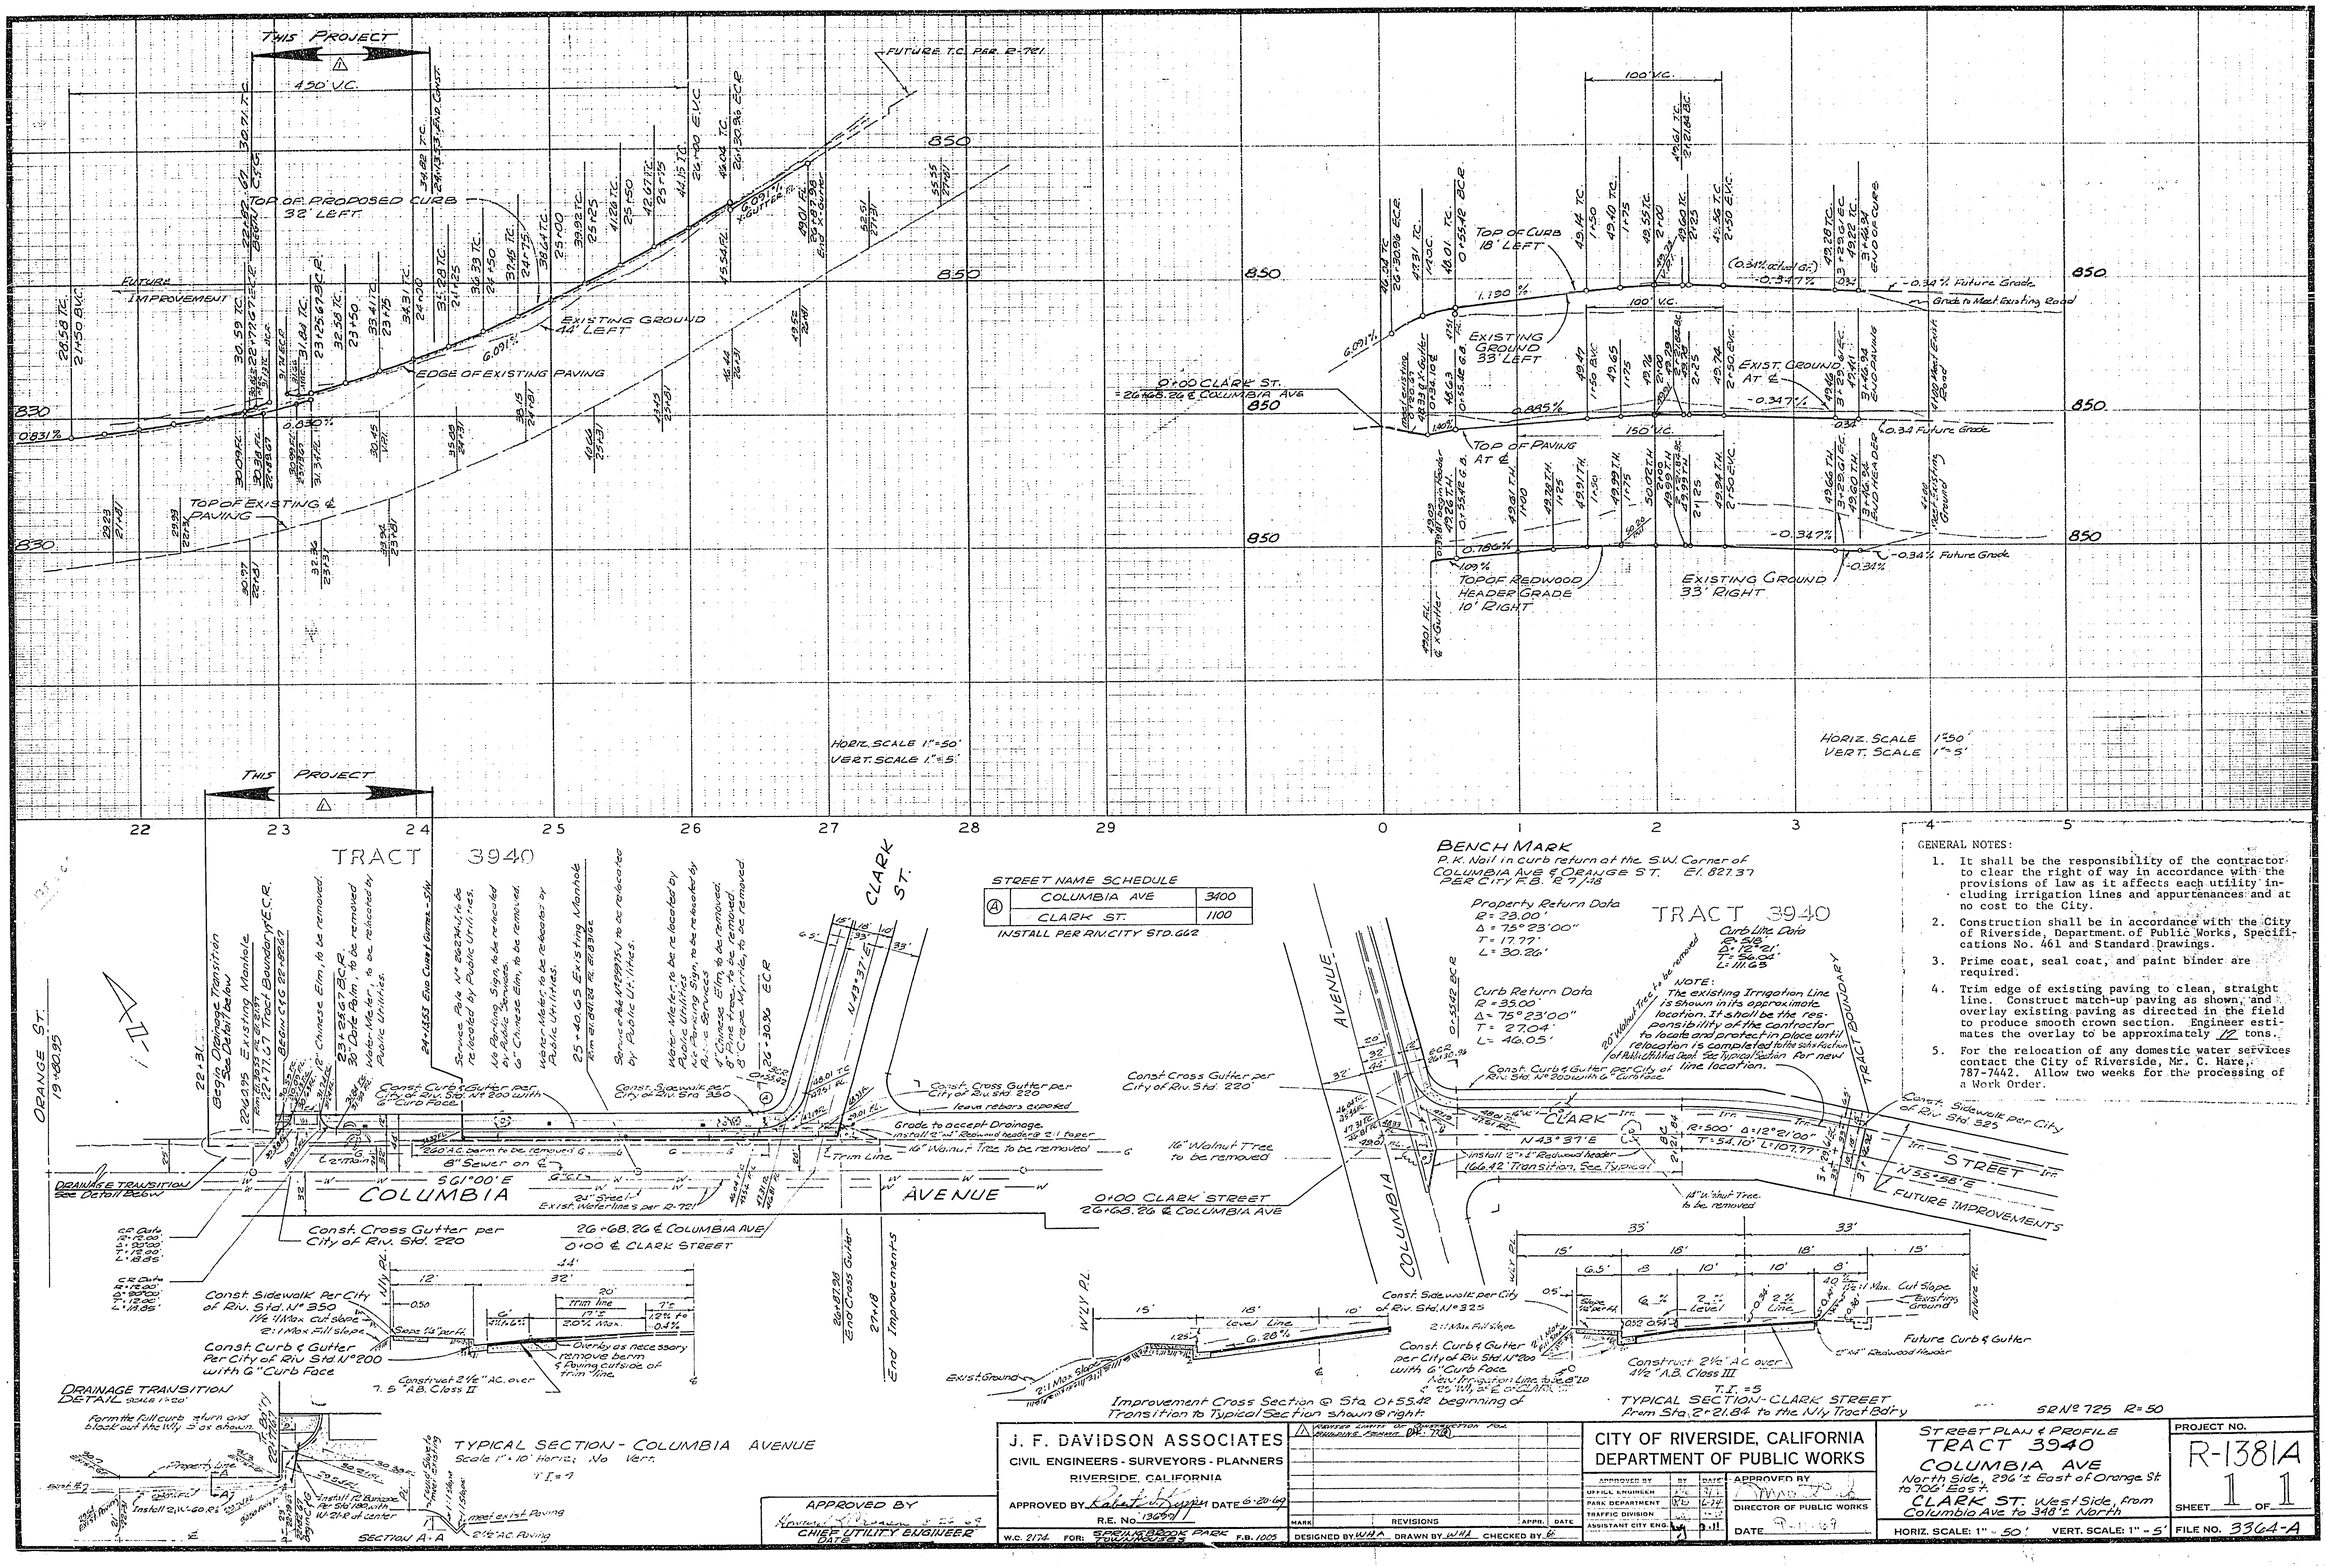

STREET NAME SCHEDULE

Ⓐ	COLUMBIA AVE	3400
	CLARK ST.	1100

INSTALL PER RIV. CITY STD. 662

GENERAL NOTES:

1. It shall be the responsibility of the contractor to clear the right of way in accordance with the provisions of law as it affects each utility including irrigation lines and appurtenances and at no cost to the City.
2. Construction shall be in accordance with the City of Riverside, Department of Public Works, Specifications No. 461 and Standard Drawings.
3. Prime coat, seal coat, and paint binder are required.
4. Trim edge of existing paving to clean, straight line. Construct match-up paving as shown, and overlay existing paving as directed in the field to produce smooth crown section. Engineer estimates the overlay to be approximately 12 tons.
5. For the relocation of any domestic water services contact the City of Riverside, Mr. C. Hare, 787-7442. Allow two weeks for the processing of a Work Order.

APPROVED BY
Kenneth L. Fitzgerald 6-25-69
CHIEF UTILITY ENGINEER
DATE

J. F. DAVIDSON ASSOCIATES
CIVIL ENGINEERS - SURVEYORS - PLANNERS
RIVERSIDE, CALIFORNIA
APPROVED BY Robert W. Lynn DATE 6-20-69
R.E. No. 13699
W.O. 2174 FOR: Spring Brook Park Development F.B. 1005

MARK	REVISIONS	APPR.	DATE
1	Revised Const. Cost Estimate Plan Reduced Project	DW	7-7-69

DESIGNED BY WHA DRAWN BY WHA CHECKED BY

CITY OF RIVERSIDE, CALIFORNIA
DEPARTMENT OF PUBLIC WORKS

APPROVED BY	BY	DATE
UTILITY ENGINEER		
PARK DEPARTMENT		
TRAFFIC DIVISION		
ASSISTANT CITY ENG.		

APPROVED BY
DIRECTOR OF PUBLIC WORKS
DATE 9-11-69

STREET PLAN & PROFILE
TRACT 3940
COLUMBIA AVE
North Side, 296'± East of Orange St. to 706' East
CLARK ST. West Side, from Columbia Ave to 348'± North

HORIZ. SCALE: 1" = 50' VERT. SCALE: 1" = 5'

PROJECT NO. R-1381A
SHEET 1 OF 1
FILE NO. 3364-A