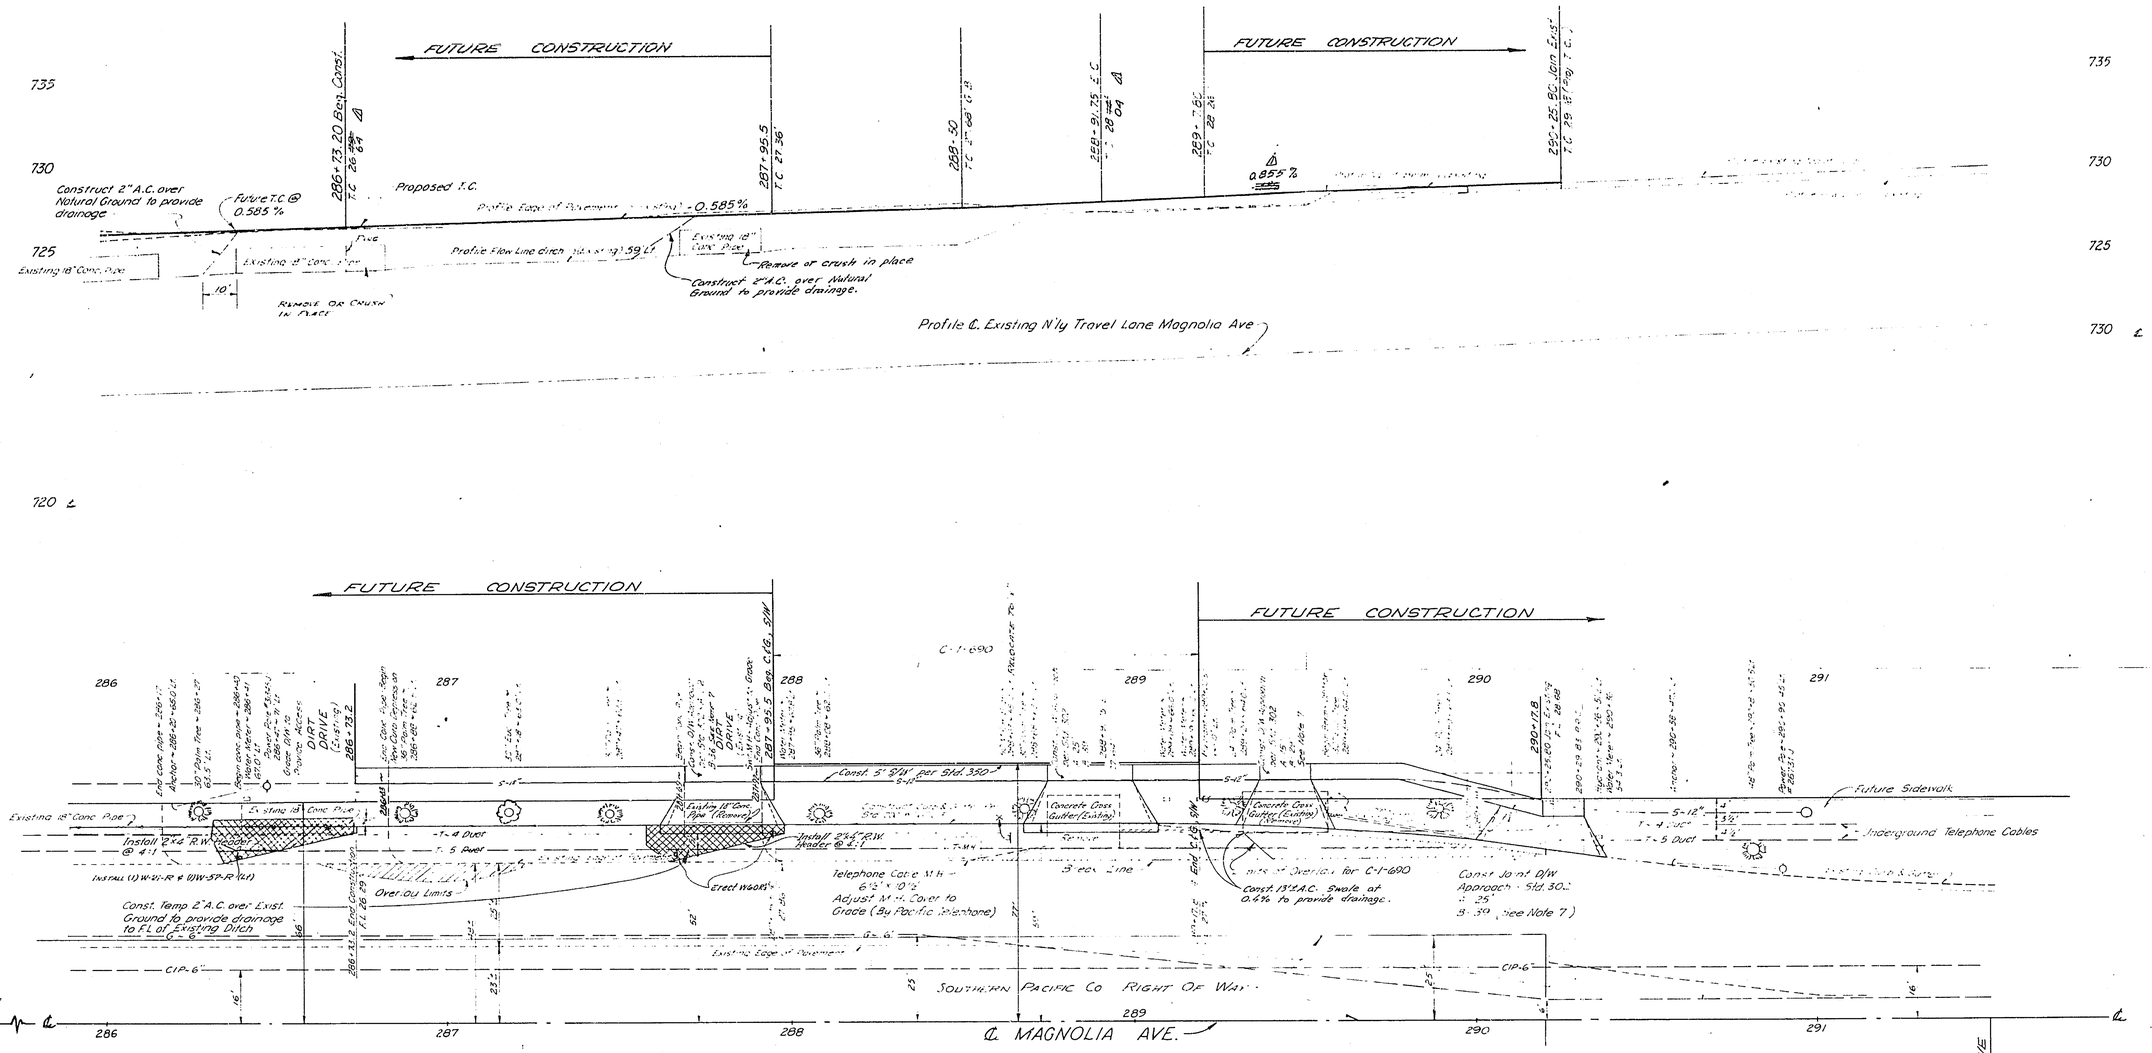

GENERAL NOTES

1. It shall be the responsibility of the contractor to clear the right-of-way in accordance with the provisions of law as it affects each utility including irrigation lines and appurtenances and at no cost to the City.
2. Construction shall be in accordance with the City of Riverside Department of Public Works, Specification No. 461 and Standard Drawings.
3. Prime coat, seal coat and paint binder are required.
4. Trim edge of existing pavement where new paving joins existing pavement to a smooth straight line. Construct match-up paving as shown and overlay paving as directed in the field to produce a smooth crown section. Engineer estimates overlay to be 13 tons.
5. For relocation of existing City irrigation water facility or electric power utility facility to be done by City forces, contact Charles Hare, Water Commercial Engineer, at 787-7442. Schedule about 2 weeks to process a work order before relocation work begins.
6. For relocation of existing domestic water facility, contact Southwest Water Company at 689-4224.
7. Exact location of driveways to be determined at time of construction AND AS APPROVED BY THE TRAFFIC ENGINEER.

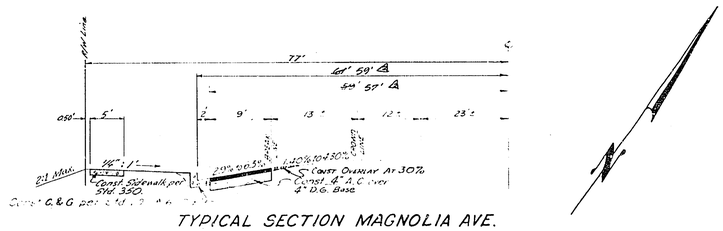

TYPICAL SECTION MAGNOLIA AVE.
STA. 286+73.2 To STA. 288+91.75

CURB CONSTRUCTION CURVE DATA
Δ: 7° 39' 29"
R: 1000.00'
L: 133.66'
T: 66.93'

TOTAL CURB CURVE DATA
Δ: 7° 54' 14"
R: 1000.00'
L: 137.49'
T: 68.94'

—CAUTION—
PACIFIC TELEPHONE
CABLES UNDERGROUND
BEFORE EXCAVATING
CALL COLLECT:

	7:30 A.M. to 5 P.M.	After Hours & Holidays
Orange County	714-633-0811	714-547-6606
Riverside County	714-684-0071	714-547-6606
Inyo County	714-684-0071	714-547-6606
San Bernardino County	714-684-0071	714-547-6606
Los Angeles County	213-621-3111	24 HOUR SERVICE
Ventura County	213-621-3111	
San Diego County	714-298-0595	714-232-0027

FOR FREE CABLE LOCATING SERVICE

BM Elev 728.23 N&T At N.E. Corner Conc. Block Planter At Magnolia Drive - In Theatre Marquee C.R.F.B. 736/20

J. F. DAVIDSON ASSOCIATES
CIVIL ENGINEERS · SURVEYORS · PLANNERS
RIVERSIDE, CALIFORNIA
APPROVED BY [illegible] DATE 5-4-71
R.E. No. [illegible]
W.O. 2299 FOR: Rod Gerold F.B. 10.6

MARK	REVISIONS	APPR.	DATE
Δ	Corrected Error in Section	[illegible]	8-16-71
Δ	Rev. TC Slope & Ex. R/W	[illegible]	8-2-71

DESIGNED BY A.W. DRAWN BY W.W. CHECKED BY JA

CITY OF RIVERSIDE, CALIFORNIA
DEPARTMENT OF PUBLIC WORKS

APPROVED BY	BY	DATE
OFFICE ENGINEER	[illegible]	7-10
PARK DEPARTMENT	[illegible]	[illegible]
TRAFFIC DIVISION	[illegible]	[illegible]
ASSISTANT CITY ENG.	[illegible]	8/16

APPROVED BY William E. Harbour
DIRECTOR OF PUBLIC WORKS
DATE 8/15/71

STREET PLAN & PROFILE
C-1-690
MAGNOLIA AVENUE
N'ly. Side 600' to 900' E'ly. Nye Ave.
HORIZ. SCALE: 1" = 20' VERT. SCALE: 1" = 4'

PROJECT NO. R-1388
SHEET 1 OF 1
FILE NO. 3368