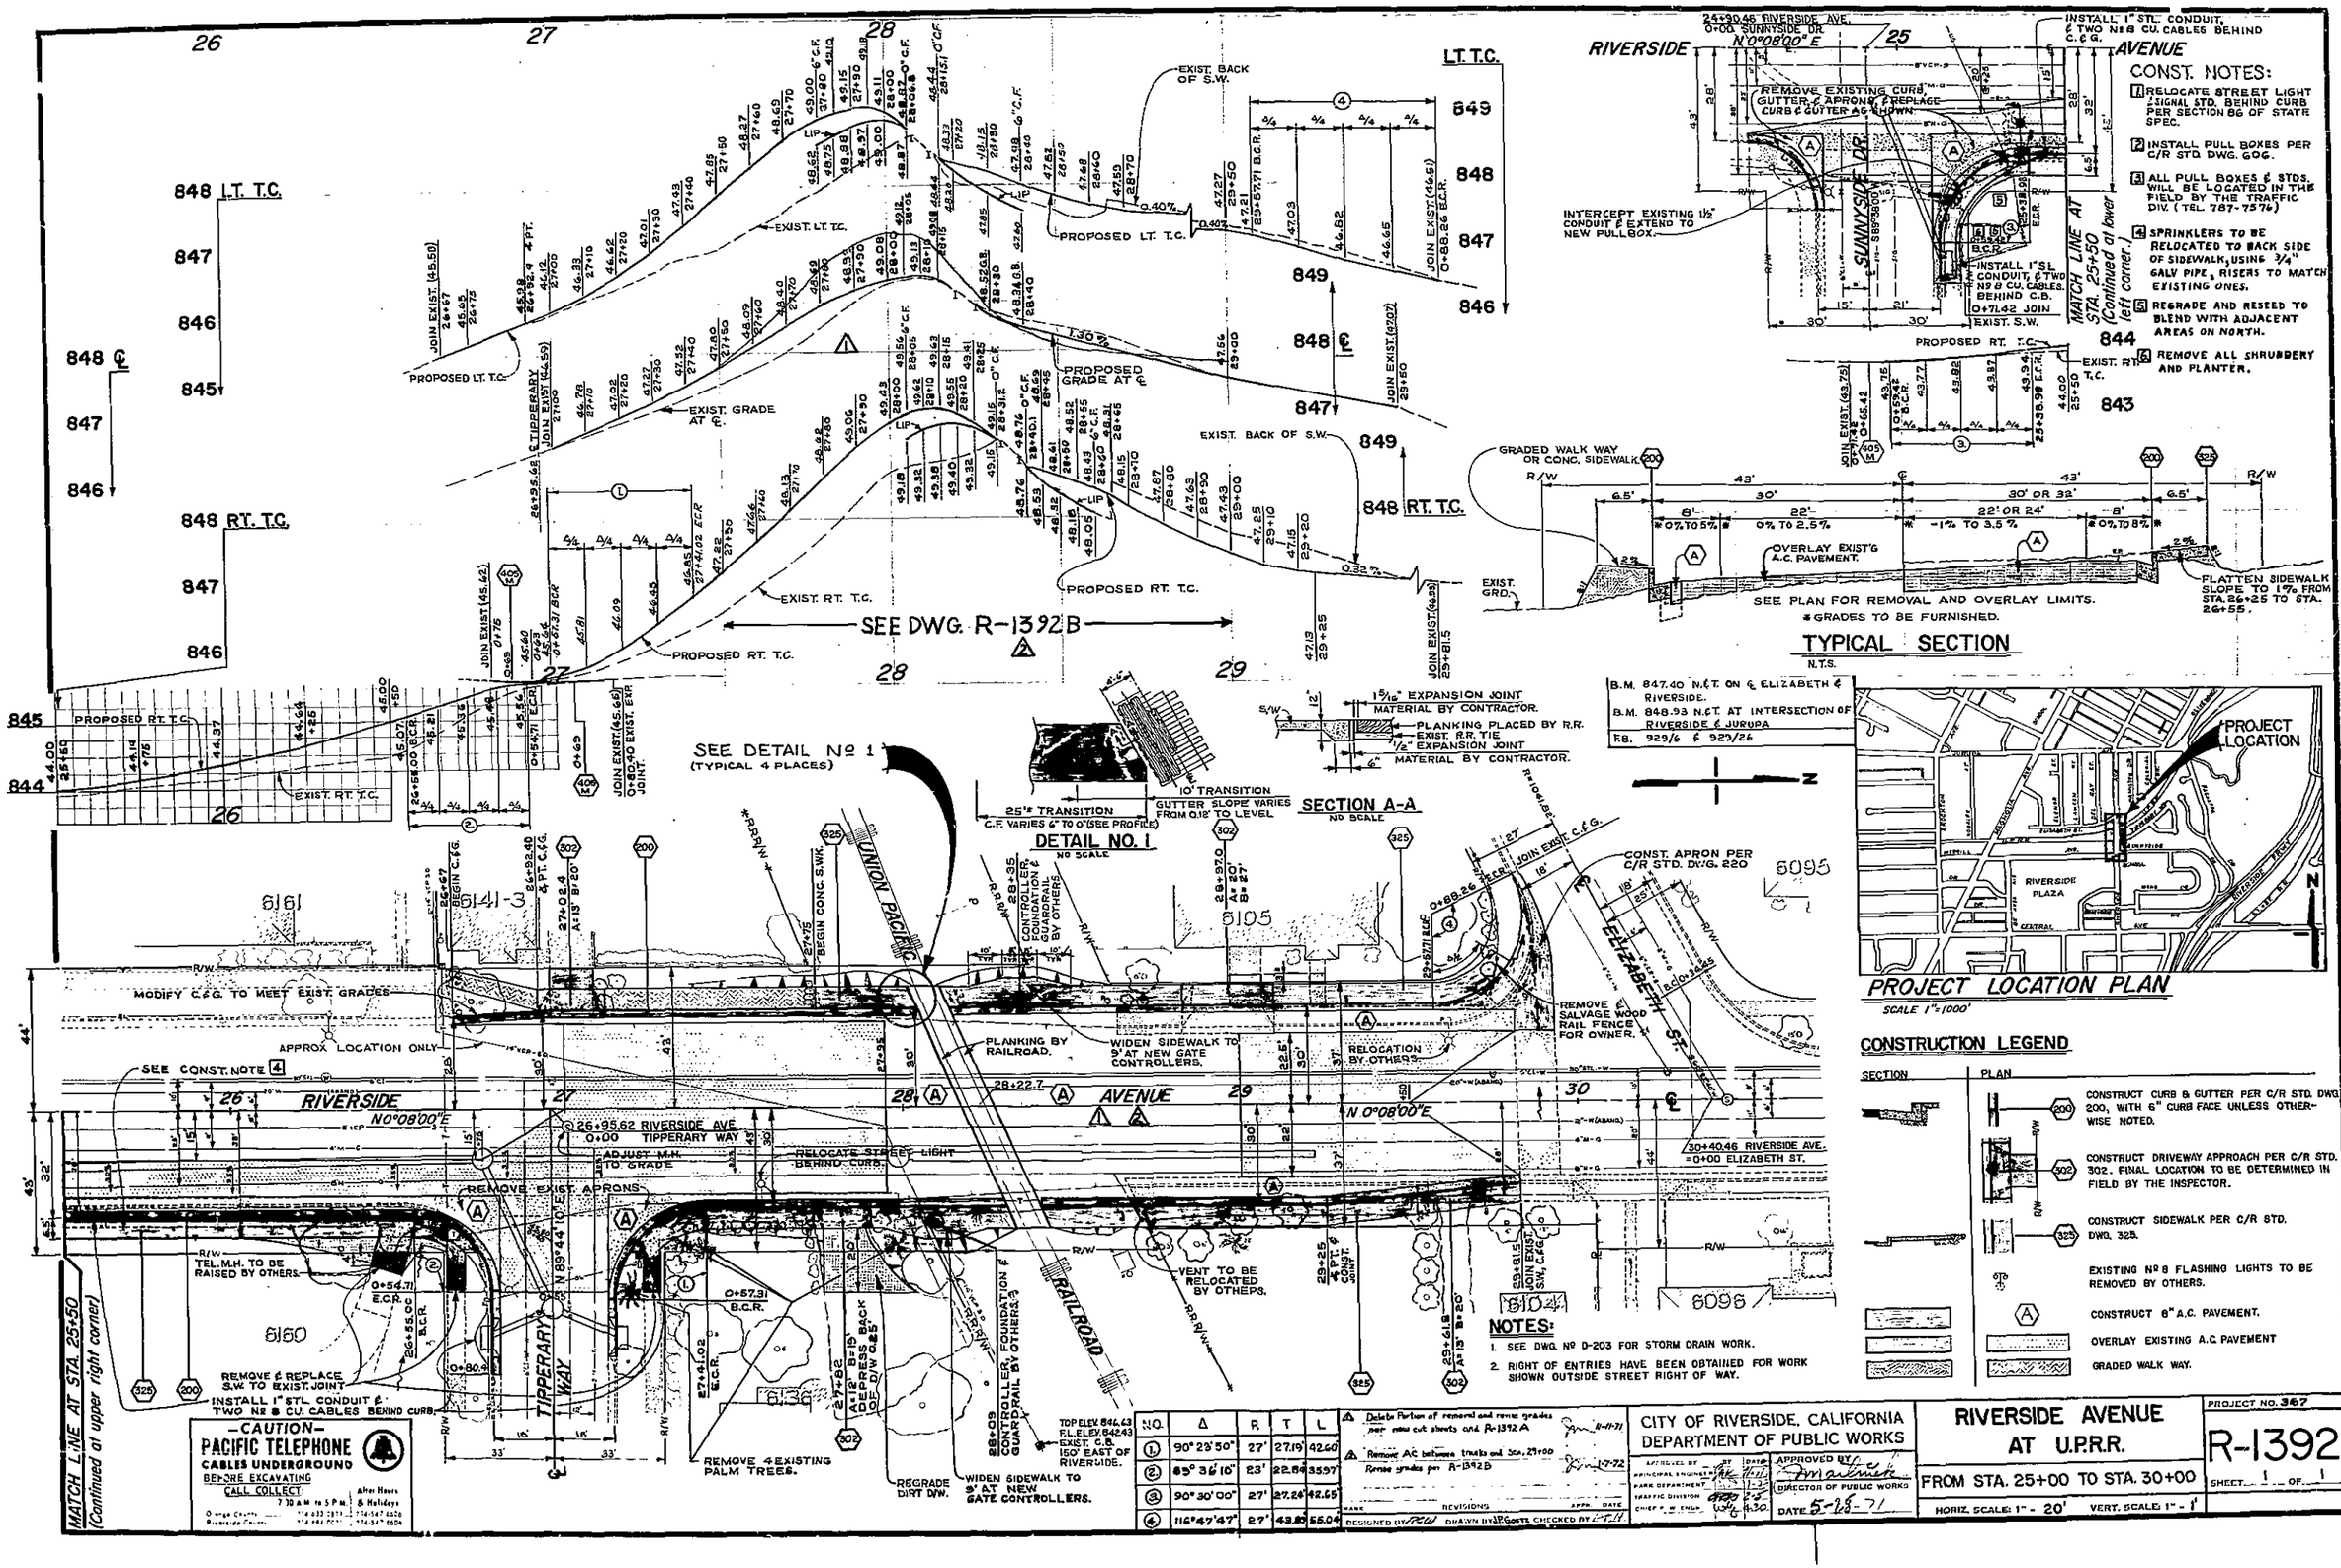

NO.	Δ	R	T	L
1	90° 22' 50"	27'	27.19'	42.60'
2	85° 36' 10"	23'	22.84'	35.97'
3	90° 30' 00"	27'	27.24'	42.65'
4	116° 47' 47"	27'	43.83'	55.04'