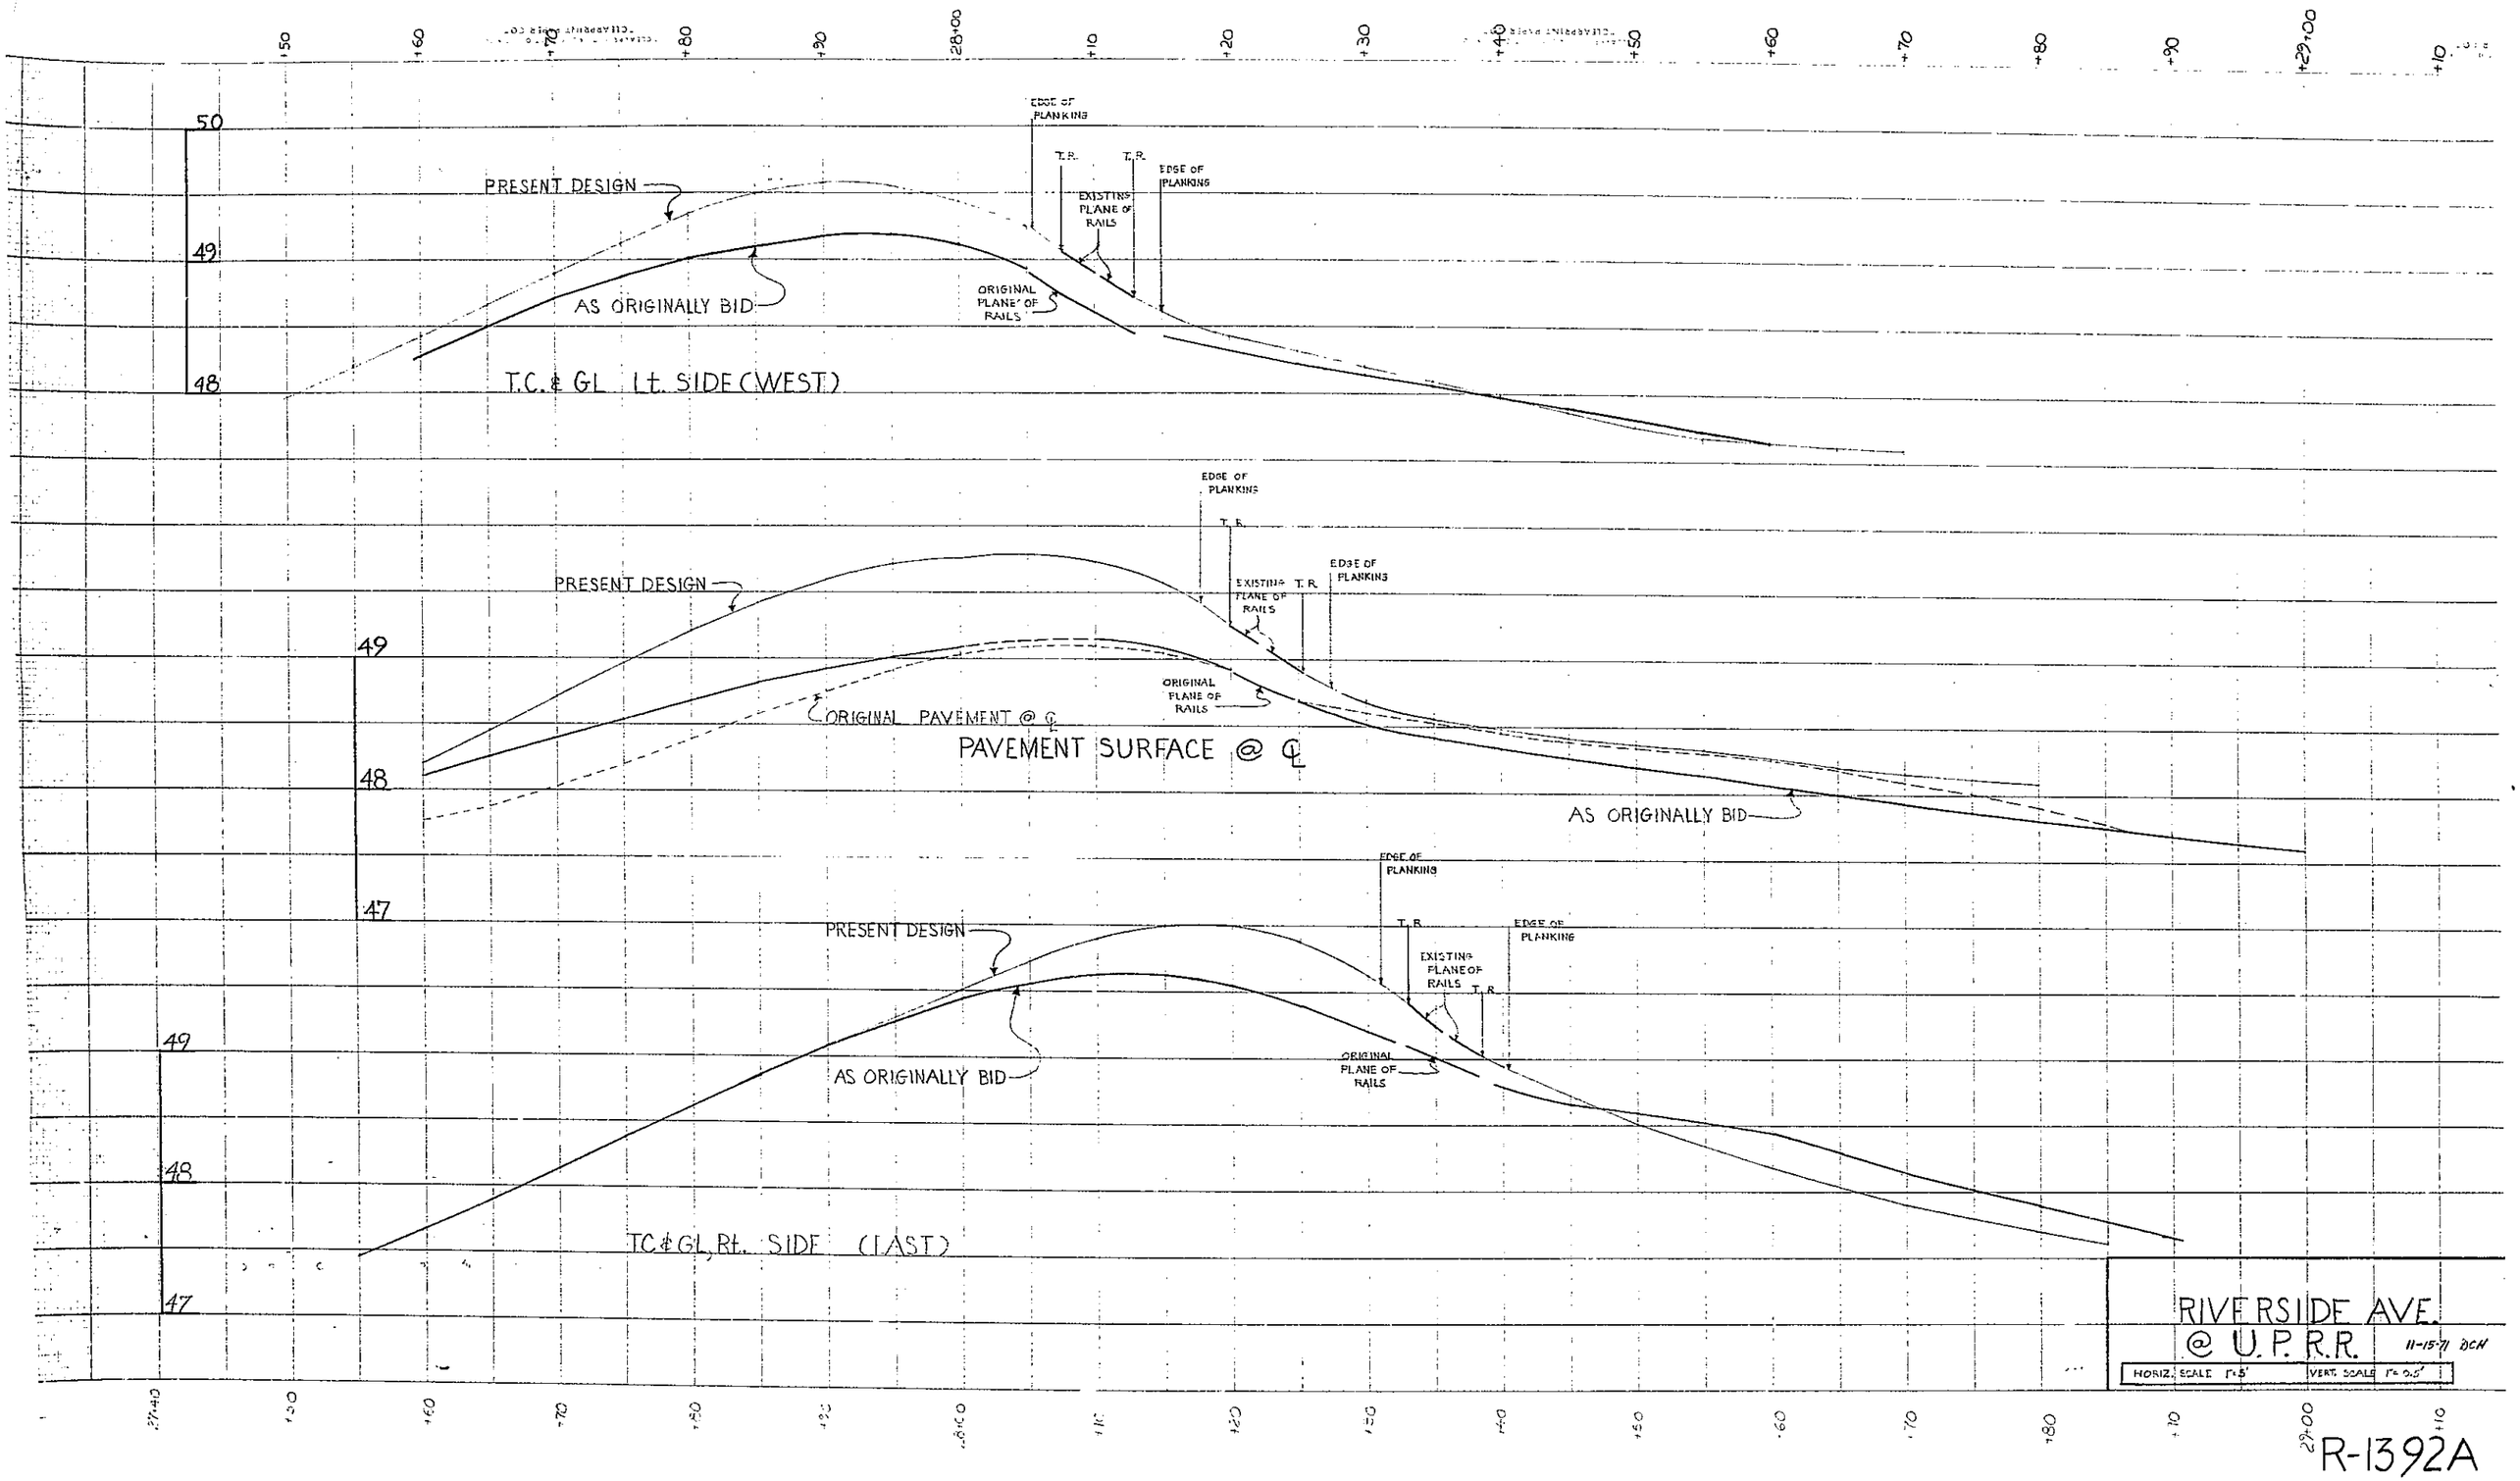
PRESENT DESIGN
AS ORIGINALLY BID
EDGE OF PLANKING
T.R.
EXISTING PLANE OF RAILS
ORIGINAL PLANE OF RAILS
T.C. & GL Lt. SIDE (WEST)
ORIGINAL PAVEMENT @ ℄
PAVEMENT SURFACE @ ℄
TC & GL, Rt. SIDE (EAST)
RIVERSIDE AVE.
@ U.P.R.R.
11-15-71 DCH
HORIZ. SCALE 1"=5'
VERT. SCALE 1"=0.5'

R-1392A