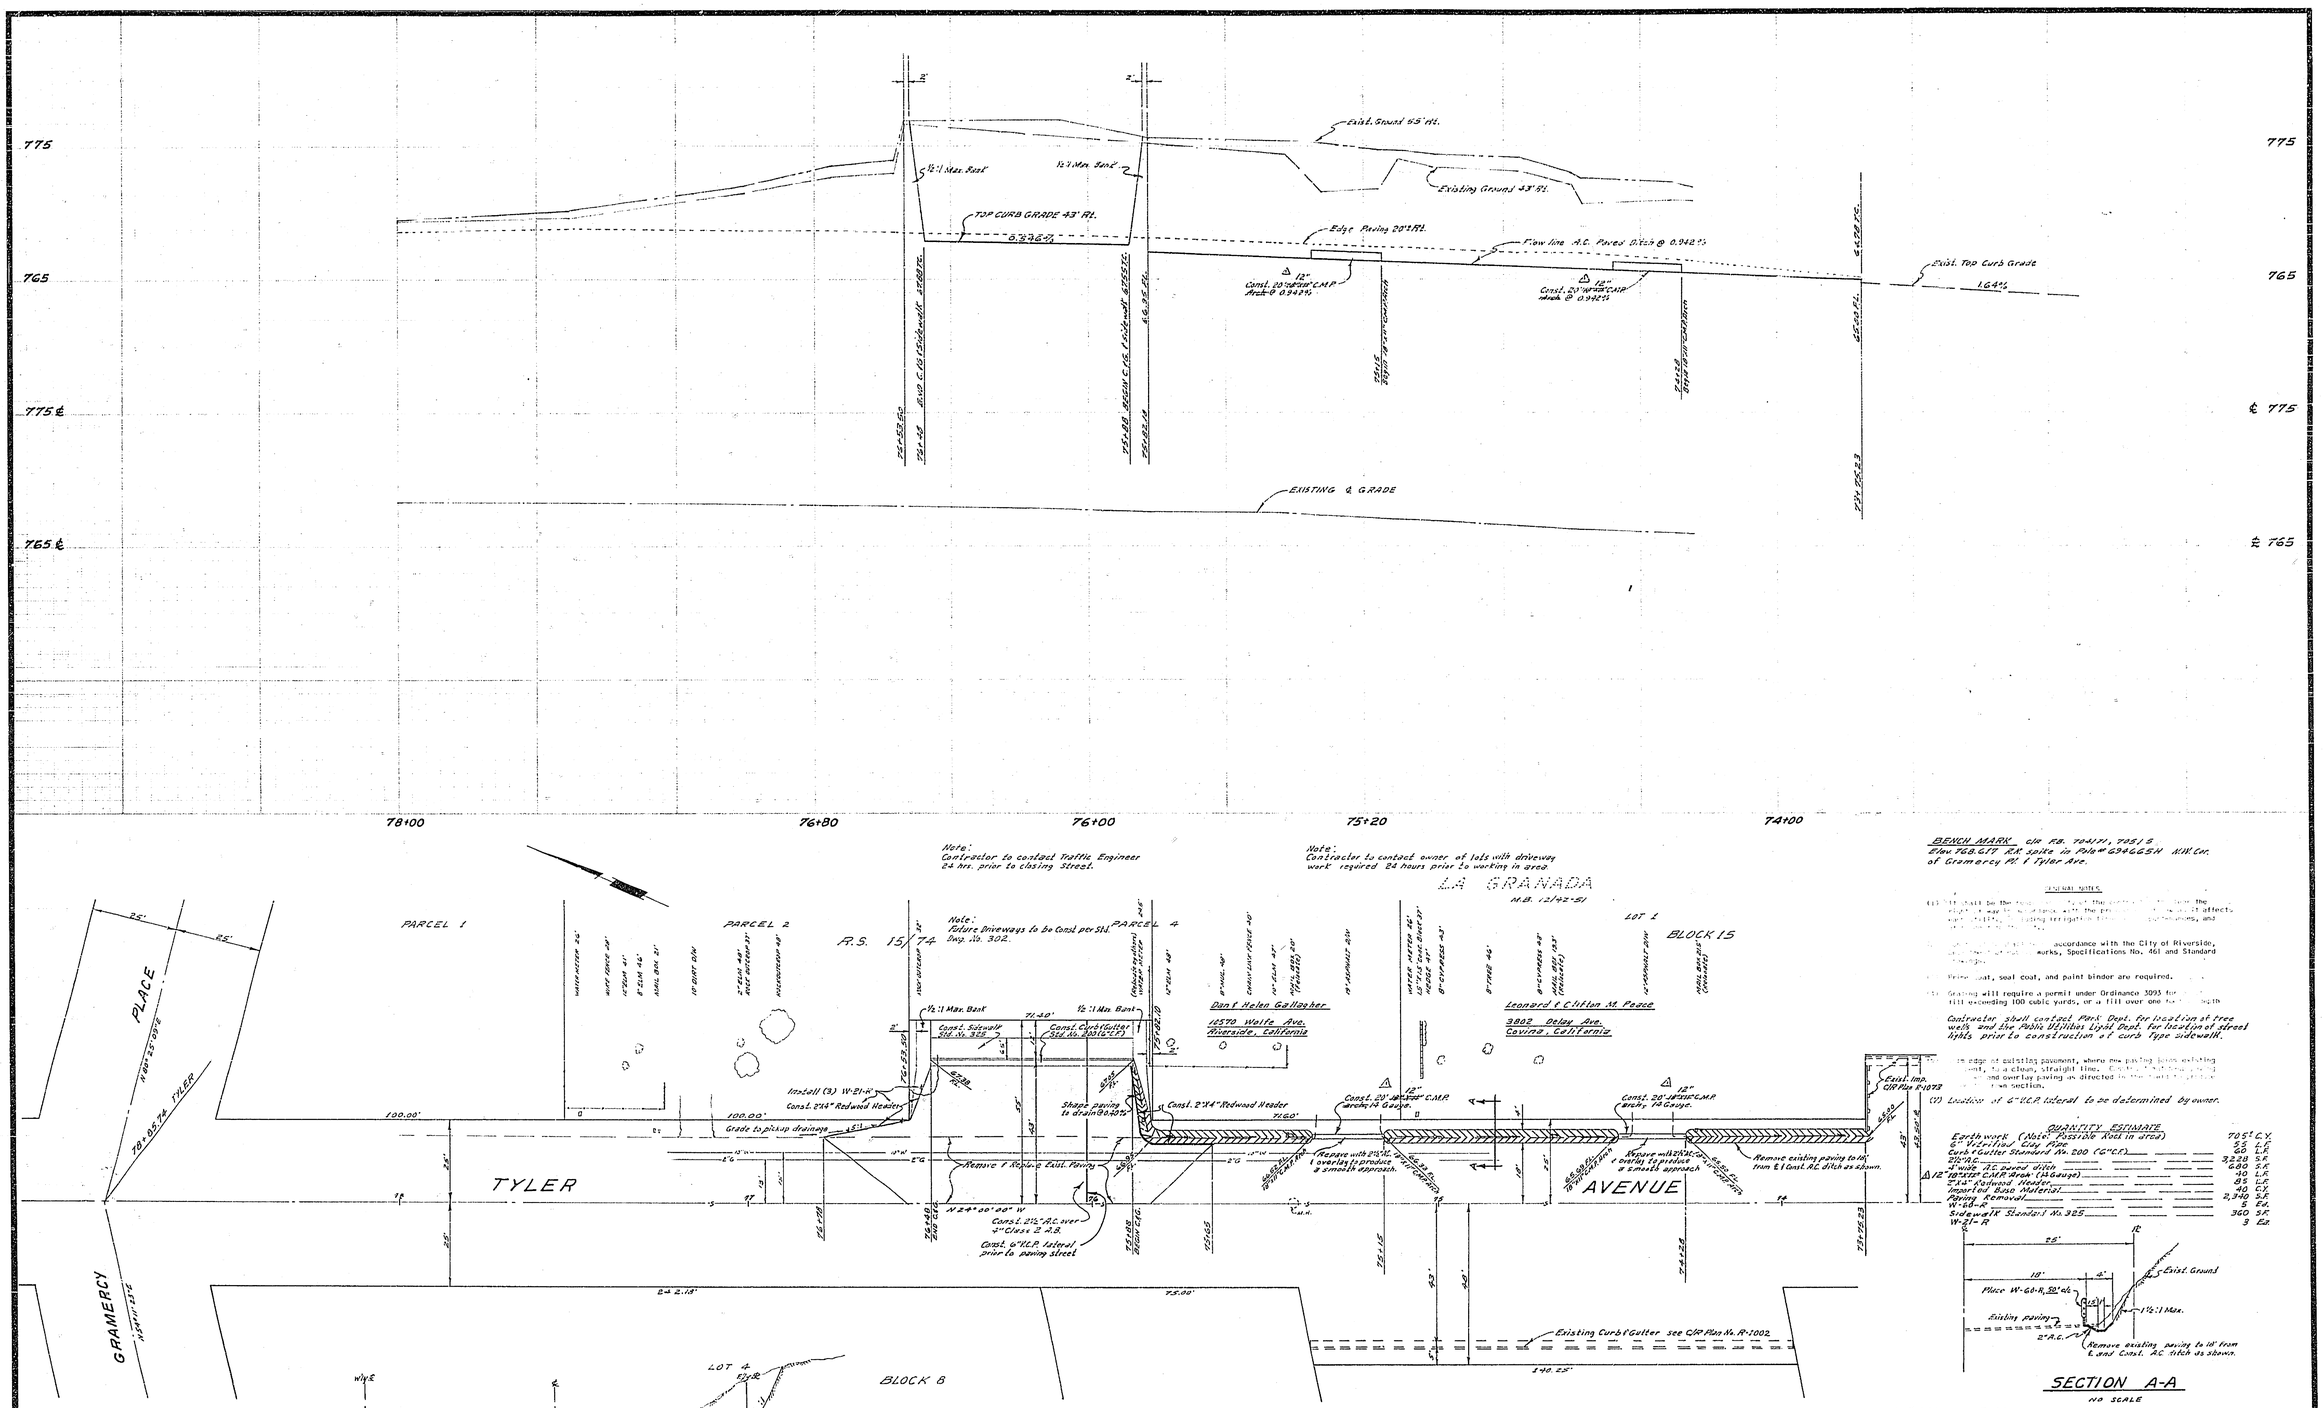

ALBERT A. WEBB ASSOCIATES
CIVIL ENGINEERS
RIVERSIDE, CALIFORNIA

APPROVED BY Robert H. Webb DATE 2/21/68

R.E. No. 9876

W.O. 67-134 FOR: Clarence Pallenger F.D. 649

MARK	REVISIONS	APPR.	DATE
1	Revised 18"x11" C.M.P. to 12" C.M.P. Size not specified. Grade to be 1.64%		
2	Revised Curb & Gutter Std. No. 200 (C.G.F.)		

DESIGNED BY B.E.L. DRAWN BY B.E.L. CHECKED BY R.G.L.

CITY OF RIVERSIDE, CALIFORNIA
DEPARTMENT OF PUBLIC WORKS

APPROVED BY	BY	DATE
OFFICE ENGINEER		6-12
PARK DEPARTMENT		
TRAFFIC DIVISION		6-11
ASSISTANT CITY ENG.		6-13

APPROVED BY William D. Anderson
DIRECTOR OF PUBLIC WORKS
DATE 12/26/69

STREET PLAN & PROFILE
TYLER AVENUE
EAST SIDE, 700'± N/y of HEDRICK AVE.
R=59-667

HORIZ. SCALE: 1" = 20' VERT. SCALE: 1" = 5'

PROJECT NO. R-1397
SHEET 1 OF 1
FILE NO. 67-134-A