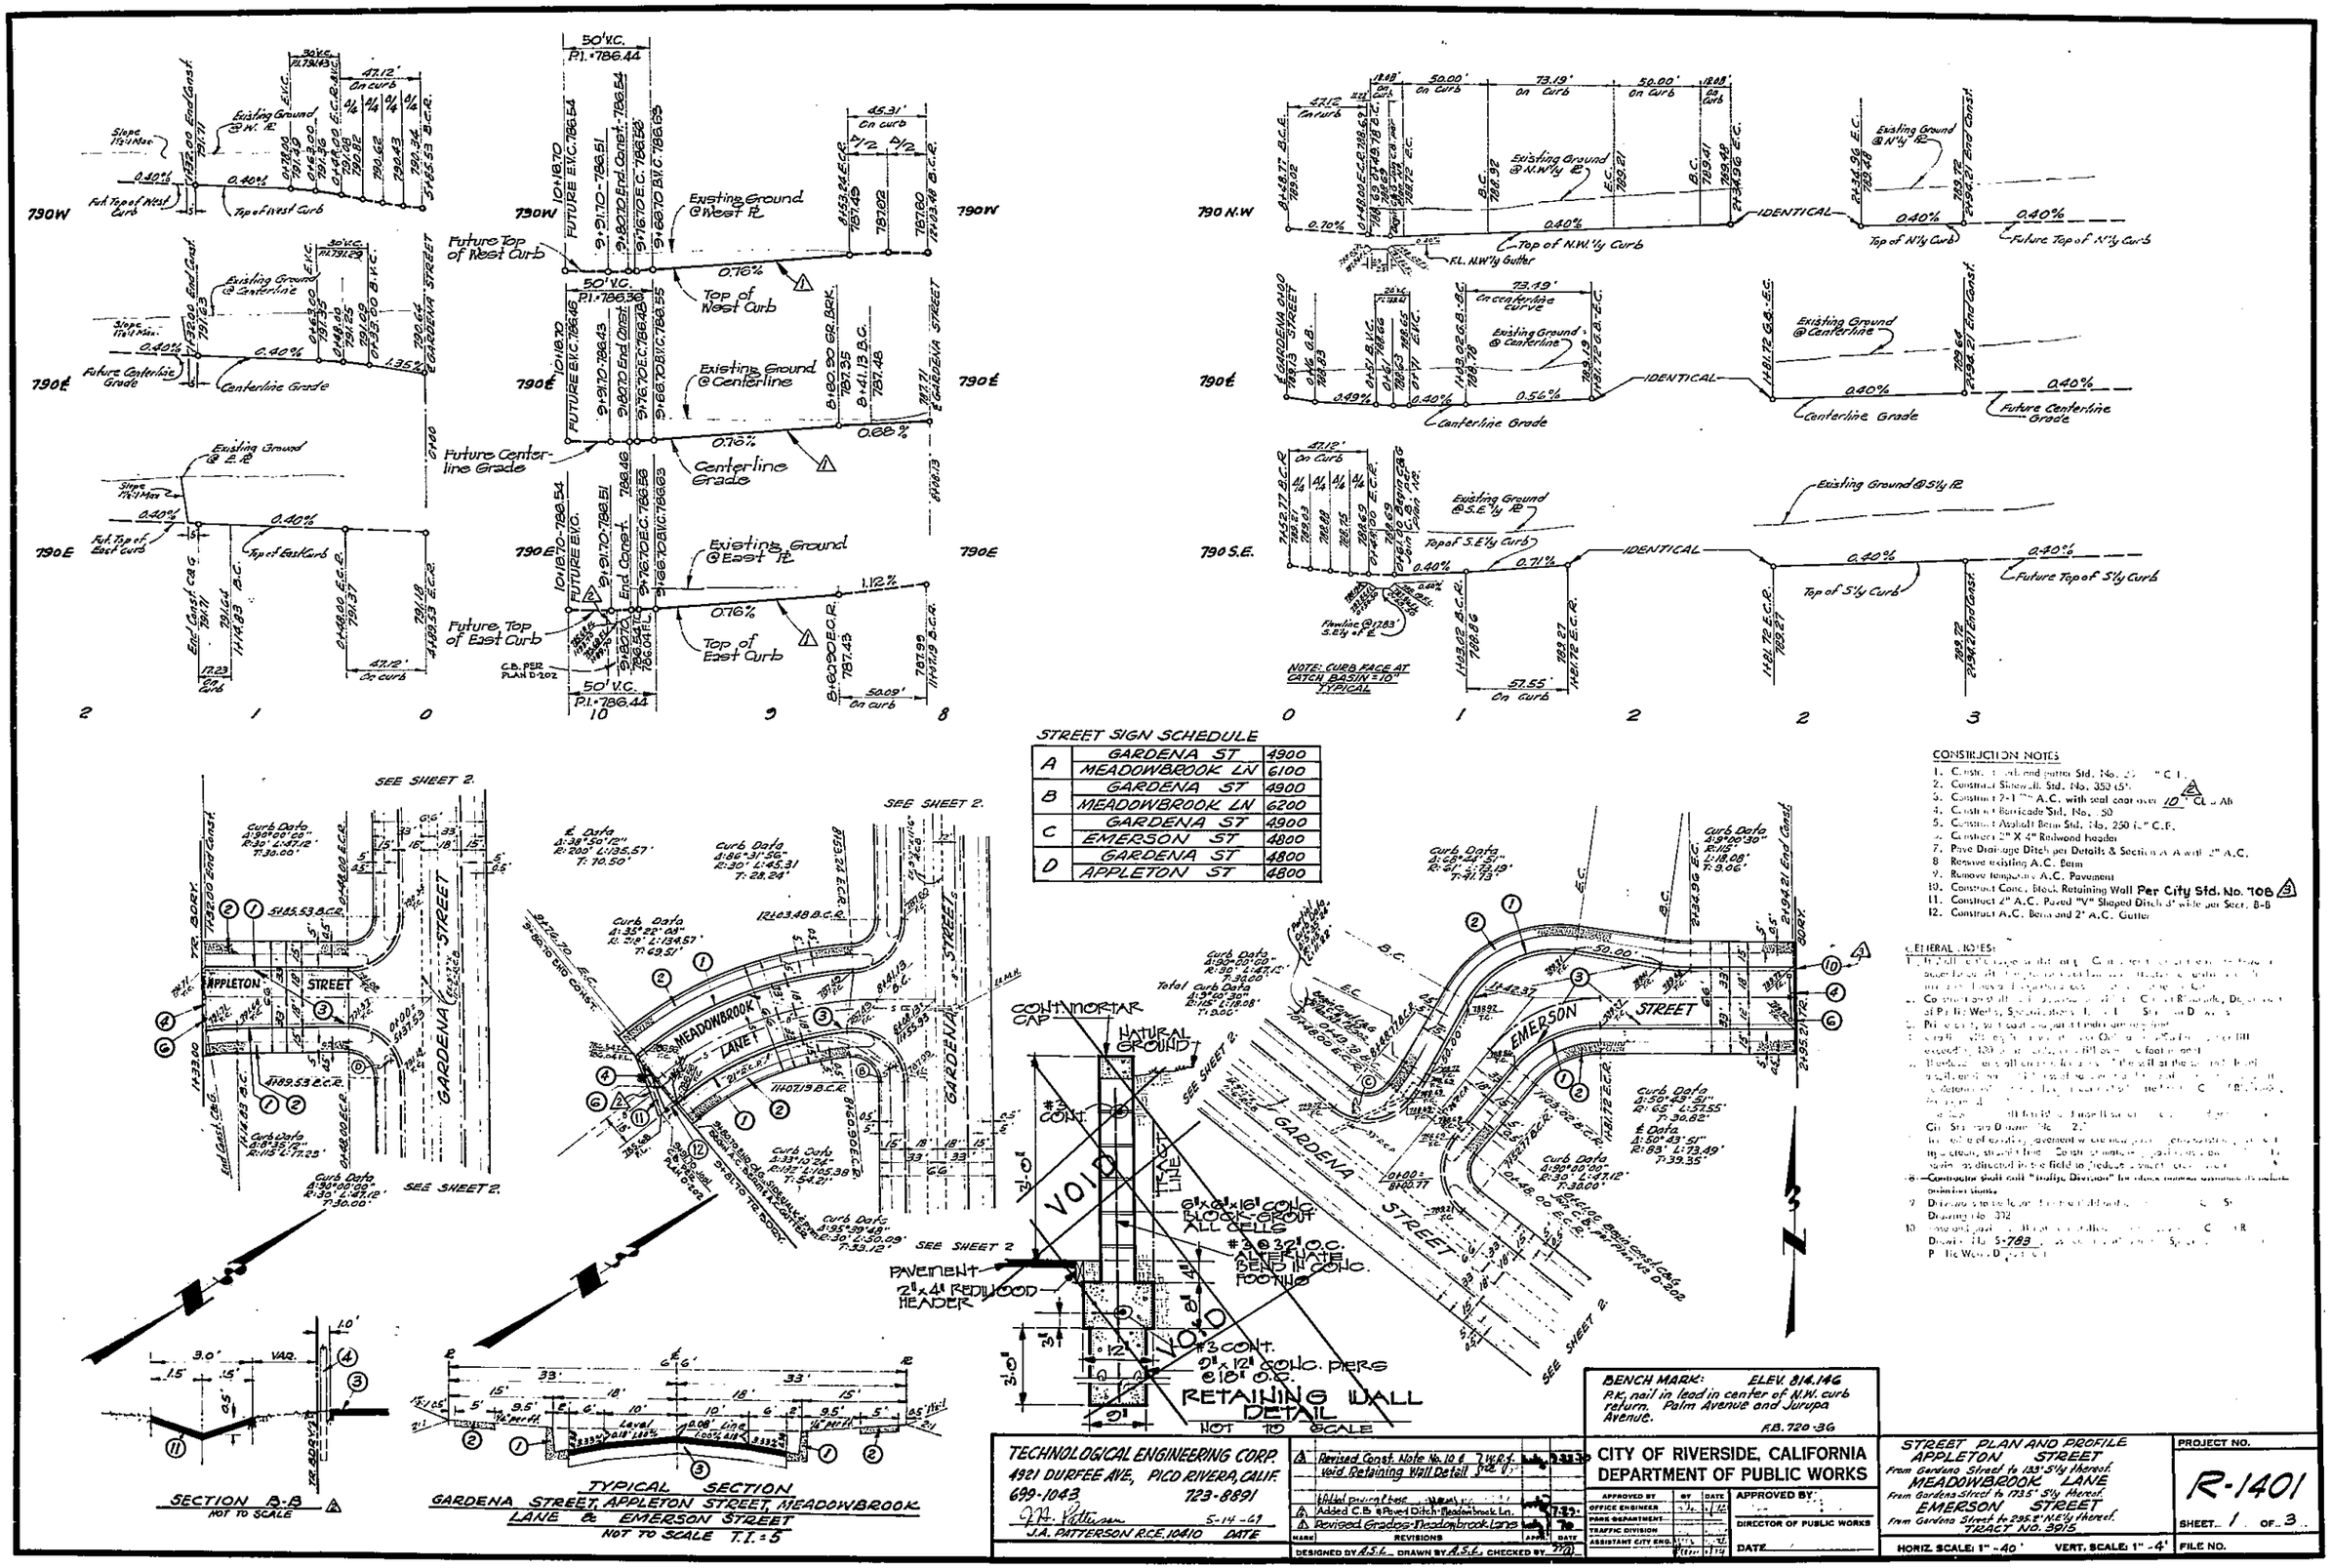

STREET SIGN SCHEDULE

A	GARDENA ST	4900
	MEADOWBROOK LN	6100
B	GARDENA ST	4900
	MEADOWBROOK LN	6200
C	GARDENA ST	4900
	EMERSON ST	4800
D	GARDENA ST	4800
	APPLETON ST	4800

CONSTRUCTION NOTES

1. Construct [illegible] and gutter Std. No. [illegible] C.I.
2. Construct Sidewalk Std. No. 350 (5')
3. Construct 2-1 [illegible] A.C. with seal coat over 10" CL [illegible] AB
4. Construct Barricade Std. No. 50
5. Construct Asphalt Berm Std. No. 250 [illegible] C.F.
6. Construct 2" X 4" Redwood header
7. Pave Drainage Ditch per Details & Section A-A with 2" A.C.
8. Remove existing A.C. Berm
9. Remove temporary A.C. Pavement
10. Construct Conc. Block Retaining Wall Per City Std. No. 708
11. Construct 2" A.C. Paved "V" Shaped Ditch 3' wide per Sect. B-B
12. Construct A.C. Berm and 2" A.C. Gutter

GENERAL NOTES:

[illegible]

BENCH MARK: ELEV. 814.146
P.K. nail in lead in center of N.W. curb return. Palm Avenue and Jurupa Avenue.
F.B. 720-36

TECHNOLOGICAL ENGINEERING CORP.
4921 DURFEE AVE., PICO RIVERA, CALIF.
699-1043 723-8891
J.A. Patterson 5-14-69
J.A. PATTERSON R.C.E. 10410 DATE

MARK	REVISIONS	APPR.	DATE
3	Revised Const. Note No. 10 & Void Retaining Wall Detail		
	Added paving base		
2	Added C.B. & Paved Ditch-Meadowbrook Ln.		7-29-
1	Revised Grades-Meadowbrook Lane		

DESIGNED BY A.S.L. DRAWN BY A.S.L. CHECKED BY

CITY OF RIVERSIDE, CALIFORNIA
DEPARTMENT OF PUBLIC WORKS

APPROVED BY	BY	DATE
OFFICE ENGINEER		
PARK DEPARTMENT		
TRAFFIC DIVISION		
ASSISTANT CITY ENG.		

APPROVED BY:
DIRECTOR OF PUBLIC WORKS
DATE

STREET PLAN AND PROFILE
APPLETON STREET
From Gardena Street to 133' S'ly thereof.
MEADOWBROOK LANE
From Gardena Street to 173.5' S'ly thereof.
EMERSON STREET
From Gardena Street to 295.2' N.E'ly thereof.
TRACT NO. 3915

HORIZ. SCALE: 1" - 40' VERT. SCALE: 1" - 4'

PROJECT NO. R-1401
SHEET 1 OF 3
FILE NO.

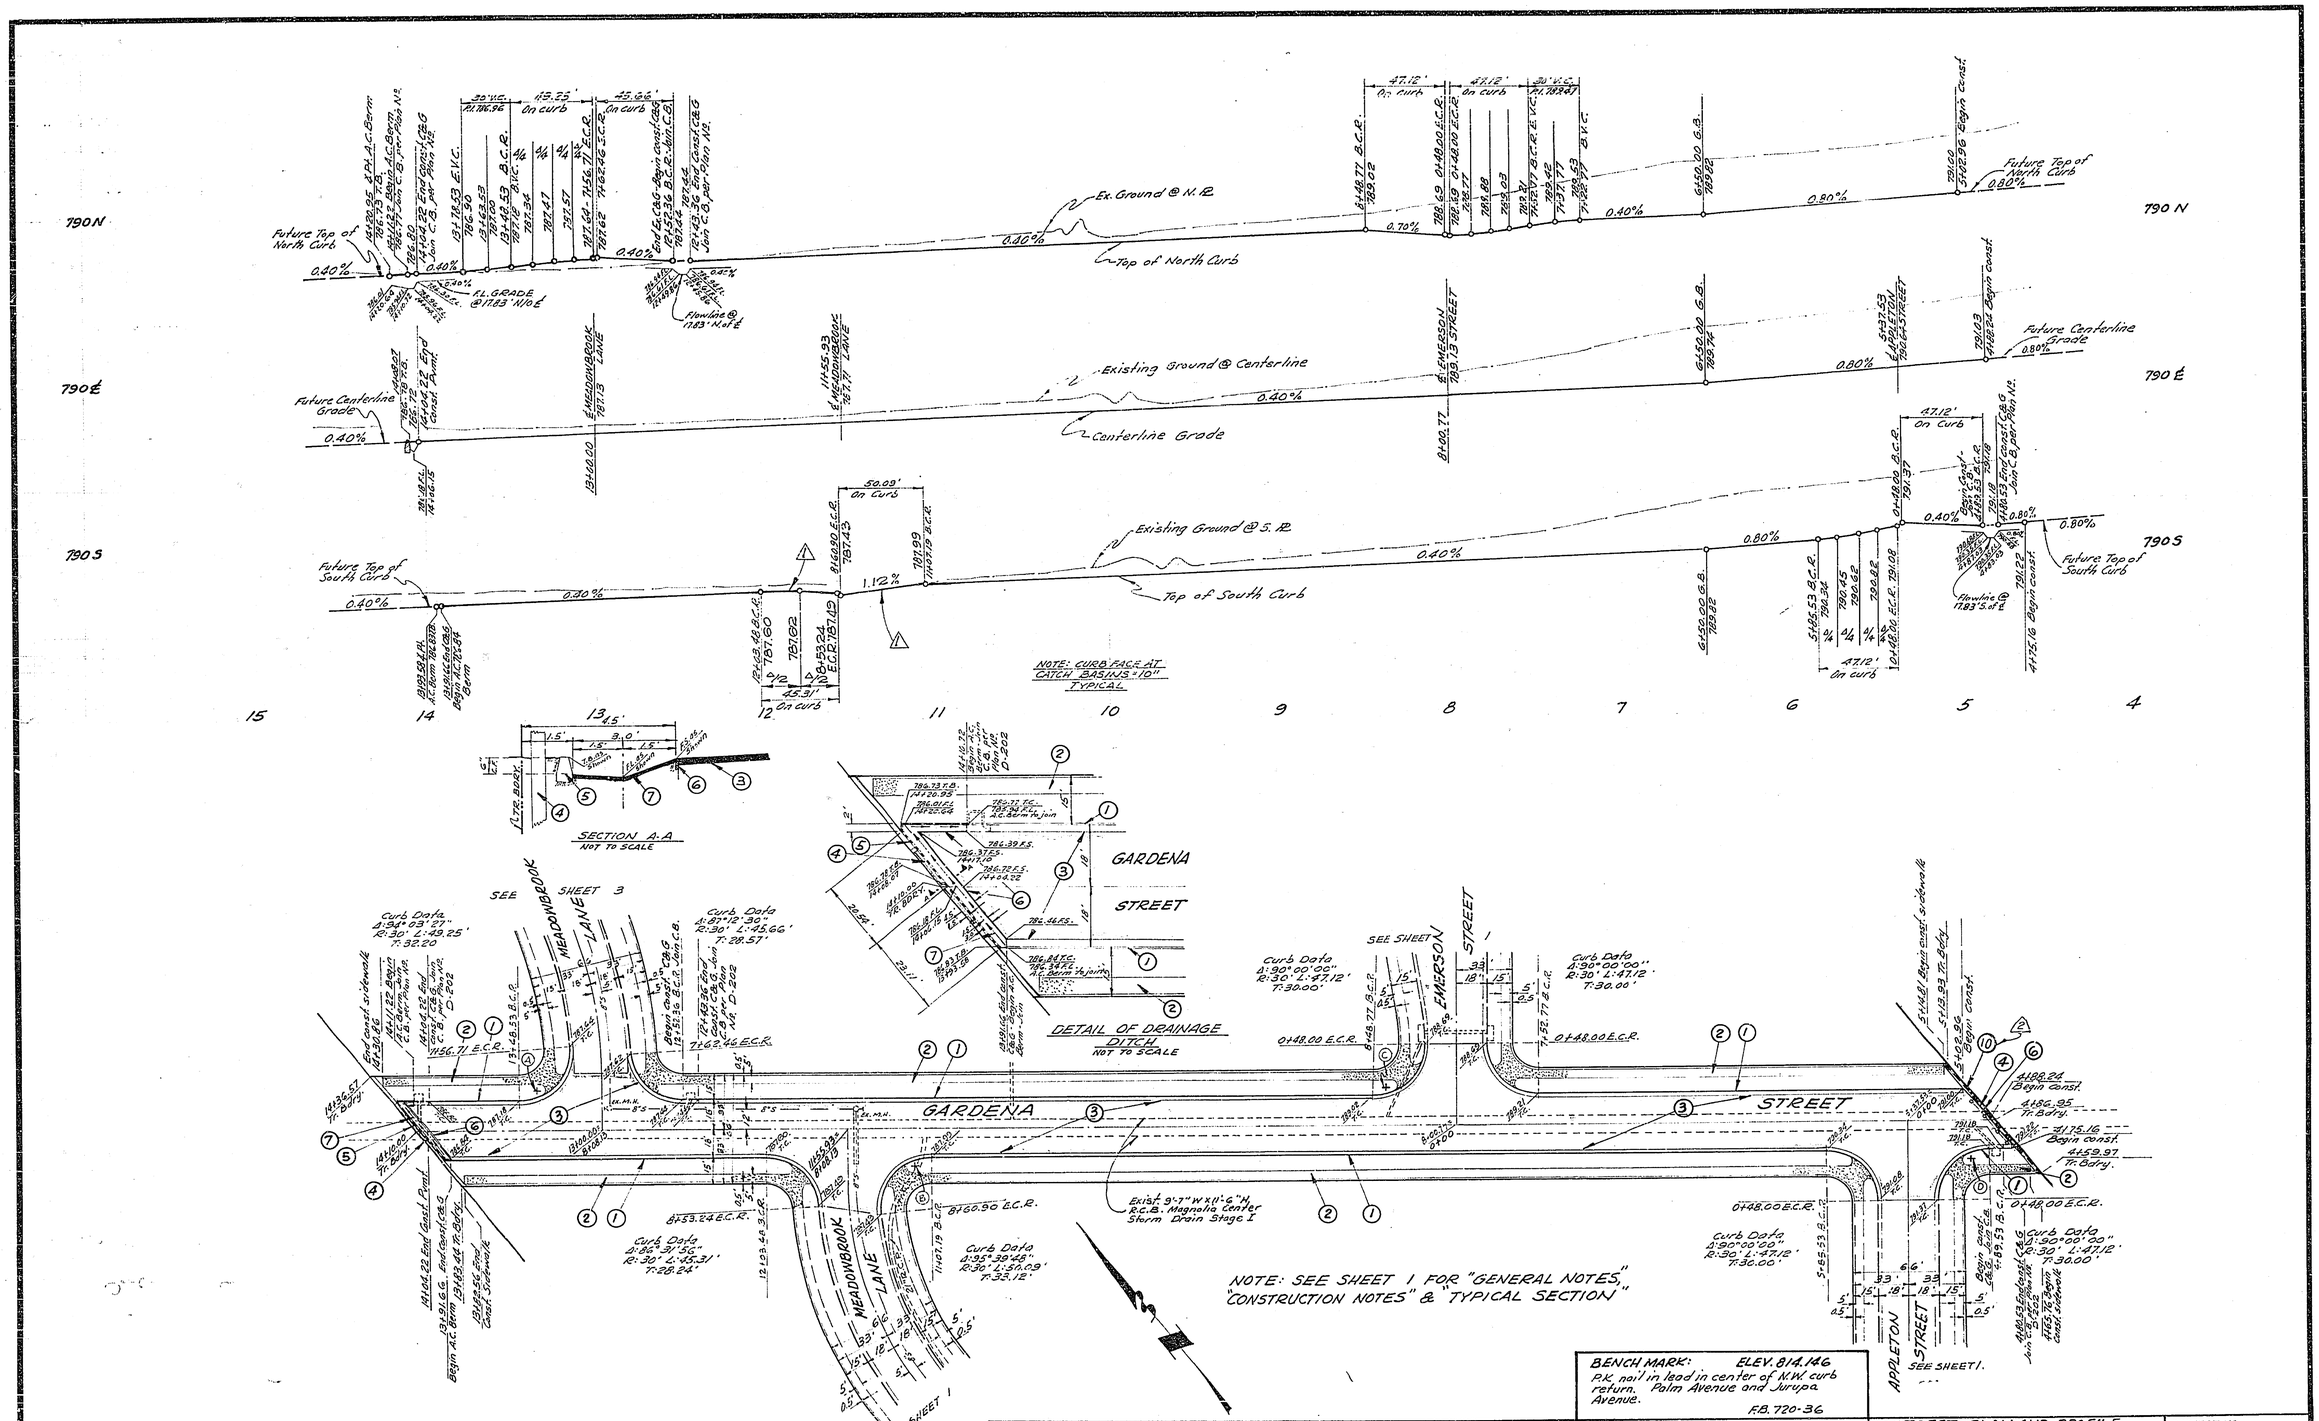

BENCH MARK: ELEV. 814.146
P.K. nail in lead in center of N.W. curb return. Palm Avenue and Jurupa Avenue.
F.B. 720-36

TECHNOLOGICAL ENGINEERING CORP.
4921 DURFEE AVE., PICO RIVERA, CALIF.
699-1043 723-8891
J.A. Patterson 5-14-69
J.A. PATTERSON R.C.E. 10410 DATE

MARK	REVISIONS	APPR.	DATE
2	Revised Const. Note No 10		
1	Revised Grades - Curb Returns		
	Meadowbrook Ln & Gardena St. to Glide		

DESIGNED BY A.S.L. DRAWN BY A.S.L. CHECKED BY

CITY OF RIVERSIDE, CALIFORNIA
DEPARTMENT OF PUBLIC WORKS

APPROVED BY	BY	DATE
OFFICE ENGINEER		
PARK DEPARTMENT		
TRAFFIC DIVISION		
ASSISTANT CITY ENG.		

APPROVED BY
DIRECTOR OF PUBLIC WORKS
DATE

STREET PLAN AND PROFILE
GARDENA STREET
FROM: 136' W'ly of Meadowbrook Lane
TO: 77' E'ly of Appleton Street
TRACT No. 3915

HORIZ. SCALE: 1" = 40' VERT. SCALE: 1" = 4'

PROJECT NO. R-1401
SHEET 2 OF 3
FILE NO.

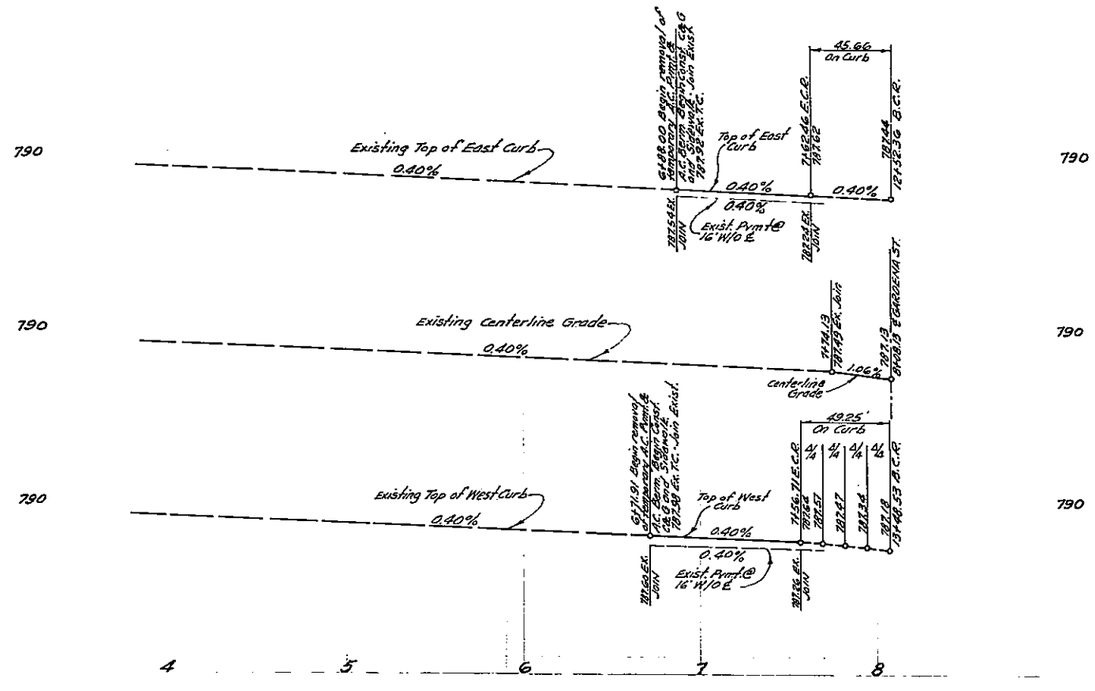

Curb Data 5+60.64 to 7+62.46
Δ: 44°28' 28"
R: 278'
L: 215.79'

Curb Data 6+98.00 to 7+62.46
Δ: 16°24' 21"
R: 270'
L: 79.60'

SEE SHEET 2

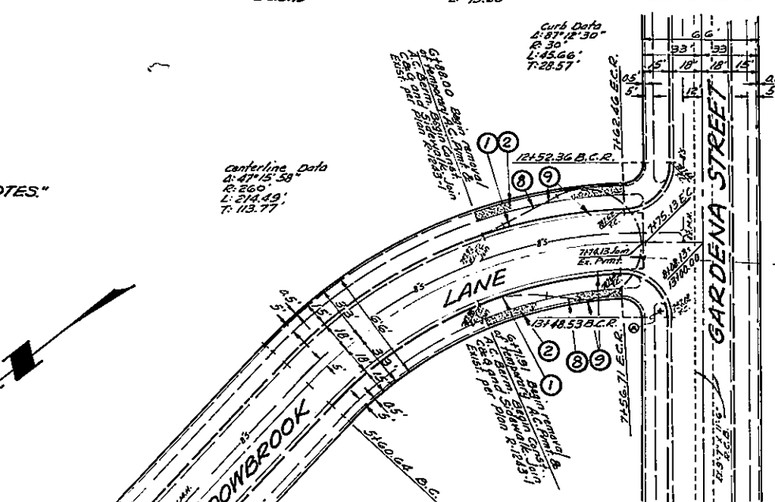

NOTE: SEE SHEET 1 FOR "GENERAL NOTES" & "CONSTRUCTION NOTES."

Note: If temporary turnaround is not constructed pavement should be constructed with this improvement. If temporary turnaround is constructed remove those portions outside edge of gutter & join pavement to gutter.

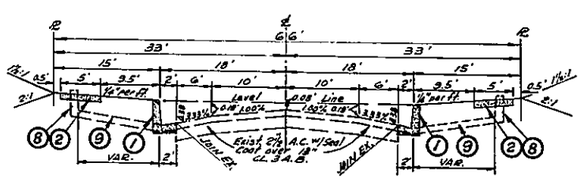

TYPICAL SECTION
MEADOWBROOK LANE
STA. 6+71.91 TO 7+74.13 T.I.=5
NOT TO SCALE

BENCH MARK: ELEV. 814.146
PK nail in lead in center of N.W. curb return, Palm Avenue and Jurupa Avenue.
F.B. 720-36

TECHNOLOGICAL ENGINEERING CORP.
4921 DURFEE AVE, PICO RIVERA, CALIF.
699-1043 723-8891
J.A. Patterson 6-17-69
J.A. PATTERSON R.C.E. 14410 DATE

MARK	REVISIONS	APPR.	DATE

DESIGNED BY A.S.L. DRAWN BY A.S.L. CHECKED BY TTD

CITY OF RIVERSIDE, CALIFORNIA
DEPARTMENT OF PUBLIC WORKS

APPROVED BY	BY	DATE
OFFICE ENGINEER		
PARK DEPARTMENT		
TRAFFIC DIVISION		
ASSISTANT CITY ENG.		

APPROVED BY
DIRECTOR OF PUBLIC WORKS
DATE

STREET PLAN AND PROFILE
MEADOWBROOK LANE
FROM: GARDENA STREET
TO: 136'± N'LY OF GARDENA STREET
TRACT No. 3915

HORIZ. SCALE: 1" 40' VERT. SCALE: 1" - 4'

PROJECT NO. R-1401
SHEET 3 OF 3
FILE NO.