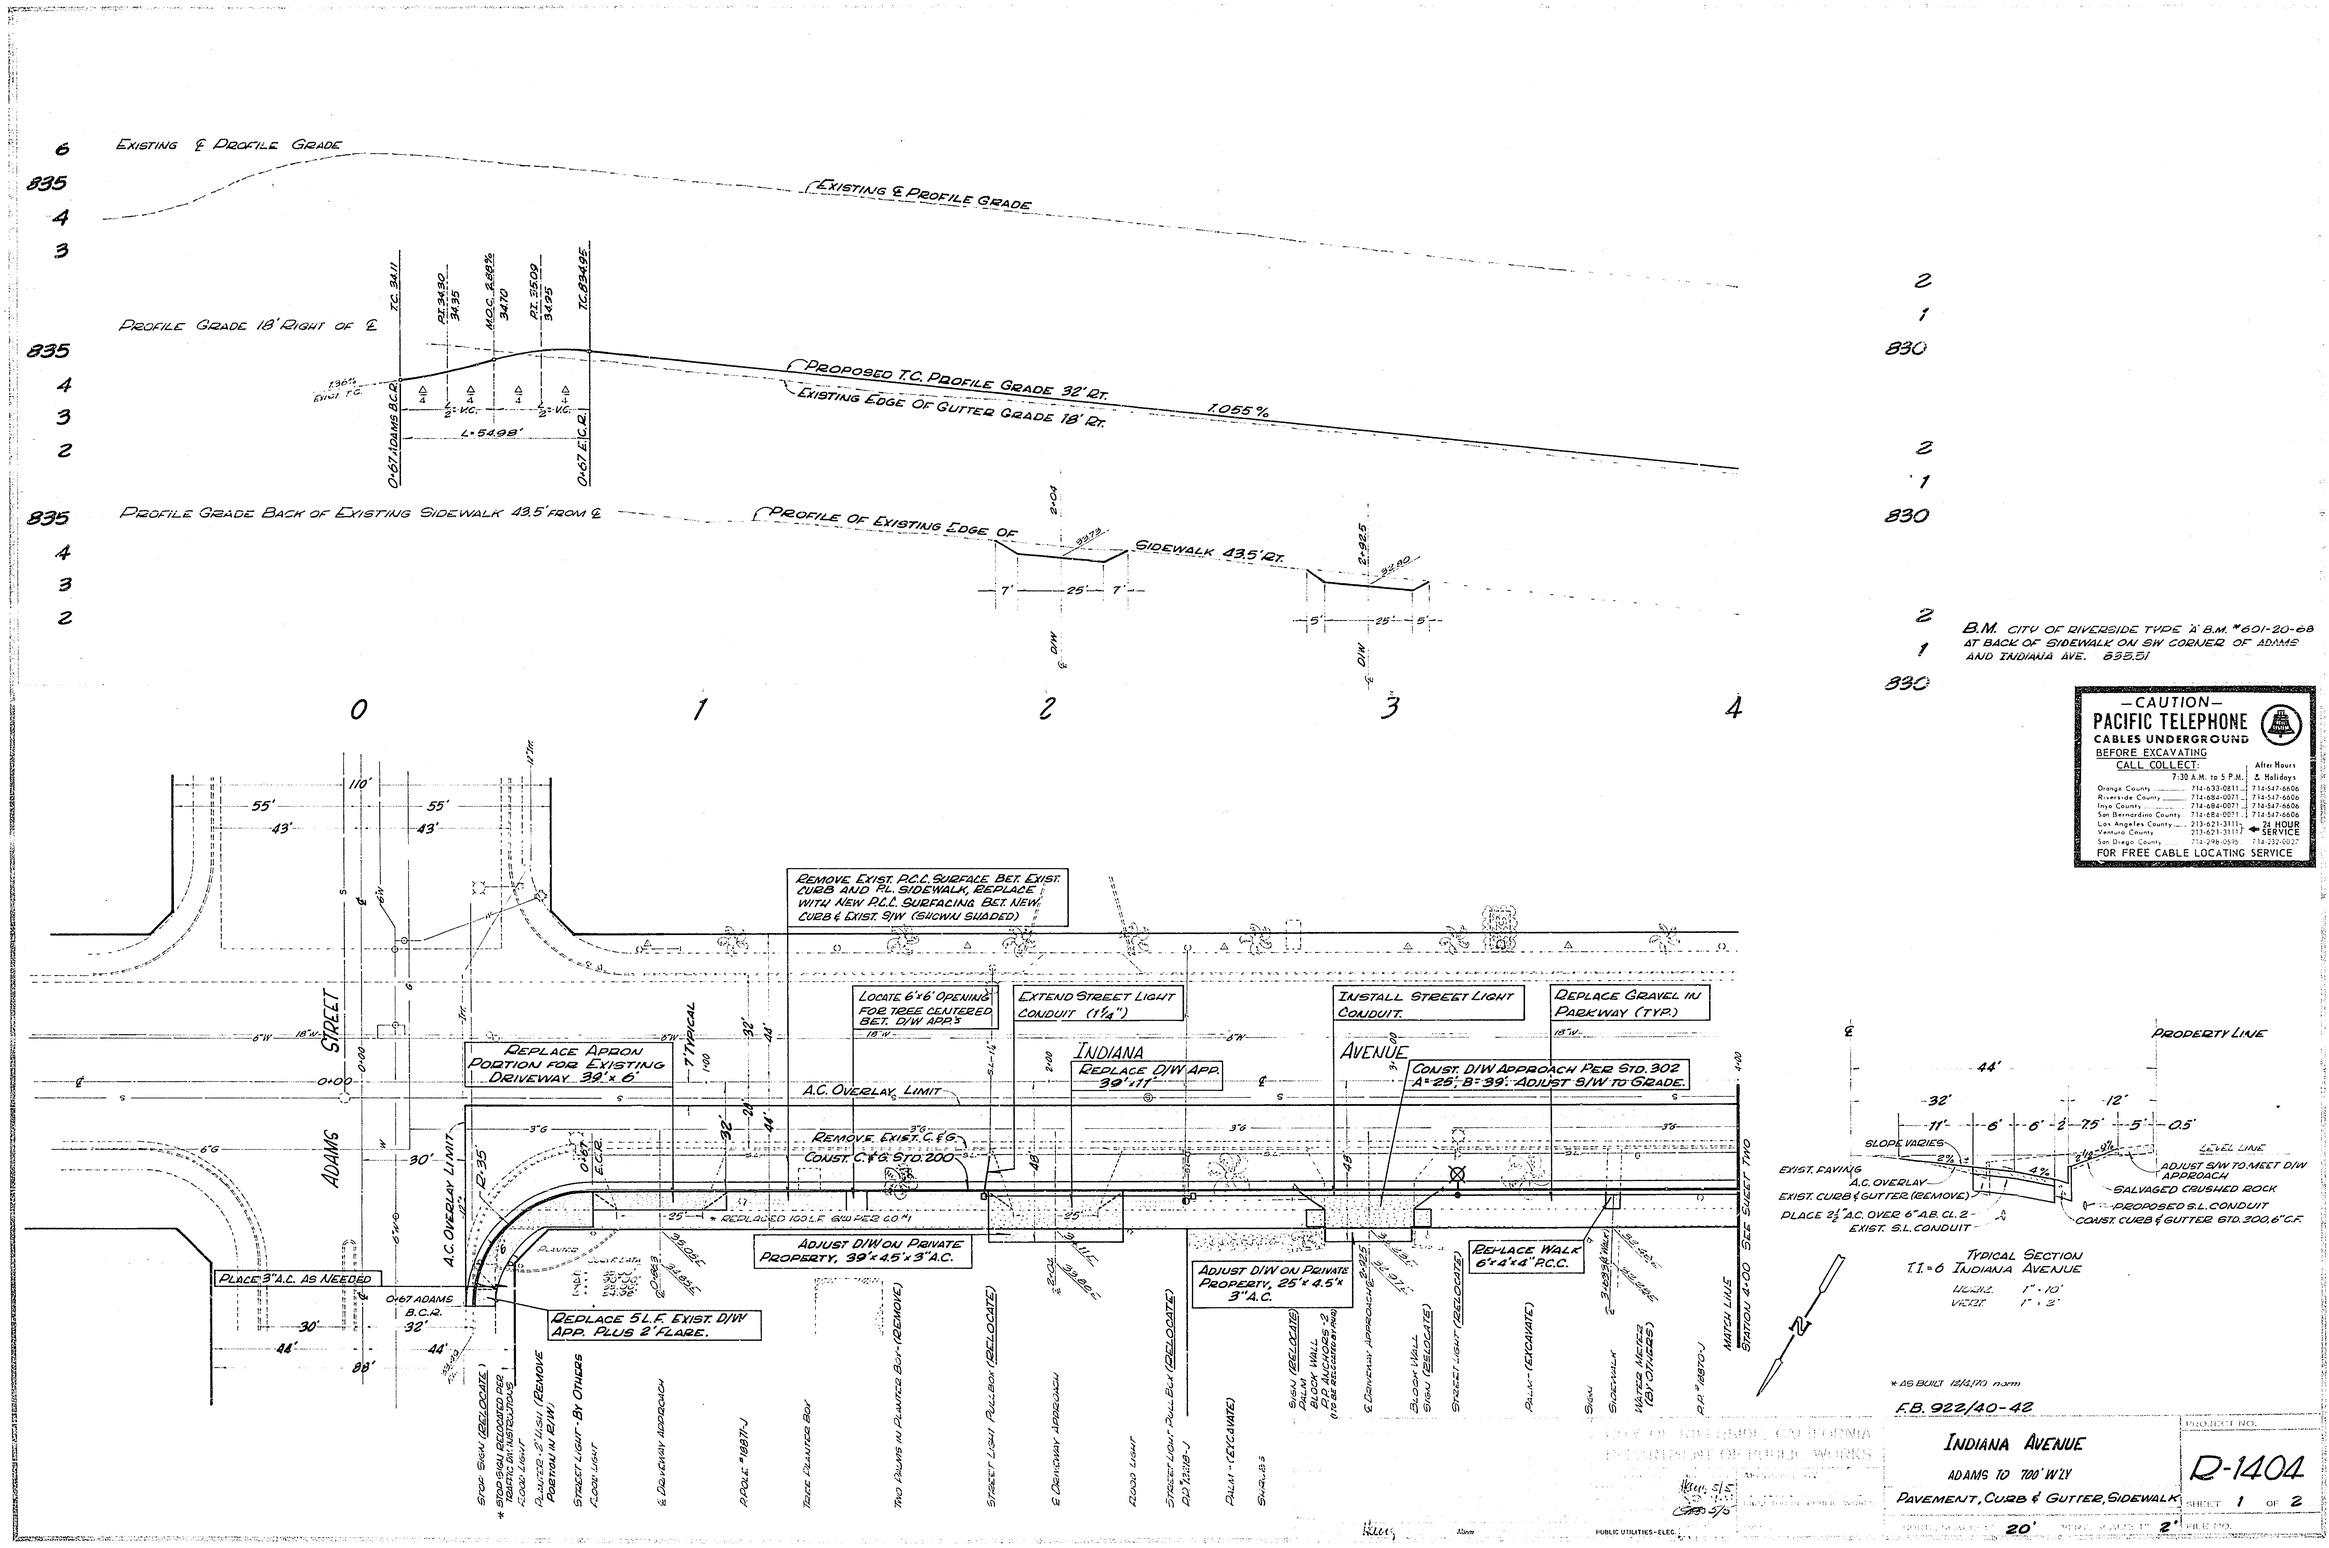

—CAUTION—
PACIFIC TELEPHONE
CABLES UNDERGROUND
BEFORE EXCAVATING
CALL COLLECT:

	7:30 A.M. to 5 P.M.	After Hours & Holidays
Orange County	714-633-0811	714-547-6606
Riverside County	714-684-0071	714-547-6606
Inyo County	714-684-0071	714-547-6606
San Bernardino County	714-684-0071	714-547-6606
Los Angeles County	213-621-3111	24 HOUR SERVICE
Ventura County	213-621-3111	

FOR FREE CABLE LOCATING SERVICE

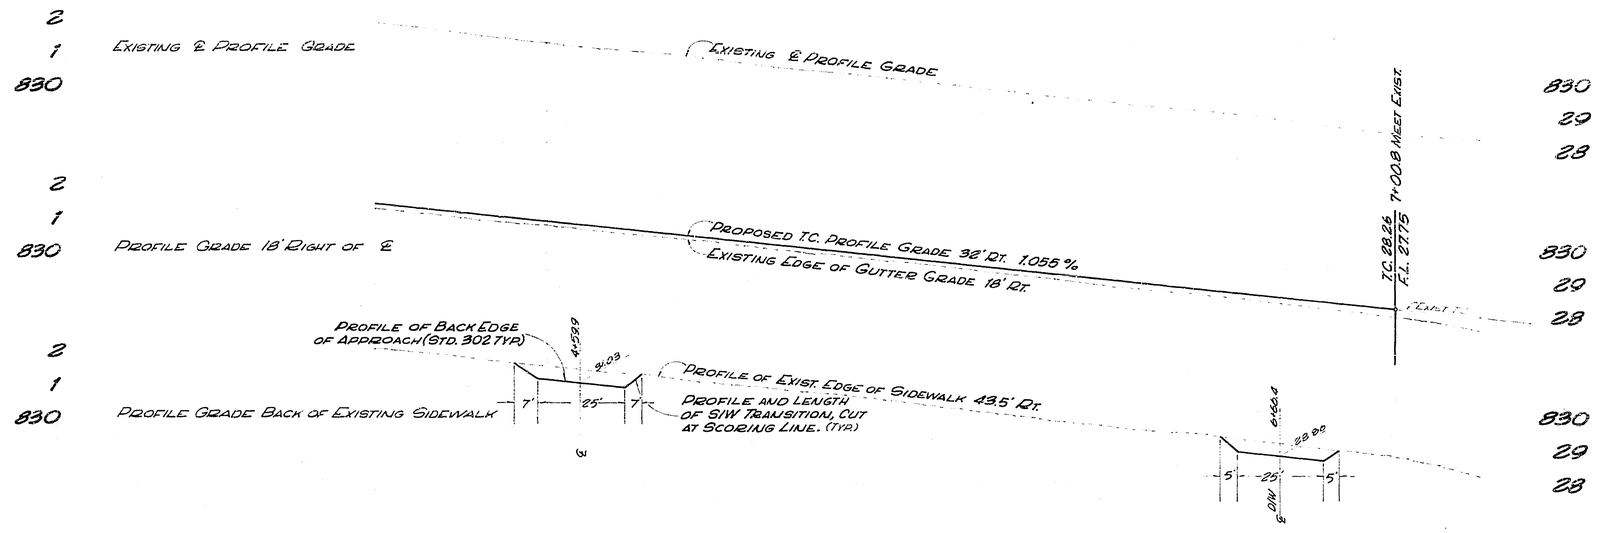

STREET LIGHT LEGEND

INDICATES CITY OF RIVERSIDE MARBELITE LIGHT STANDARD NO. 4904 WITH 10,000 L., 250 W, TYPE III "LINE MATERIAL" MERCURY VAPOR LUMINAIRE, CATALOG NO. LM93A12 OR APPROVED EQUAL.

INDICATES NO. 3½ PULLBOX "BROOKS PRODUCTS INC", "QUIKSET ED-17", OR APPROVED EQUAL.

INDICATES 1" RIGID GALVANIZED STEEL CONDUIT, EXCEPT AS NOTED.

INDICATES 240 V. FEED POINT

CONTRACTOR SHALL OBTAIN DAILY CIRCUIT CLEARANCES FROM THE PUBLIC UTILITIES DEPARTMENT PRIOR TO WORKING ON ANY EXISTING CIRCUITS. CALL 787-7811 FOR CLEARANCE.

—CAUTION—
PACIFIC TELEPHONE
CABLES UNDERGROUND
BEFORE EXCAVATING
CALL COLLECT:

	7:30 A.M. to 5 P.M.	After Hours & Holidays
Orange County	714-633-0811	714-547-6606
Riverside County	714-684-0071	714-547-6606
Inyo County	714-684-0071	714-547-6606
San Bernardino County	714-684-0071	714-547-6606
Los Angeles County	213-621-3111	← 24 HOUR SERVICE
Ventura County	213-621-3111	
San Diego County	714-298-0595	714-232-0027
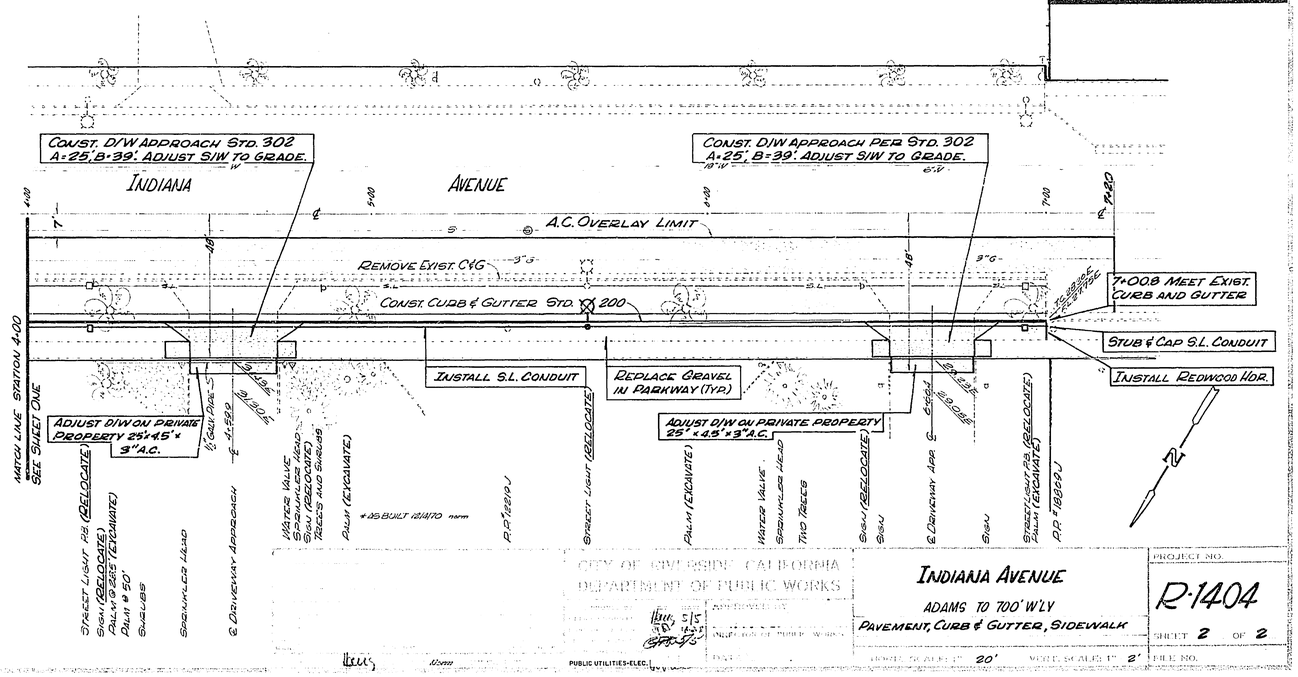
FOR FREE CABLE LOCATING SERVICE