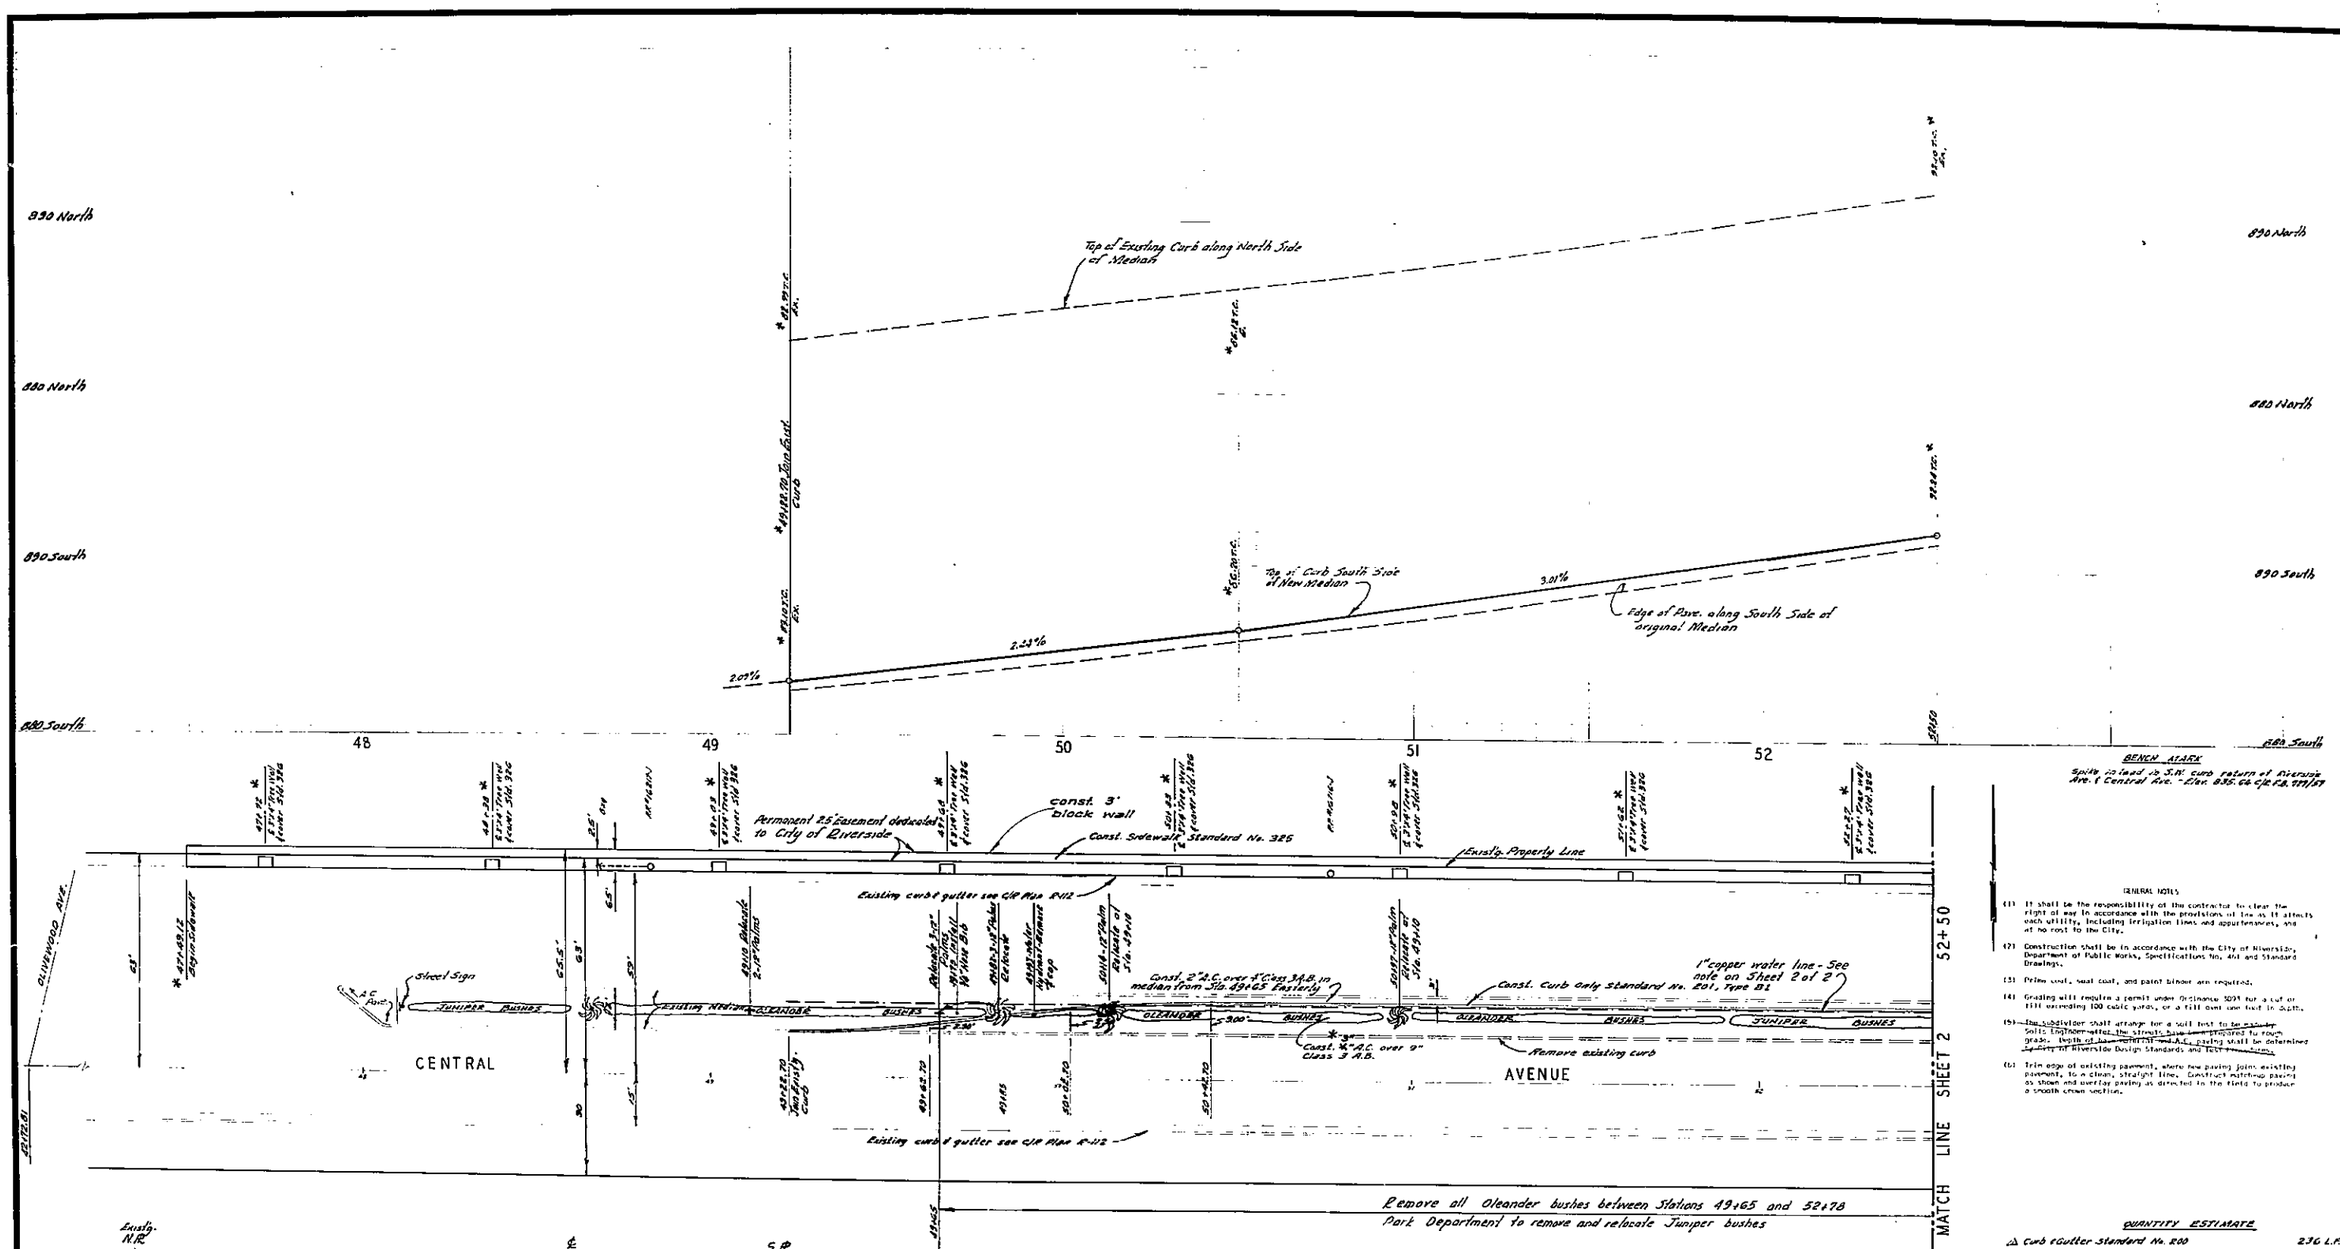

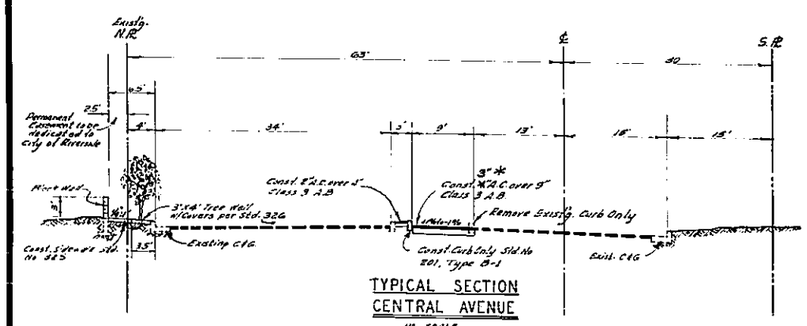

TYPICAL SECTION
CENTRAL AVENUE
NO SCALE

BENCH MARK

Spike in lead in S.W. curb return of Riverside Ave. & Central Ave. - Elev. 835.66 C/R F.B. 777/57

GENERAL NOTES

(1) It shall be the responsibility of the contractor to clear the right of way in accordance with the provisions of law as it affects each utility, including irrigation lines and appurtenances, and at no cost to the City.

(2) Construction shall be in accordance with the City of Riverside, Department of Public Works, Specifications No. 461 and Standard Drawings.

(3) Prime coat, seal coat, and paint binder are required.

(4) Grading will require a permit under Ordinance 3093 for a cut or fill exceeding 100 cubic yards, or a fill over one foot in depth.

(5) The subdivider shall arrange for a soil test to be made by Soils Engineer after the streets have been prepared to rough grade. Depth of base material and A.C. paving shall be determined by City of Riverside Design Standards and test [illegible].

(6) Trim edge of existing pavement, where new paving joins existing pavement, to a clean, straight line. Construct matchup paving as shown and overlay paving as directed in the field to produce a smooth crown section.

QUANTITY ESTIMATE

△ Curb & Gutter Standard No. 200	236 L.F.
Curb Only Standard No. 201, Type B1	475 L.F.
4" A.C. paving	3,500 S.F.
△ Cross Gutter Standard No. 220	1,940 S.F.
Curb Only removal	475 L.F.
Std. 326 Tree Well Covers	15 Pairs
Std. 325 Sidewalk	5,220 S.F.
△ Curb & Gutter Removal	234 L.F.
9" Class 3 A.B.	3,600 S.F.
2" A.C. Paving	1,500 S.F.
4" Class 3 A.B.	1,800 S.F.
△ Cross Gutter Removal	255 S.F.
△ 2½" A.C. Paving	700 S.F.
△ 6" Class 2 A.B.	700 S.F.
△ 2"x4" Redwood Header	7.0 L.F.
△ R10R(RL) Standard No. 666	1 Ea.

* as built - 10/15/70 - Karl

ALBERT A. WEBB ASSOCIATES
CIVIL ENGINEERS
RIVERSIDE, CALIFORNIA
APPROVED BY Ernest N. Wolff DATE 1/16/70
R.E. No. 9876
W.O. 69-208 FOR: Olivewood Cemetery F.B. 563 437

MARK	REVISIONS	APPR.	DATE
△	Revised Quantity Est., added Sheet 3 ENDS		

DESIGNED BY REC DRAWN BY B.E.L. CHECKED BY [illegible]

CITY OF RIVERSIDE, CALIFORNIA
PUBLIC WORKS DEPARTMENT

APPROVED BY	BY	DATE
PRINCIPAL ENGINEER		
PARK DEPARTMENT	[illegible]	2-3-70
TRAFFIC DIVISION	[illegible]	2/16
CHIEF PUB. WKS. ENGR.	[illegible]	2/13

APPROVED BY [illegible]
DIRECTOR OF PUBLIC WORKS
DATE 2-16-70

STREET PLAN AND PROFILE
CENTRAL AVENUE
NORTH SIDE
STA. 47+50 TO STA. 57+77.42
C.U.P. C-6-690
SCALE: 1" = 20' Horiz., 1" = 4' Vert.

ACCOUNT No.
DRAWING NUMBER
R-1407
SHEET 1 OF 3
69-208-A

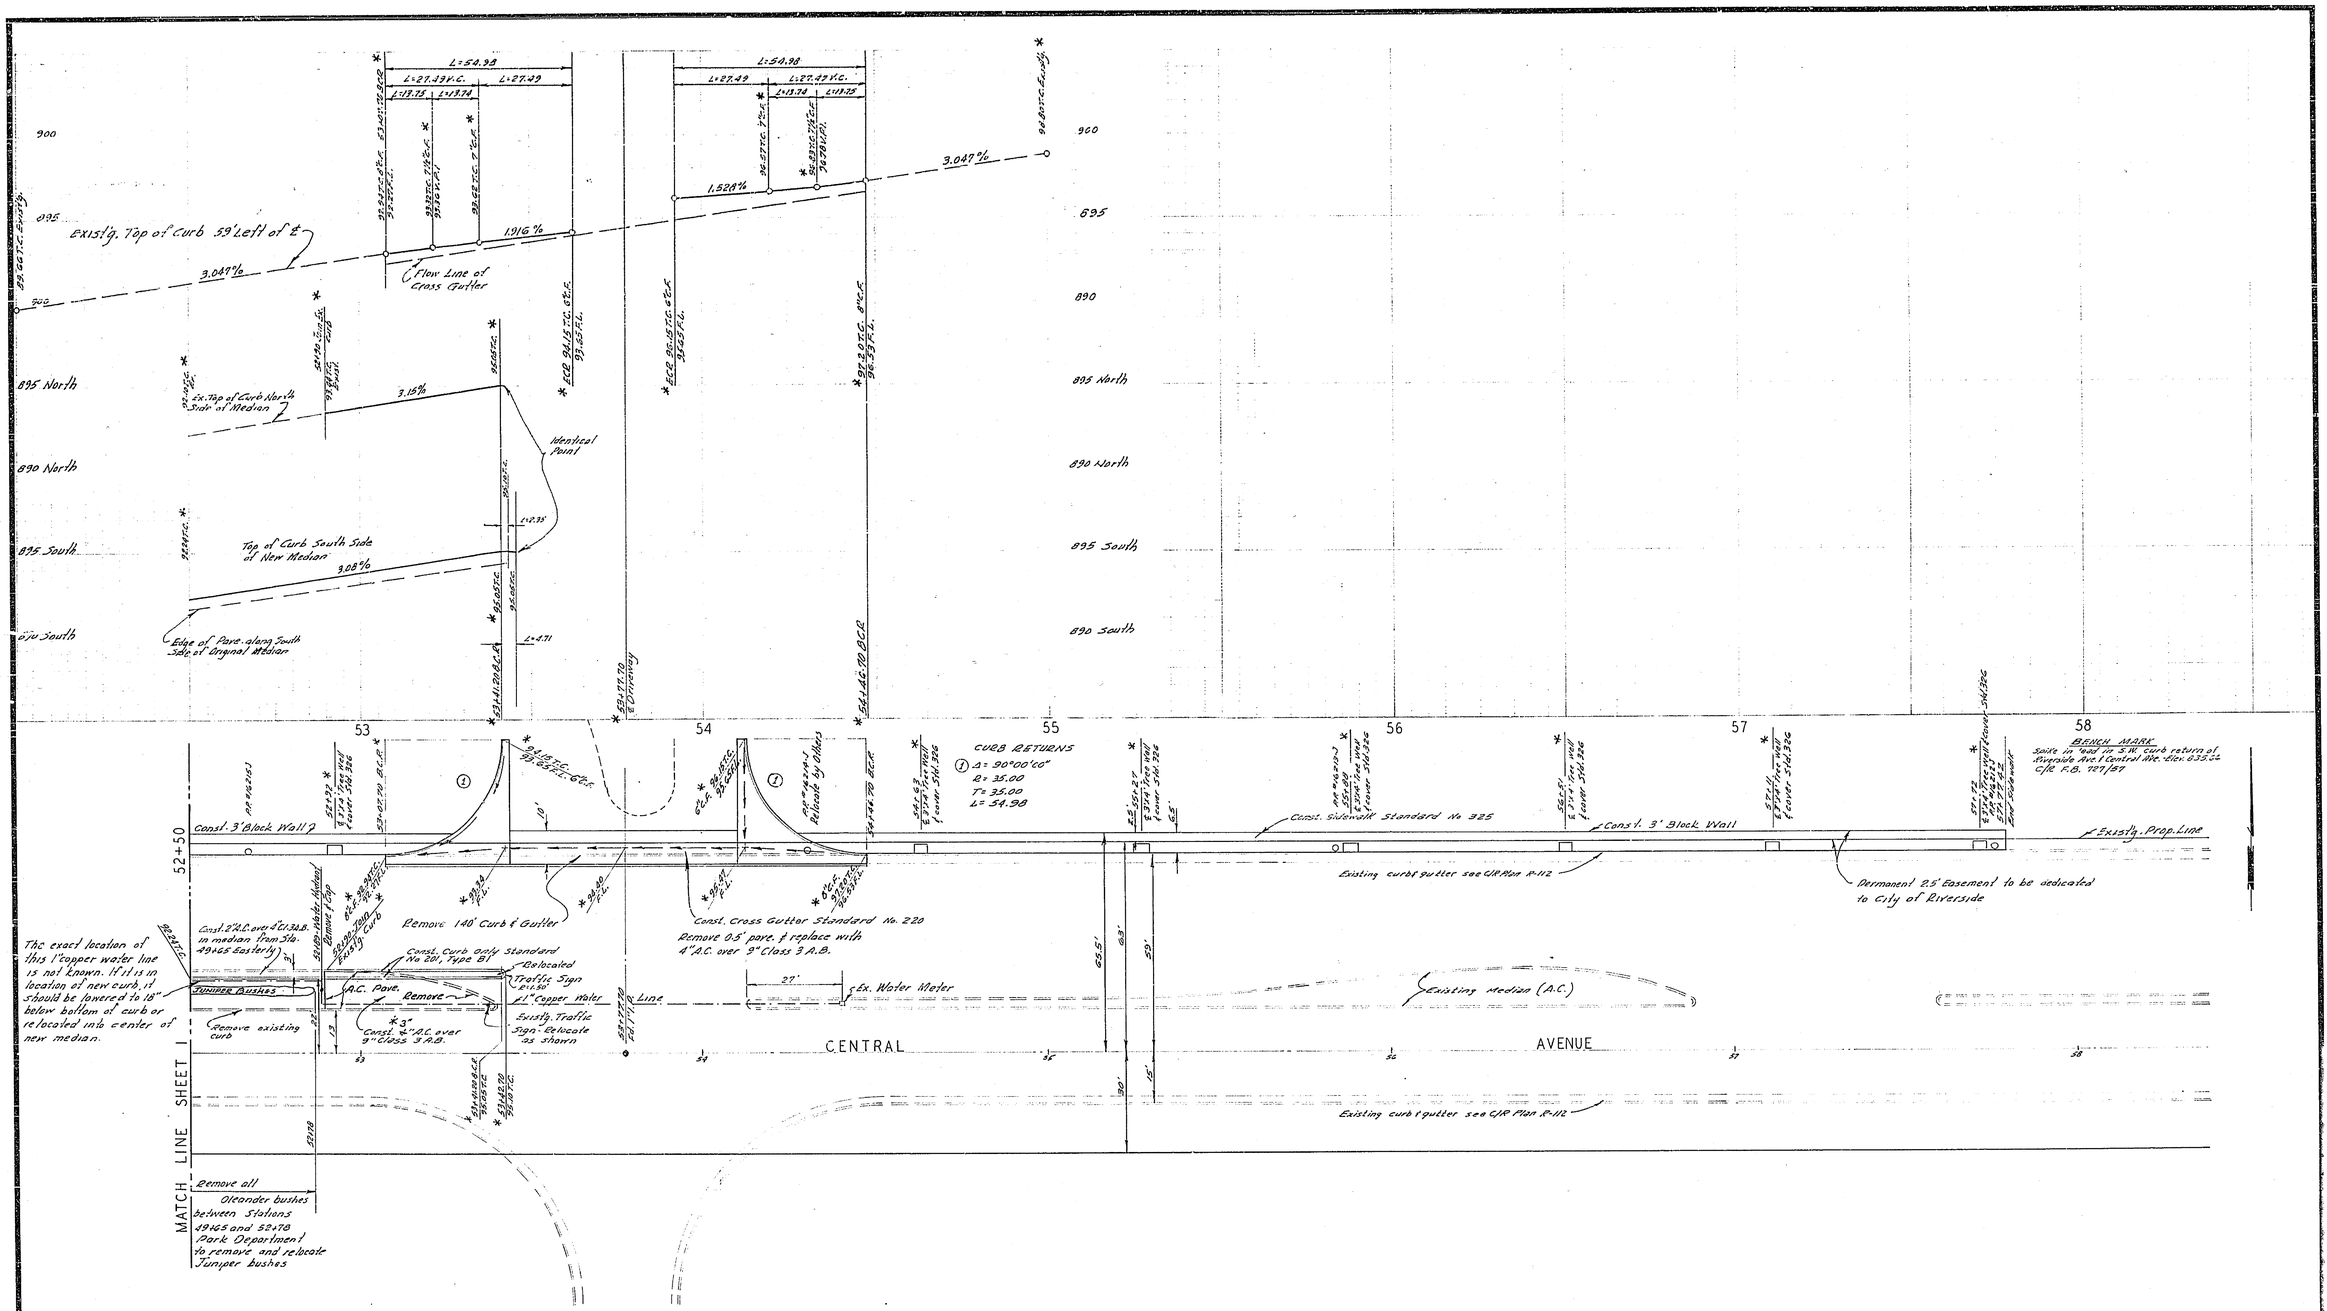

*as built · 10/15/70 · KARL

ALBERT A. WEBB ASSOCIATES CIVIL ENGINEERS RIVERSIDE, CALIFORNIA APPROVED BY [signature] DATE 1/16/70 R.E. No. 9876 W.O. 69-208 FOR: Olivewood Cemetery F.B. 563/437	MARK / REVISIONS / APPR. / DATE 1 Revised to sheet 2 of 3, added sheets 3 BNW DESIGNED BY REC DRAWN BY B.E.L. CHECKED BY [initials]	CITY OF RIVERSIDE, CALIFORNIA PUBLIC WORKS DEPARTMENT APPROVED BY / BY / DATE PRINCIPAL ENGINEER PARK DEPARTMENT TRAFFIC DIVISION CHIEF PUB. WKS. ENGR. APPROVED BY [signature] DIRECTOR OF PUBLIC WORKS DATE 8-16-70	STREET PLAN AND PROFILE CENTRAL AVENUE NORTH SIDE STA. 47+50 to STA. 57+77.42 C.U.P. C-6-690 SCALE: 1" = 20' Horiz., 1" = 4' Vert.

ACCOUNT No.
DRAWING NUMBER R-1407
SHEET 2 OF 3
69-208-A

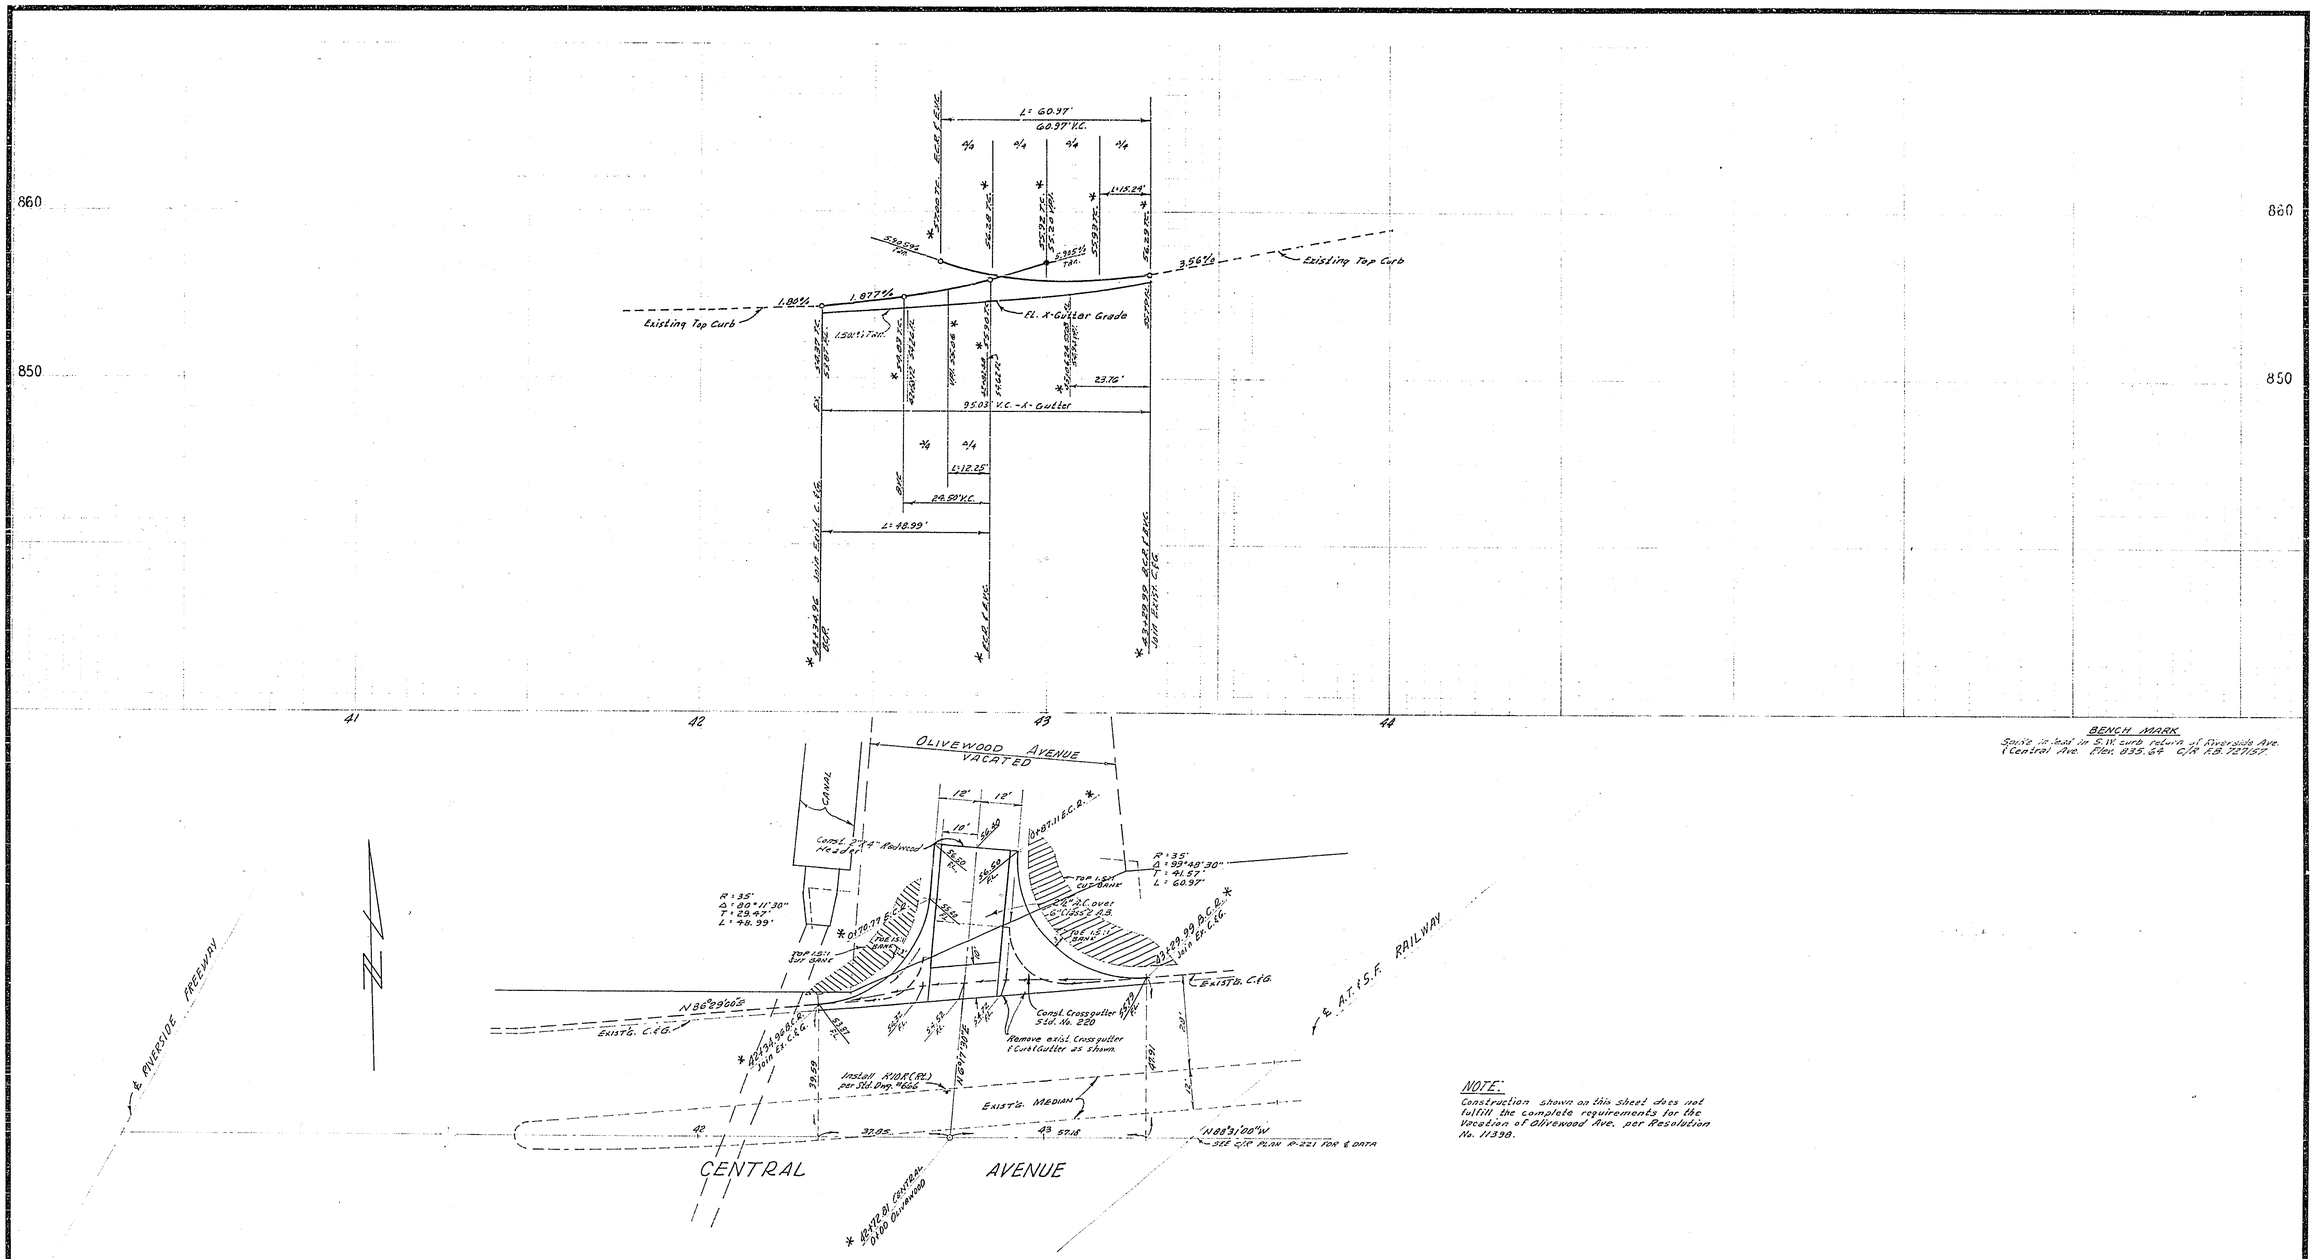

BENCH MARK
Spike in lead in S.W. curb return of Riverside Ave. & Central Ave. Elev. 835.64 C/A F.B. 727/157.

NOTE:
Construction shown on this sheet does not fulfill the complete requirements for the Vacation of Olivewood Ave. per Resolution No. 11398.

*as built - 10/15/70 - Karl

ALBERT A. WEBB ASSOCIATES CIVIL ENGINEERS RIVERSIDE, CALIFORNIA APPROVED BY Bernard N. Webb DATE 4/24/70 R.E. No. 9876	MARK / REVISIONS / APPR. / DATE	CITY OF RIVERSIDE, CALIFORNIA PUBLIC WORKS DEPARTMENT	STREET PLAN AND PROFILE
W.O. 69-208 FOR: Olivewood Cemetery F.B. 567, 437	DESIGNED BY BEL DRAWN BY BEL CHECKED BY	APPROVED BY / BY / DATE PRINCIPAL ENGINEER / PARK DEPARTMENT / TRAFFIC DIVISION / CHIEF PUB. WKS. ENGR. APPROVED BY DIRECTOR OF PUBLIC WORKS DATE 6-1-70	CENTRAL AVENUE NORTH SIDE STA. 42+34.96 TO STA. 43+29.99 C.U.P. C-6-690 SCALE: 1" = 20' Horiz., 1" = 4' Vert.

ACCOUNT No.
DRAWING NUMBER R-1407
SHEET 3 OF 3
69-208-A