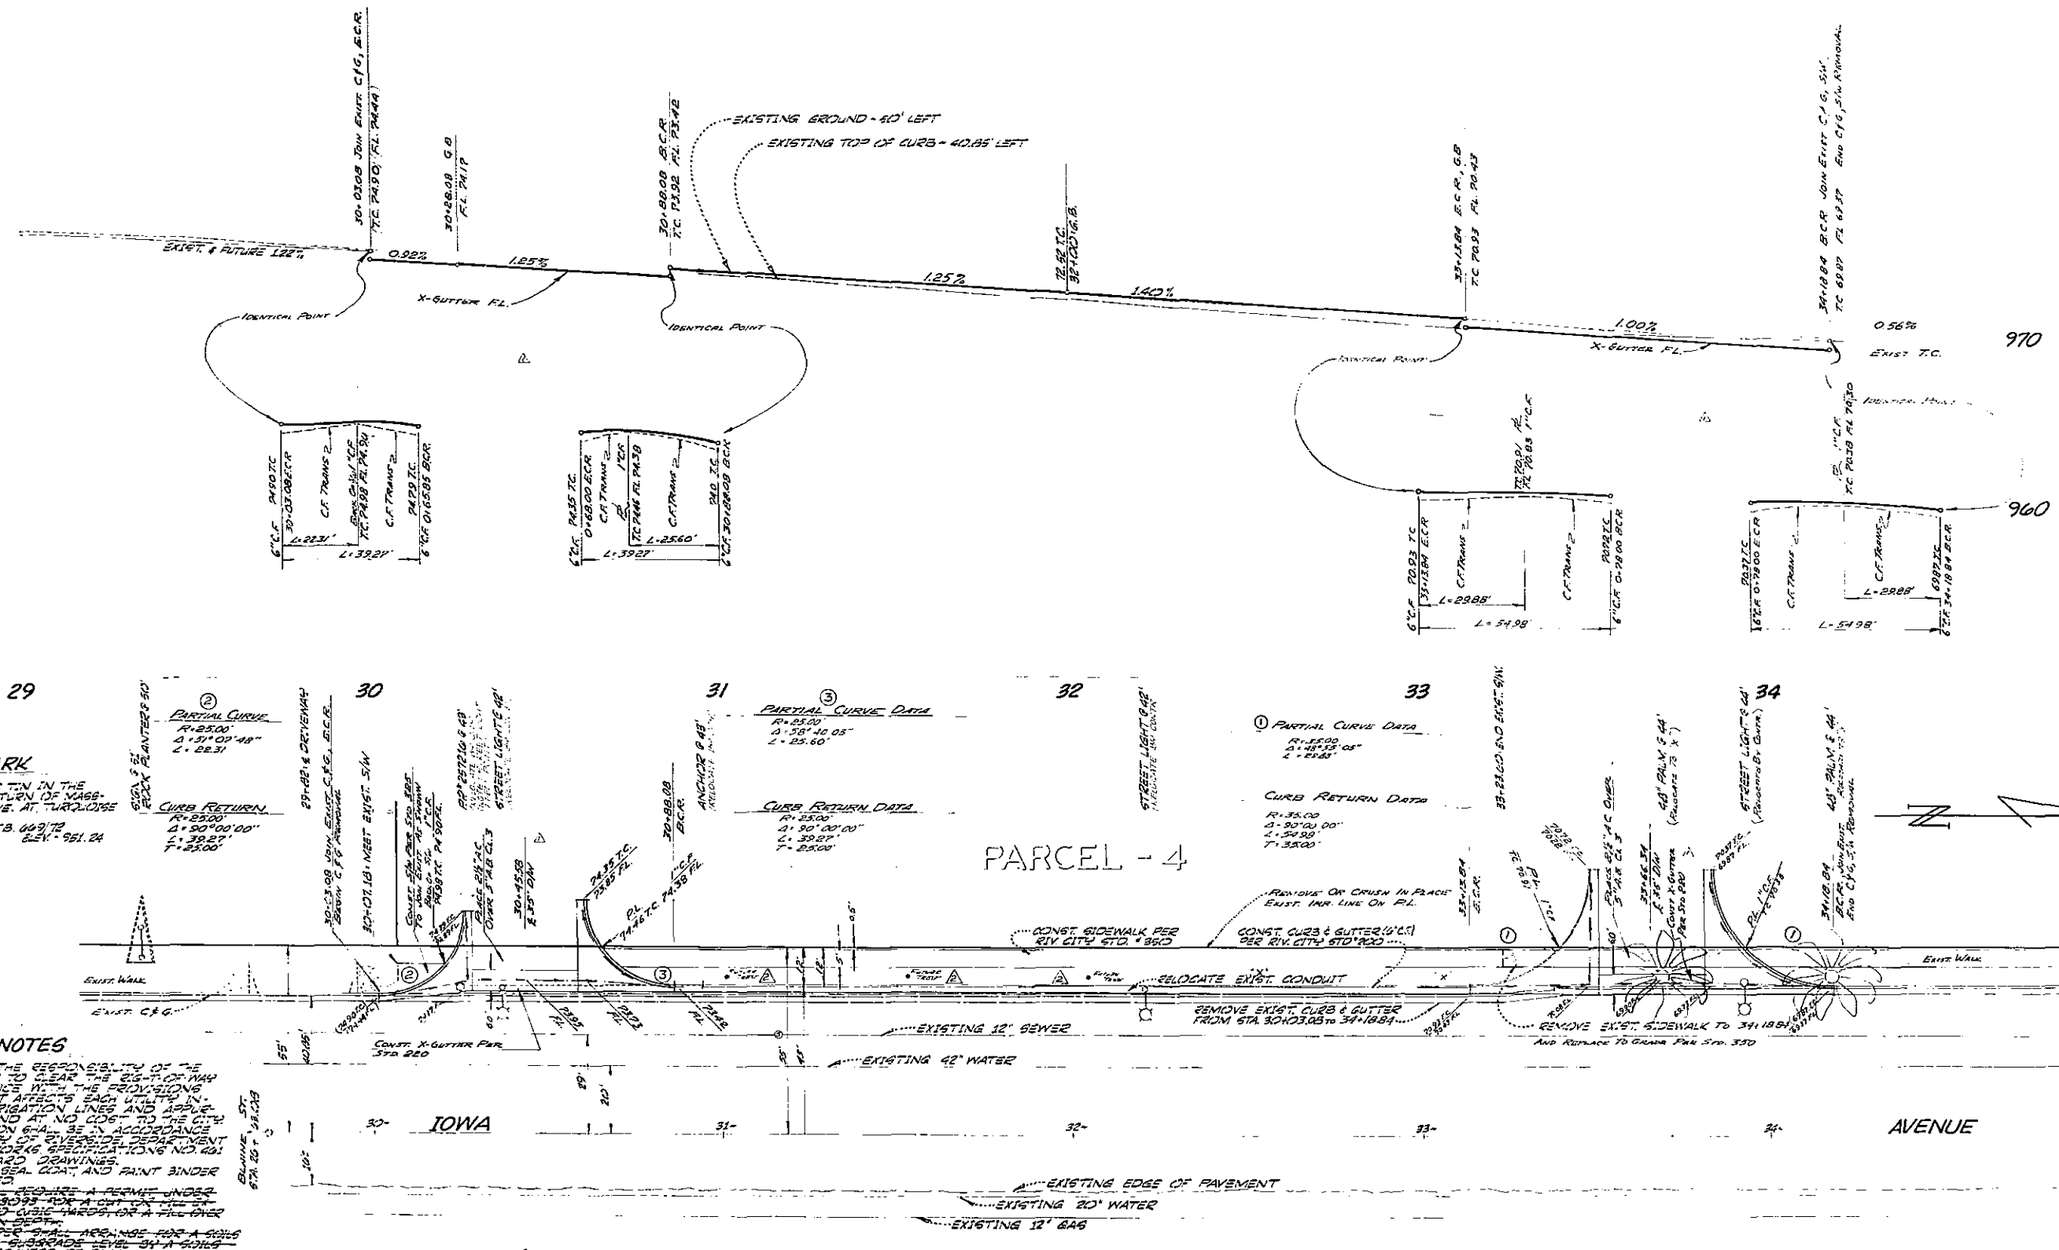

BENCH MARK

60-D NAIL & TIN IN THE NW. CURB RETURN OF MAGNOLIA AVE. AT TURQUOISE STREET.
CITY OF RIV. F.B. 669/72
ELEV. = 951.24

GENERAL NOTES

1. IT SHALL BE THE RESPONSIBILITY OF THE CONTRACTOR TO CLEAR THE RIGHT-OF-WAY IN ACCORDANCE WITH THE PROVISIONS OF LAW AS IT AFFECTS EACH OBJECT INCLUDING IRRIGATION LINES AND APPURTENANCES AND AT NO COST TO THE CITY.
2. CONSTRUCTION SHALL BE IN ACCORDANCE WITH THE CITY OF RIVERSIDE DEPARTMENT OF PUBLIC WORKS SPECIFICATIONS NO. 401 AND STANDARD DRAWINGS.
3. PRIME COAT, SEAL COAT, AND PAINT BINDER ARE REQUIRED.
4. ~~GRADING WILL REQUIRE A PERMIT UNDER ORDINANCE 9039 FOR A CUT OR FILL EXCEEDING 100 CUBIC YARDS OR A FILL OVER ONE FOOT IN DEPTH.~~
5. ~~THE DEVELOPER SHALL ARRANGE FOR A SOILS TEST AT THE SUBGRADE LEVEL BY A SOILS ENGINEER. THICKNESS OF PAVEMENT AND THICKNESS AND TYPE OF AGGREGATE BASE SHALL BE DETERMINED BY THE SOILS ENGINEER AND SUBMITTED TO THE CITY OF RIVERSIDE FOR APPROVAL PRIOR TO CONSTRUCTION.~~
6. TRIM EDGE OF EXISTING PAVING WHERE NEW PAVING JOINS EXISTING PAVEMENT TO A SMOOTH STRAIGHT LINE. CONSTRUCT MATCH-UP PAVING AS SHOWN, AND OVERLAY PAVING AS DIRECTED IN THE FIELD TO PRODUCE A SMOOTH CROWN SECTION. ENGINEER ESTIMATES OVERLAY TO BE 20 TONS.
7. FOR RELOCATION OF ANY EXISTING CITY DOMESTIC OR IRRIGATION WATER FACILITY OR ELECTRIC POWER FACILITY TO BE DONE BY CITY FORCES, CONTACT CHARLES HAGE WATER COMMERCIAL ENGINEER AT 787-7242. SCHEDULE ABOUT 2 WEEKS TO PROCESS A WORK ORDER BEFORE RELOCATION WORK BEGINS.
8. STREET LIGHT LOCATION TO BE DETERMINED IN THE FIELD BY THE STREET LIGHT ENGINEER AT THE TIME OF CONSTRUCTION.

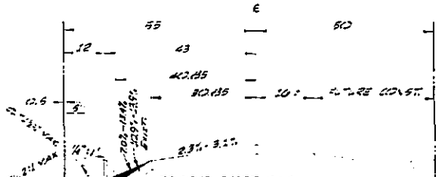

TYPICAL SECTION
IOWA AVENUE
NO SCALE

APPROVED BY: C.P.U.E. - ELECT. DATE

APPROVED BY: C.P.U.E. - CIVIL DATE

J. F DAVIDSON ASSOCIATES
CIVIL ENGINEERS - SURVEYORS - PLANNERS
RIVERSIDE, CALIFORNIA
APPROVED BY Robert F. Davidson DATE 3-8-72
R.E. No 13684
W.O. 2487 FOR SMITH-JONES F.B.

MARK	REVISIONS	APPR.	DATE
A	Incorporated Fire Hydrant in Lieu of Light Pole		6-12-72
B	Revised Curb Return Radius Per Traffic Engineering Comments		6-3-76

DESIGNED BY A.W. DRAWN BY A.W. CHECKED BY B.B.

CITY OF RIVERSIDE, CALIFORNIA
DEPARTMENT OF PUBLIC WORKS

	BY	DATE
APPROVED BY OFFICE ENGINEER		
PARK DEPARTMENT		
TRAFFIC DIVISION		
ASSISTANT CITY ENG.		4-12

APPROVED BY
DIRECTOR OF PUBLIC WORKS
DATE

R.S. 10190
ST. PLAN AND PROFILE
IOWA AVENUE
WESTERLY SIDE 300' NORTHERLY OF BLAINE ST. TO 300' NORTHERLY OF BLAINE STREET.
HORIZ. SCALE: 1" = 20' VERT. SCALE: 1" = 4'

PROJECT NO. R-1419
SHEET 1 OF 1
FILE NO. 3385

MISSION Rd