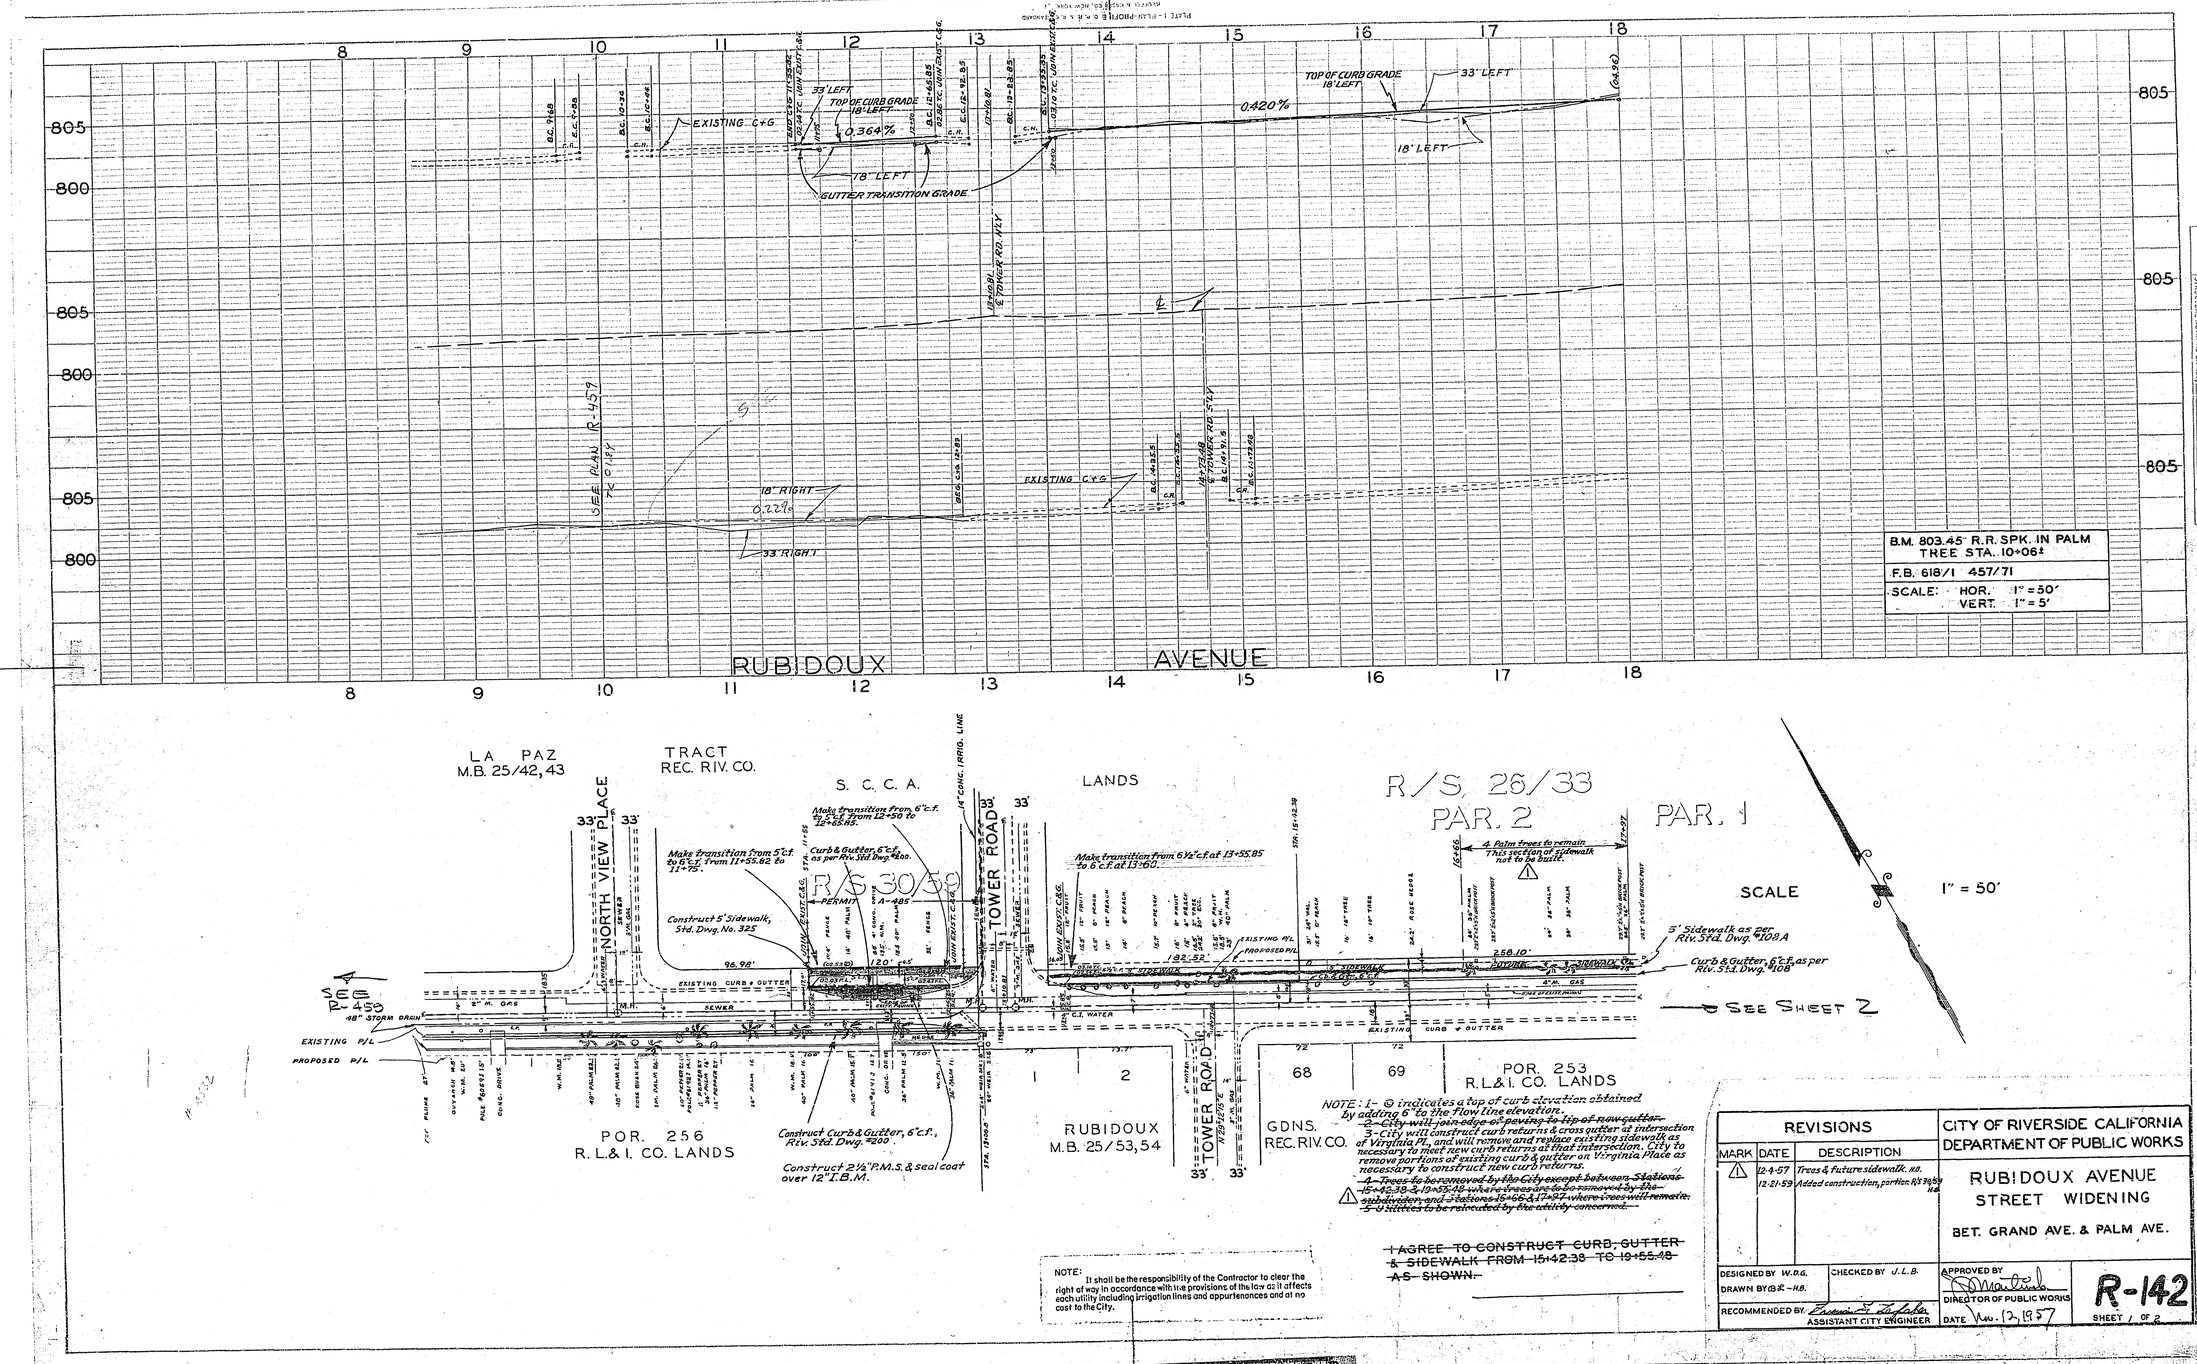

NOTE: 1- ⊙ indicates a top of curb elevation obtained by adding 6" to the flow line elevation.
~~2- City will join edge of paving to lip of new gutter.~~
3- City will construct curb returns & cross gutter at intersection of Virginia Pl., and will remove and replace existing sidewalk as necessary to meet new curb returns at that intersection. City to remove portions of existing curb & gutter on Virginia Place as necessary to construct new curb returns.
~~4- Trees to be removed by the City except between Stations 15+42.38 & 19+55.48 where trees are to be removed by the subdivider, and Stations 16+66 & 17+97 where trees will remain.~~
~~5- Utilities to be relocated by the utility concerned.~~

~~I AGREE TO CONSTRUCT CURB, GUTTER & SIDEWALK FROM 15+42.38 TO 19+55.48 AS SHOWN.~~

NOTE: It shall be the responsibility of the Contractor to clear the right of way in accordance with the provisions of the law as it affects each utility including irrigation lines and appurtenances and at no cost to the City.

REVISIONS			CITY OF RIVERSIDE CALIFORNIA DEPARTMENT OF PUBLIC WORKS
MARK	DATE	DESCRIPTION	RUBIDOUX AVENUE STREET WIDENING
△1	12-4-57	Trees & future sidewalk. H.B.	BET. GRAND AVE. & PALM AVE.
	12-21-59	Added construction, portion R/S 30/59 H.B.	

DESIGNED BY W.D.G. CHECKED BY J.L.B.
DRAWN BY B.E.-H.B.
RECOMMENDED BY [signature] ASSISTANT CITY ENGINEER
APPROVED BY [signature] DIRECTOR OF PUBLIC WORKS
DATE Nov. 12, 1957
R-142
SHEET 1 OF 2

PROFILE: SURVEYED, PLOTTED, GRADES CHECKED, B.M.'S NOTED, STRUCTURE NOTATIONS CHKD.
PLAN: SURVEYED, PLOTTED, ALIGNMENT CHECKED, RT. OF WAY CHECKED.

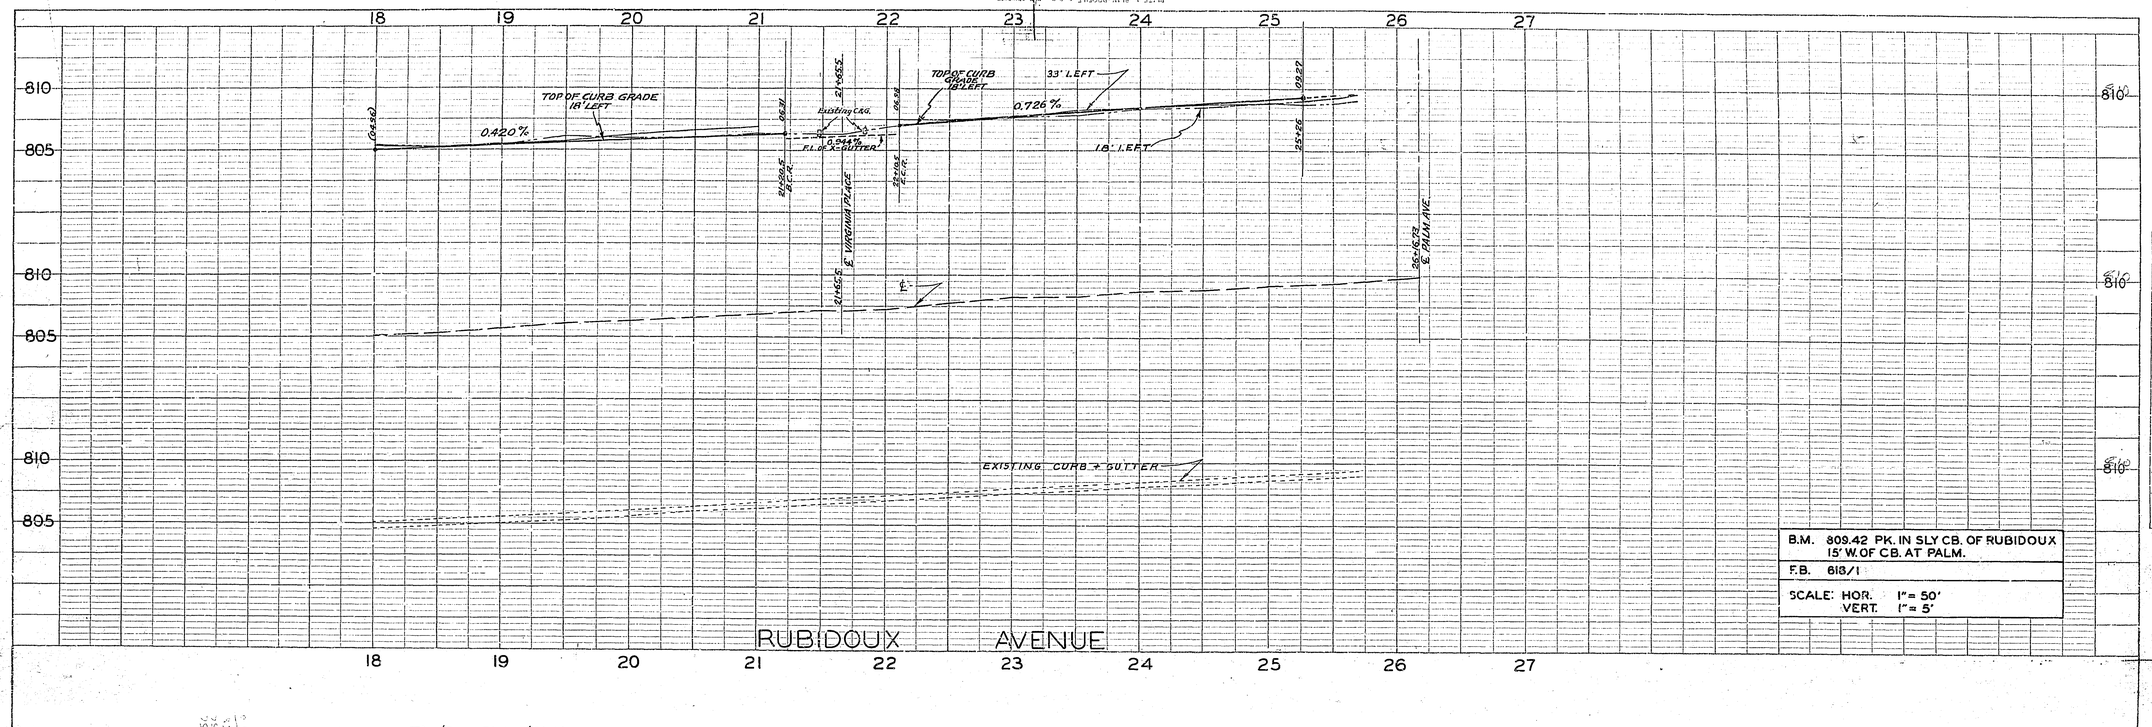

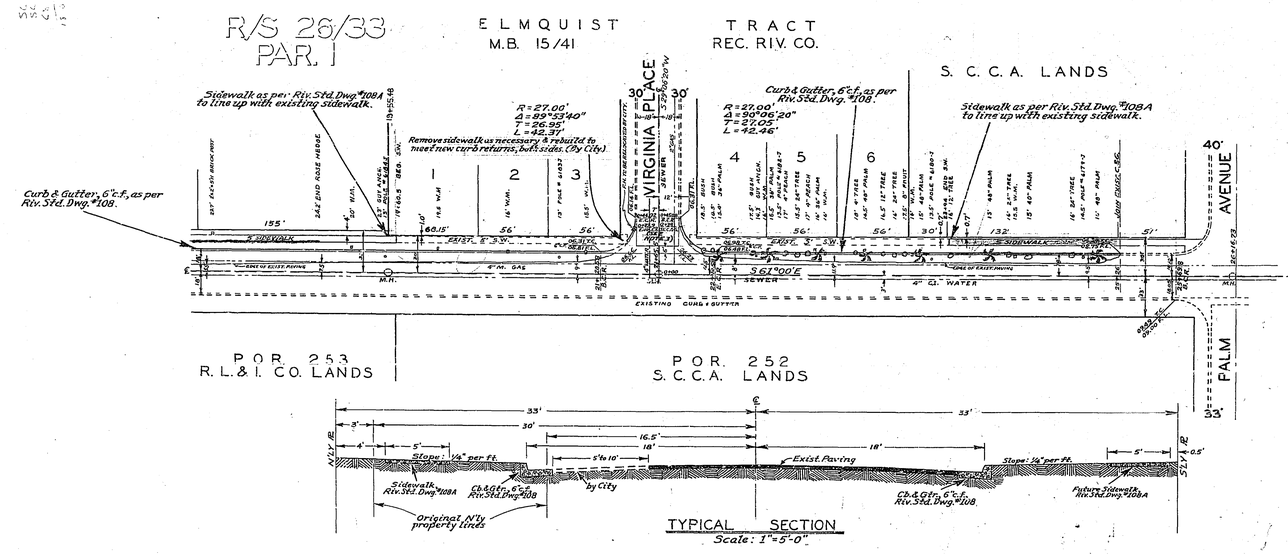

REVISIONS		
MARK	DATE	DESCRIPTION

CITY OF RIVERSIDE CALIFORNIA
DEPARTMENT OF PUBLIC WORKS

RUBIDOUX AVENUE
STREET WIDENING
BET. GRAND AVE. & PALM AVE.

DESIGNED BY W.D.G.
DRAWN BY G.E.-H.B.
CHECKED BY J.L.B.
RECOMMENDED BY Dwain E. Lofstrom ASSISTANT CITY ENGINEER
APPROVED BY DIRECTOR OF PUBLIC WORKS
DATE Nov. 12, 1957

R-142
SHEET 2 OF 2

PROFILE
SURVEYED
PLOTTED
CALCULATED
NOTE BOOK
NO.
PAGES CHECKED
STRUCTURE NOTE NO. CHKD.
BY
DATE

PLAN
SURVEYED
PLOTTED
CALCULATED
NOTE BOOK
NO.
PAGES CHECKED
STRUCTURE NOTE NO. CHKD.
BY
DATE