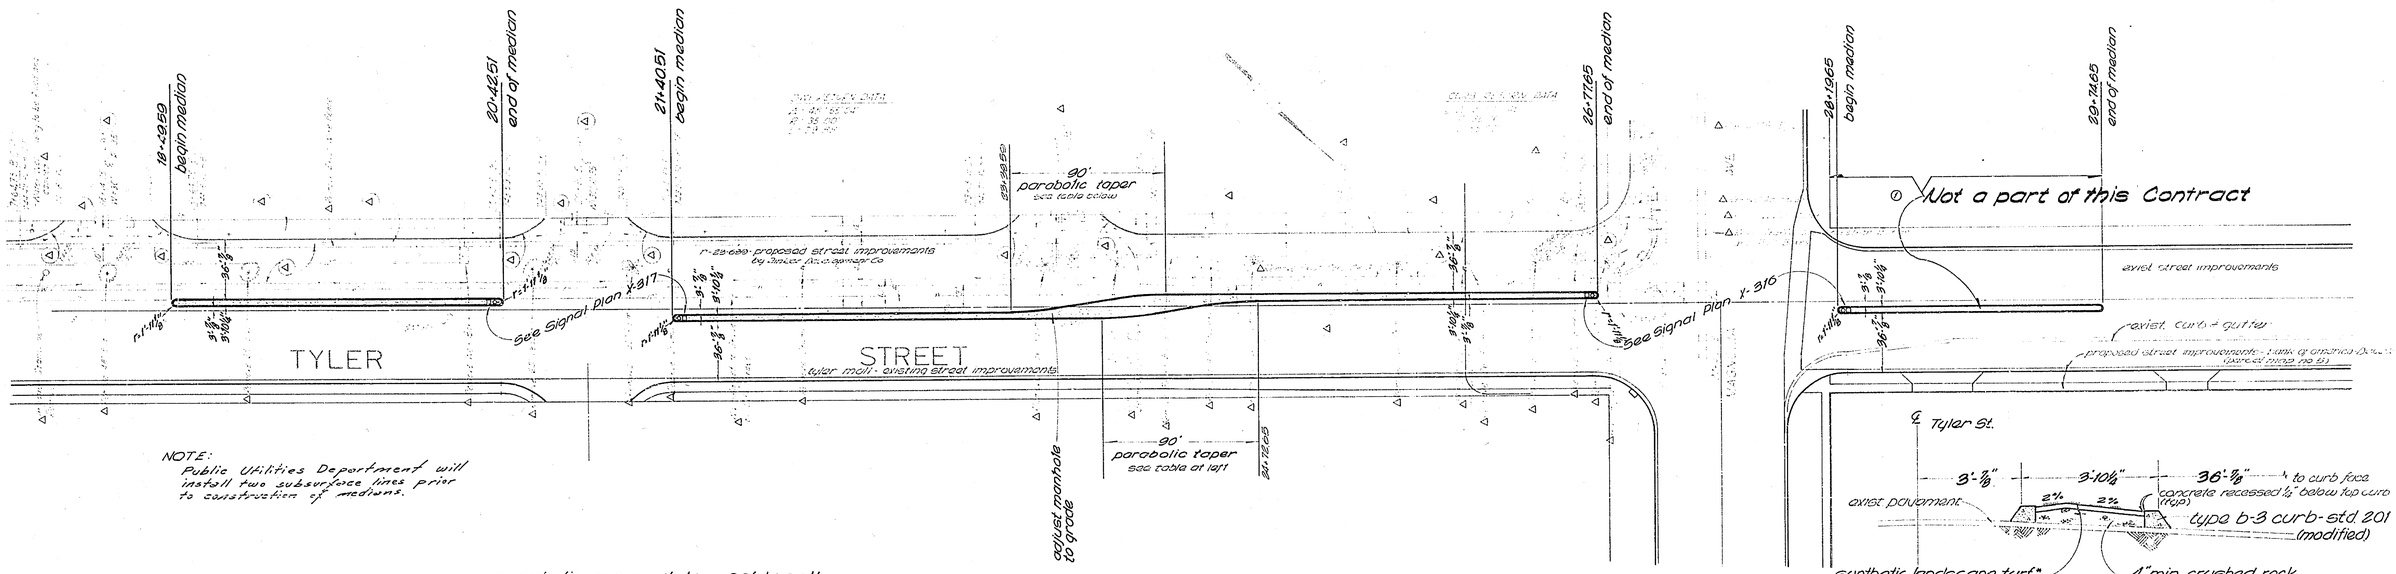

NOTE:
Public Utilities Department will install two subsurface lines prior to construction of medians.

parabolic curve data - 90' length

distance from pt. 'd'	0'	7.5'	15'	22.5'	30'	45'	60'	67.5'	75'	82.5'	90'
offset distance	0'	.16'	.62'	1.41'	2.50'	5.0'	7.50'	8.59'	9.38'	9.84'	10.0'

scale: 1" = 20'

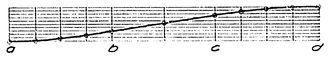

electrical legend

- ○ pedestrian button and post } by others
- □ pull box

after backfill material is in place the traffic electrical contractor shall install electrical units at grade.

BENCH MARK

typical section - medians
1" = 2'

* Monsanto Astro turf - CH-4 - or approved equal.

Δ - indicates construction that is not a part of this contract and shall be done by others.

① Deleted median per C.O. #1 ... 8/12

CITY OF RIVERSIDE, CALIFORNIA
DEPARTMENT OF PUBLIC WORKS

APPROVED BY: [signature]
DATE 7-8-70

TYLER STREET MEDIANS
AT MAGNOLIA AVENUE

HORIZ SCALE: 1" = 40' VERT SCALE: 1" = 4'

PROJECT NO. R 1429
SHEET 1 OF 1
FILE NO.