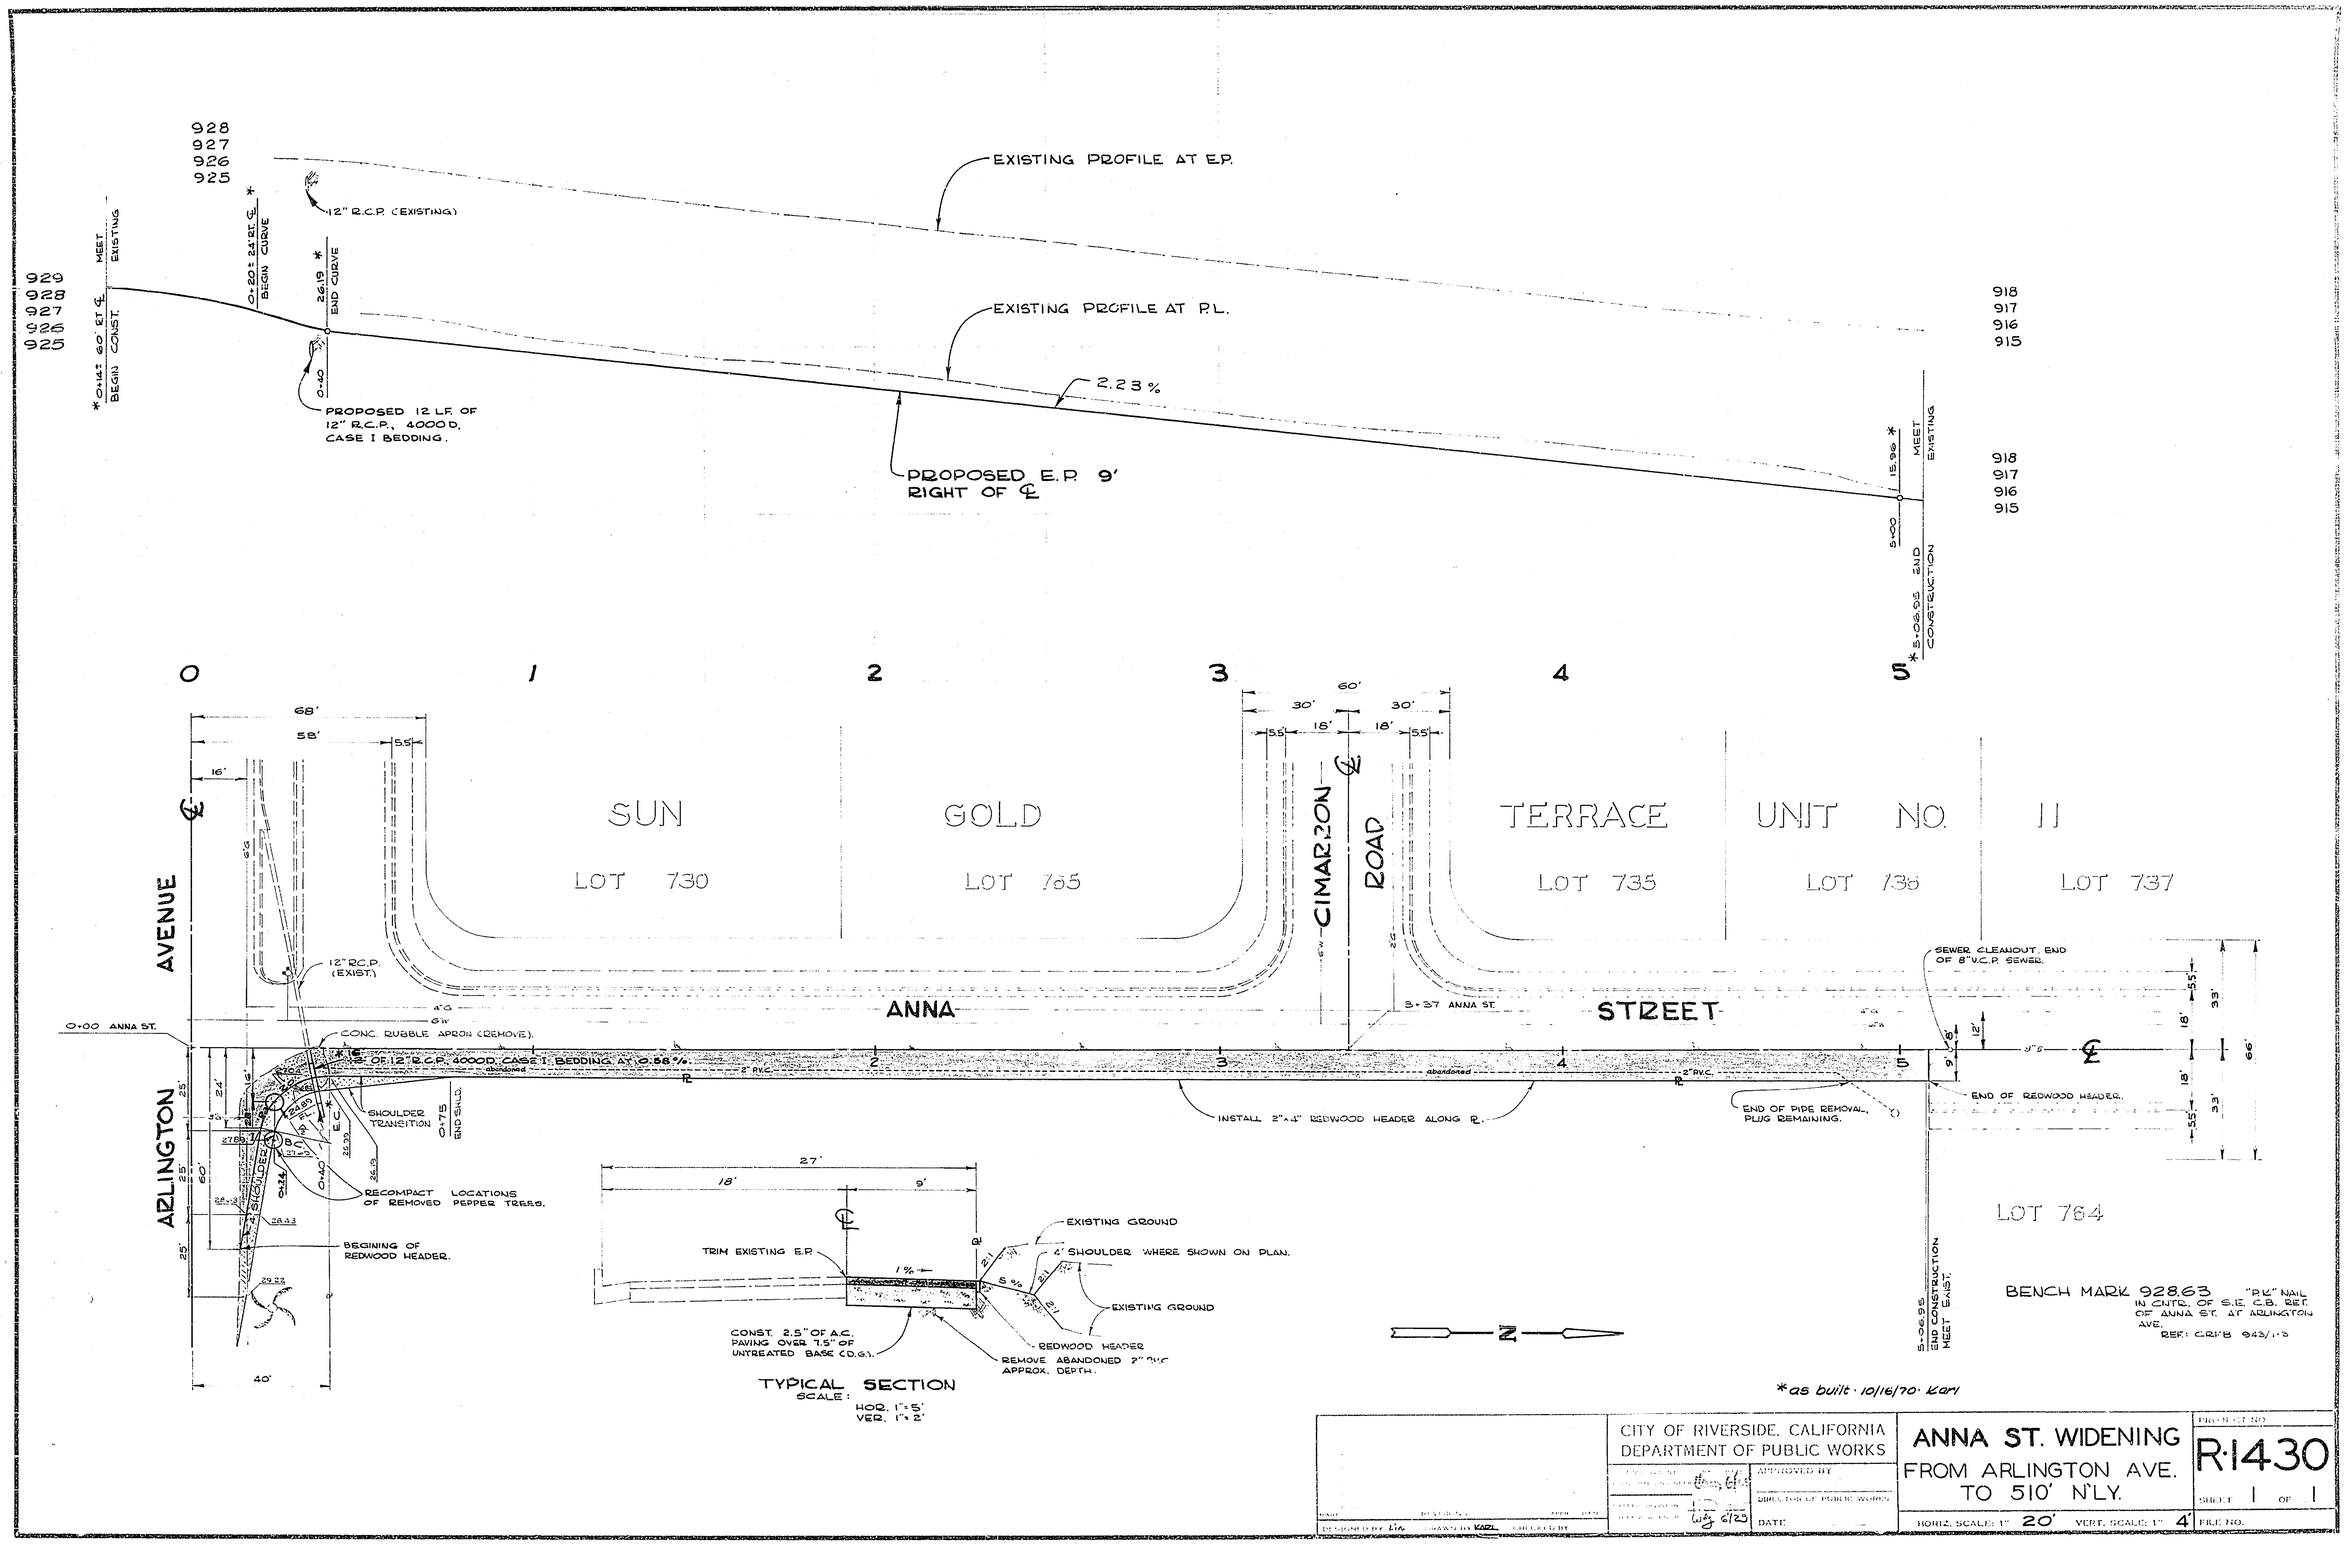

CITY OF RIVERSIDE, CALIFORNIA DEPARTMENT OF PUBLIC WORKS	APPROVED BY DIRECTOR OF PUBLIC WORKS DATE	ANNA ST. WIDENING FROM ARLINGTON AVE. TO 510' N'LY.	PROJECT NO. R-1430 SHEET 1 OF 1
DESIGNED BY Lin DRAWN BY KARL CHECKED BY		HORIZ. SCALE: 1" 20' VERT. SCALE: 1" 4'	FILE NO.