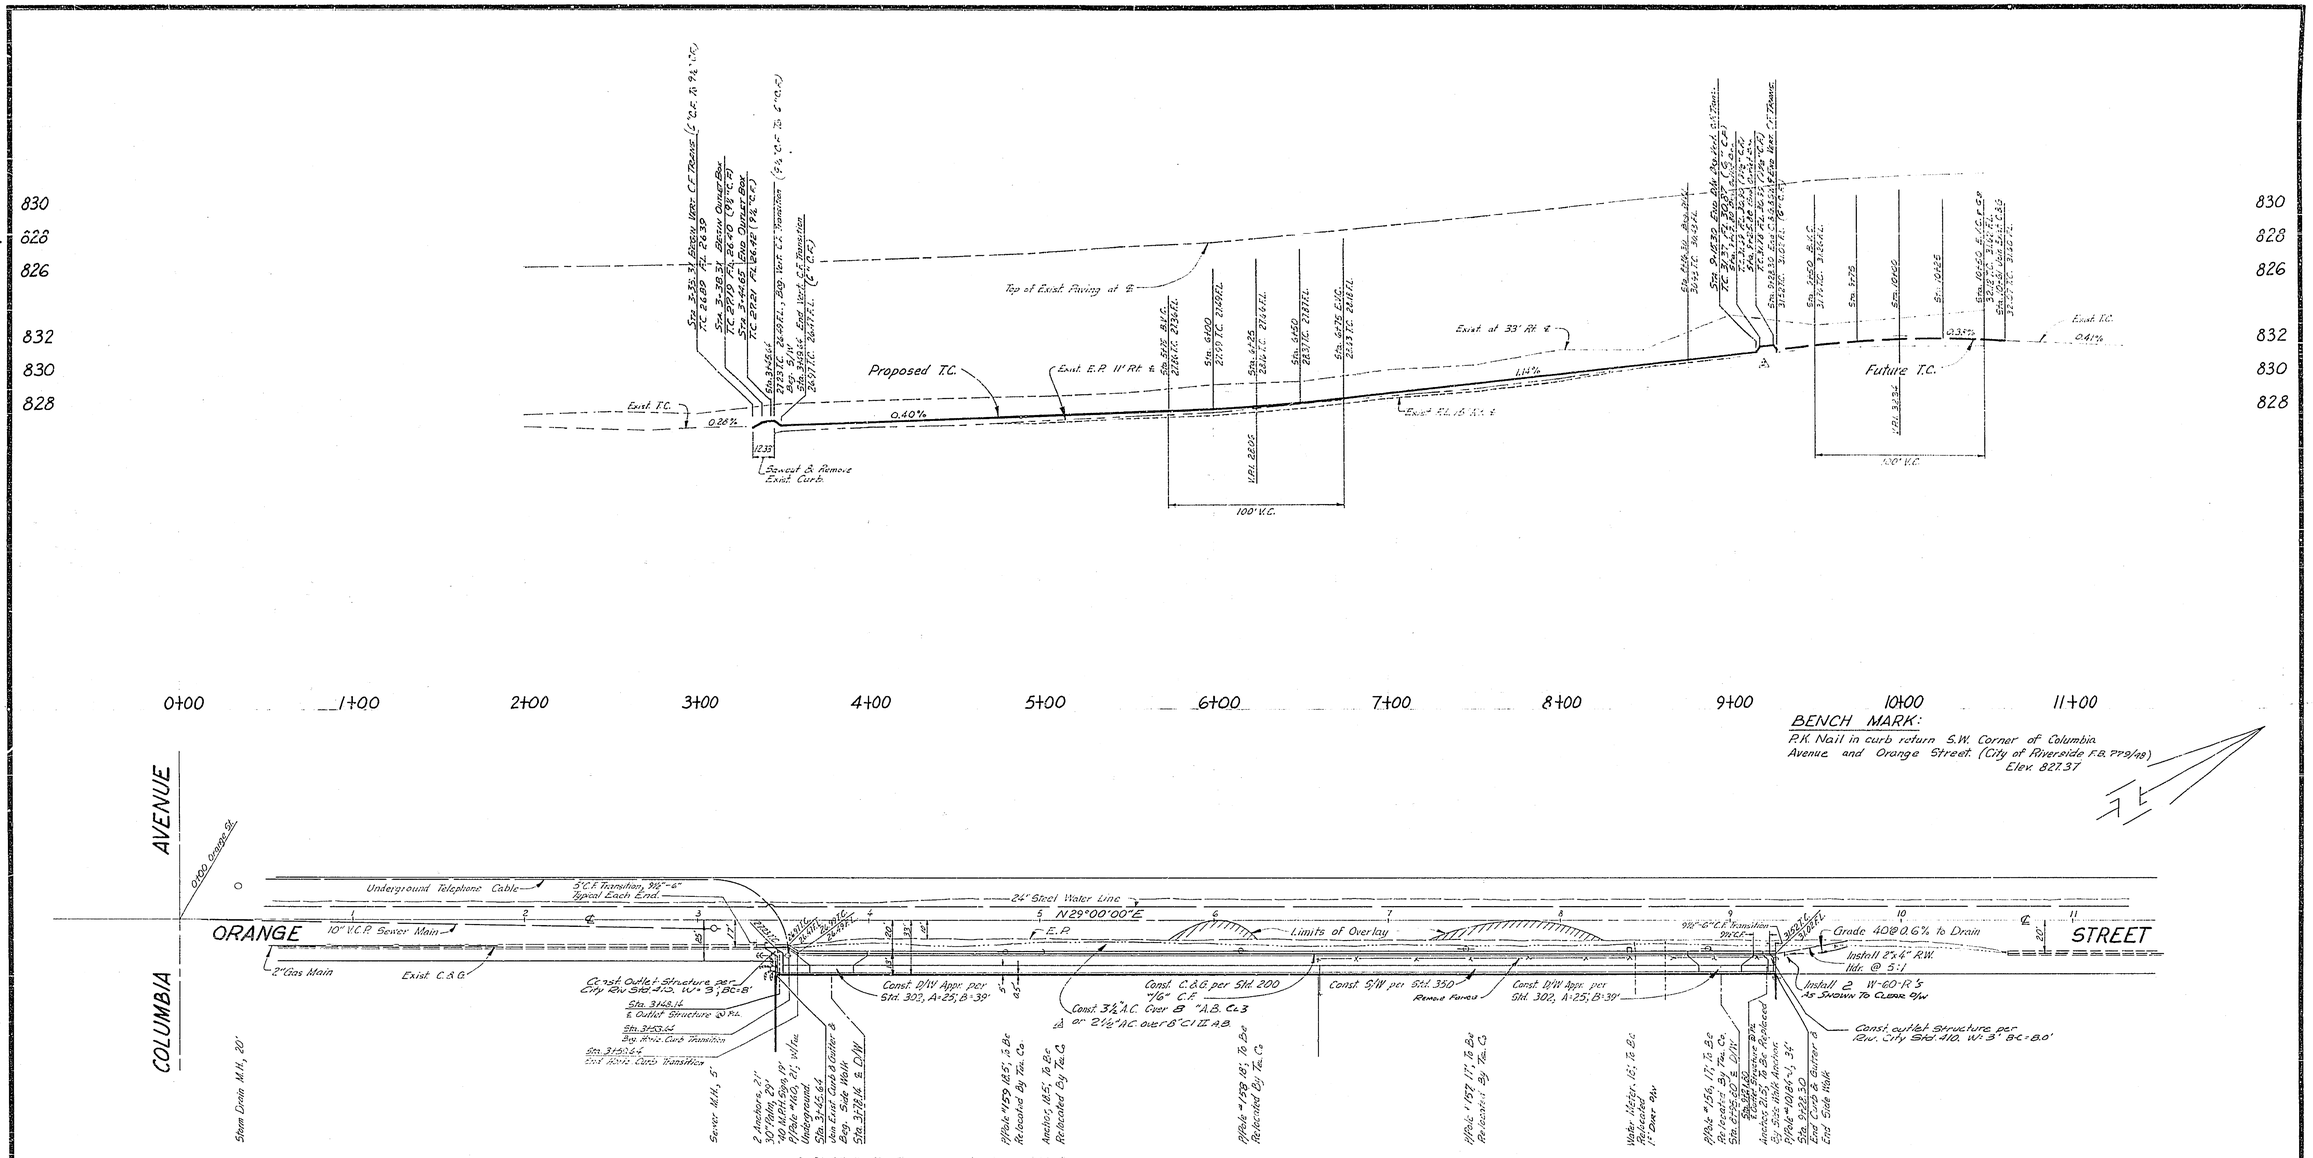

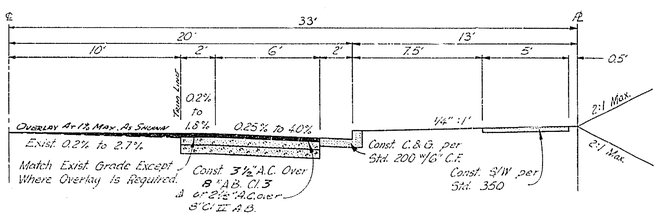

TYPICAL SECTION
ORANGE STREET
Scale: 1" = 4' Horiz.
1" = 4' Vert.
T.E. = 6.0

—CAUTION—
PACIFIC TELEPHONE
CABLES UNDERGROUND
BEFORE EXCAVATING
CALL COLLECT:

	7:30 A.M. to 5 P.M.	After Hours & Holidays
Orange County	714-633-0811	714-547-6606
Riverside County	714-684-0071	714-547-6606
Imperial County	714-684-0071	714-547-6606
San Bernardino County	714-684-0071	714-547-6606
Los Angeles County	213-621-3111	24 HOUR SERVICE
Ventura County	213-621-3111	
San Diego County	714-298-0595	714-232-0027

FOR FREE CABLE LOCATING SERVICE

GENERAL NOTES

1. It shall be the responsibility of the contractor to clear the right of way in accordance with the provisions of law as it affects each utility including irrigation lines and appurtenances and at no cost to the City.

2. Construction shall be in accordance with the City of Riverside, Department of Public Works, Specifications No. 461 and Standard Drawings.

3. Prime coat, seal coat, and paint binder are required.

4. Trim edge of existing paving to clean, straight line. Construct match-up paving as shown, and overlay existing paving as directed in the field to produce a smooth crown section. Engineer estimates the overlay to be approximately 3 tons.

5. Pavement shall not be placed until the sewer as shown on S-797 is constructed.

J. F. DAVIDSON ASSOCIATES
CIVIL ENGINEERS - SURVEYORS - PLANNERS
RIVERSIDE, CALIFORNIA
APPROVED BY [signature] DATE 5-14-70
R.E. No. 13617
W.O. 2583 FOR: Henschel & Sproul F.B. 1005

MARK	REVISIONS	APPR.	DATE
2	Revised Outlet To Show As Built		
1	Added 2½" A.C. over 8" Cl II A.B. & 3½" A.C.		

DESIGNED BY AW DRAWN BY MKC CHECKED BY

CITY OF RIVERSIDE, CALIFORNIA
DEPARTMENT OF PUBLIC WORKS

APPROVED BY	BY	DATE
OFFICE ENGINEER		
PARK DEPARTMENT		
TRAFFIC DIVISION		
ASSISTANT CITY ENG.		

APPROVED BY
DIRECTOR OF PUBLIC WORKS
DATE

STREET PLAN & PROFILE
ORANGE STREET
345.64' N'ly TO 928.30' N'ly
OF COLUMBIA AVENUE.
C-29-690, PM-1

HORIZ. SCALE: 1" = 40' VERT. SCALE: 1" = 4'

PROJECT NO. R-1436
SHEET 1 OF 1
FILE NO. 3389