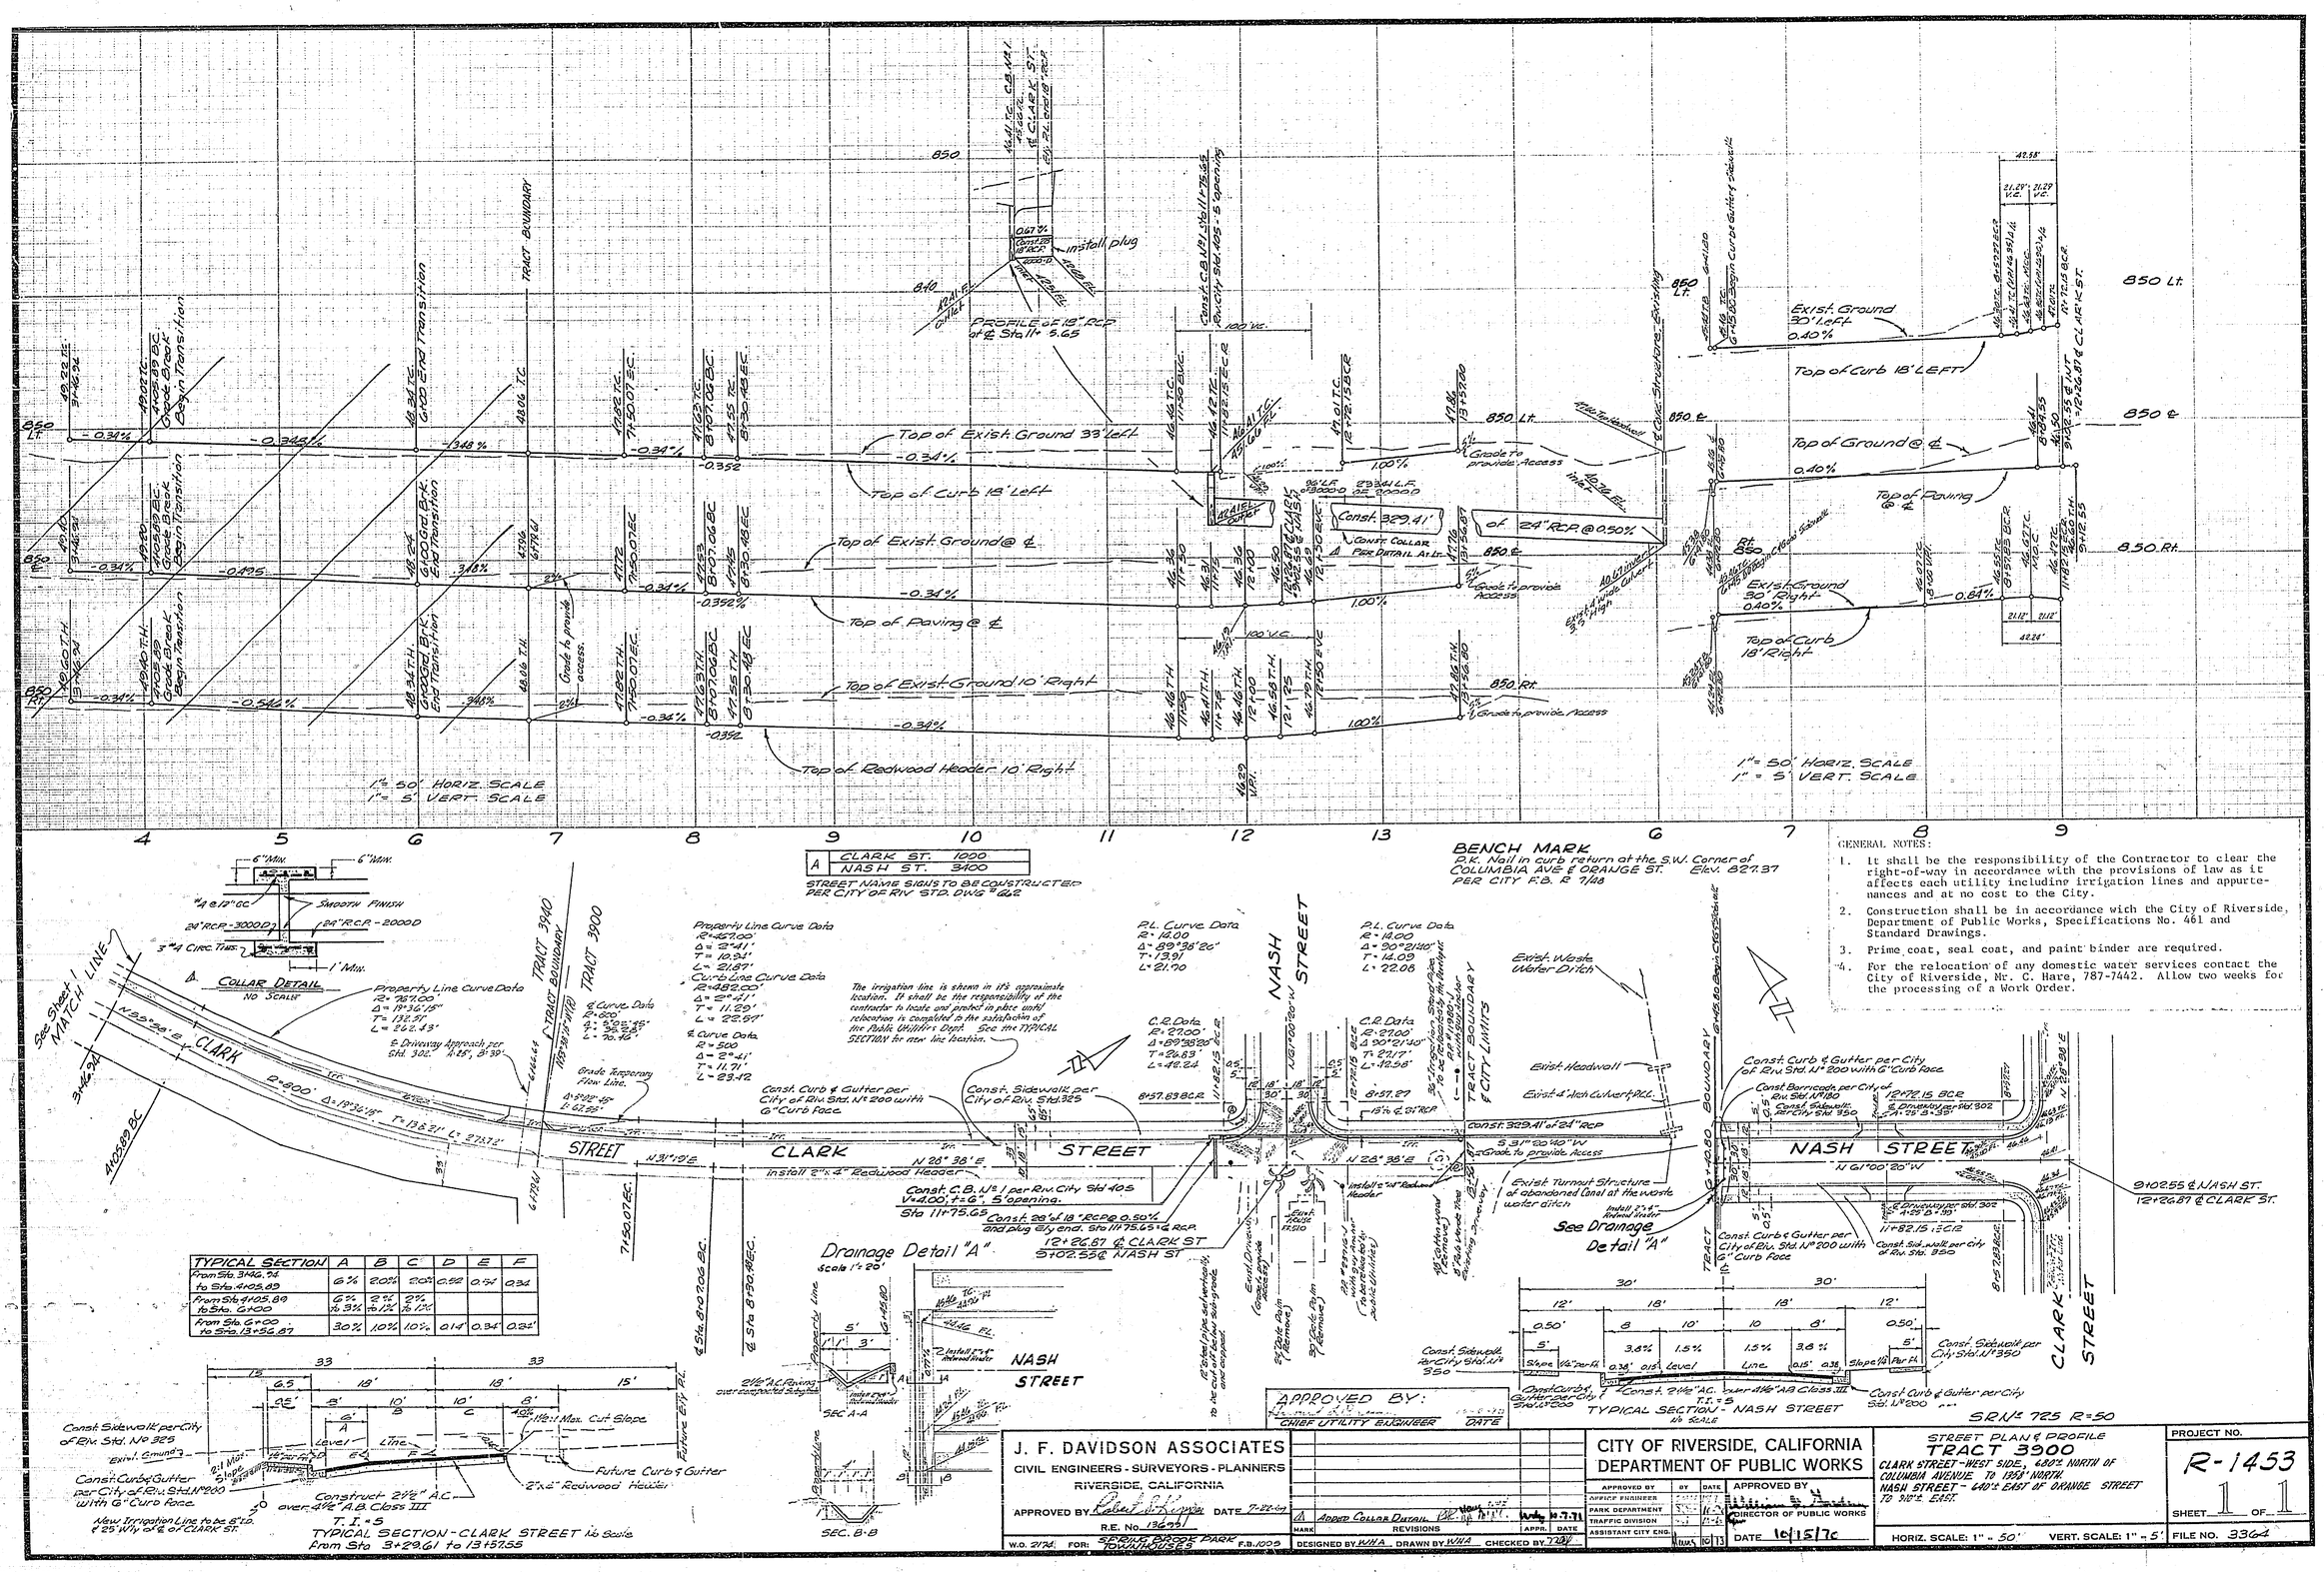

TYPICAL SECTION	A	B	C	D	E	F
From Sta. 3+46.94 to Sta. 4+05.89	6%	2.0%	2.0%	0.52	0.54	0.34
From Sta. 4+05.89 to Sta. 6+00	6% to 3%	2% to 1%	2% to 1%			
From Sta. 6+00 to Sta. 13+56.87	3.0%	1.0%	1.0%	0.14'	0.34'	0.24'

GENERAL NOTES:

1. It shall be the responsibility of the Contractor to clear the right-of-way in accordance with the provisions of law as it affects each utility including irrigation lines and appurtenances and at no cost to the City.
2. Construction shall be in accordance with the City of Riverside, Department of Public Works, Specifications No. 461 and Standard Drawings.
3. Prime coat, seal coat, and paint binder are required.
4. For the relocation of any domestic water services contact the City of Riverside, Mr. C. Hare, 787-7442. Allow two weeks for the processing of a Work Order.

APPROVED BY:
CHIEF UTILITY ENGINEER DATE

J. F. DAVIDSON ASSOCIATES
CIVIL ENGINEERS - SURVEYORS - PLANNERS
RIVERSIDE, CALIFORNIA
APPROVED BY Robert J. Kinney DATE 7-22-69
R.E. No. 13699
W.O. 2174 FOR: SPRING BROOK PARK TOWNHOUSES F.B. 1005

MARK	REVISIONS	APPR.	DATE
A	ADDED COLLAR DETAIL		10-7-71

DESIGNED BY WHA DRAWN BY WHA CHECKED BY

CITY OF RIVERSIDE, CALIFORNIA
DEPARTMENT OF PUBLIC WORKS

APPROVED BY	BY	DATE
OFFICE ENGINEER		
PARK DEPARTMENT		
TRAFFIC DIVISION		
ASSISTANT CITY ENG.		10/13

APPROVED BY
DIRECTOR OF PUBLIC WORKS
DATE 10/15/70

STREET PLAN & PROFILE
TRACT 3900
CLARK STREET - WEST SIDE, 680± NORTH OF COLUMBIA AVENUE TO 1358' NORTH.
NASH STREET - 640± EAST OF ORANGE STREET TO 910± EAST.

HORIZ. SCALE: 1" = 50' VERT. SCALE: 1" = 5'

PROJECT NO. R-1453
SHEET 1 OF 1
FILE NO. 3364