| DIST. | COUNTY | ROUTE | POST MILES—TOTAL PROJECT | SHEET NO. | TOTAL SHEETS |
|---|---|---|---|---|---|
| 08 | RIV | 91 | 20.0 | 1 | 1 |

DISTRICT ENGINEER

APPROVED

* Revise supercelevation as needed to provide for minimum clearance.




TYPICAL WIDENING SECTION

SCALE 1"=10'

BM #38-A
Fd. Lead & Sp. Hd. Nail in D.I.
Rt. of Sta. 372+20 ℄ Rte 91
Elev. 845.97'

BM - 14TH & Vine -52
Elev. 869.90'

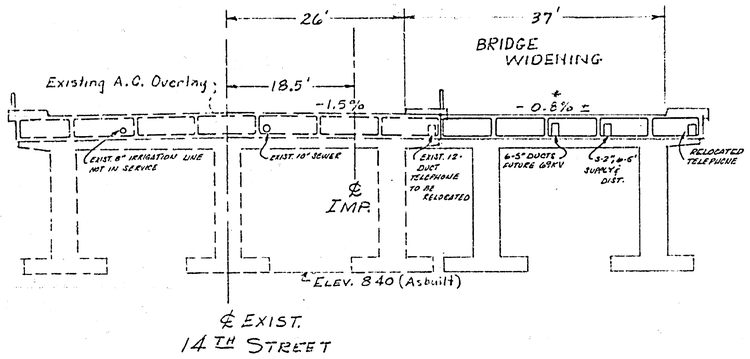


WIDENING PLAN

SCALE 1"=20'

TABLE OF
CLEARANCE UNDER EXISTING BRIDGE

| | ELEV. ON HWY. | SOFFIT ELEV. | CLEARANCE |
|---|---|---|---|
| 1 | 844.13 | 859.52 | 15.39 |
| 2 | 844.66 | 859.91 | 15.25 |
| 3 | 844.67 | 860.08 | 15.41 |
| 4 | 844.09 | 860.55 | 16.46 |
| 5 | 844.15 | 859.39 | 15.24 |
| 6 | 844.73 | 860.37 | 15.64 |
| 7 | 844.72 | 860.54 | 15.52 |
| 8 | 844.13 | 860.99 | 16.86 |
| 9 | 844.21 | 859.51 | 15.30 |
| 10 | 844.76 | 859.93 | 15.17 |
| 11 | 844.79 | 860.07 | 15.28 |
| 12 | 844.20 | 860.57 | 16.37 |

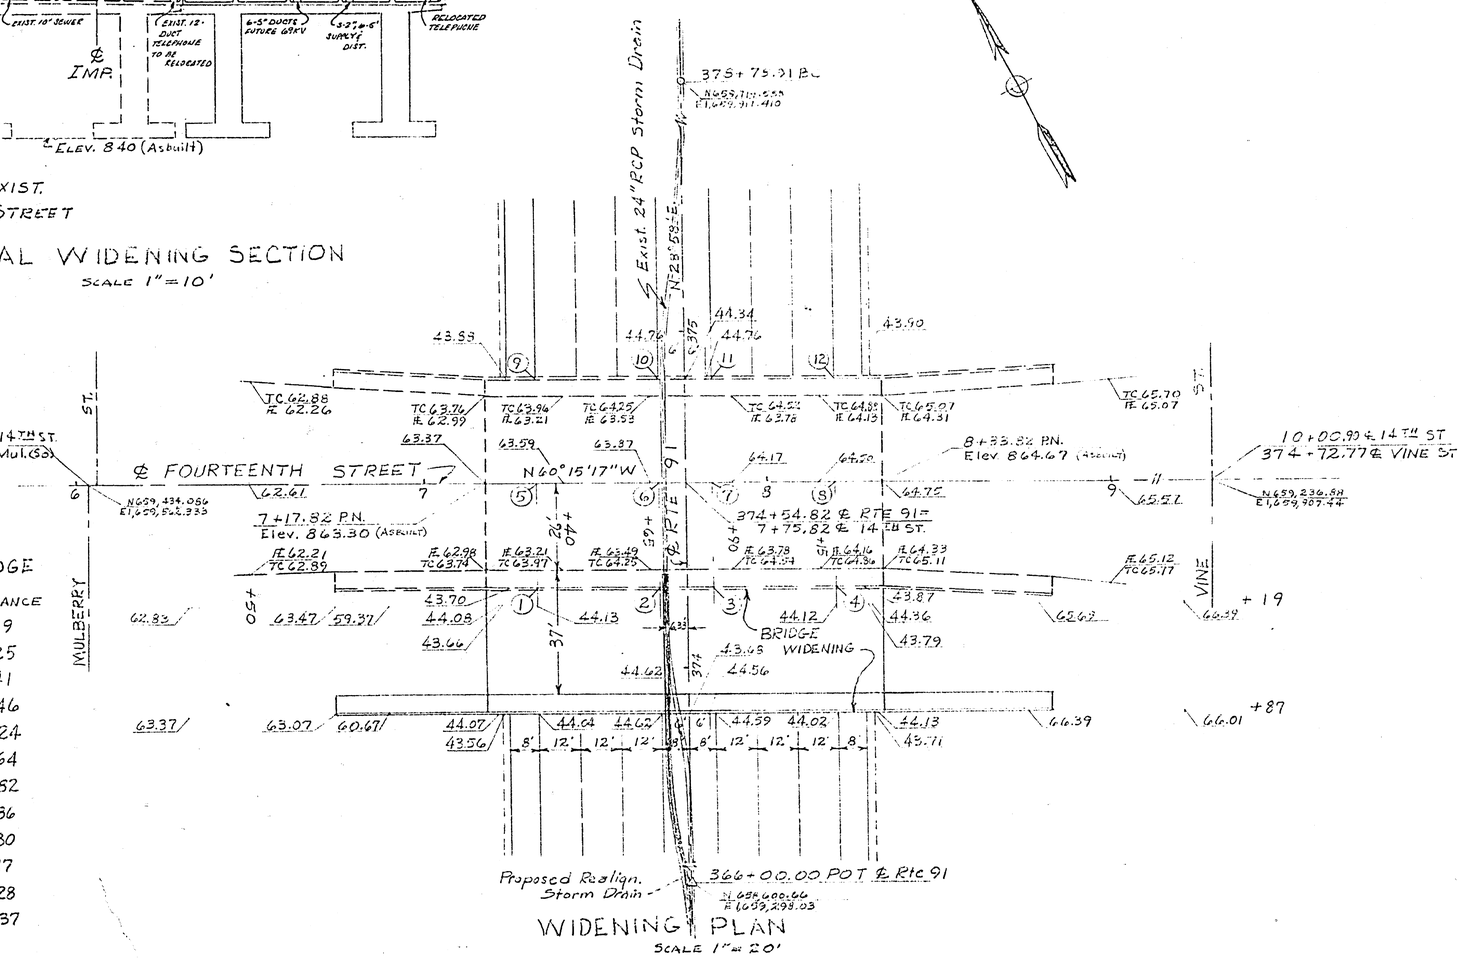JLP 4-10-72

08-RIV-91-P.M. 20.0

BRIDGE SITE PLAN

FOURTEENTH STREET O.C. WIDENING
BRIDGE NO. 56-313

SCALE AS SHOWN

R-1486 F

| Project Engineer | Date | Design Engineer | Date | Approval Recommended By | Date |
|---|---|---|---|---|---|
| | | | | | |