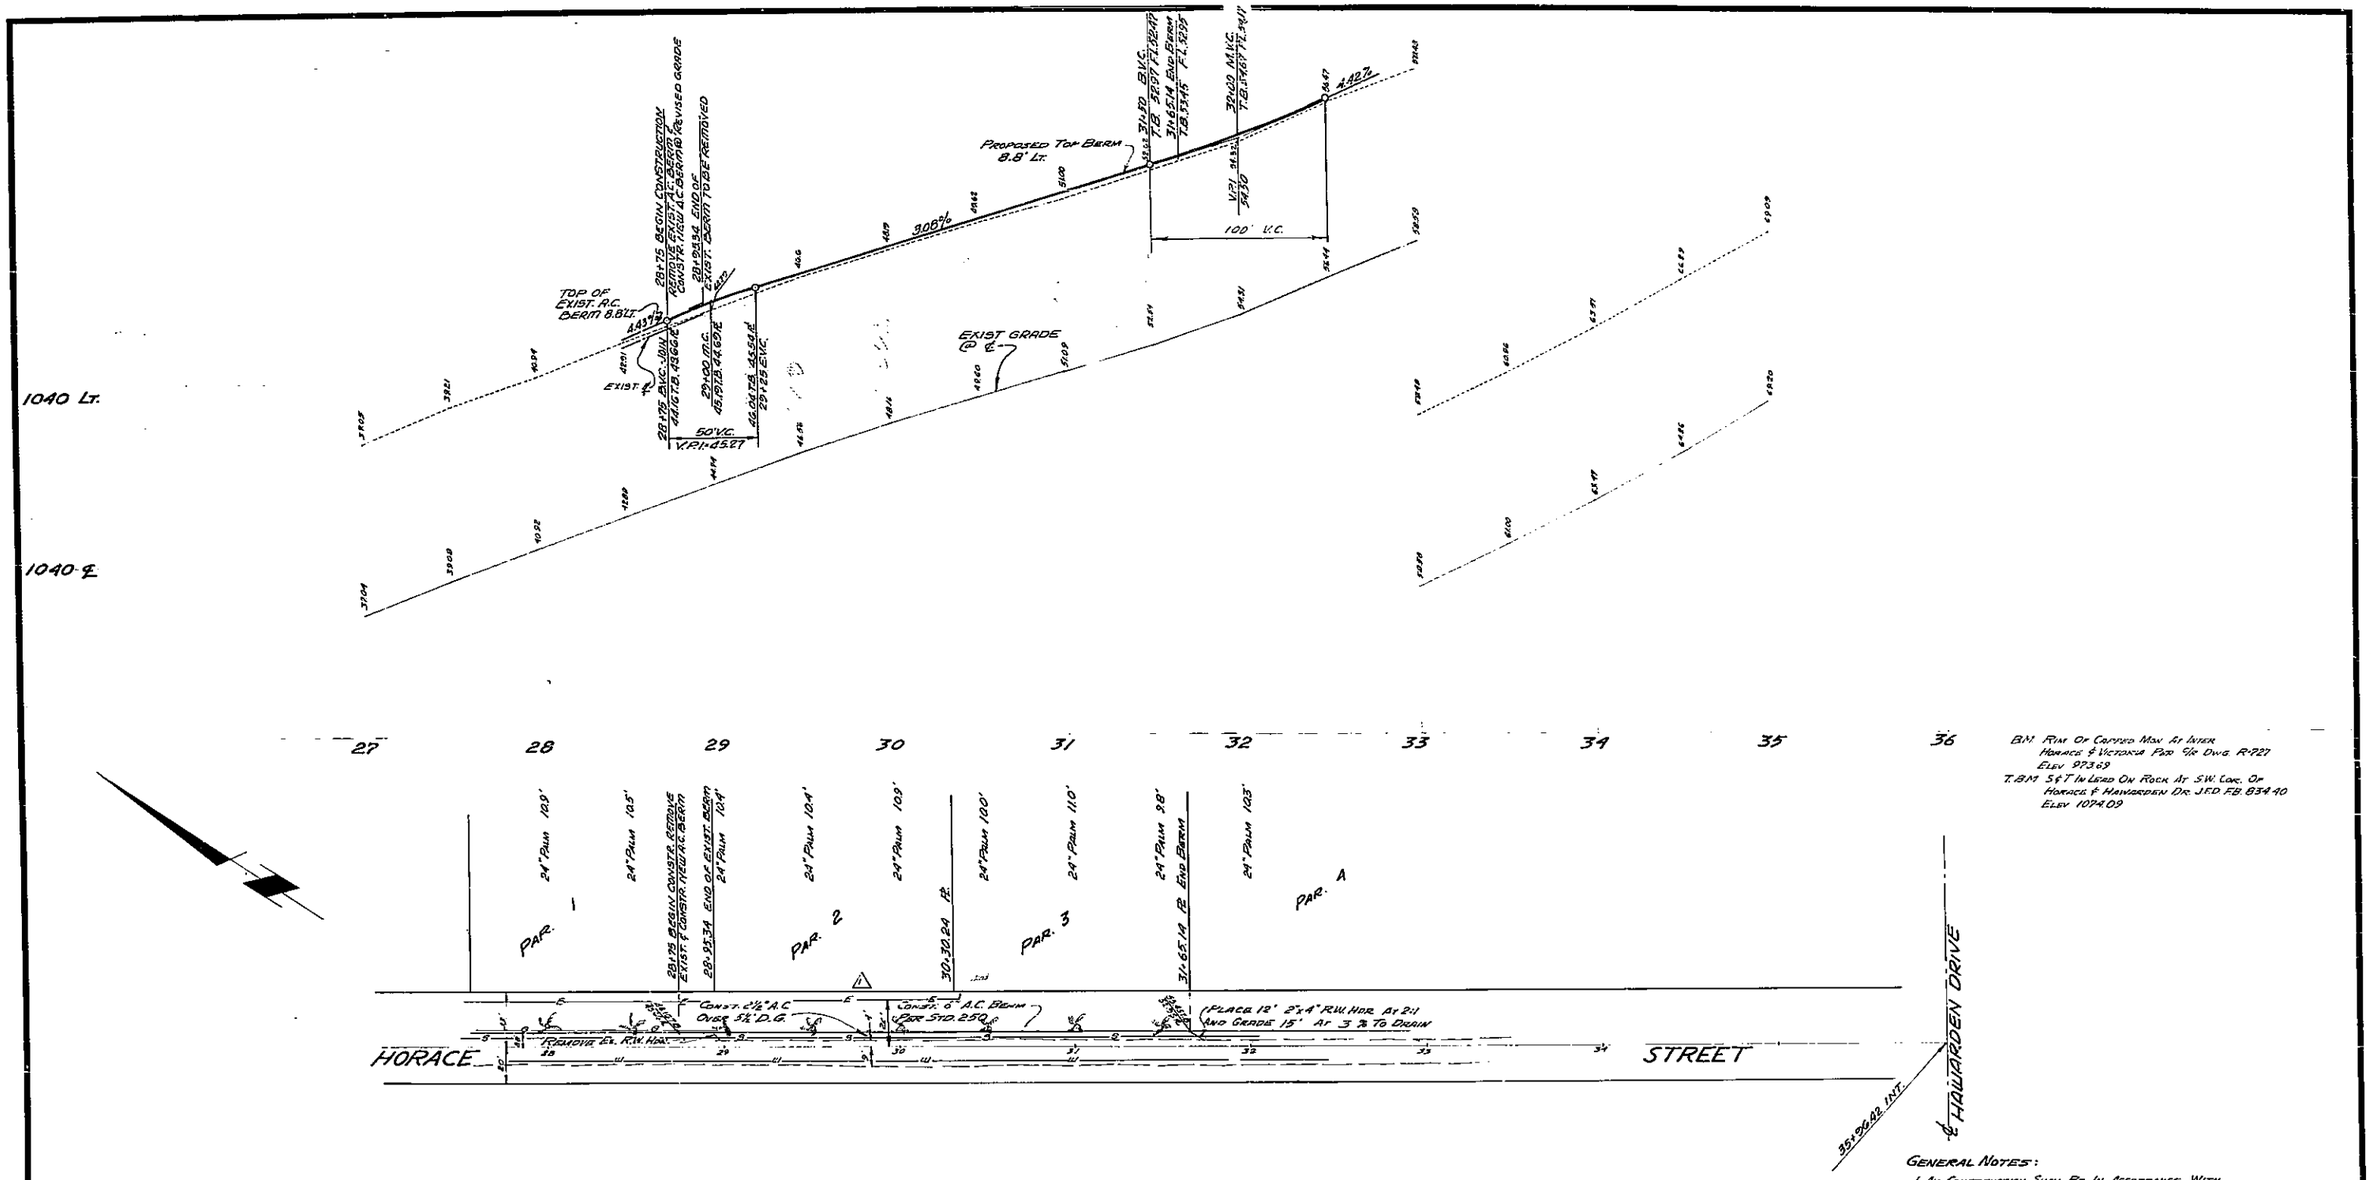

B.M. Rim Of Capped Mon At Inter Horace & Victoria Per C/R Dwg. R-727 Elev 973.69

T.B.M. S&T In Lead On Rock At S.W. Cor. Of Horace & Hawarden Dr. J.F.D. F.B. 834.40 Elev 1074.09

General Notes:

1. All Construction Shall Be In Accordance With The Standard Specifications For Public Works Construction 1970 Edition And Standard Drawings City Of Riverside Department Of Public Works.

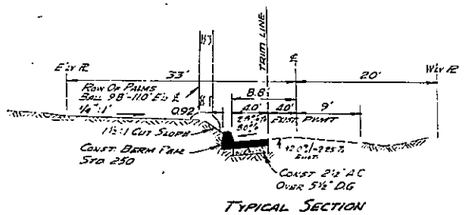

Typical Section
Horace St.
Sta. 28+95.34 - 31+65.14
No Scale
T.I. = 5.0

J. F. DAVIDSON ASSOCIATES
CIVIL ENGINEERS - SURVEYORS - PLANNERS
RIVERSIDE, CALIFORNIA
APPROVED BY Robert S. Kipper DATE 3-29-71
R.E. No. 13659
W.O. 2835 FOR: S. White F.B. 1032

MARK	REVISIONS	APPR.	DATE
1	Adjust Elec. U.G. At Pole To Show Exist.		6-8-71

DESIGNED BY A.W. DRAWN BY A.W. CHECKED BY [illegible]

CITY OF RIVERSIDE, CALIFORNIA
DEPARTMENT OF PUBLIC WORKS

APPROVED BY	BY	DATE
OFFICE ENGINEER		
PARK DEPARTMENT	[illegible]	5-4
TRAFFIC DIVISION	[illegible]	
ASSISTANT CITY ENG.	[illegible]	5-6

APPROVED BY [illegible]
DIRECTOR OF PUBLIC WORKS
DATE [illegible]

STREET PLAN & PROFILE
HORACE STREET
East Side
500'± - 800' N'ly Hawarden
P.M. 21

HORIZ. SCALE: 1" = 40' VERT. SCALE: 1" = 4'

PROJECT NO. R-1487
SHEET 1 OF 1
FILE NO. 4402